


PURPOSE OF PROJECT:
BUDGET FEEDER PROJECT

CITY OF LAS VEGAS
PERMIT REQUIRED*

CONTACT CLV LAND DEVELOPMENT (229-6371)
CLV CONSTRUCTION SERVICES MUST BE
NOTIFIED 24 HOURS PRIOR TO COMMENCING
CONSTRUCTION (229-6337)

*NPC INSPECTOR MUST BE NOTIFIED BY
FAX 48 HOURS PRIOR TO COMMENCING
CONSTRUCTION & WILL VERIFY CITY PERMIT
FOR WORK DONE IN STREETS OR SIDEWALK.
LAS VEGAS NORTH 887-4354
LAS VEGAS SOUTH (HENDERSON) 558-4740
LAS VEGAS SOUTH (SPRING VALLEY) 252-4828

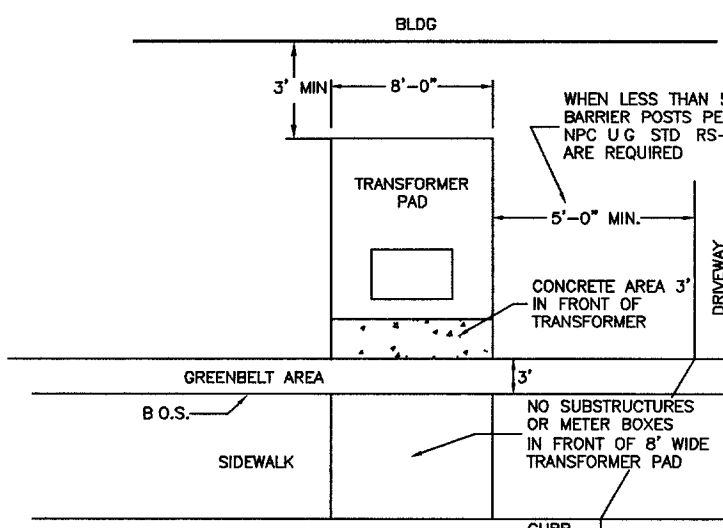


COMMERCIAL TRANSFORMER LOCATION DETAIL
NPC IUG STD RS-5

SWITCHING ORDER

CLOSE ALL THE SWITCHES IN FC-5218 LOCATED ON THE
NORTHWEST CORNER OF ELKHORN RD AND TEE PEE LN.
THIS WILL PARALLEL ELK 1224 AND NW 1205

OPEN SW-9465 (FC-5131) BREAKING THE PARALLEL
BETWEEN ELK 1224 AND NW 1205. FC-5131 IS LOCATED
ON THE EAST SIDE OF TEE PEE LN NORTH OF SVEREANCE LN.



SEE MATCHLINE A
SHEET 3 OF 4

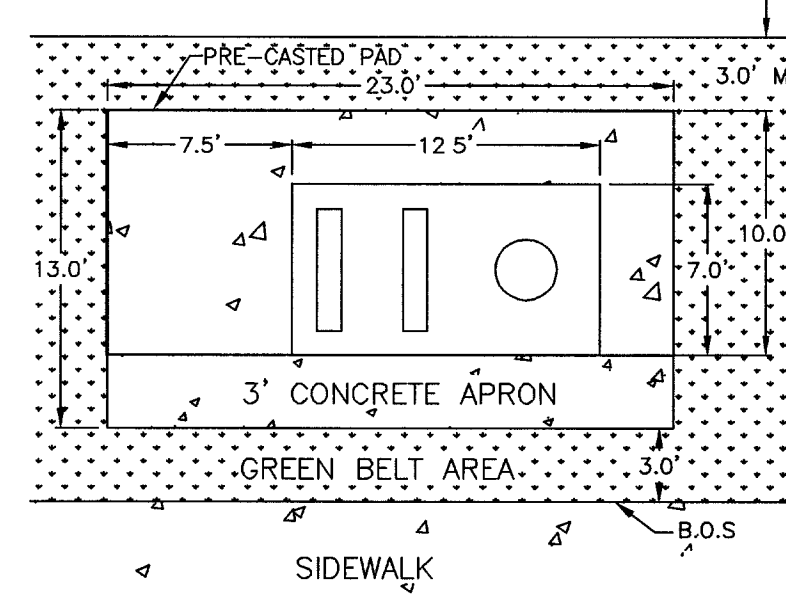


RS-99 PLACEMENT WITH SIDEWALK
CONFORMS TO CLV SPECIFICATIONS

78114

SEE MATCHLINE C
SHEET 3 OF 4

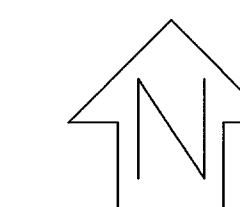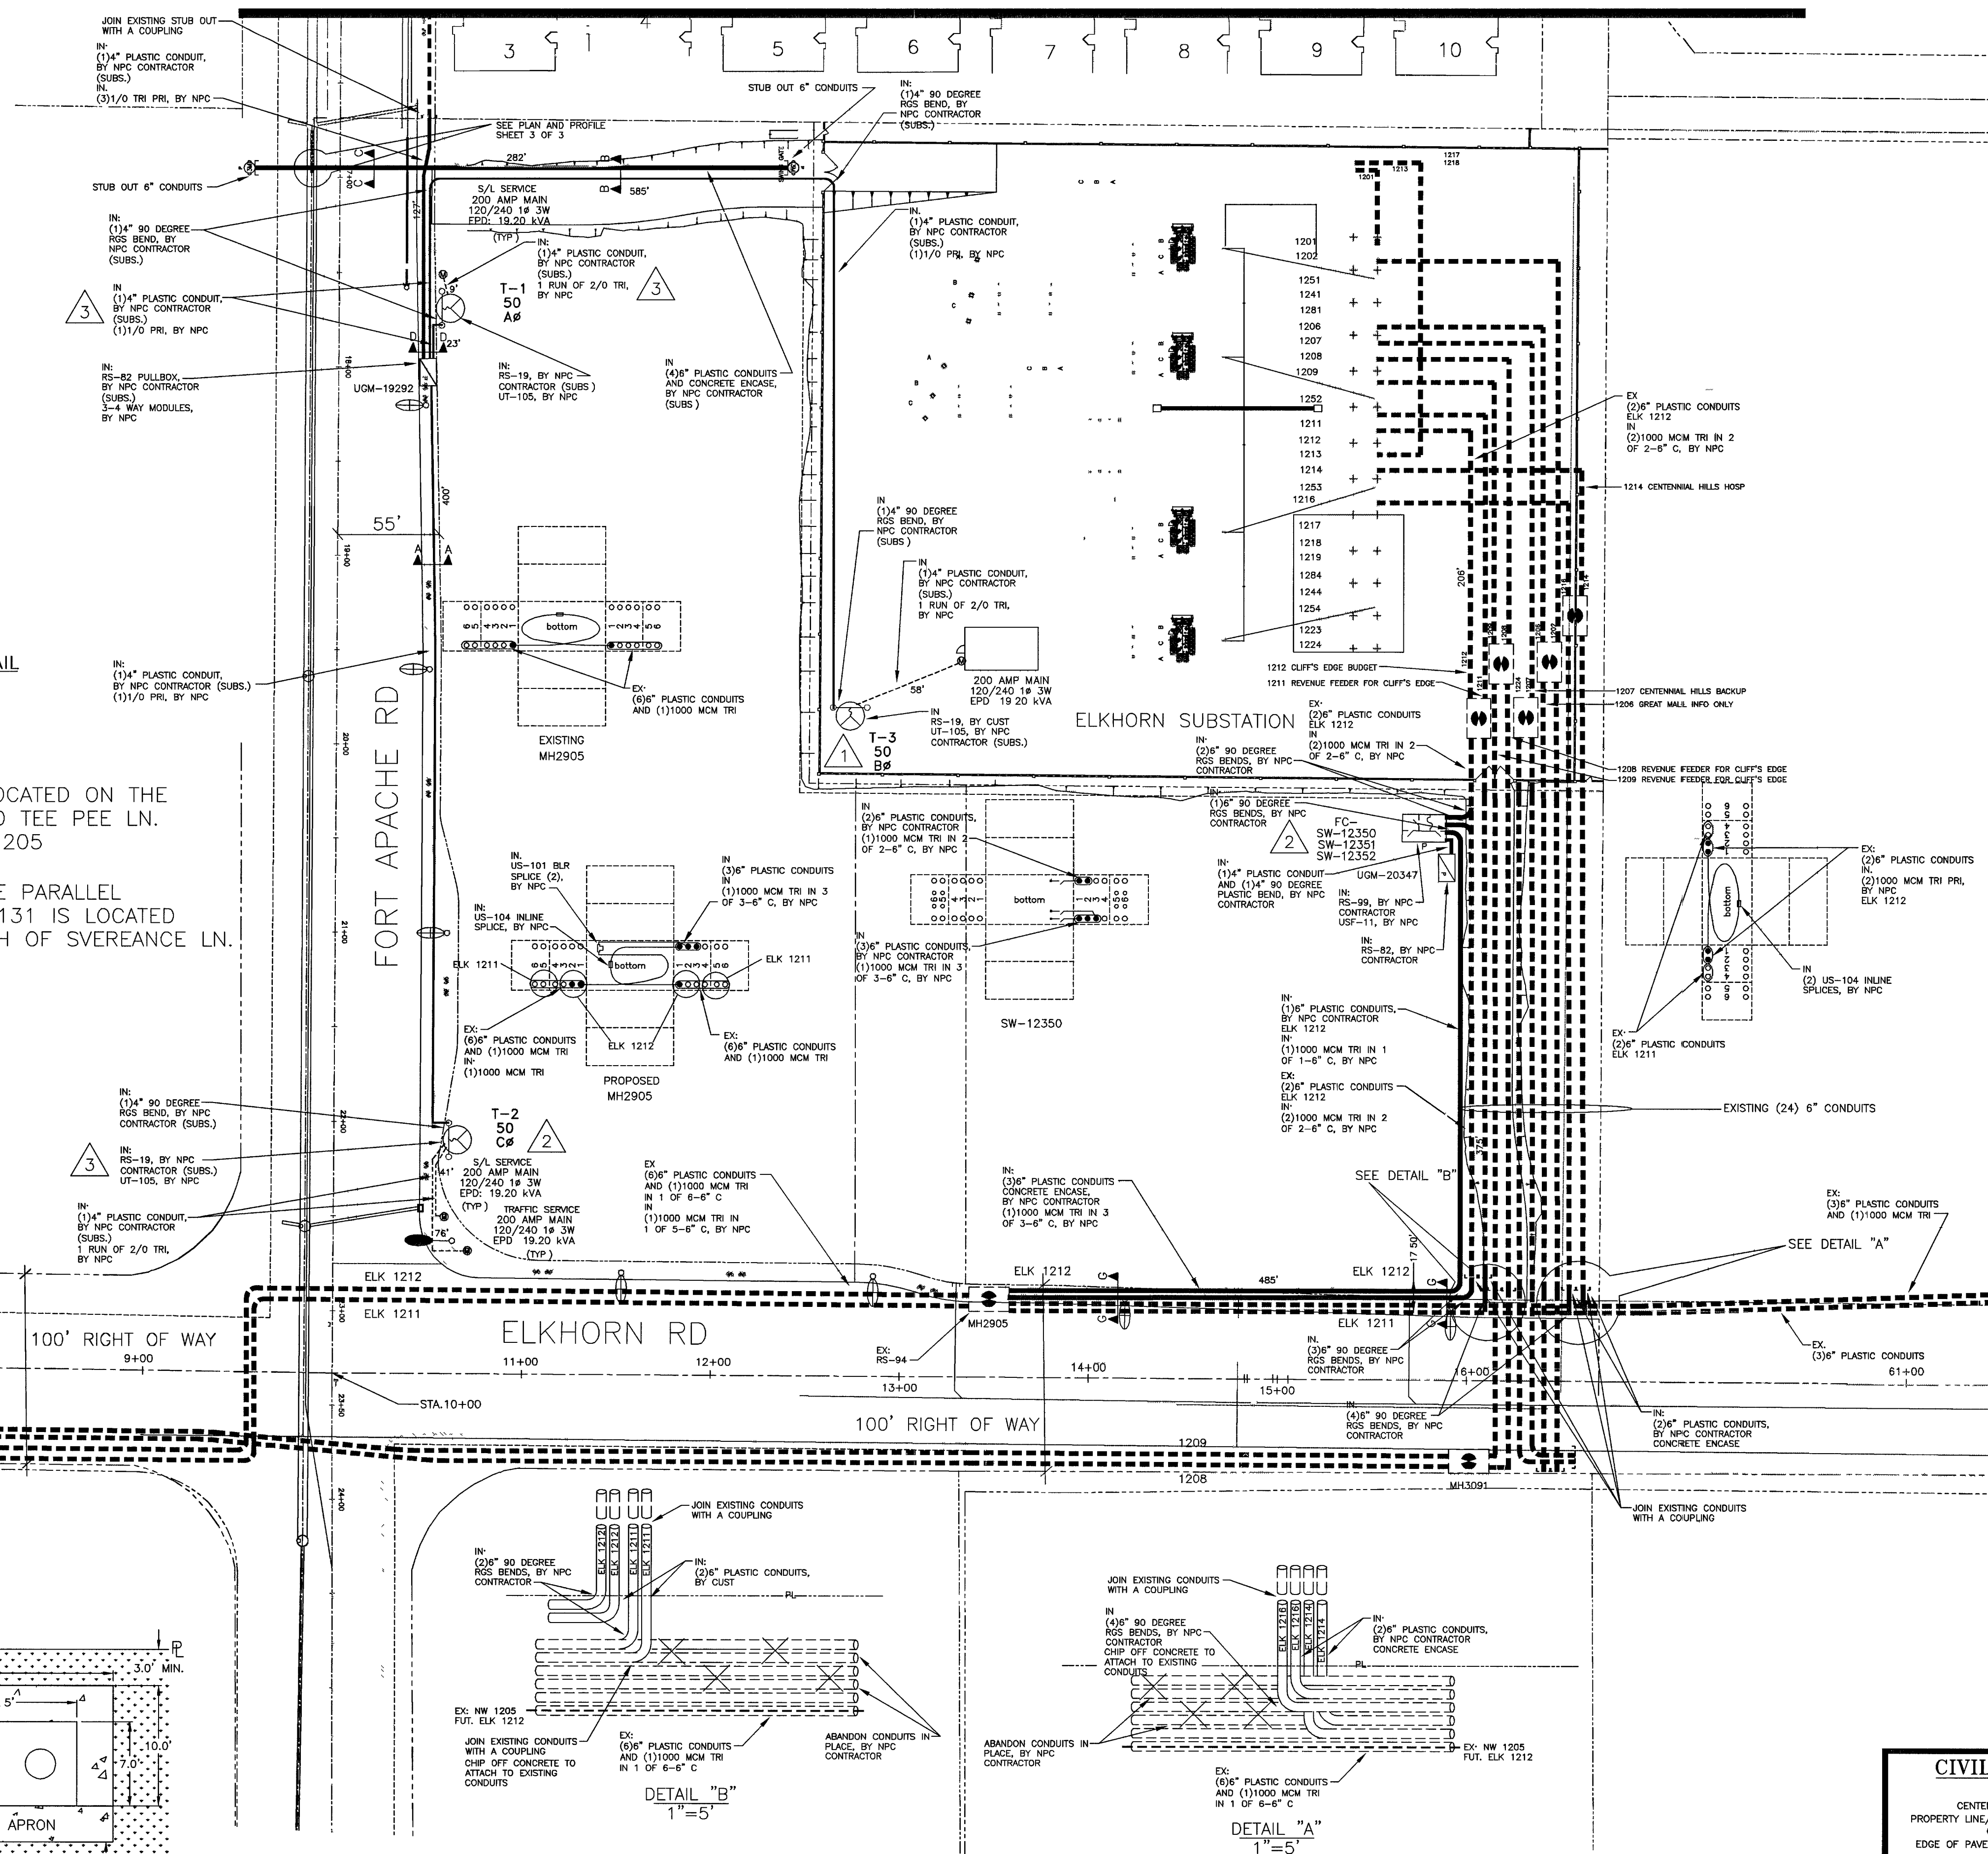

T,R,S: 1960-17
APN: 12517401007

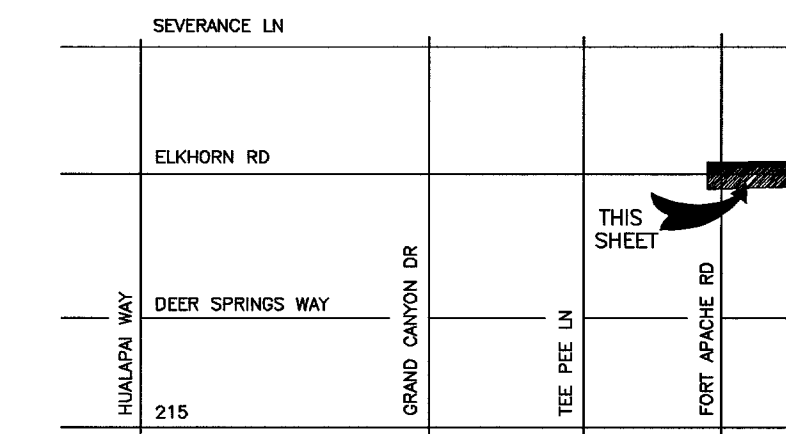

VICINITY MAP
(NOT TO SCALE)

EVERY EFFORT HAS BEEN MADE TO IDENTIFY ALL NPC
FACILITIES. THE CUSTOMER SHALL CONFIRM THE EXISTENCE
AND LOCATION OF THESE FACILITIES.

AVOID HITTING OVERHEAD
POWER LINES. IT'S COSTLY.

CALL BEFORE
YOU DO
OVERHEAD

AVOID CUTTING UNDERGROUND
UTILITY LINES. IT'S COSTLY.

Call
before you
Dig.

CALL 1-702-227-2929 1-800-227-2600
UNDERGROUND SERVICE (USA)

REVISIONS

NO.	DESCRIPTION	DATE	G.A.
1	CHANGED C PH TO B PH, PER HEATHER REQUEST, BY DT	01/13/2005	
2	CHANGE B PH TO C PH, PER HEATHER REQUEST, BY DT	01/13/2005	
3	CHANGE NOTES TO CALL OUT FOR SUBSTATIONS TO INSTALL SUBSTRUCTURES, BY DT	02/17/2005	
4	MOVE SW NEAR GATE ENTRANCE APPROVED BY SAM TOLMAN, BY DT	03/15/2005	

SURVEY

TYPE OF EASEMENT:

AERIAL
STANDARD
R/W-31
UNDERGROUND
AS BUILT UNDERGROUND
R.O.E./R/W-5-COM
3rd PARTY
UNDERGROUND BY EXHIBIT
(N-DOT) PERMIT
(BLM) PERMIT
RAILROAD-UPRR-PERMIT
SO. NEVADA WATER PERMIT
NOT REQUIRED
Misc. Info.

JPA NOTES:

SPRINT CONTACT:
PHONE NUMBER:
DATE OF CONTACT:
TO SET NEW POLES
TO STAKE NEW POLES
TO PROVIDE POLES
TO REMOVE POLES
TO DIG POLE HOLES
TO REMOVE EX. POLES

JPA#:

NPC INFORMATION:

COORDINATOR: BRAD REIPLINGER
PHONE: 657-4303
DESIGNER: DARRYL THOMAS
DCA:
INSPECTOR: 274-7051
SCHEDULING: 657-4114, 657-4116, 657-4118

DISTRICT: LAS VEGAS

CUSTOMER INFORMATION:

APPLICANT: NEVADA POWER COMPANY
ENGINEER: BARBARA ALLEN
CONTACT: BRAD REIPLINGER 657-4303

APPROVAL DATE:

GOVERNMENT INFORMATION:

AGENCY: CITY OF LAS VEGAS
APPROVAL DATE: 3/1/05

NEVADA POWER COMPANY

ELKHORN SUB 1212 FEEDER

107V4316-NPC

PROJ. ID: 176925 SCALE: 1" = 50'
SHEET #: 2 OF 4 DATE: 10/22/2004

CIVIL LINETYPE LEGEND

	PROPOSED	EXISTING
CENTERLINE	---	---
PROPERTY LINE/ROW	---	---
CURB	---	---
EDGE OF PAVEMENT	---	---
SEWER LINE	---	---
WATER LINE	---	---
GAS LINE	---	---
TELEPHONE LINE	---	---
CABLE TV LINE	---	---
STORM DRAIN LINE	---	---
FIRE HYDRANT	---	---
STREET LIGHT	---	---
STREET LIGHT SERVICE	---	---

* LINETYPES UTILIZED WHERE CONFLICT OCCURS WITH NPC FACILITIES.

SEE TRENCH DETAILS ON SHEET 4 OF 4

SEE MATCHLINE B
SHEET 3 OF 4