



Call
before you
Dig.
1-800-227-2600
UNDERGROUND SERVICE (US)

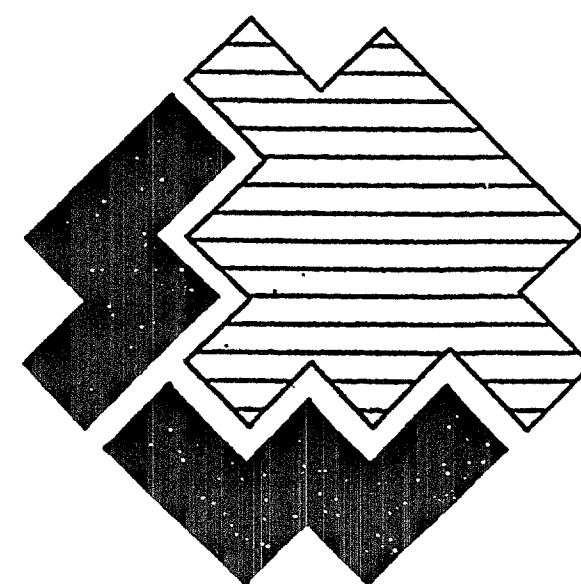

SOUTHWEST GAS CORPORATION SI - CLV - CASINO CENTER MAIN REPLACEMENT E. CHARLESTON / CASINO CENTER WR# 147369

FOR STREETS WITH 60 FOOT OR LESS RIGHT-OF-WAY:
PAVED AREA. COMPLY WITH RTC STANDARD 503.

FOR STREETS WITH GREATER THAN 60 FOOT RIGHT-OF-WAY:
PAVED AREA. COMPLY WITH RTC STANDARD 504.

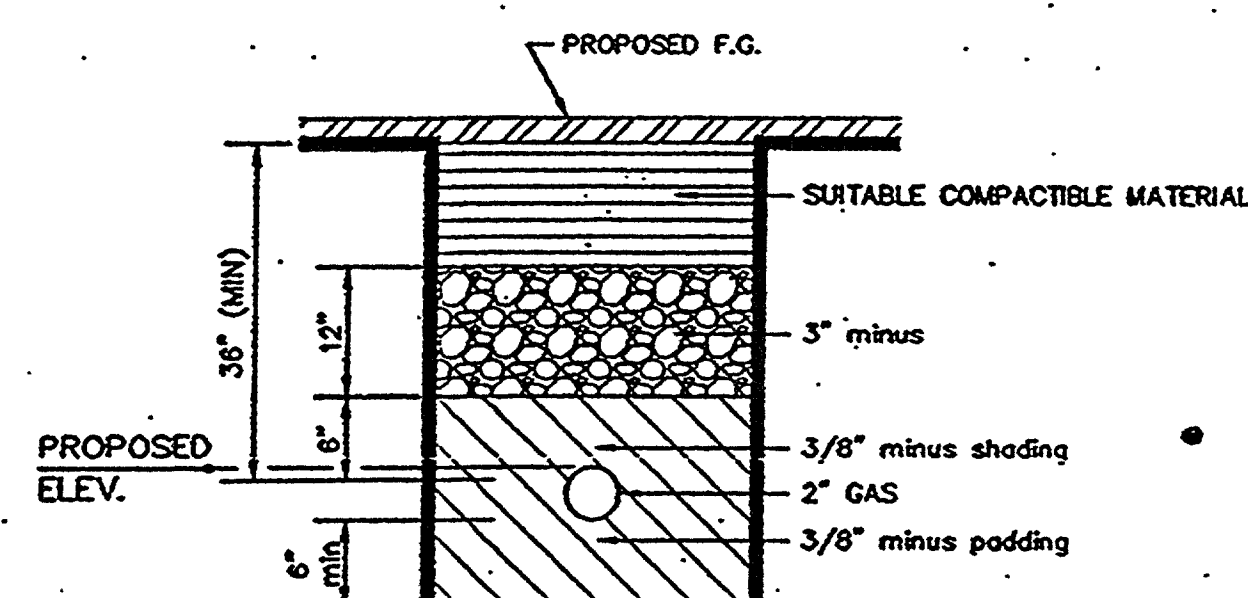

TRENCH DETAIL

CONSTRUCTION NOTES:


1. SUGGESTED GAS LOCATIONS ARE TO CLEAR SUBSTRUCTURES LOCATE IN FIELD
2. ALL PIPELINE CONSTRUCTION SHALL CONFORM TO APPLICABLE JURISDICTION SPECIFICATIONS.
3. DO NOT SCALE THIS DRAWING.
4. SEE AC'S FOR SERVICE TIE-OVERS & REPLACEMENTS.
5. CHANGE IN PROPOSED MAIN LOCATION MUST BE AUTHORIZED BY SWG INSPECTOR.
6. GAS MAINS SHALL BE PURGED PER OPERATIONS MANUAL.
7. ABANDONED SERVICE NO ACTION REQUIRED.
8. REPLACE ALL ACTIVE SERVICES EXCEPT WHERE EXISTING PE SERVICES ARE FOUND.
9. CITY OF LAS VEGAS PERMIT REQUIRED.
10. EXISTING PE SERVICE. PE VERIFICATION REQUIRED FROM MAIN TO RISER. TIE IN TO NEW MAIN REQUIRED.
11. EXISTING SERVICE, UNKNOWN TYPE, SIZE, AND LOCATION. TO BE VERIFIED.
12. TIE OVER ALL EXISTING SERVICES TO NEW MAIN.
13. EXISTING ANODE RISER
14. EXISTING ANODELESS RISER
15. REPLACEMENT SVCS TO BE SINGLE OR BRANCHED. NO CROSS-LOT REPLACEMENT SVCS PERMITTED
16. REPLACE ALL STL RISERS W/ ANODELESS RISERS.

E. CHARLESTON BLVD. 100' R/W



LEGEND

EX. GAS SERVICES	EX. GAS SERVICES
PROPOSED GAS MAIN	PROPOSED GAS MAIN
EXISTING GAS MAIN	EXISTING GAS MAIN
EXISTING GAS MAIN TO BE ABANDONED	EXISTING GAS MAIN TO BE ABANDONED
PROPOSED 1/2" PE	PROPOSED 1/2" PE
MATCHLINE	MATCHLINE
RIGHT-OF-WAY LINE	RIGHT-OF-WAY LINE
CENTERLINE	CENTERLINE
EXISTING	EXISTING
RIGHT-OF-WAY	RIGHT-OF-WAY
STREET ADDRESS	STREET ADDRESS
WR NUMBER	WR NUMBER
BACK OF CURB	BACK OF CURB

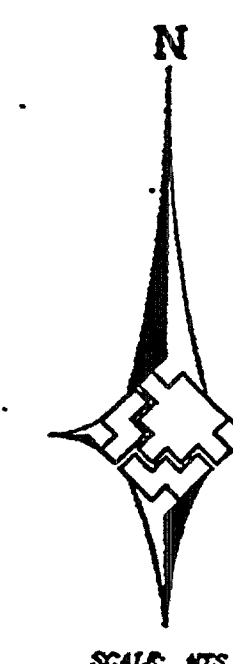

SCALE: HTS

PURGE PLAN WAS COMPLETE IN ACCORDANCE
WITH OPERATIONS MANUAL GUIDELINES BY:

NAME _____ DATE _____

Revision OK
12-16-05

TOTAL FOOTAGE LOCATED IN
PUBLIC ROW 2,365'±

REVISED

NOTHING ON THESE DRAWINGS SHALL BE RELIED ON
OR CONSTRUED BY CONTRACTOR TO ESTABLISH THE
METHOD OF INSTALLATION (I.E. INSERTION, SPLITTING
OF SERVICE, OPEN CUT, OR BORING).

107N4460-SW6