


T,R,S: 1960-20
APN:



AVOID HITTING OVERHEAD POWER LINES IT'S COSTLY  CALL BEFORE YOU DO OVERHEAD CALL 1-702-227-2929	AVOID CUTTING UNDERGROUND UTILITY LINES IT'S COSTLY  Call before you Dig. 1-800-227-2600 UNDERGROUND SERVICE (USA)
---	--

NO.	DESCRIPTION	DATE	G.A.
1	SHOW EXISTING CONDUIT FROM DEER SPRINGS TO JUST SOUTH OF CENTENNIAL PER PHOL, 1992E1	03/27/2002	DT
2	BORE OSO BLANCA/NO CUT PER NDOT	06/11/2002	DT
3	REVISE ENTIRE DRAWING TO SHOW STREET LIGHT SERVICE POINTS ONLY	01/13/2003	KC
4	ADD SHEET 4 AND SERVICE AT FRONTAGE ROAD	01/21/2003	KC
5	ADD NDOT CLV TRENCH DETAILS	03/05/2003	KC
6	REVISE FEED ON PAGE 1 DUE TO HITS FAMILY NOT DEVELOPING AT THIS TIME	08/06/2003	KC
7	MOVE SWITCH ON HITS PROPERTY PER DOUG HITT	08/22/2003	KC
8	OMIT SHEET 4 OF 4 REFER TO WR14535	10/30/2003	KC
9	MOVE SERVICE POINT 4 AND 5 TO WR #174535	11/05/2003	KC
10	OMIT SERVICE POINT ON DURANGO AND DEER SPRINGS WAY PER CITY	12/06/2005	KC

AERIAL	☐	SPRINT CONTACT: _____
STANDARD	☐	PHONE NUMBER: _____
R/W-31	☐	DATE OF CONTACT: _____
UNDERGROUND	☐	_____ TO SET NEW POLES
AS BUILT UNDERGROUND	☒	_____ TO STAKE NEW POLES
R.O.E./R/W-5-COM	☒	_____ TO PROVIDE _____ POLES
3rd PARTY	☒	_____ FT. CLASS
UNDERGROUND BY EXHIBIT	☒	_____ FT. CLASS
(N-DOT) PERMIT	☒	_____ FT. CLASS
(BLM) PERMIT	☒	_____ TO DIG POLE HOLES
RAILROAD-UPRR-PERMIT	☐	_____ TO REMOVE EX. POLES
SO. NEVADA WATER PERMIT	☐	
NOT REQUIRED	☐	
Misc Info.	☐	
		JPA# : _____

COORDINATOR: KATHY CUNNINGHAM

PHONE: 657-4313

DESIGNER: _____

DCA: _____

INSPECTOR: 378-3695

SCHEDULING: 657-4114, 657-4116, 657-4118

DISTRICT: LAS VEGAS

DISTRICT: LAS VEGAS

CUSTOMER INFORMATION:

DEVELOPER: CITY OF LAS VEGAS

ENGINEER: _____

CONTACT: CITY OF LAS VEGAS

APPROVAL DATE: 01/29/2003

GOVERNMENT INFORMATION:

AGENCY: CITY OF LAS VEGAS

APPROVAL DATE: 03/29/2004

NEVADA POWER COMPANY 

EL CARITAN / DURANGO

EL CAPITAN/DURANGO
STREET LIGHTS


STREET LIGHTS

10714540-NAC

10	10	15	10	14.5
----	----	----	----	------

PROJ. ID: 169105	SCALE: 1" = 50'
------------------	-----------------

SHEET #: 2 OF 2	DATE: 01/13/2003
-----------------	------------------

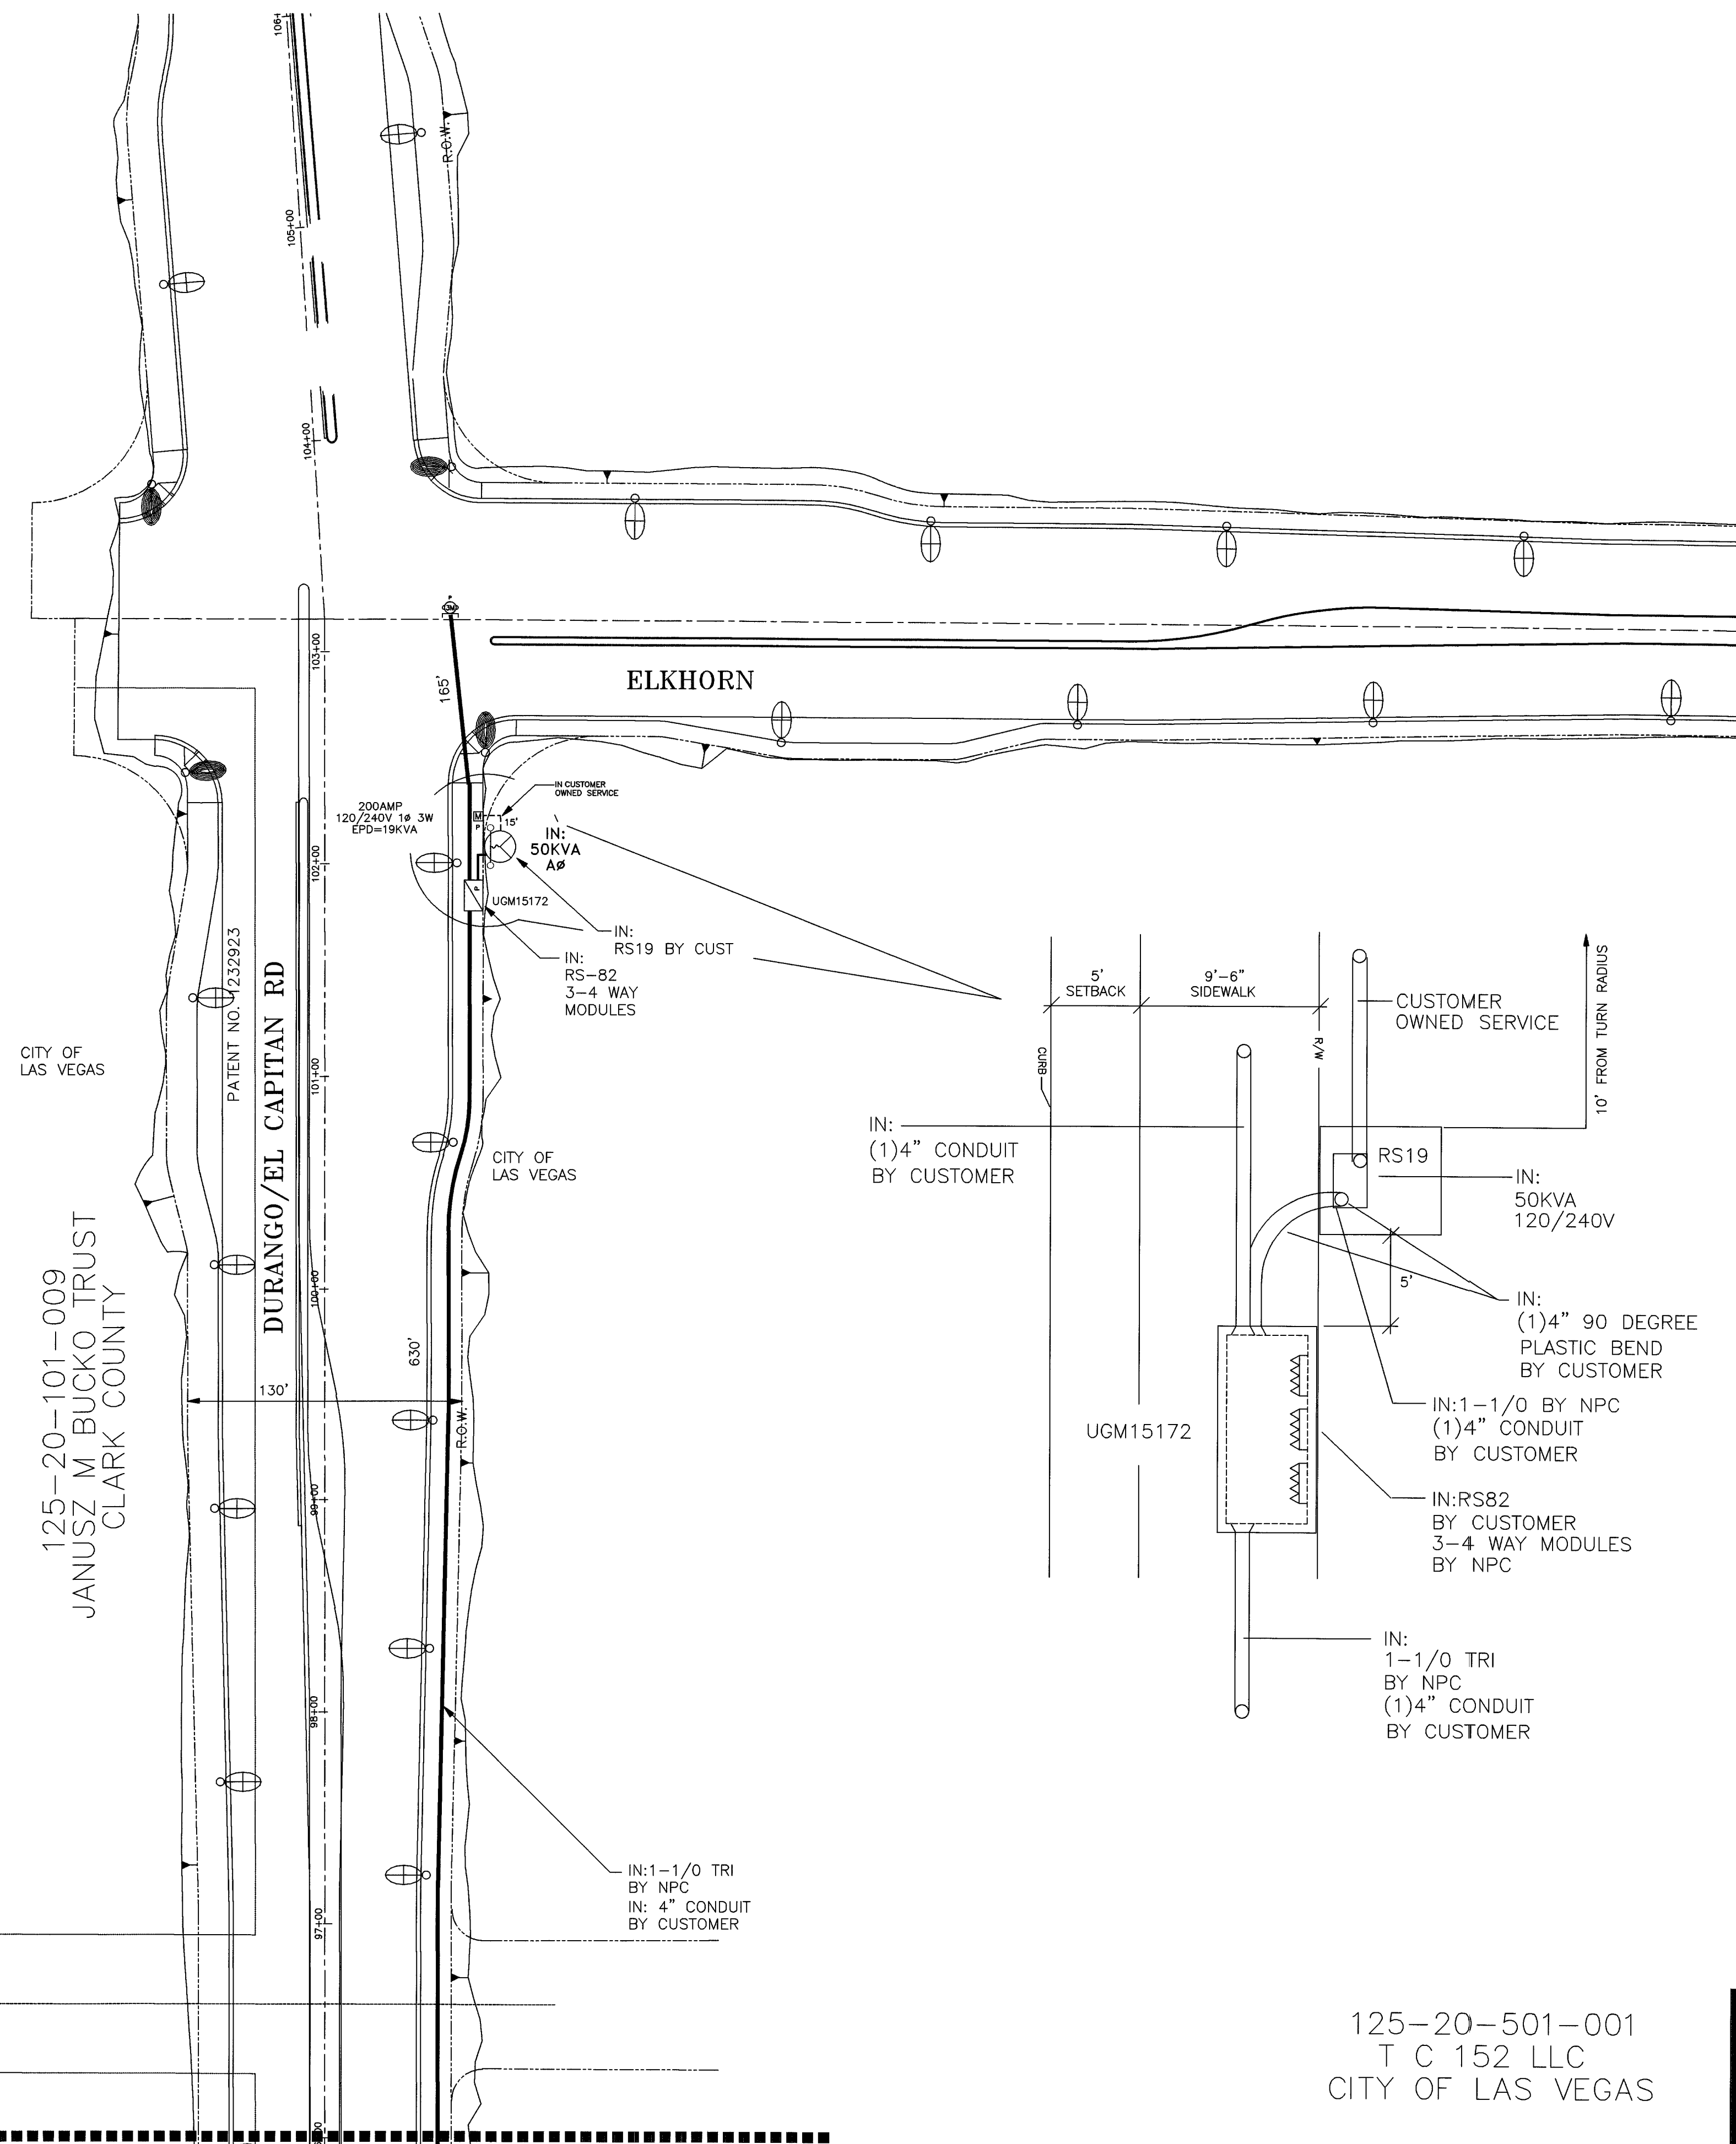

125-20-501-001
T C 152 LLC
CITY OF LAS VEGAS

CIVIL LINETYPE LEGEND		
	PROPOSED	EXISTING
CENTERLINE	_____	_____
PROPERTY LINE/ROW	_____	_____
CURB	_____	_____
EDGE OF PAVEMENT	_____	_____
EDGE OF SIDEWALK	____/____/____	____/____/____
SEWER LINE *	8" _____	8" _____
WATER LINE *	8" _____	8" _____
GAS LINE *	2" _____	2" _____
TELEPHONE LINE *	____/____/____	____/____/____
CABLE TV LINE *	CATV _____	CATV _____
STORM DRAIN LINE *	12" _____	12" _____
FIRE HYDRANT		
STREET LIGHT		
STREET LIGHT SERVICE		