
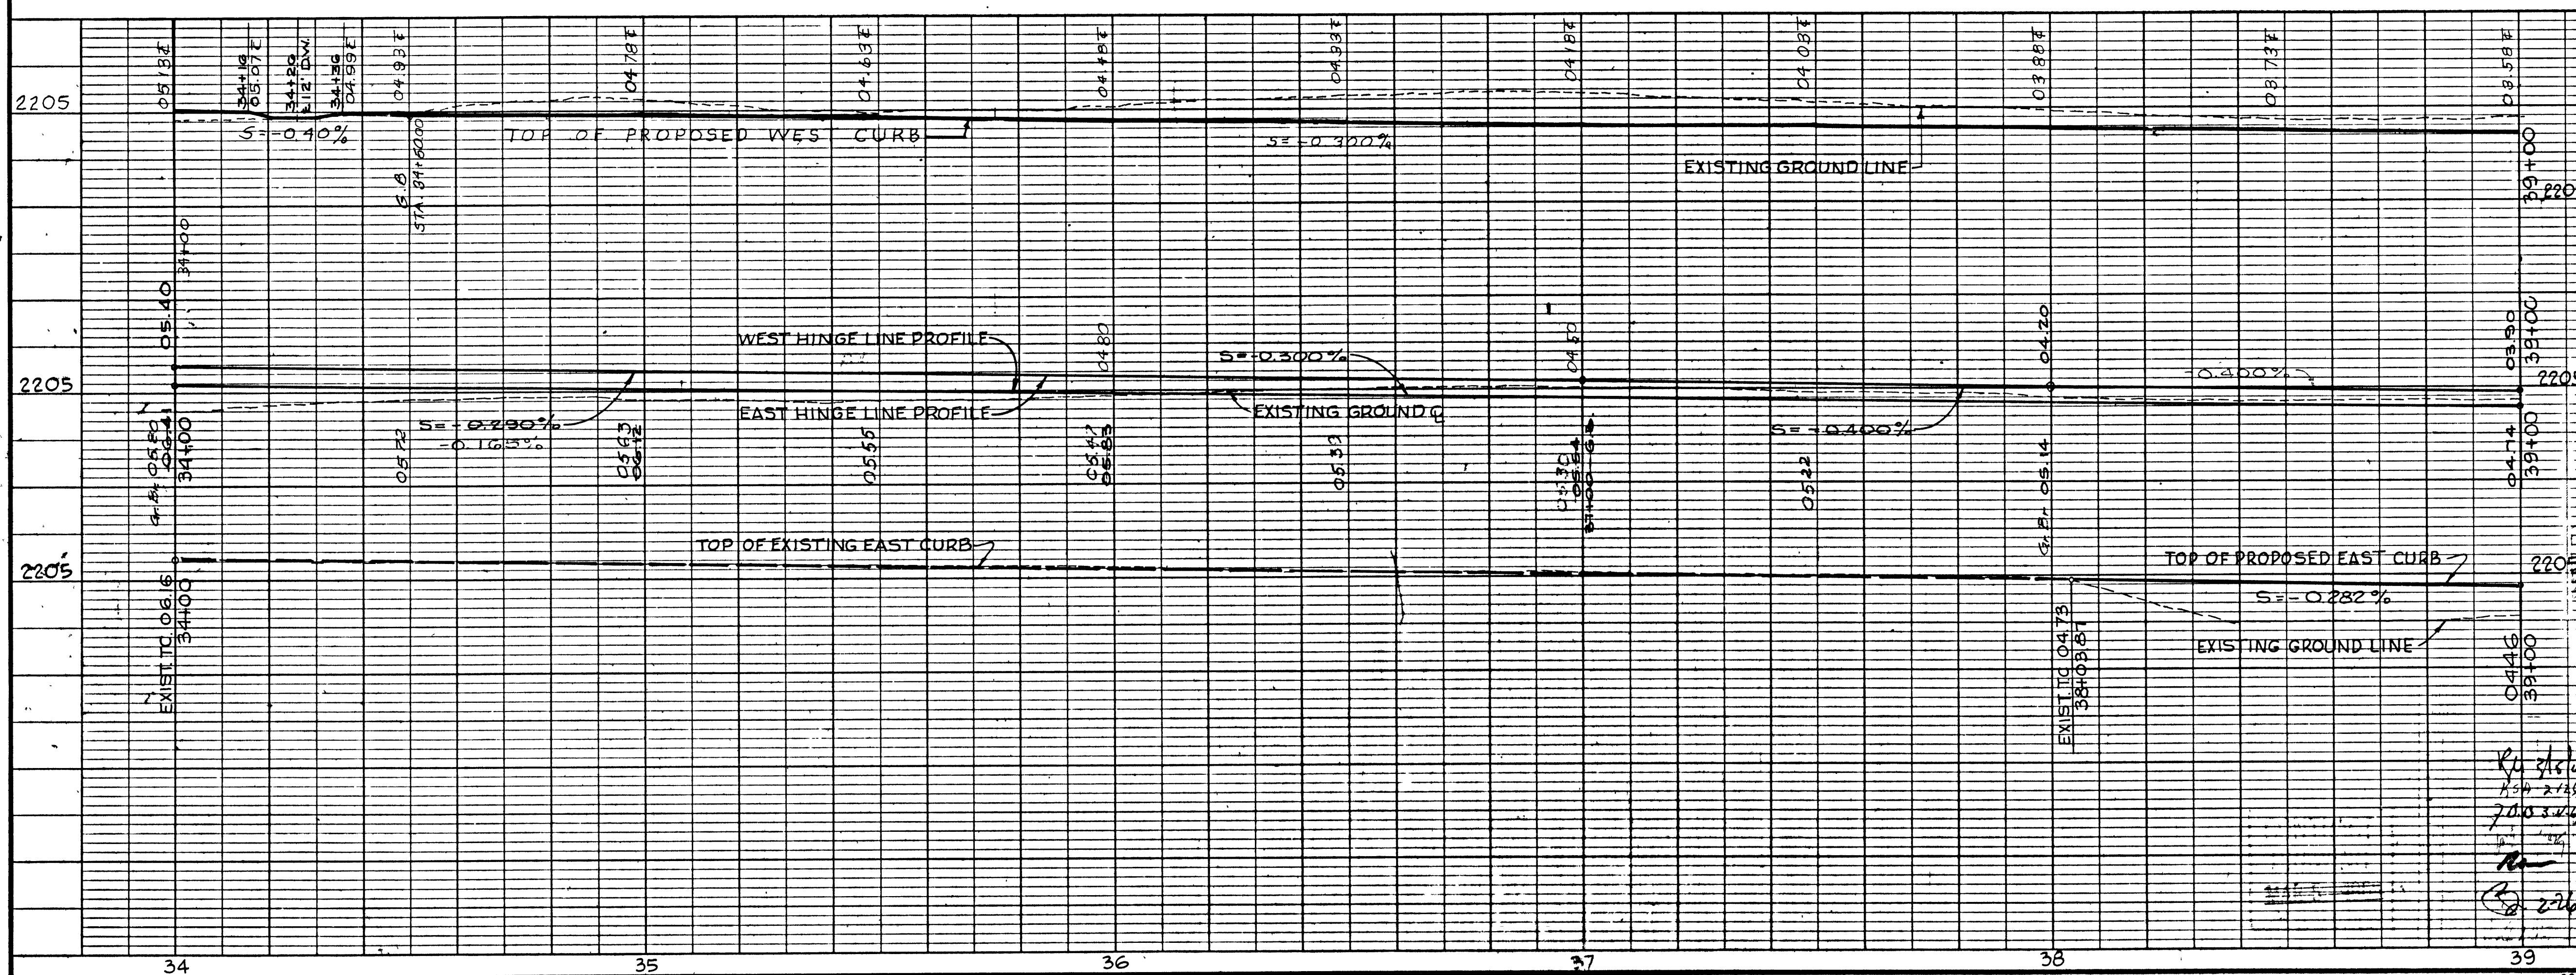


11-4-58

PLAN	BY	DATE
SURVEYED		
PLOTTED		
CHECKED		
RT. OF WAY CHECKED		
NO.		

PROFILE	BY	DATE
SURVEYED		
PLOTTED		
CHECKED		
STRUCTURE NOTATIONS CHECKED		
NO.		

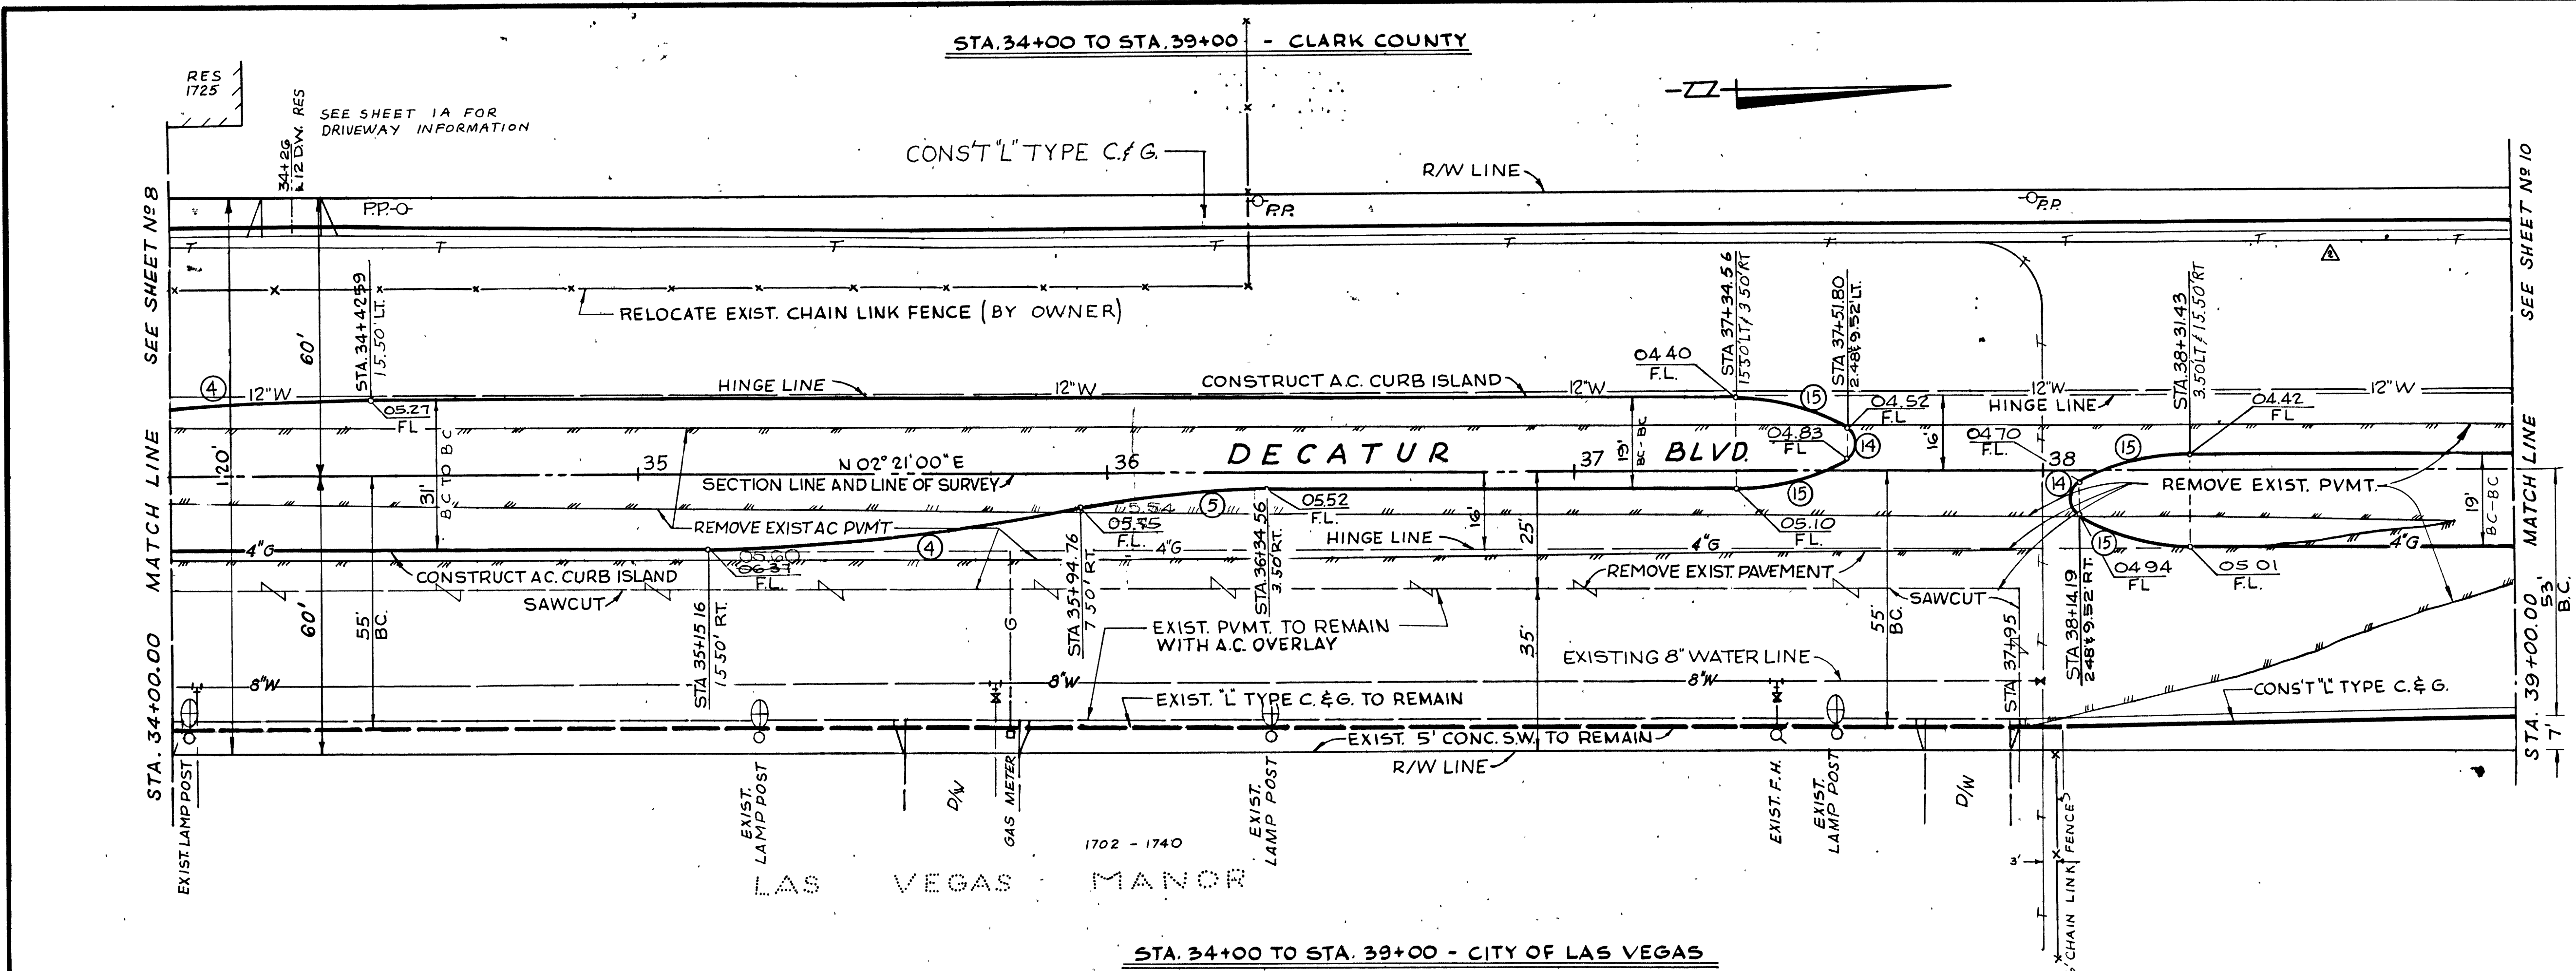

ITEM	DESCRIPTION	R.S.H.	CLV. S.A.D.	CLV.	C.C.S.A.D.	TOTAL	UNIT
201.100	EXCAVATION	110			39	1152	CY
201.100	SAWCUT A.C. PAVEMENT	423				423	L.F.
302.100	TYPE I GRAVEL BASE	316		17	81	414	CY
302.200	TYPE II GRAVEL BASE	316		9	70	395	CY
320.100	BIT. PENETRATION	1176				1176	SY
333.500	1/2\" OPEN GRADE PLANTING	4020		82	387	4489	SY
334.200	A.C. OVERLAY	1141				1141	SY
334.210	A.C. CURB (LAND)	928				928	L.F.
334.212	C.A.C. PAVEMENT	2879		82	387	3348	L.F.
340.190	24\" TYPE CURBOUTLET			105	488	593	L.F.
340.410	RESIDENTIAL DRIVEWAY				108	108	S.F.

CURVE	DELTA	RADIUS	LENGTH	TANGENT
④	11°28'42"	400.00'	80.13'	40.20'
⑤	11°28'42"	200.00'	40.07'	20.10'
⑥	123°23'22"	4.00'	8.61'	7.43'
⑦	28°18'19"	50.00'	24.70'	12.61'

4-4 added tele. conduit
731-9 REVISED GRADE ON EAST HINGE LINE

REV. DATE DESCRIPTION APP.

CITY OF LAS VEGAS, NEVADA
ENGINEERING DEPARTMENT

DECATUR BLVD.
WASHINGTON AVE. TO U.S. HIGHWAY N° 95
STA. 34+00.00 TO STA. 39+00.00

DESIGN	G.E.C.	DATE	12-9-66
DRAWN	HURTADO		
CHECKED	S.C.B.		
CONSULTING ENG.	TYSON ENGINEERING COMPANY INC.		
TRAFFIC ENG.			
CITY ENGINEER			

3/5/69
CLV. DRWG. N° 107V-738
SHEET 9 OF 12

K-E PLATE 1, PLAN-PROFILE
KUEPPEL & EMMER CO.

"AS CONSTRUCTED"

