


11-4-62

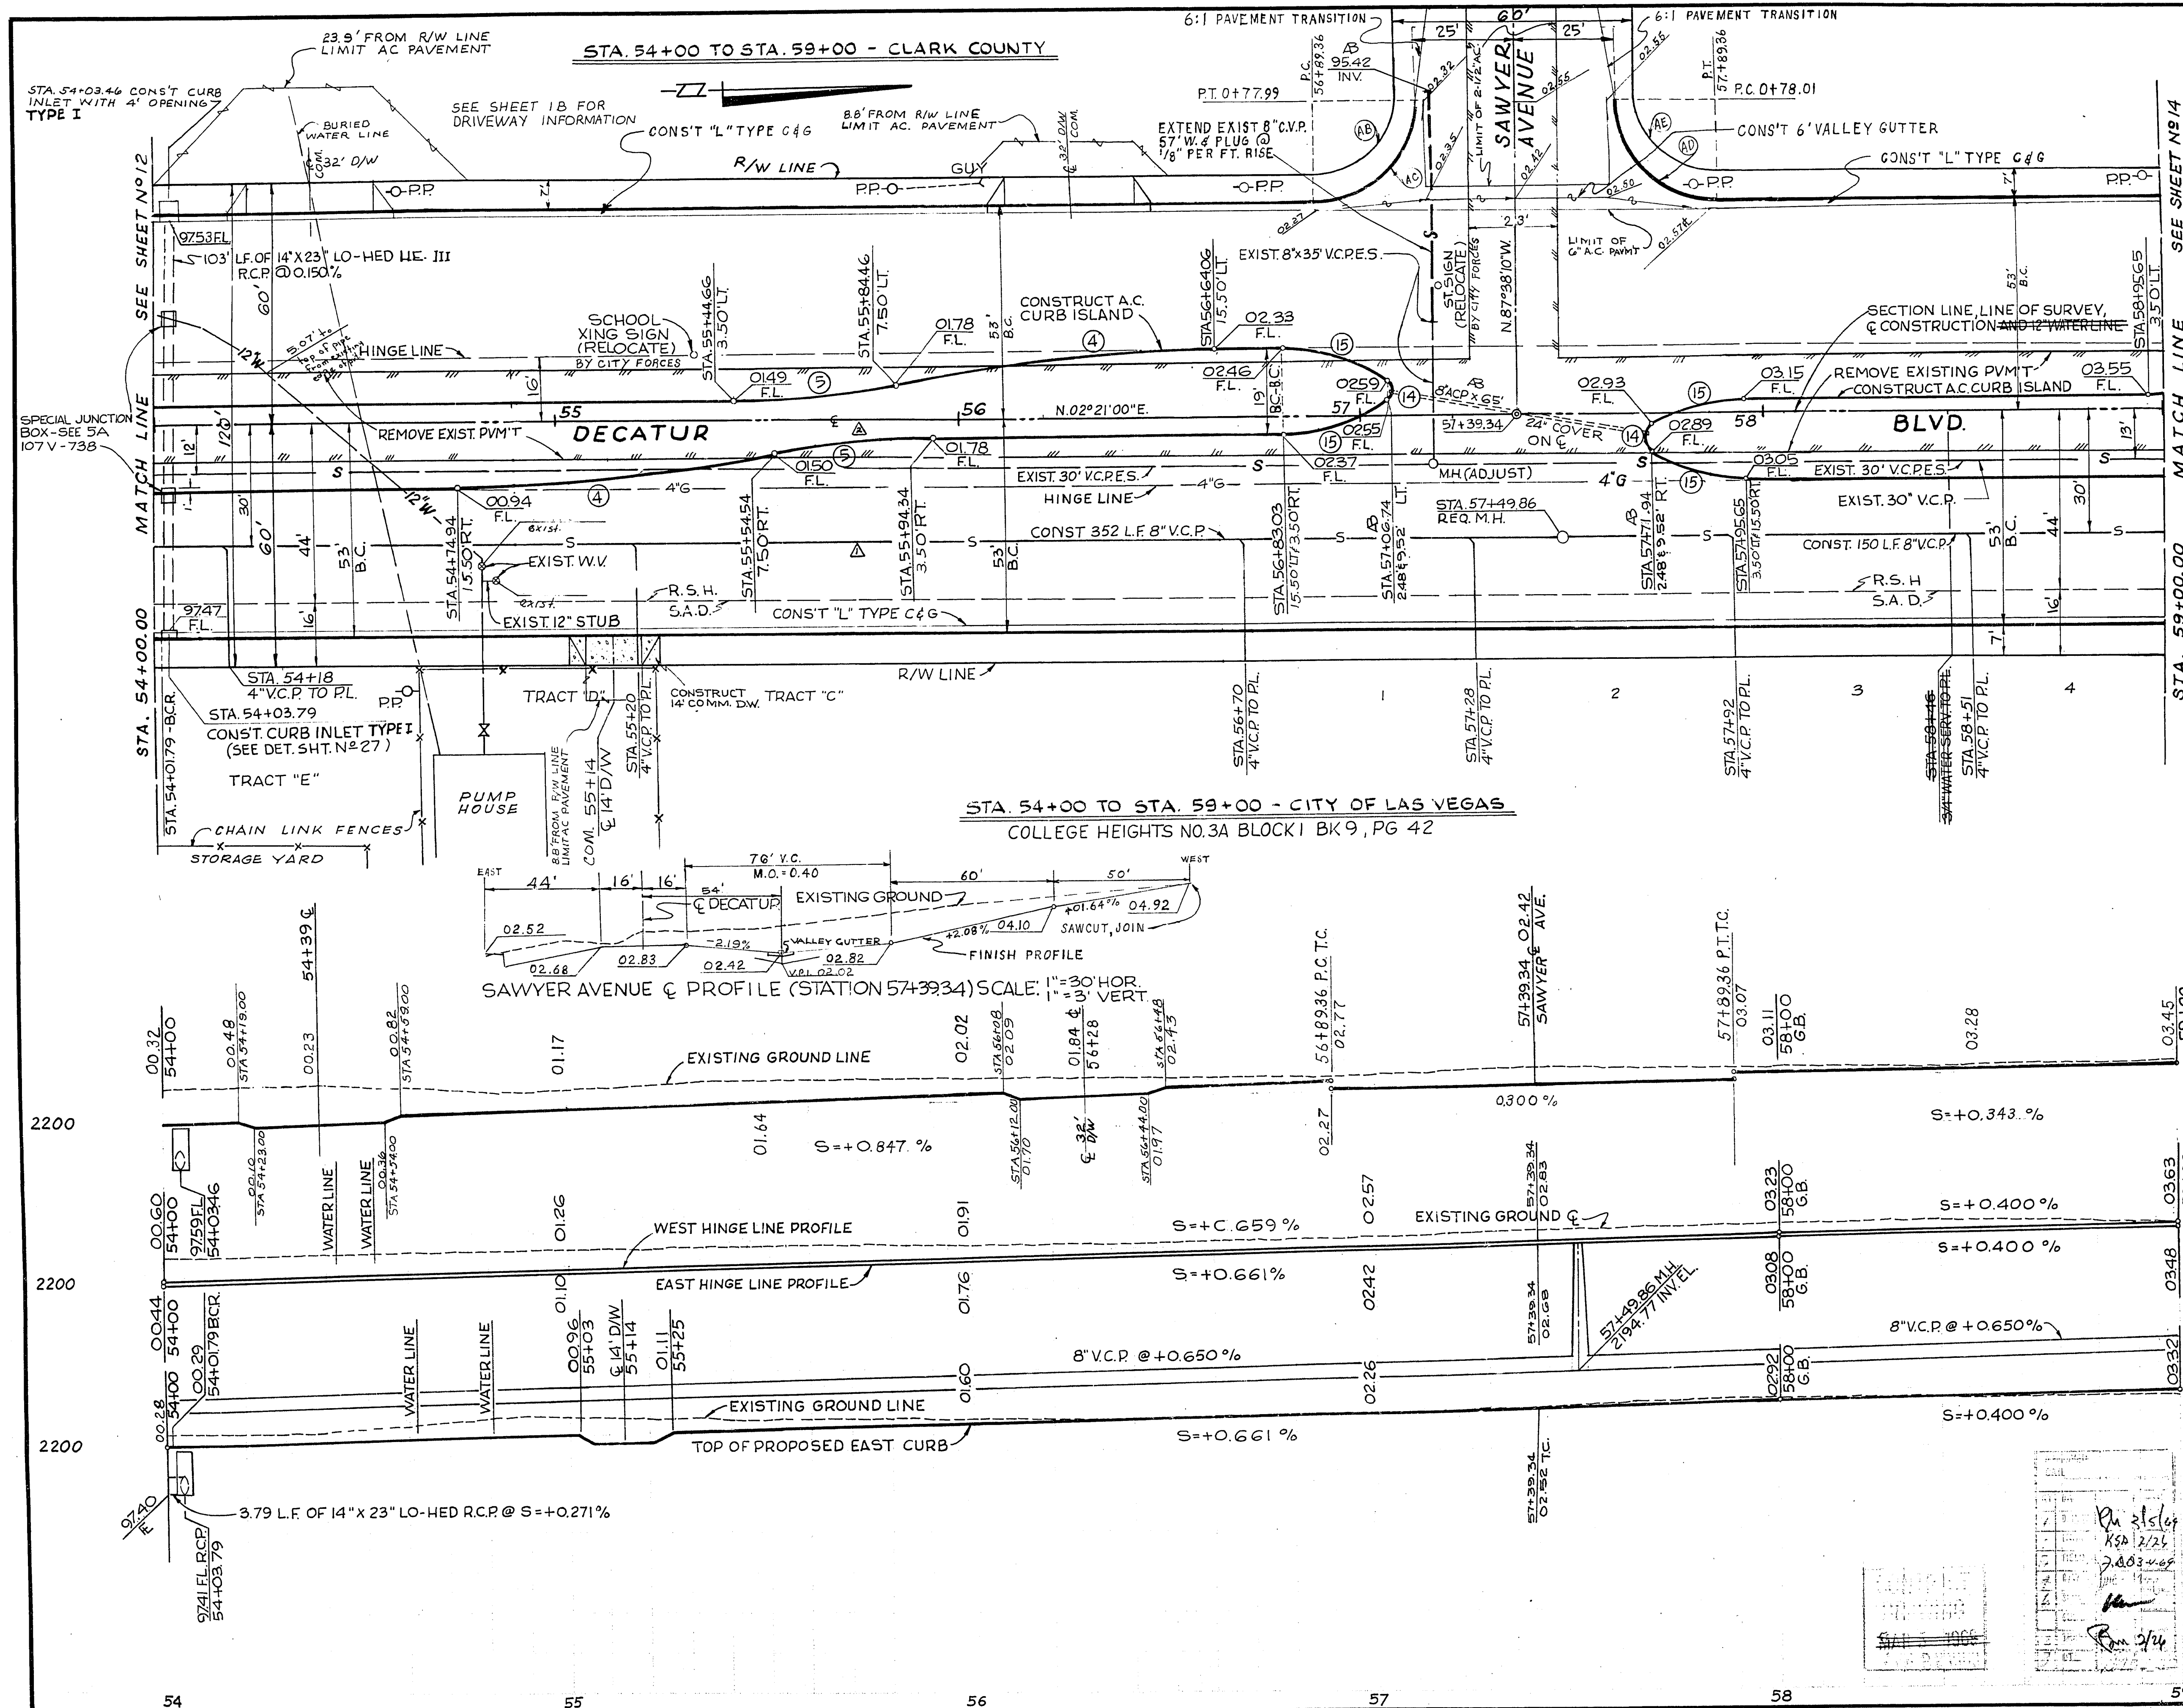

ITEM	DESCRIPTION	C.C. S.A.D.	R.S.H.	CLV. S.A.D.	CLV.	TOTAL	UNIT
121.518	14"X23" LO-HED R.C.P.		103			103	LF
123.208	8" V.C.P.			502	57	559	LF
201.103	EXCAVATION	522	3300	378		4200	C.Y.
201.103	SAWCUT A.C. PAVE	156	22			178	LF
201.103	TYPET GRAVEL	96	555	83		734	C.Y.
302.220	TYPET GRAVEL	57	511	46		614	C.Y.
320.103	BIT PENETRATION		907			907	S.Y.
333.103	BIT FOG SEAL	185	535			720	S.Y.
333.200	1/2" O.G. PLANT MIX	311	4106	389		4806	S.Y.
334.210	A.C. CURB		892			892	LF
334.212	6" A.C. PAVEMENT	311	4106	389		4806	S.Y.
334.300	1-1/2" A.C. PAVEMENT	185	122			307	S.Y.
334.500	2-1/2" A.C. PAVEMENT		413			413	S.Y.
340.190	24" CURB & GUTTER	478		486		964	LF
340.420	COMM. DRIVEWAY	432		126		558	S.F.
340.500	VALLEY GUTTER	752	752			1504	LF
500.200	CURB INLET					2	EACH
512.500	ADJUST MANHOLE					1	EACH
N.I.C.	RELOCATE SIGN					2	EACH
123.204	4" V.C.P.			180		180	LF
512.100	MANHOLE					1	EACH

NO	DELTA	RADIUS	LENGTH	TANGENT
(A)	11°28'42"	400.00'	80.13'	40.20'
(B)	11°28'42"	200.00'	40.07'	20.10'
(C)	123°23'22"	4.00'	8.61'	7.43'
(D)	28°18'18"	50.00'	24.70'	12.61'
(E)	89°59'10"	20.00'	31.41'	20.00'
(F)	89°59'10"	25.00'	39.26'	24.99'
(G)	90°00'50"	25.00'	39.28'	25.01'
(H)	90°00'50"	20.00'	31.42'	20.00'

327-69

INSTALL 8" V.C.P.

327-69

REMOVE WATER LINE

REV

DATE

DESCRIPTION

APP

CITY OF LAS VEGAS, NEVADA

ENGINEERING DEPARTMENT

DECATUR BLVD.

WASHINGTON AVE. TO U.S. HIGHWAY NO 95

STA. 54+00.00 TO STA. 59+00.00

W.O. TESTO & ASSOC.

DATE

HORIZONTAL SCALE

DESIGN

G.E.C.

12-10-62

1" = 20'

DRAWN

MURTAO

5-17-63

VERTICAL SCALE

CHECKED

S.C.P.

5-17-63

1" = 5'

CONSULTING ENG.

5-17-63

F.B.N.

TRAFFIC ENG.

CITY ENGINEER

PREPARED BY

TYSON ENGINEERING COMPANY INC.

SHEET 13 OF 42

CLV. DRWG. NO

107V-738

"AS CONSTRUCTED"

107V-738