


11-1-63

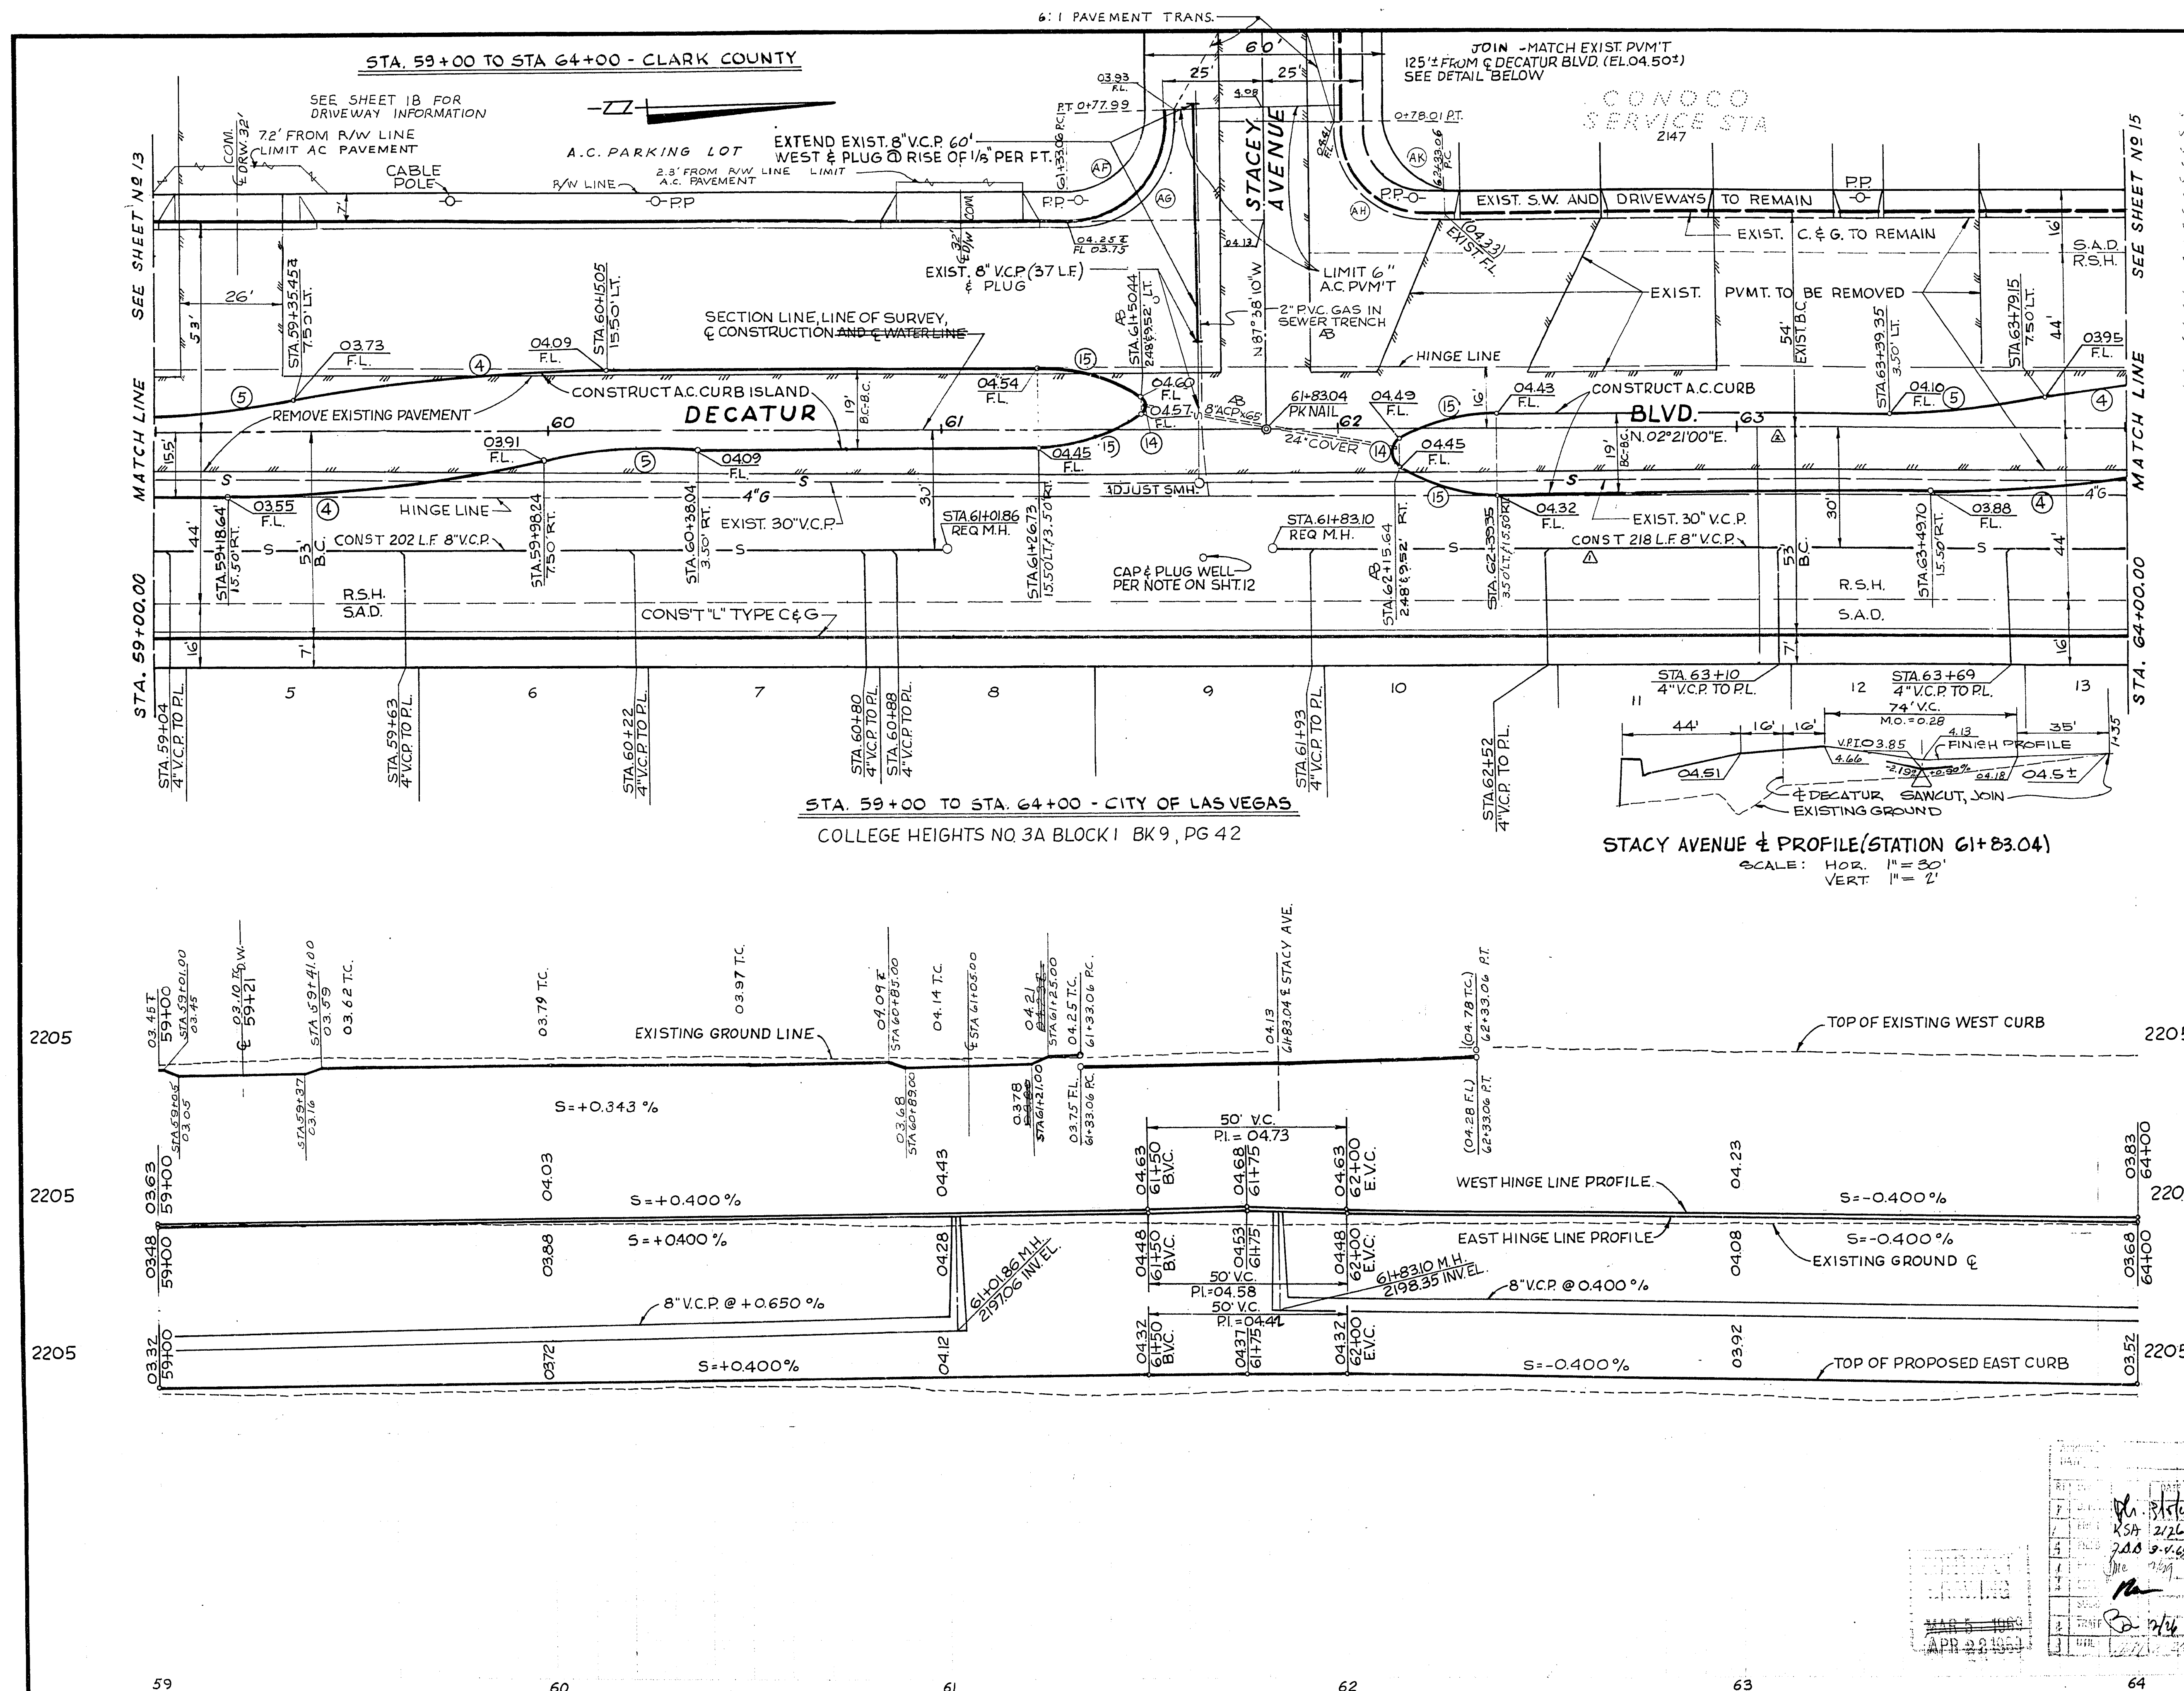

| ITEM    | DESCRIPT             | CC  | RSH. | CLV  | CLV | TOTAL | UNIT |
|---------|----------------------|-----|------|------|-----|-------|------|
| 123.204 | 4" V.C.P.            |     |      | 270  |     | 270   | LF   |
| 123.208 | 8" V.C.P.            |     |      | 42.0 | 60  | 480   | LF   |
| 201.100 | EXCAVATION           | 146 | 727  | 101  |     | 974   | C.Y. |
| 201.100 | SAWCUT A.C. PVT      | 92  | 22   |      |     | 114   | LF   |
| 302.100 | TYPE I GRAVEL        | 53  | 475  | 83   |     | 611   | C.Y. |
| 302.200 | TYPE II GRAVEL       | 43  | 475  | 43   |     | 561   | C.Y. |
| 320.100 | BIT. PENETRATION     |     | 994  |      |     | 994   | S.Y. |
| 333.100 | BIT. FOG SEAL        | 40  | 345  |      |     | 385   | S.Y. |
| 333.500 | 1/2" O.G. PLANT MIX  | 311 | 3972 | 389  |     | 4672  | S.Y. |
| 334.210 | A.C. CURB            |     | 890  |      |     | 890   | LF   |
| 334.212 | G" A.C. PAVEMENT     | 311 | 3972 | 389  |     | 4672  | S.Y. |
| 334.300 | 1/2" A.C. PAVEMENT   | 40  | 63   |      |     | 103   | S.Y. |
| 334.500 | 2 1/2" A.C. PAVEMENT |     | 282  |      |     | 282   | S.Y. |
| 340.100 | 24" TYPE CURB & GUT  | 208 |      | 500  |     | 708   | LF   |
| 340.410 | RES. DRIVEWAY        | 576 |      |      |     | 576   | S.F. |
| 500.901 | PLUG WELL            |     | 1    |      |     | 1     | EA.  |
| 512.100 | MANHOLE              |     |      | 2    |     | 2     | EA.  |
| 512.510 | ADJUST MANHOLE       |     |      |      | 1   | 1     | EA.  |

| CURVE | DELTA        | RADIUS  | LENGTH | TANGENT |
|-------|--------------|---------|--------|---------|
| (4)   | 11° 28' 42"  | 400.00' | 80.13' | 40.20'  |
| (5)   | 11° 28' 42"  | 200.00' | 40.07' | 20.10'  |
| (4)   | 123° 23' 22" | 4.00'   | 8.61'  | 7.43'   |
| (5)   | 28° 18' 19"  | 50.00'  | 24.20' | 12.61'  |
| (4)   | 89° 59' 10"  | 20.00'  | 31.41' | 20.00'  |
| (4)   | 89° 59' 10"  | 25.00'  | 39.26' | 24.99'  |
| (4)   | 90° 00' 50"  | 25.00'  | 39.28' | 25.01'  |
| (4)   | 90° 00' 50"  | 20.00'  | 31.42' | 20.00'  |

|        |                     |
|--------|---------------------|
| 327.69 | CONSTRUCT 8" V.C.P. |
| 327.69 | REMOVE WATER LINE   |

REV. DATE DESCRIPTION APP

CITY OF LAS VEGAS, NEVADA  
ENGINEERING DEPARTMENT

**DECATUR BLVD.**  
WASHINGTON AVE. TO U.S. HIGHWAY N° 95  
STA. 59+00.00 TO STA. 64+00.00

|                  |         |                  |
|------------------|---------|------------------|
| W.O. 75 TO 14810 | DATE    | HORIZONTAL SCALE |
| DESIGN           | G.E.C.  | 1" = 20'         |
| DRAWN            | HURTADO | VERTICAL SCALE   |
| CHECKED          |         | 1" = 5'          |
| CONSULTING ENG.  |         |                  |
| TRAFFIC ENG.     |         |                  |
| CITY ENGINEER    |         |                  |

PREPARED BY  
TYSON ENGINEERING COMPANY INC.

SHEET 14 OF 42

"AS CONSTRUCTED"

107-V-738