


11-4-65

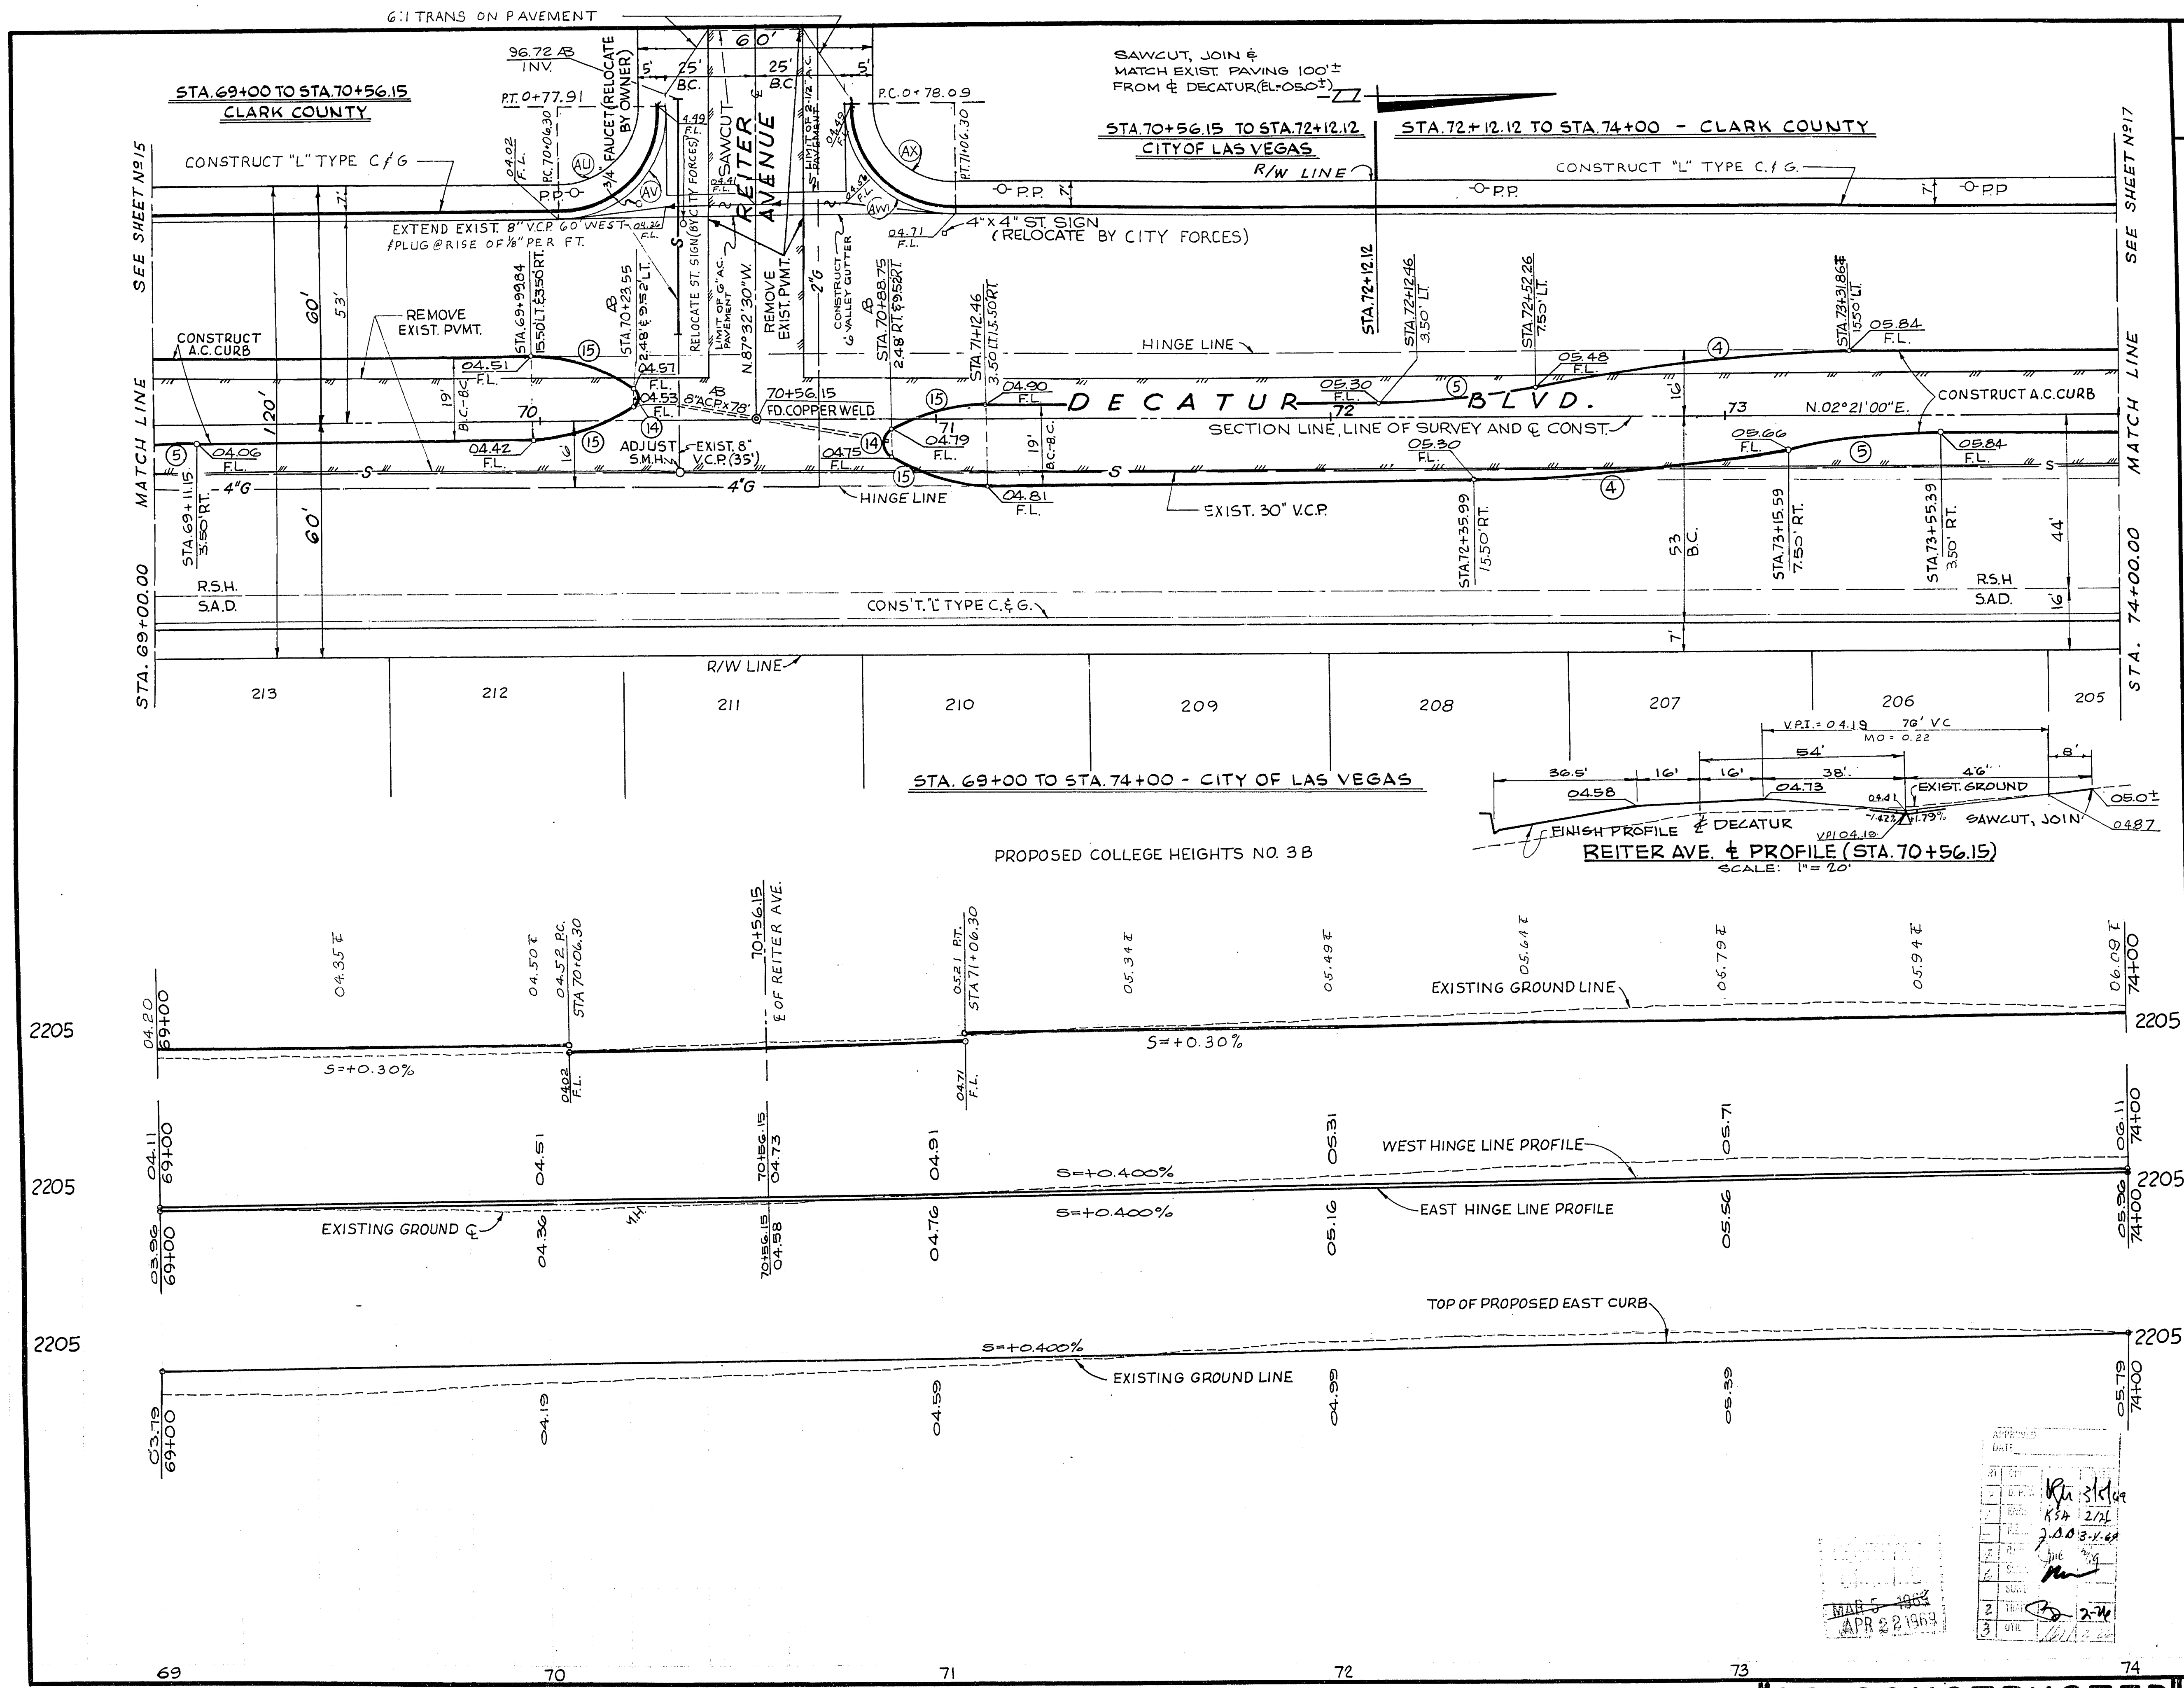

ITEM	DESCRIPTION	RSH	CLV S&D	CLV	CCS&D	TOTAL	UNIT
123.208	8" V.C.P.					240	LF
123.208	8" V.C.P.					500	LF
201.100	EXCAVATION	1865				2305	CY
201.100	SAWCUT A.C. PAVEMENT	22			190	28	LF
302.100	TYPE I GRAVEL BASE	48431				609	CY
302.200	TYPE I GRAVEL BASE	481				558	CY
320.100	BIT. PENETRATION	1016				1016	SY
333.100	BIT. FOG SEAL	257				257	SY
333.100	1/2" OPEN GRADE PLANK	3944				4645	SY
334.210	A.C. CURB (5' LAND)	893				893	LF
334.300	A.C. PAVEMENT	3944				4645	SY
334.500	1/2" A.C. PAVEMENT	161				96	SY
340.190	8" TYPE CURB GUTTER	161				161	LF
340.500	VALLEY GUTTER	752				752	LF
512.510	MANHOLE					2	EACH
512.510	ADJUST MANHOLE					2	EACH
483.204	N.I.C. RELOCATE SIGN					2	EACH
483.204	4" V.C.P.					240	LF

CURVE	DELTA	RADIUS	LENGTH	TANGENT
④	11°28'42"	400.00'	80.13'	40.20'
⑤	11°28'42"	200.00'	40.07'	20.10'
⑥	123°23'22"	4.00'	8.61'	7.43'
⑦	28°18'19"	50.00'	24.70'	12.61'
⑧	89°53'30"	20.00'	31.38'	19.96'
⑨	89°53'30"	25.00'	39.22'	24.95'
⑩	90°06'30"	25.00'	39.32'	25.05'
⑪	90°06'30"	20.00'	31.45'	20.04'

327-69 CONSTRUCT 8" V.C.P.
4-16-69 REMOVED 8" V.C.P.

REV. DATE DESCRIPTION APP

CITY OF LAS VEGAS, NEVADA
ENGINEERING DEPARTMENT

DECATUR BLVD.
WASHINGTON AVE. TO U.S. HIGHWAY No 95
STA. 69+00.00 TO STA. 74+00.00

W.D. 757014810	DATE	HORIZONTAL SCALE
DESIGN G.E.C.		1" = 20'
DRAWN HURTADO	11-21-66	VERTICAL SCALE
CHECKED S.C.D.		1" = 5'
CONSULTING ENG. <i>Frank E. Russell</i>	5-7-68	F.B. No
TRAFFIC ENG.		
CITY ENGINEER		
<i>APR 5 1968</i>	3/5/69	CLV. DRWG. No
<i>APR 22 1969</i>		107V-738
PREPARED BY TYSON ENGINEERING COMPANY INC.		SHEET 16 OF 42

"AS CONSTRUCTED"

107-V738