
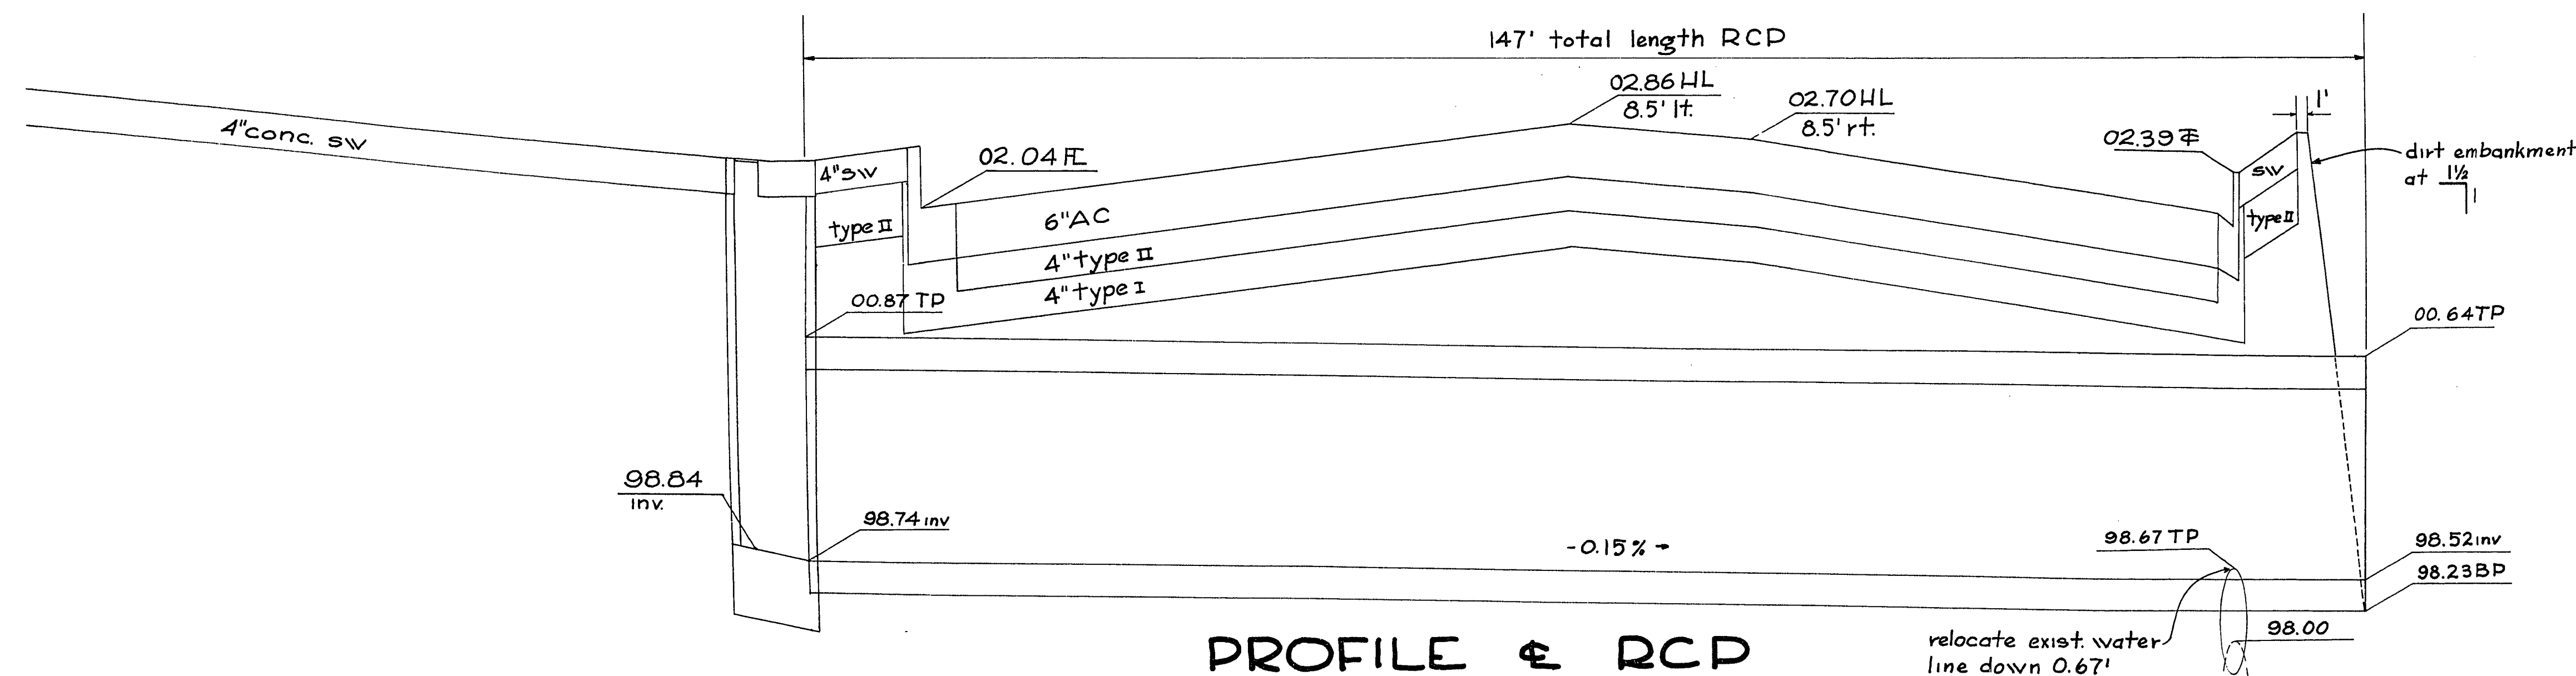


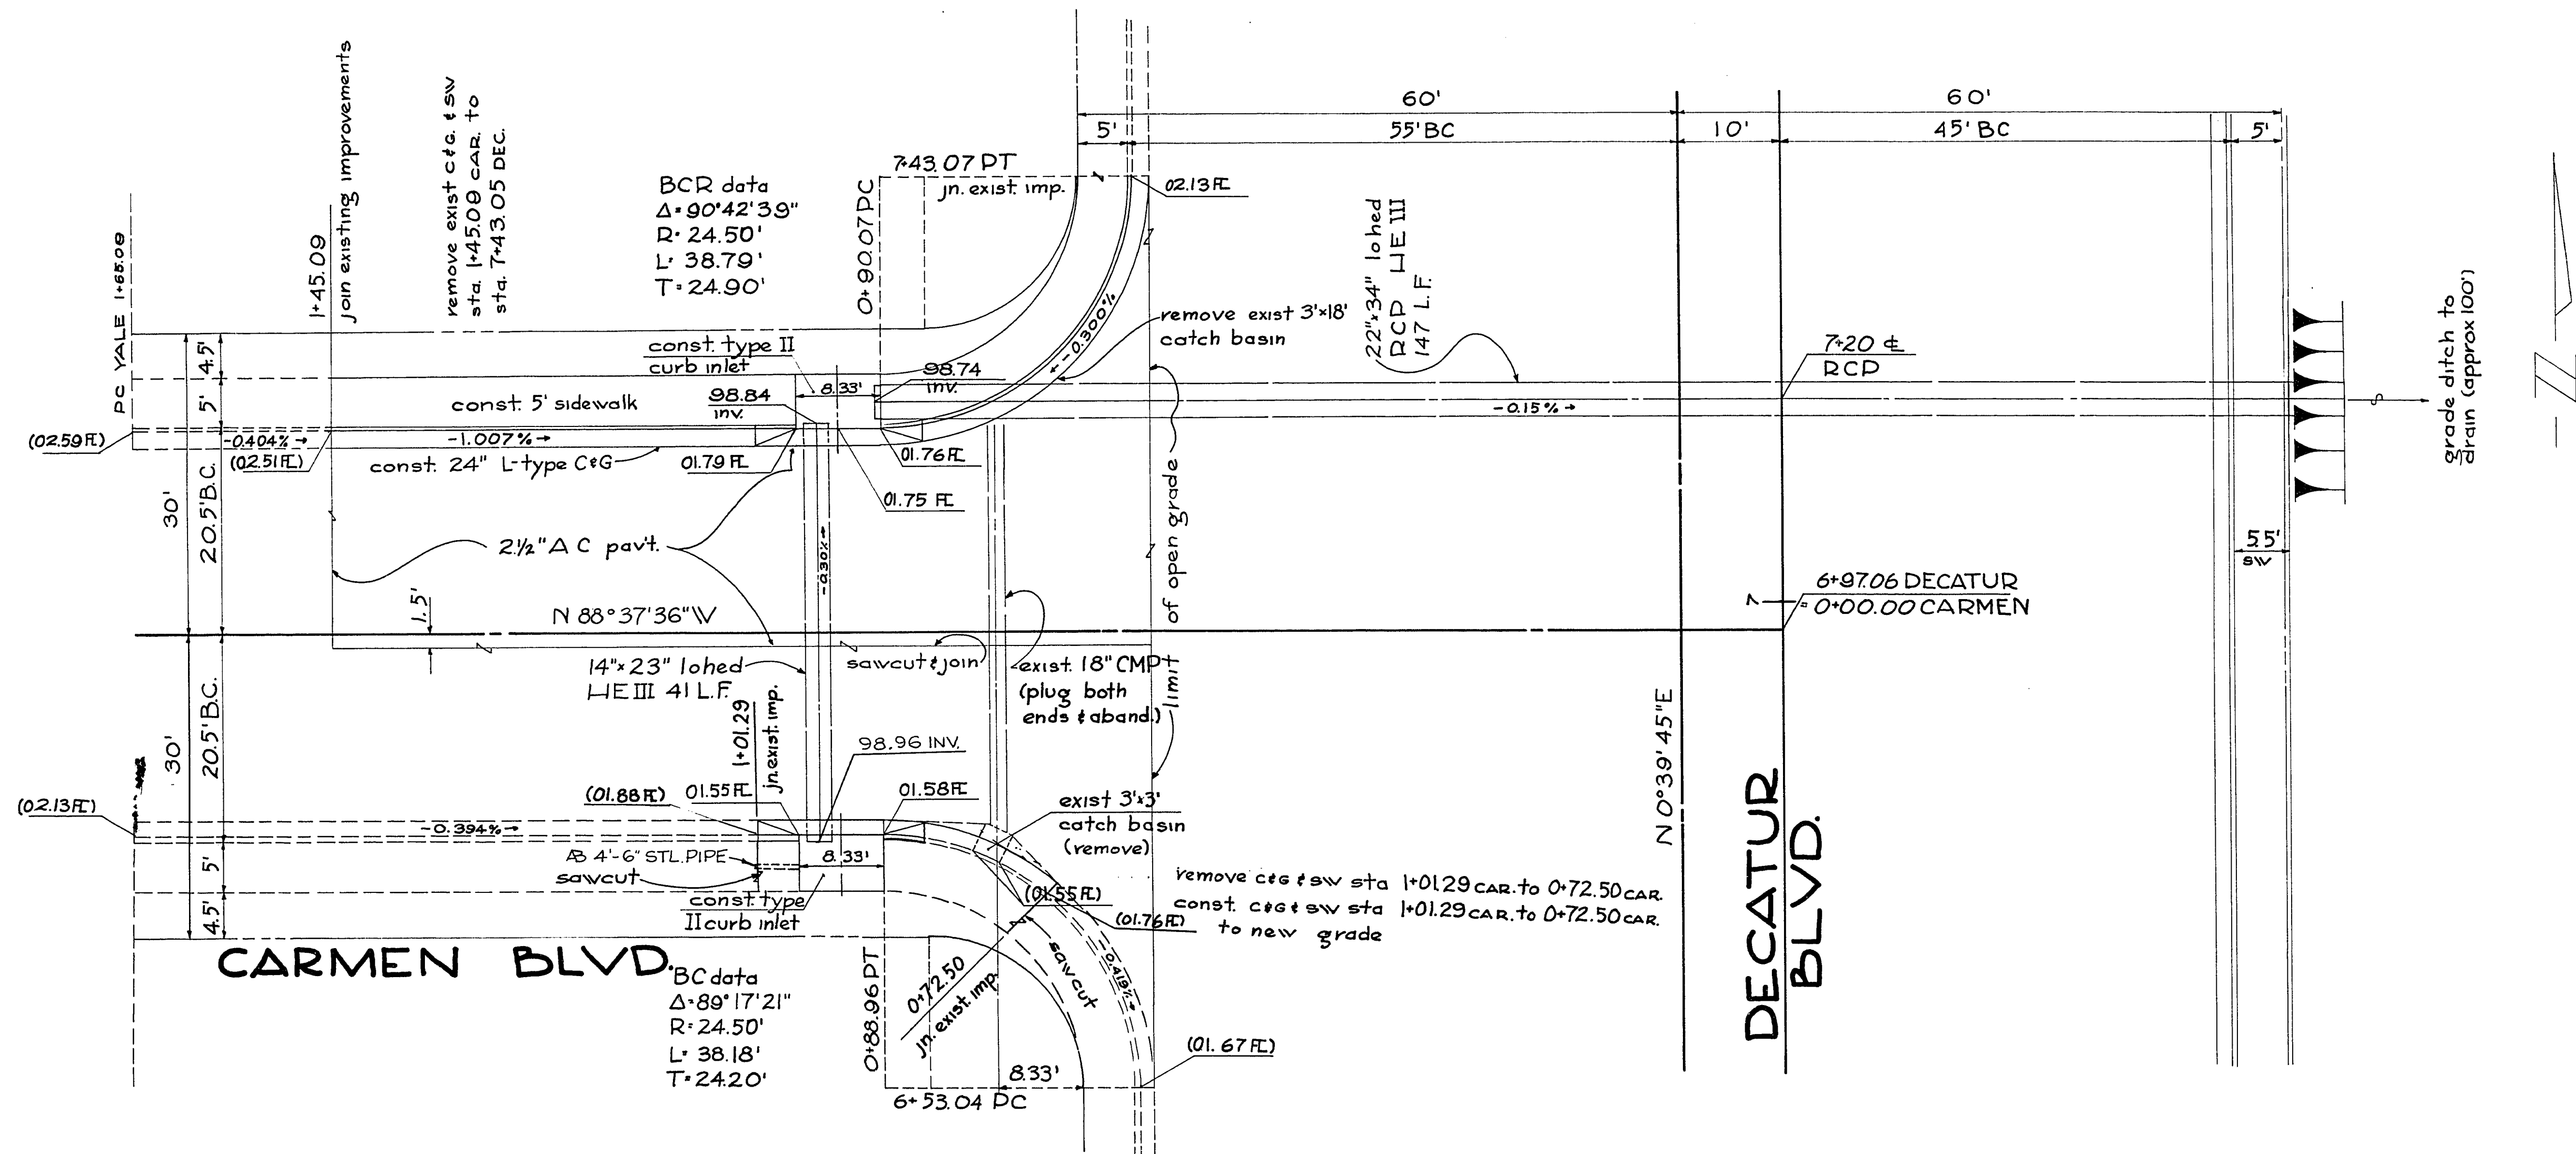

PROFILE & RCP

"AS CONSTRUCTED"

CONTRACT
DRAWING
107V-738

RT	DIV	DATE
4	D. P. W.	
1	ENGR.	6/24/78
2	FIELD	7/28/78
3	SUBV.	8/1/78
	TRAP	
	UTIL	

CITY OF LAS VEGAS NEVADA DEPARTMENT OF PUBLIC WORKS SERVICES DIVISION			
DECATUR BLVD.; WASHINGTON- TONOPAH HY. PLAN & PROFILE RCP @ CARMEN BLVD.			
W.O. NO. 757014810	F.B.K. NO. —	DATE	DRAWING NO.
SC. (H) 1"=10'	SC. (V) 1"=1'	4/17/69	107V-738
DES. G. BILLINGSBLEY		FILE NO.	
APPROVED BY DIRECTOR OF PUBLIC WORKS		SHEET 26A OF 42	