



11-4-42

PLAN
UNREVIEWED
NOTED WORK
BY
DATE

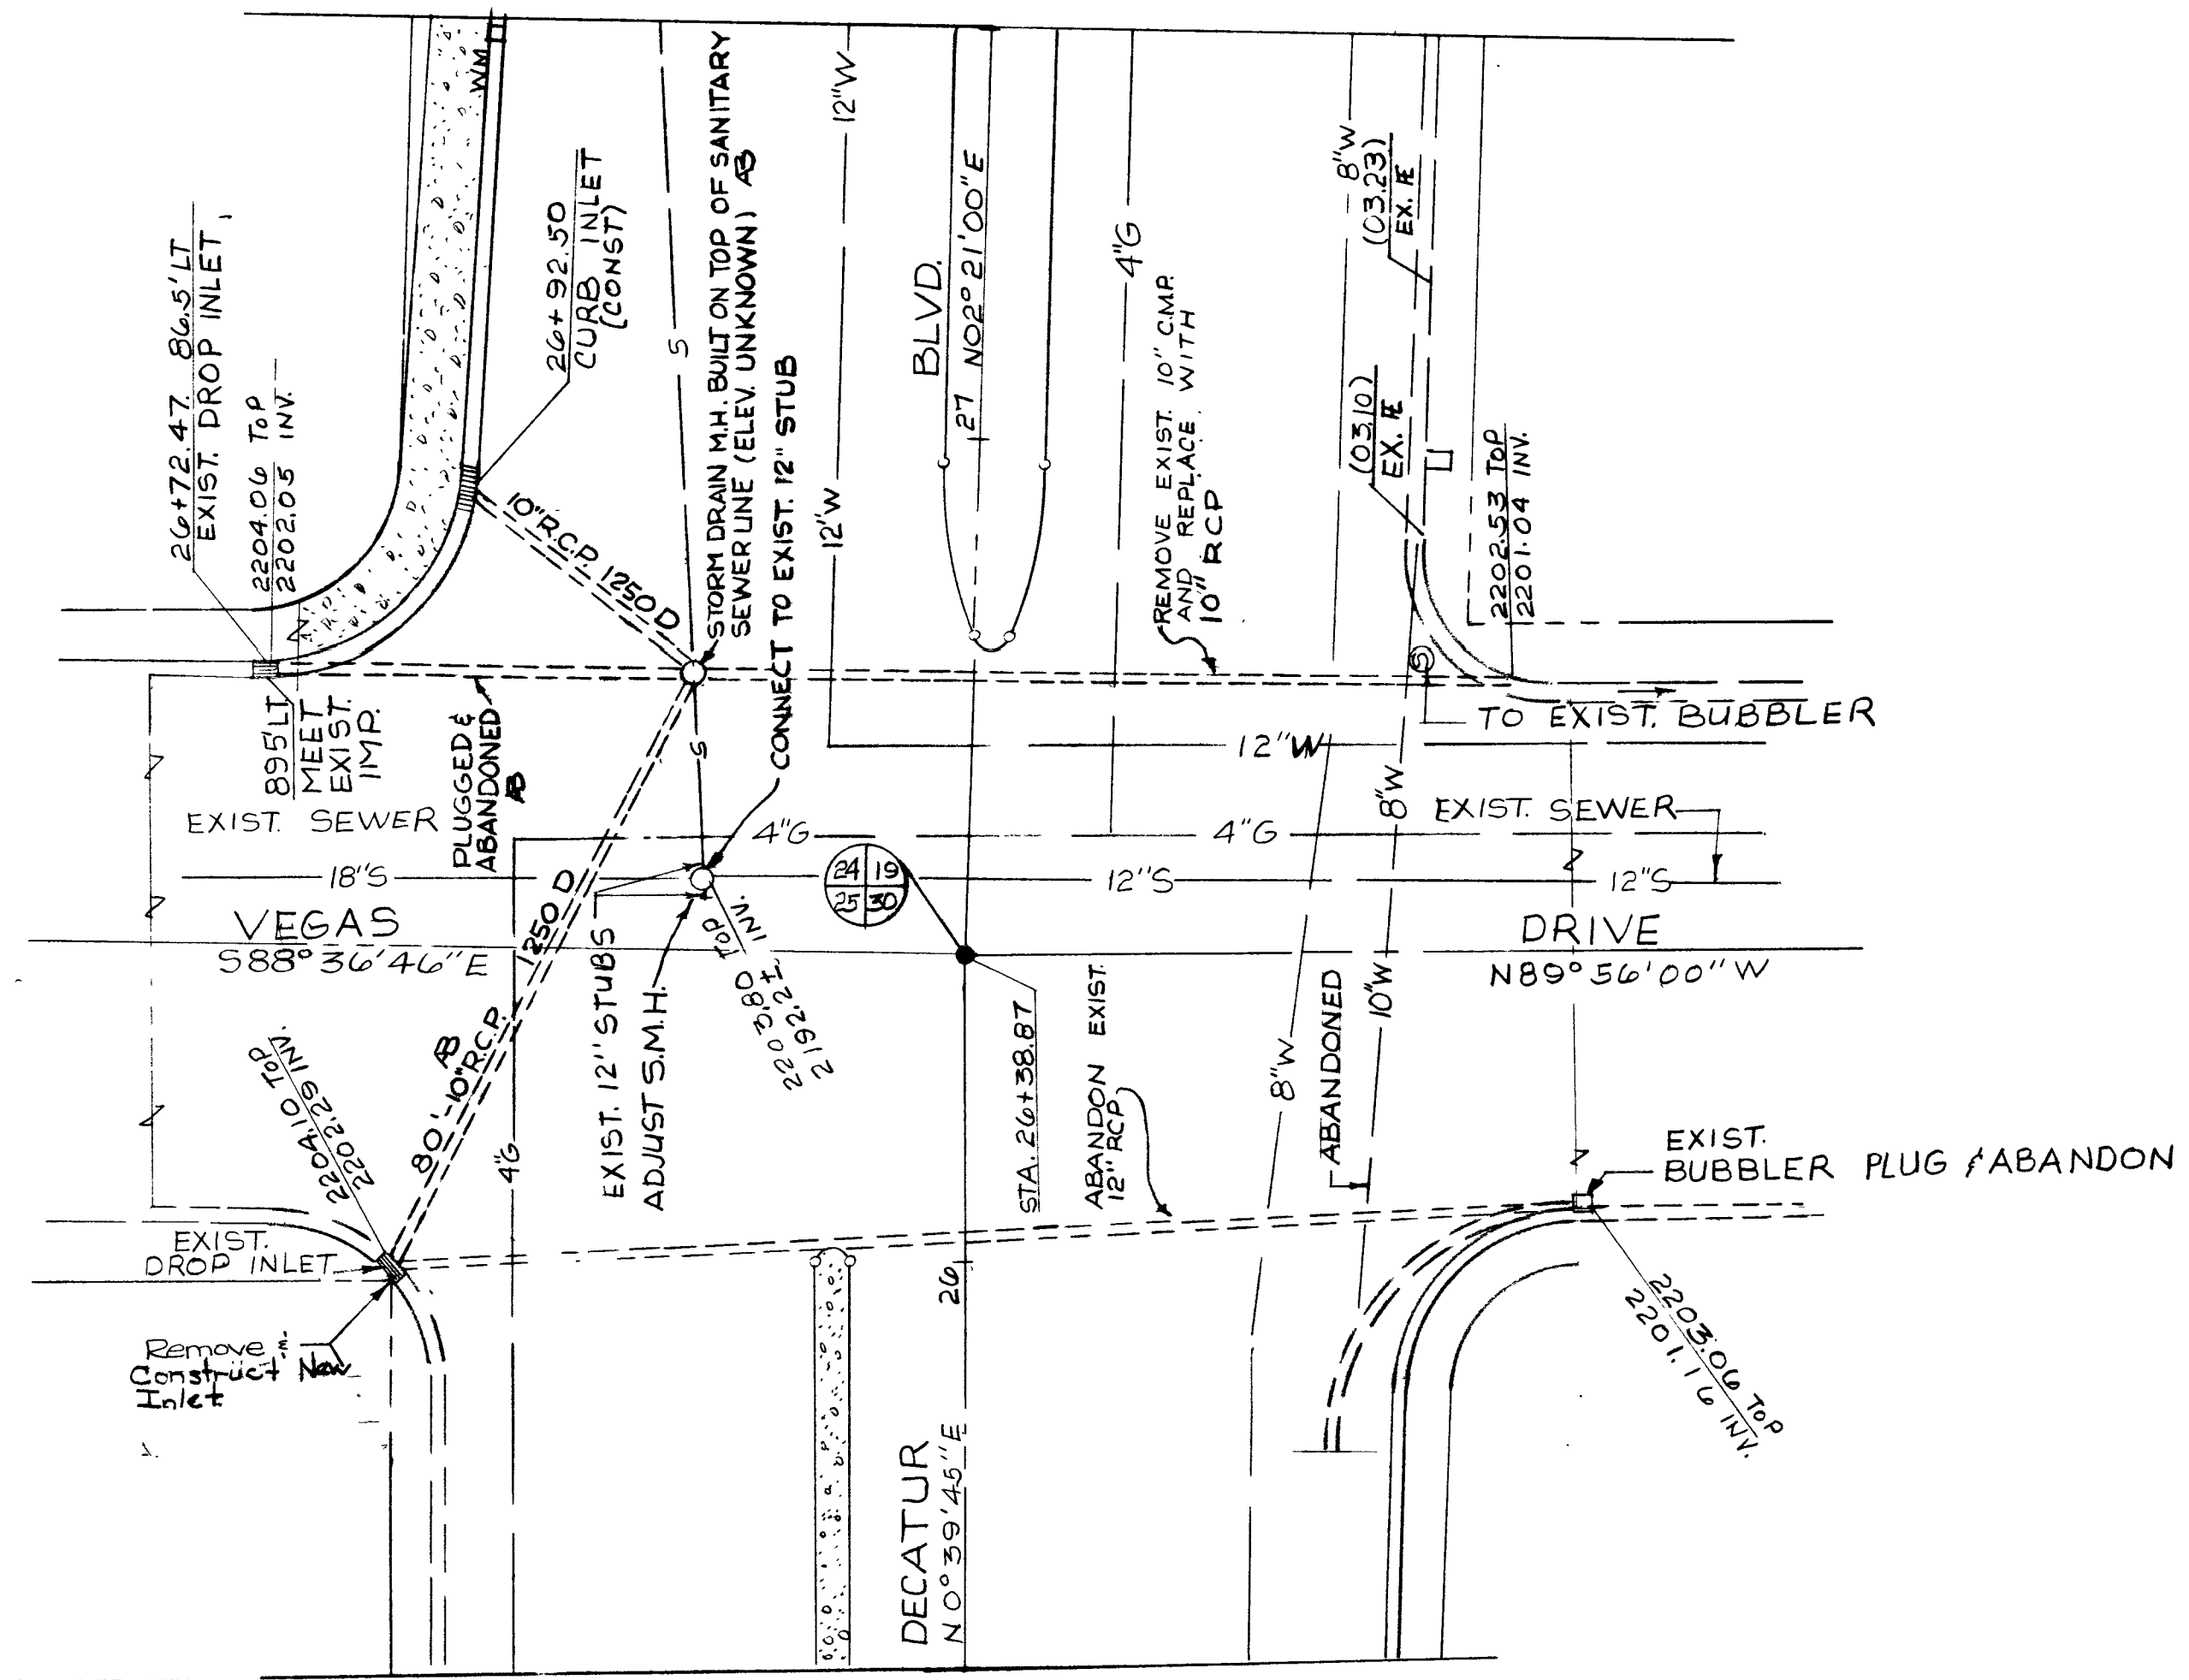

PROFILE
UNREVIEWED
NOTED WORK
BY
DATE

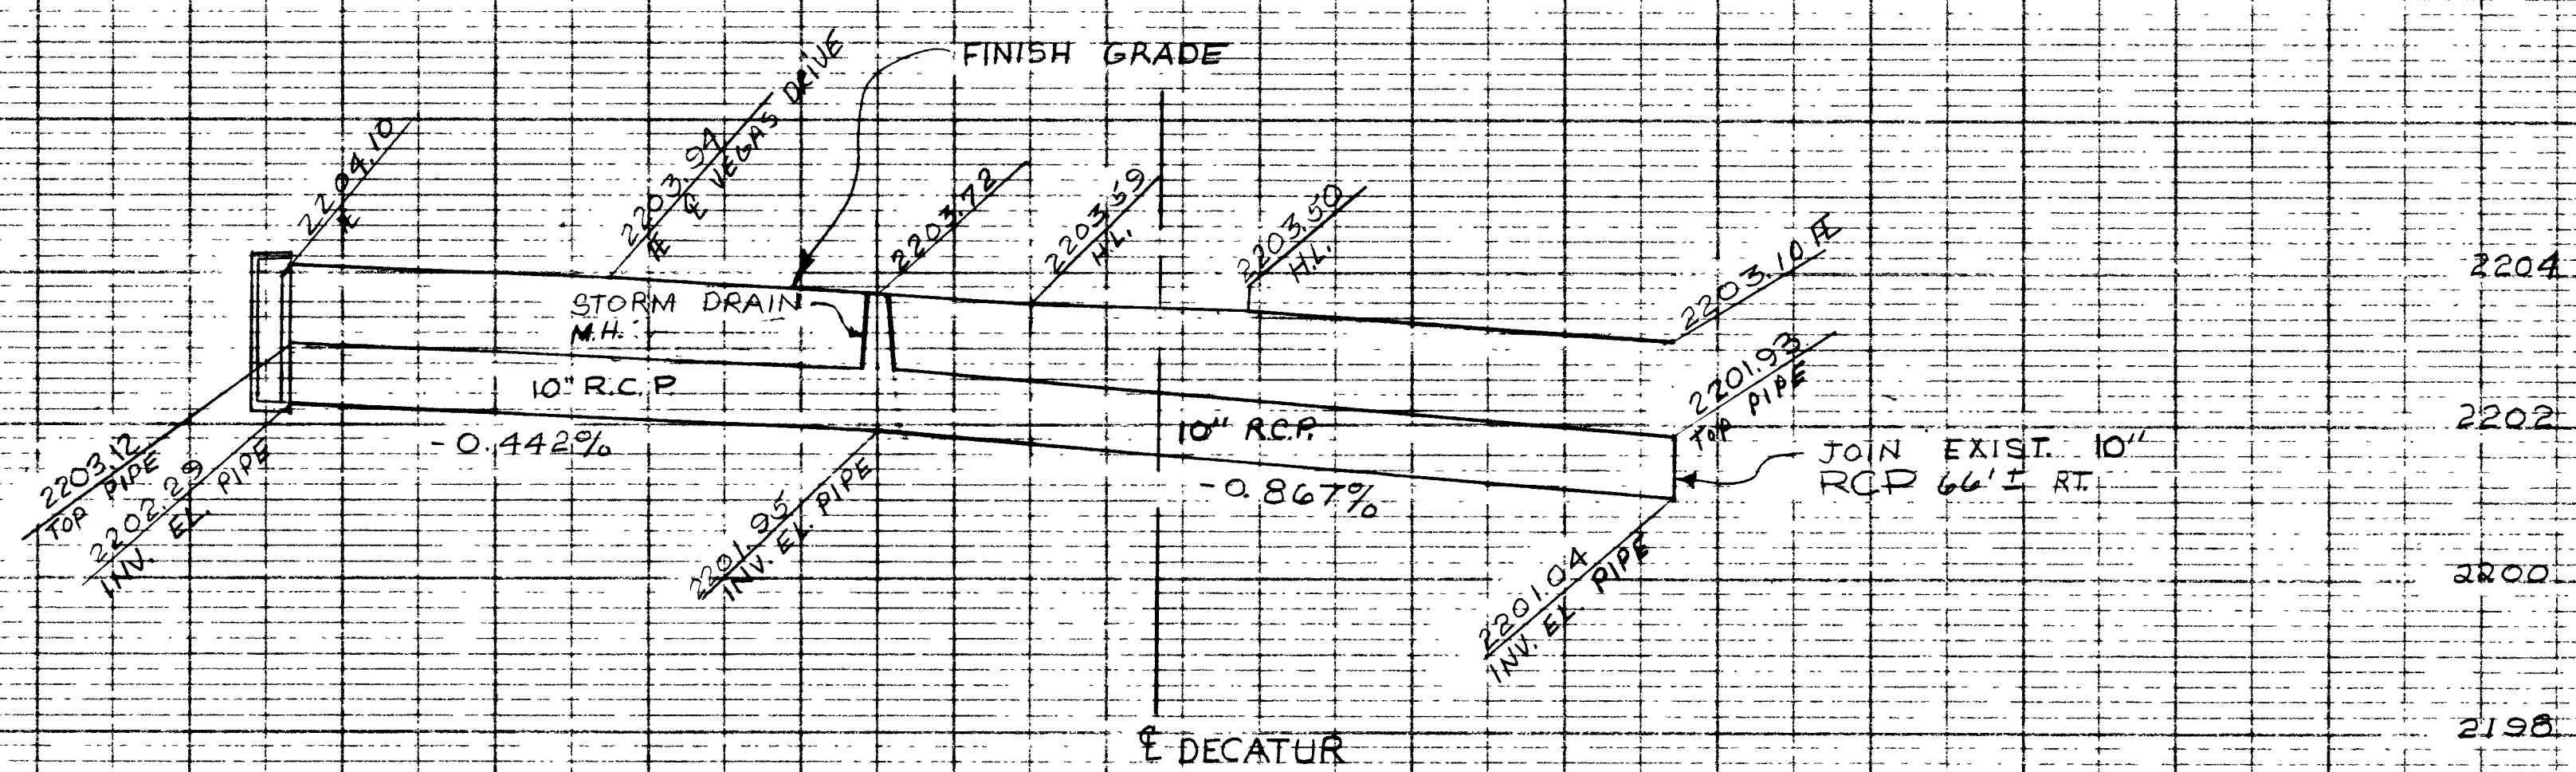

APPROVED *[Signature]* 8/15/69
DIRECTOR OF PUBLIC WORKS
DATE

APPROVED *[Signature]* 8/15/69
MANAGING ENGINEER RSEHC
DATE

CITY OF LAS VEGAS NEVADA			
DEPARTMENT OF PUBLIC WORKS			
SERVICES DIVISION			
INTERSECTION DECATUR & VEGAS DRIVE - FIELD CONSTRUCTION SK. 1			
W.O. NO. 7570	DESIGN NO. 4810	DATE	DRAWING NO.
SC. (H) 1" = 20'	SC. (V) 1" = 2'	8/14/69	102V738
DES. CHG.		FILE NO.	
DR. C. KREHNOVI		FILE NO.	
APPROVED BY DIRECTOR OF PUBLIC WORKS		8/15/69	SHEET A OF A

"AS CONSTRUCTED"
2100

