
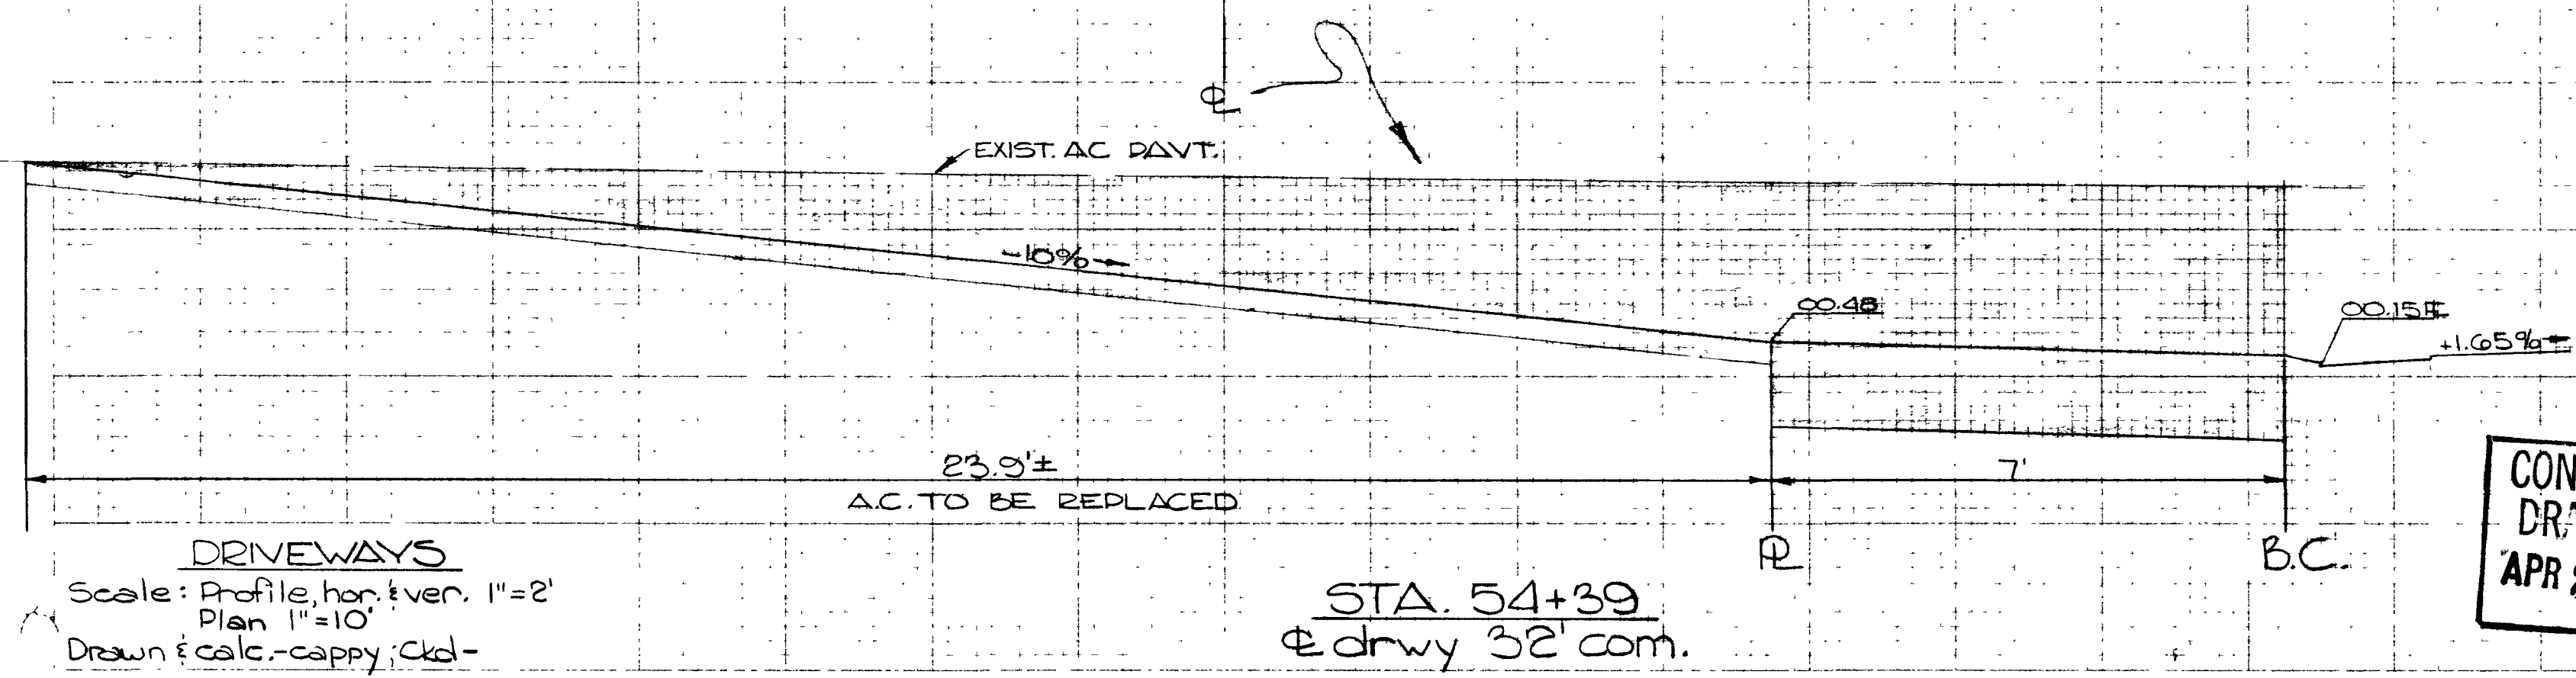
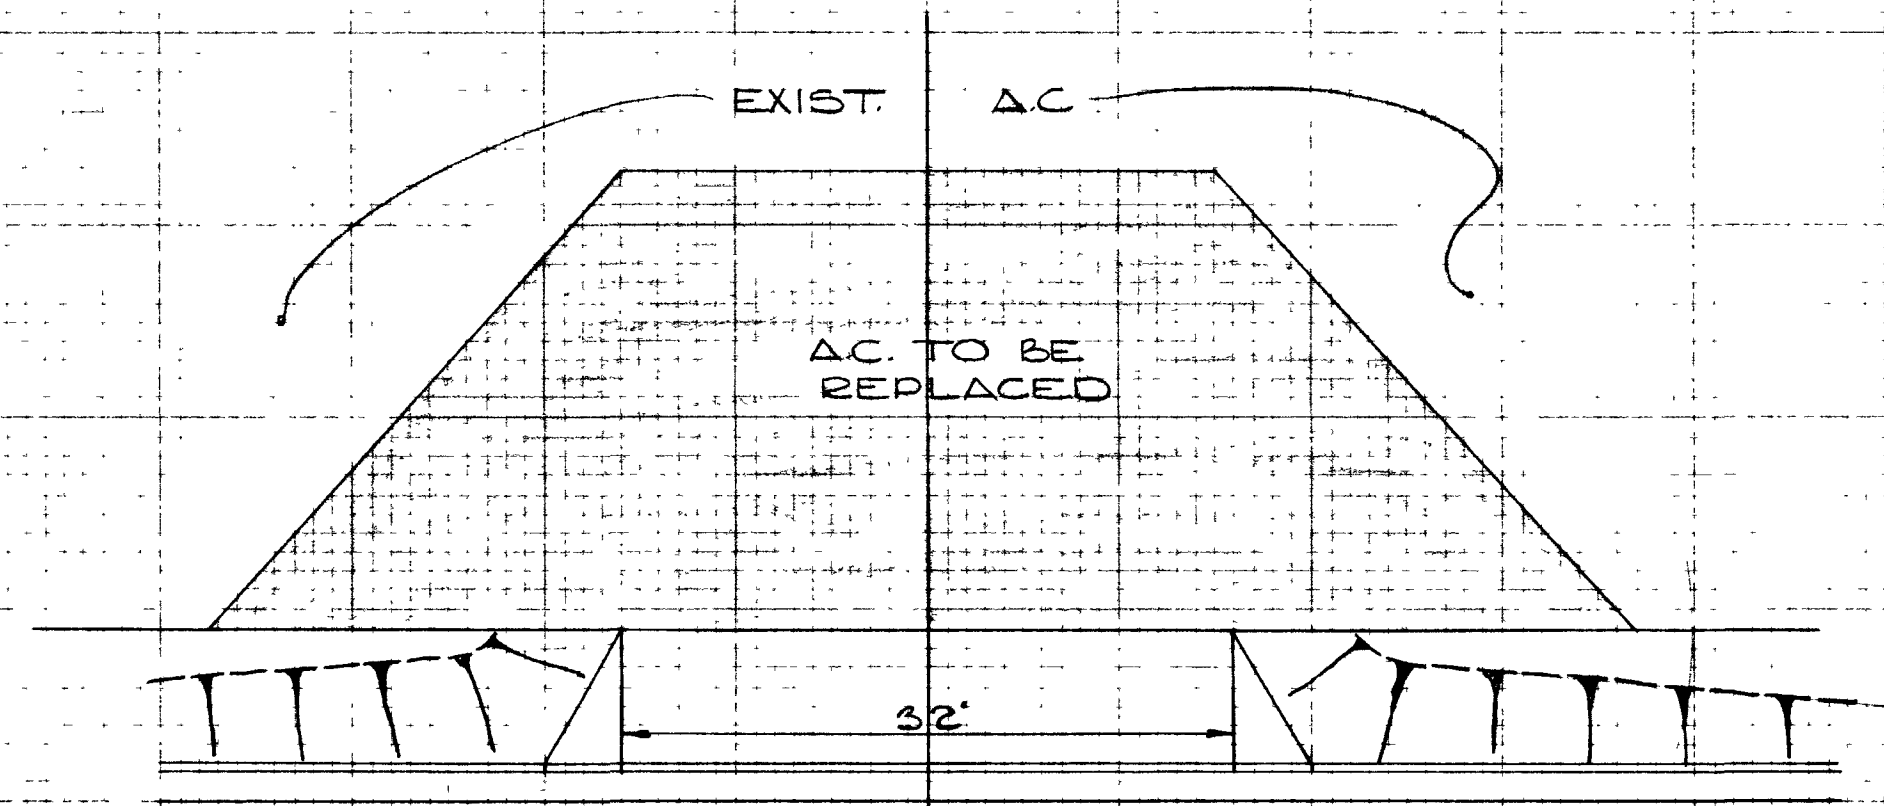
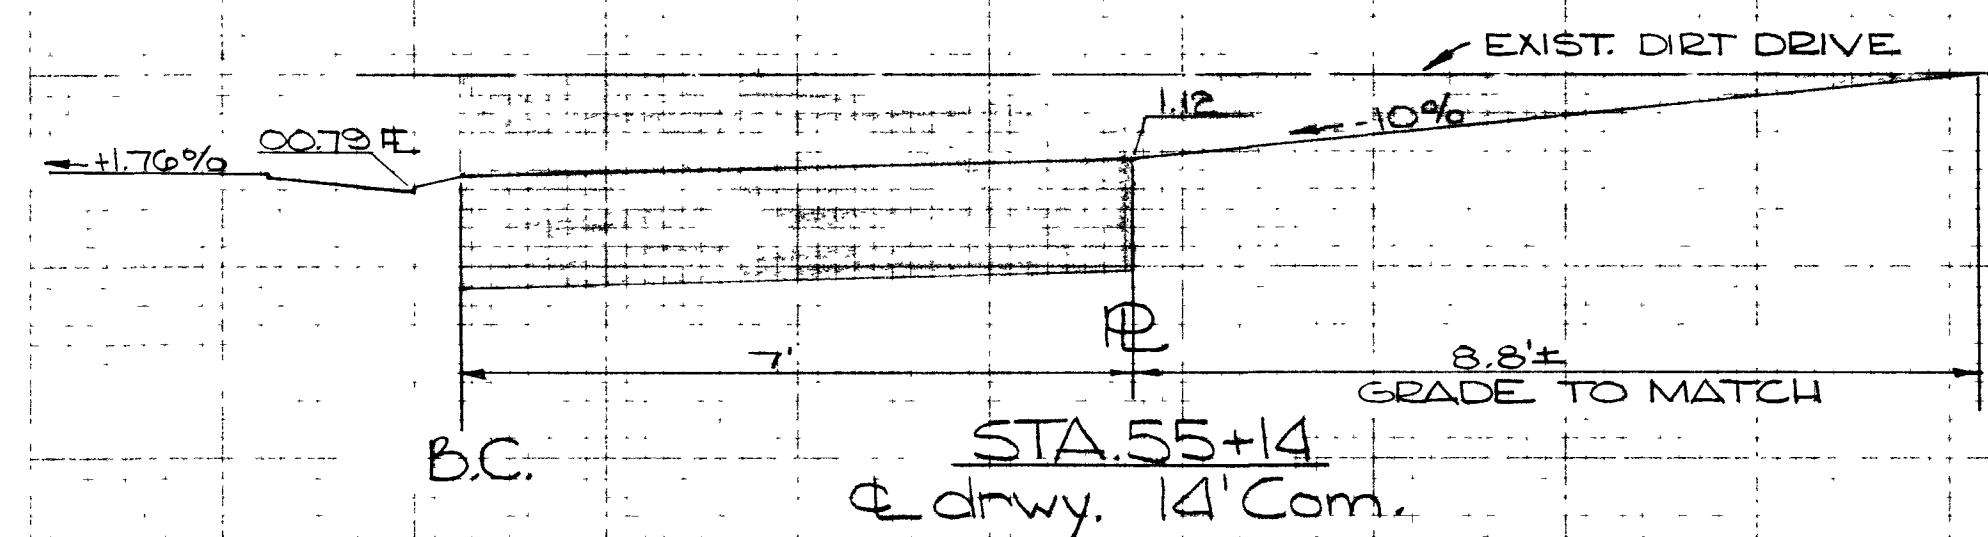
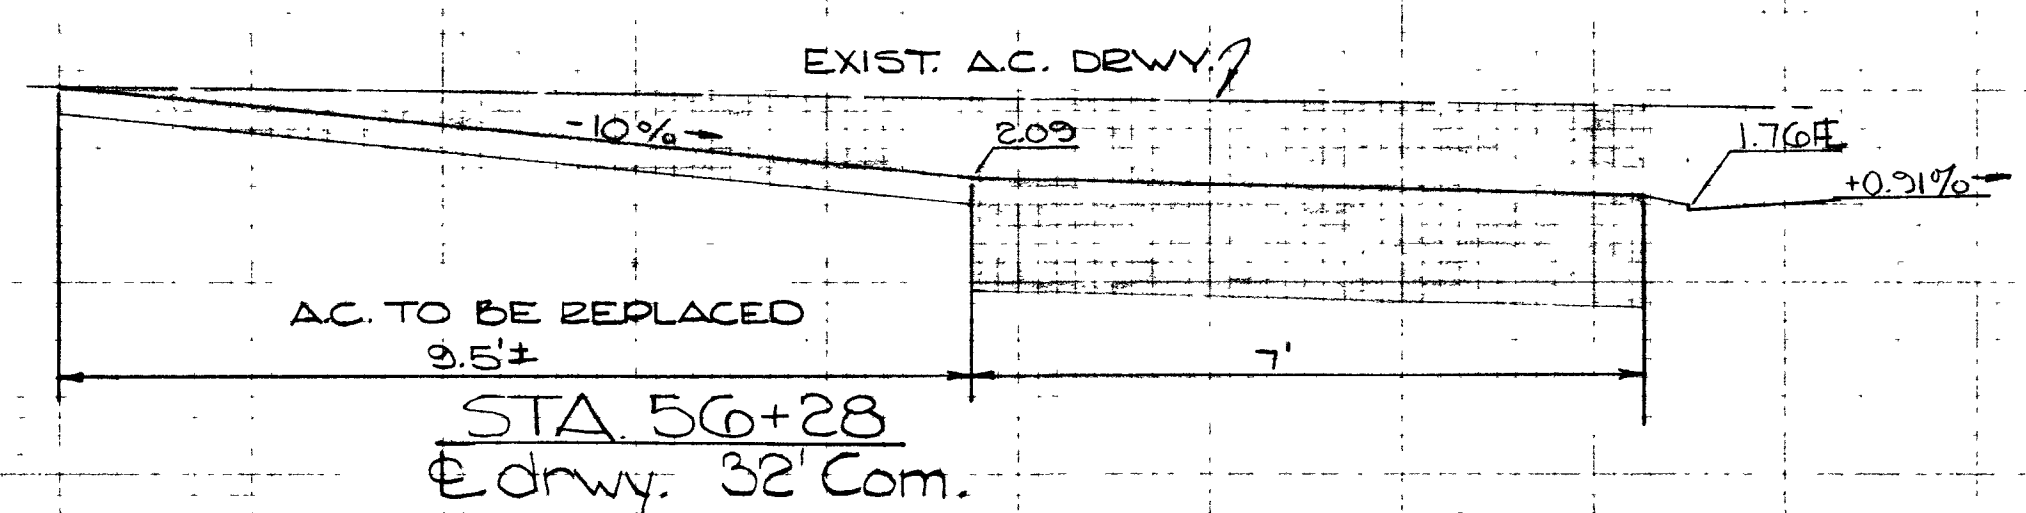
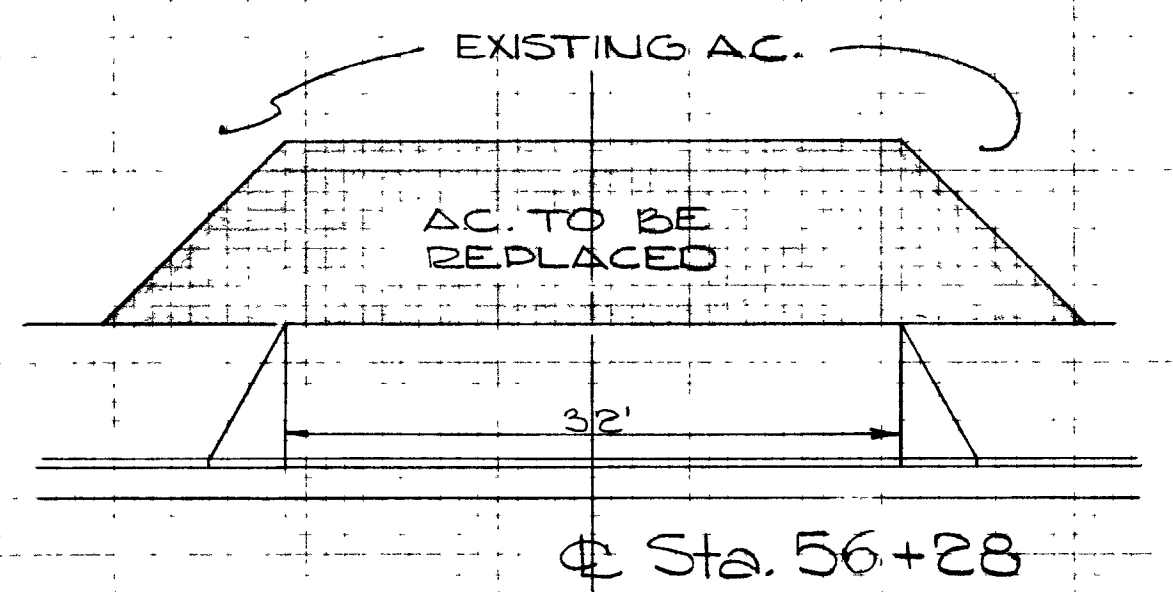
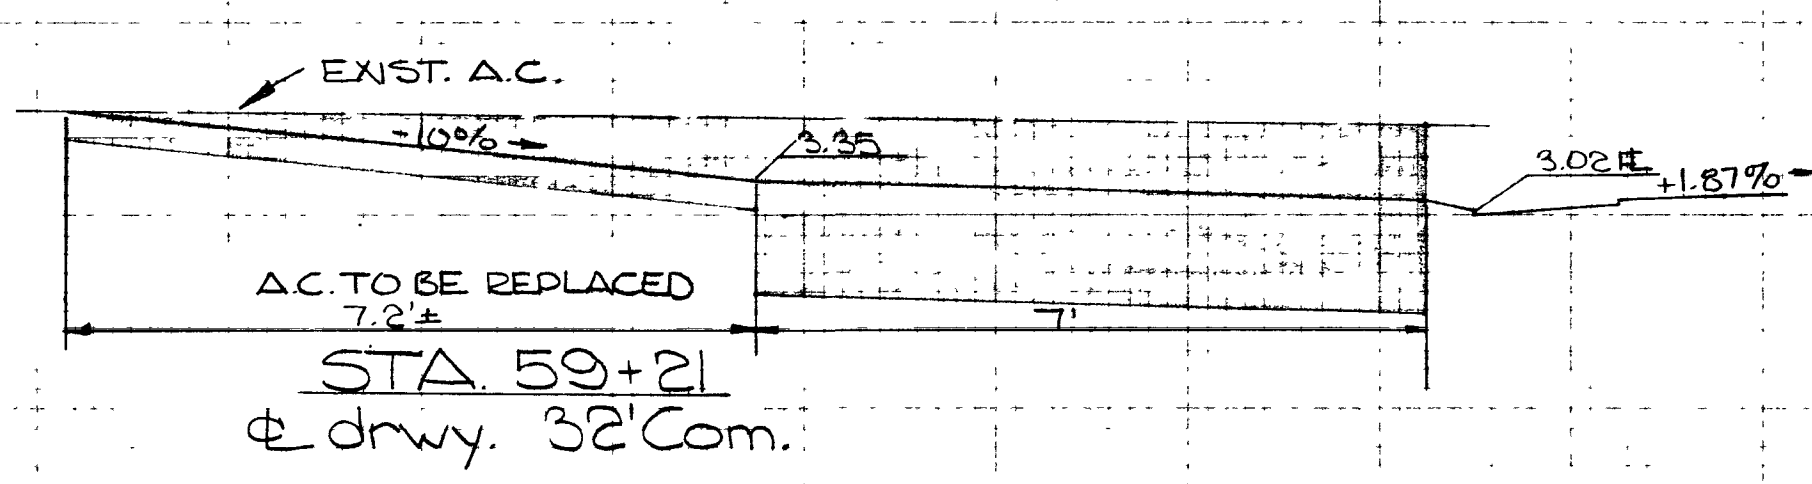


11-4-44

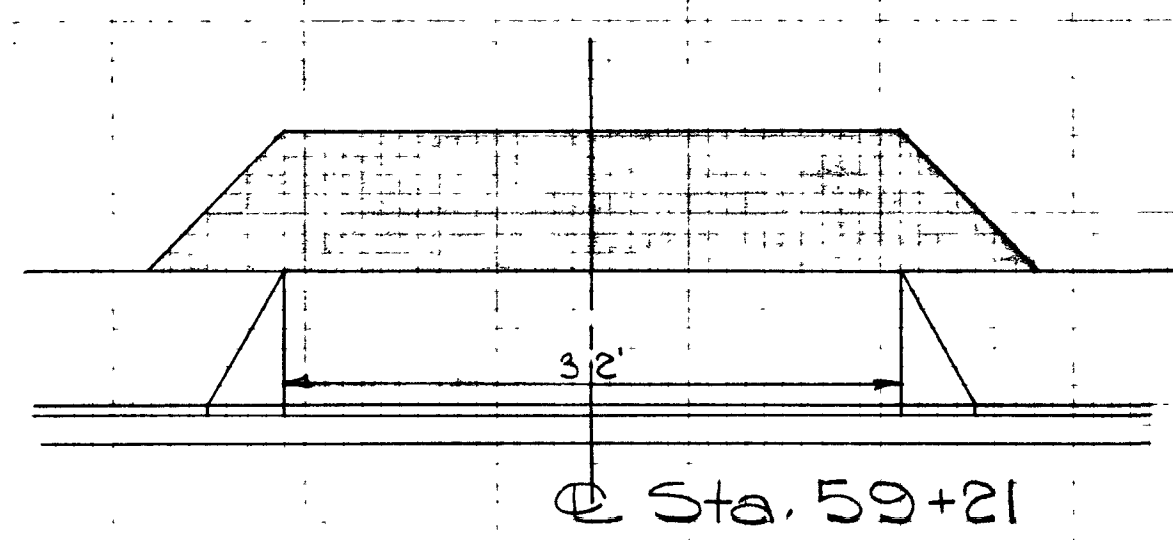

DRIVEWAYS

Scale: Profile, hor. & ver. 1"=2'



Plan 1"=10'

Drawn & calc. - cappy, ckd -

APPROVED DATE	
RT DIV	DATE
1 ENGR	1554 4-18
2 FIELD	1554 4-18
3 SER	1554 4-18
4 SWRD	1554 4-18
5 TRAFF	1554 4-18
6 VTE	1554 4-18

CONTRACT DRAWING

APR 22 1969

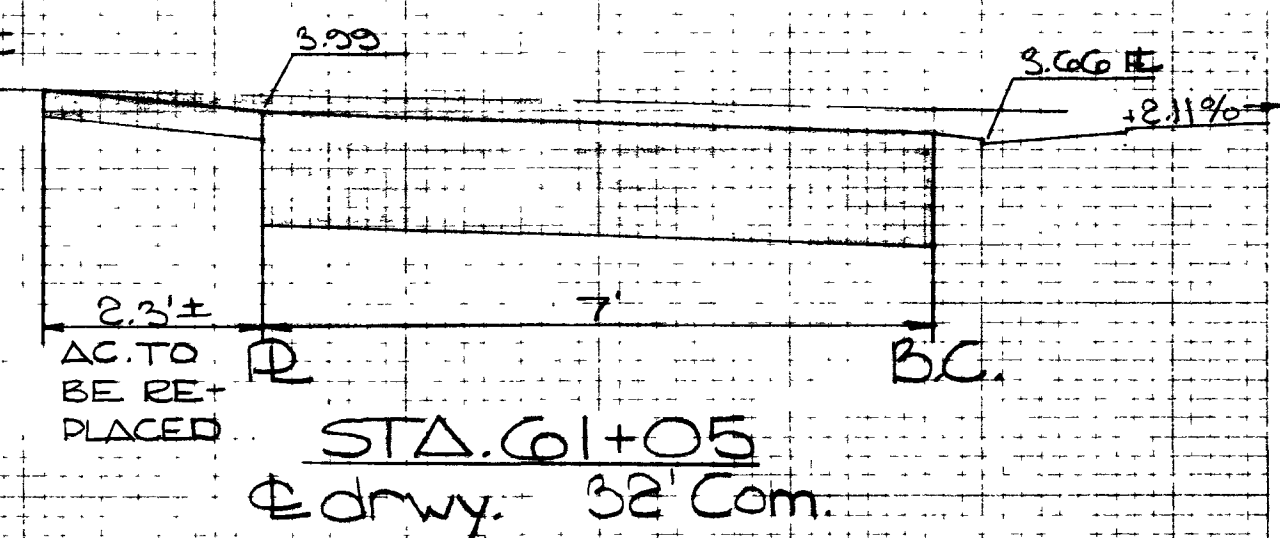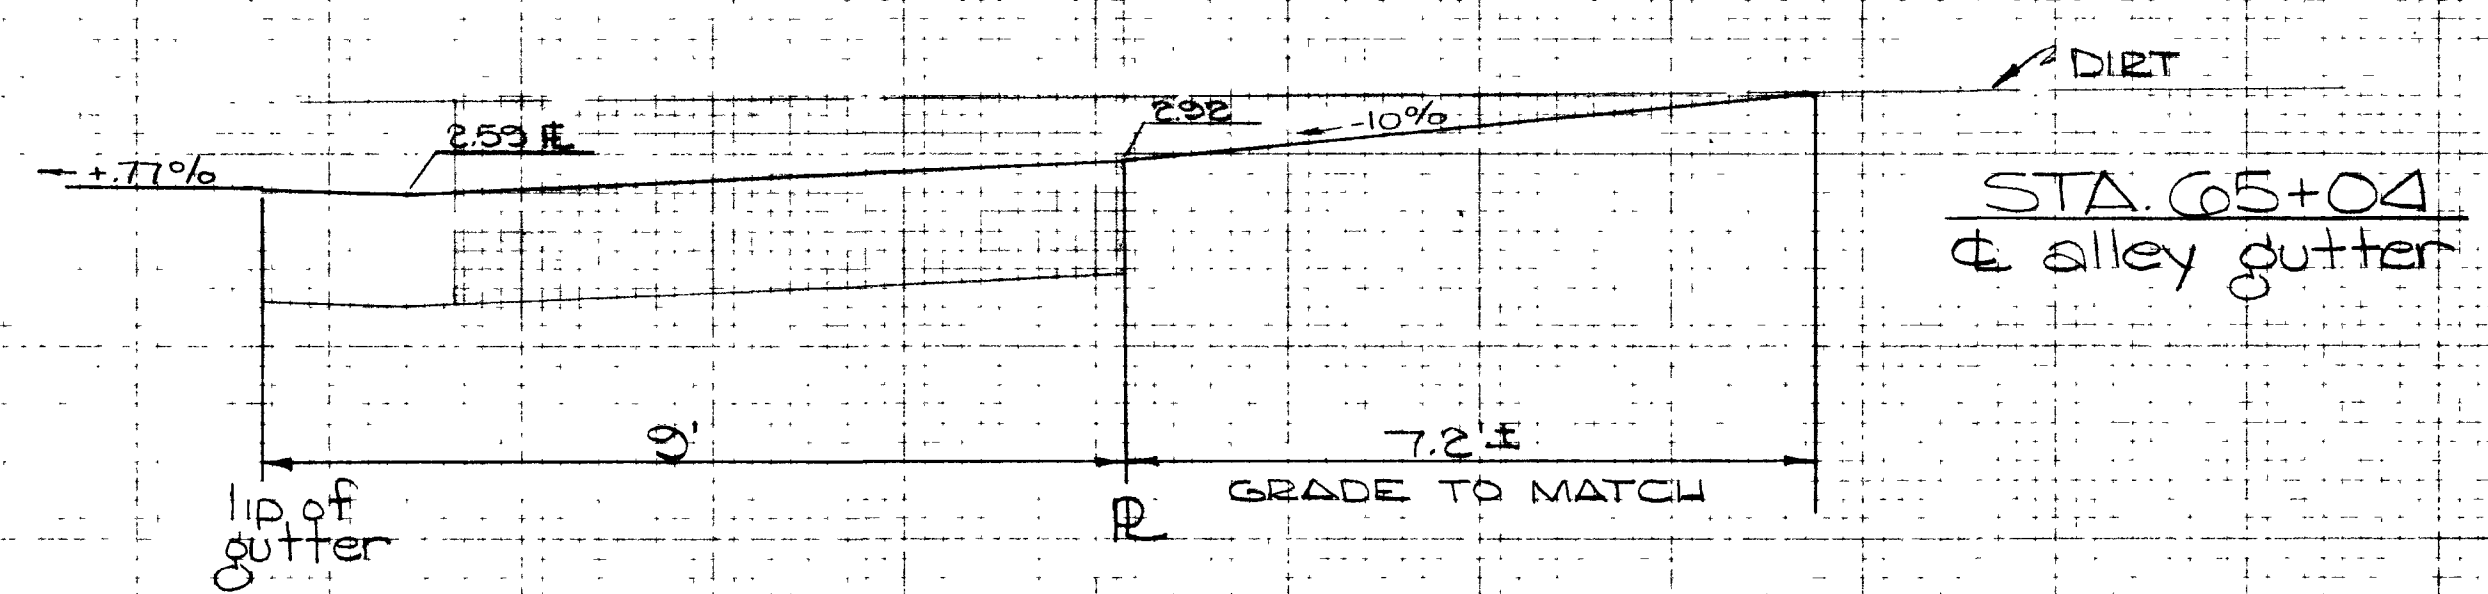

CITY OF LAS VEGAS NEVADA	
DEPARTMENT OF PUBLIC WORKS	
SERVICES DIVISION	
DECATUR BOULEVARD	
WASHINGTON AVENUE TO U.S. HIGHWAY NO. 95	
DRIVEWAY DETAILS - STA. 54+39 TO STA. 65+04	
W.O. NO. 7570 & 4810	DATE
F.B. NO. 64-4X	107V-738
APPROVED BY DIRECTOR OF PUBLIC WORKS	SHEET NO.
2A	2A

"AS CONSTRUCTED"

ORIGINAL	DATE
1554 4-18	1554 4-18

FINAL	DATE
1554 4-18	1554 4-18

Handwritten signature

