


11-4-46

ORIGINAL	DATE
SUBMITTED	DATE
APPROVED	DATE
NO. 0000	

FINAL	DATE
SUBMITTED	DATE
APPROVED	DATE
NO. 0000	

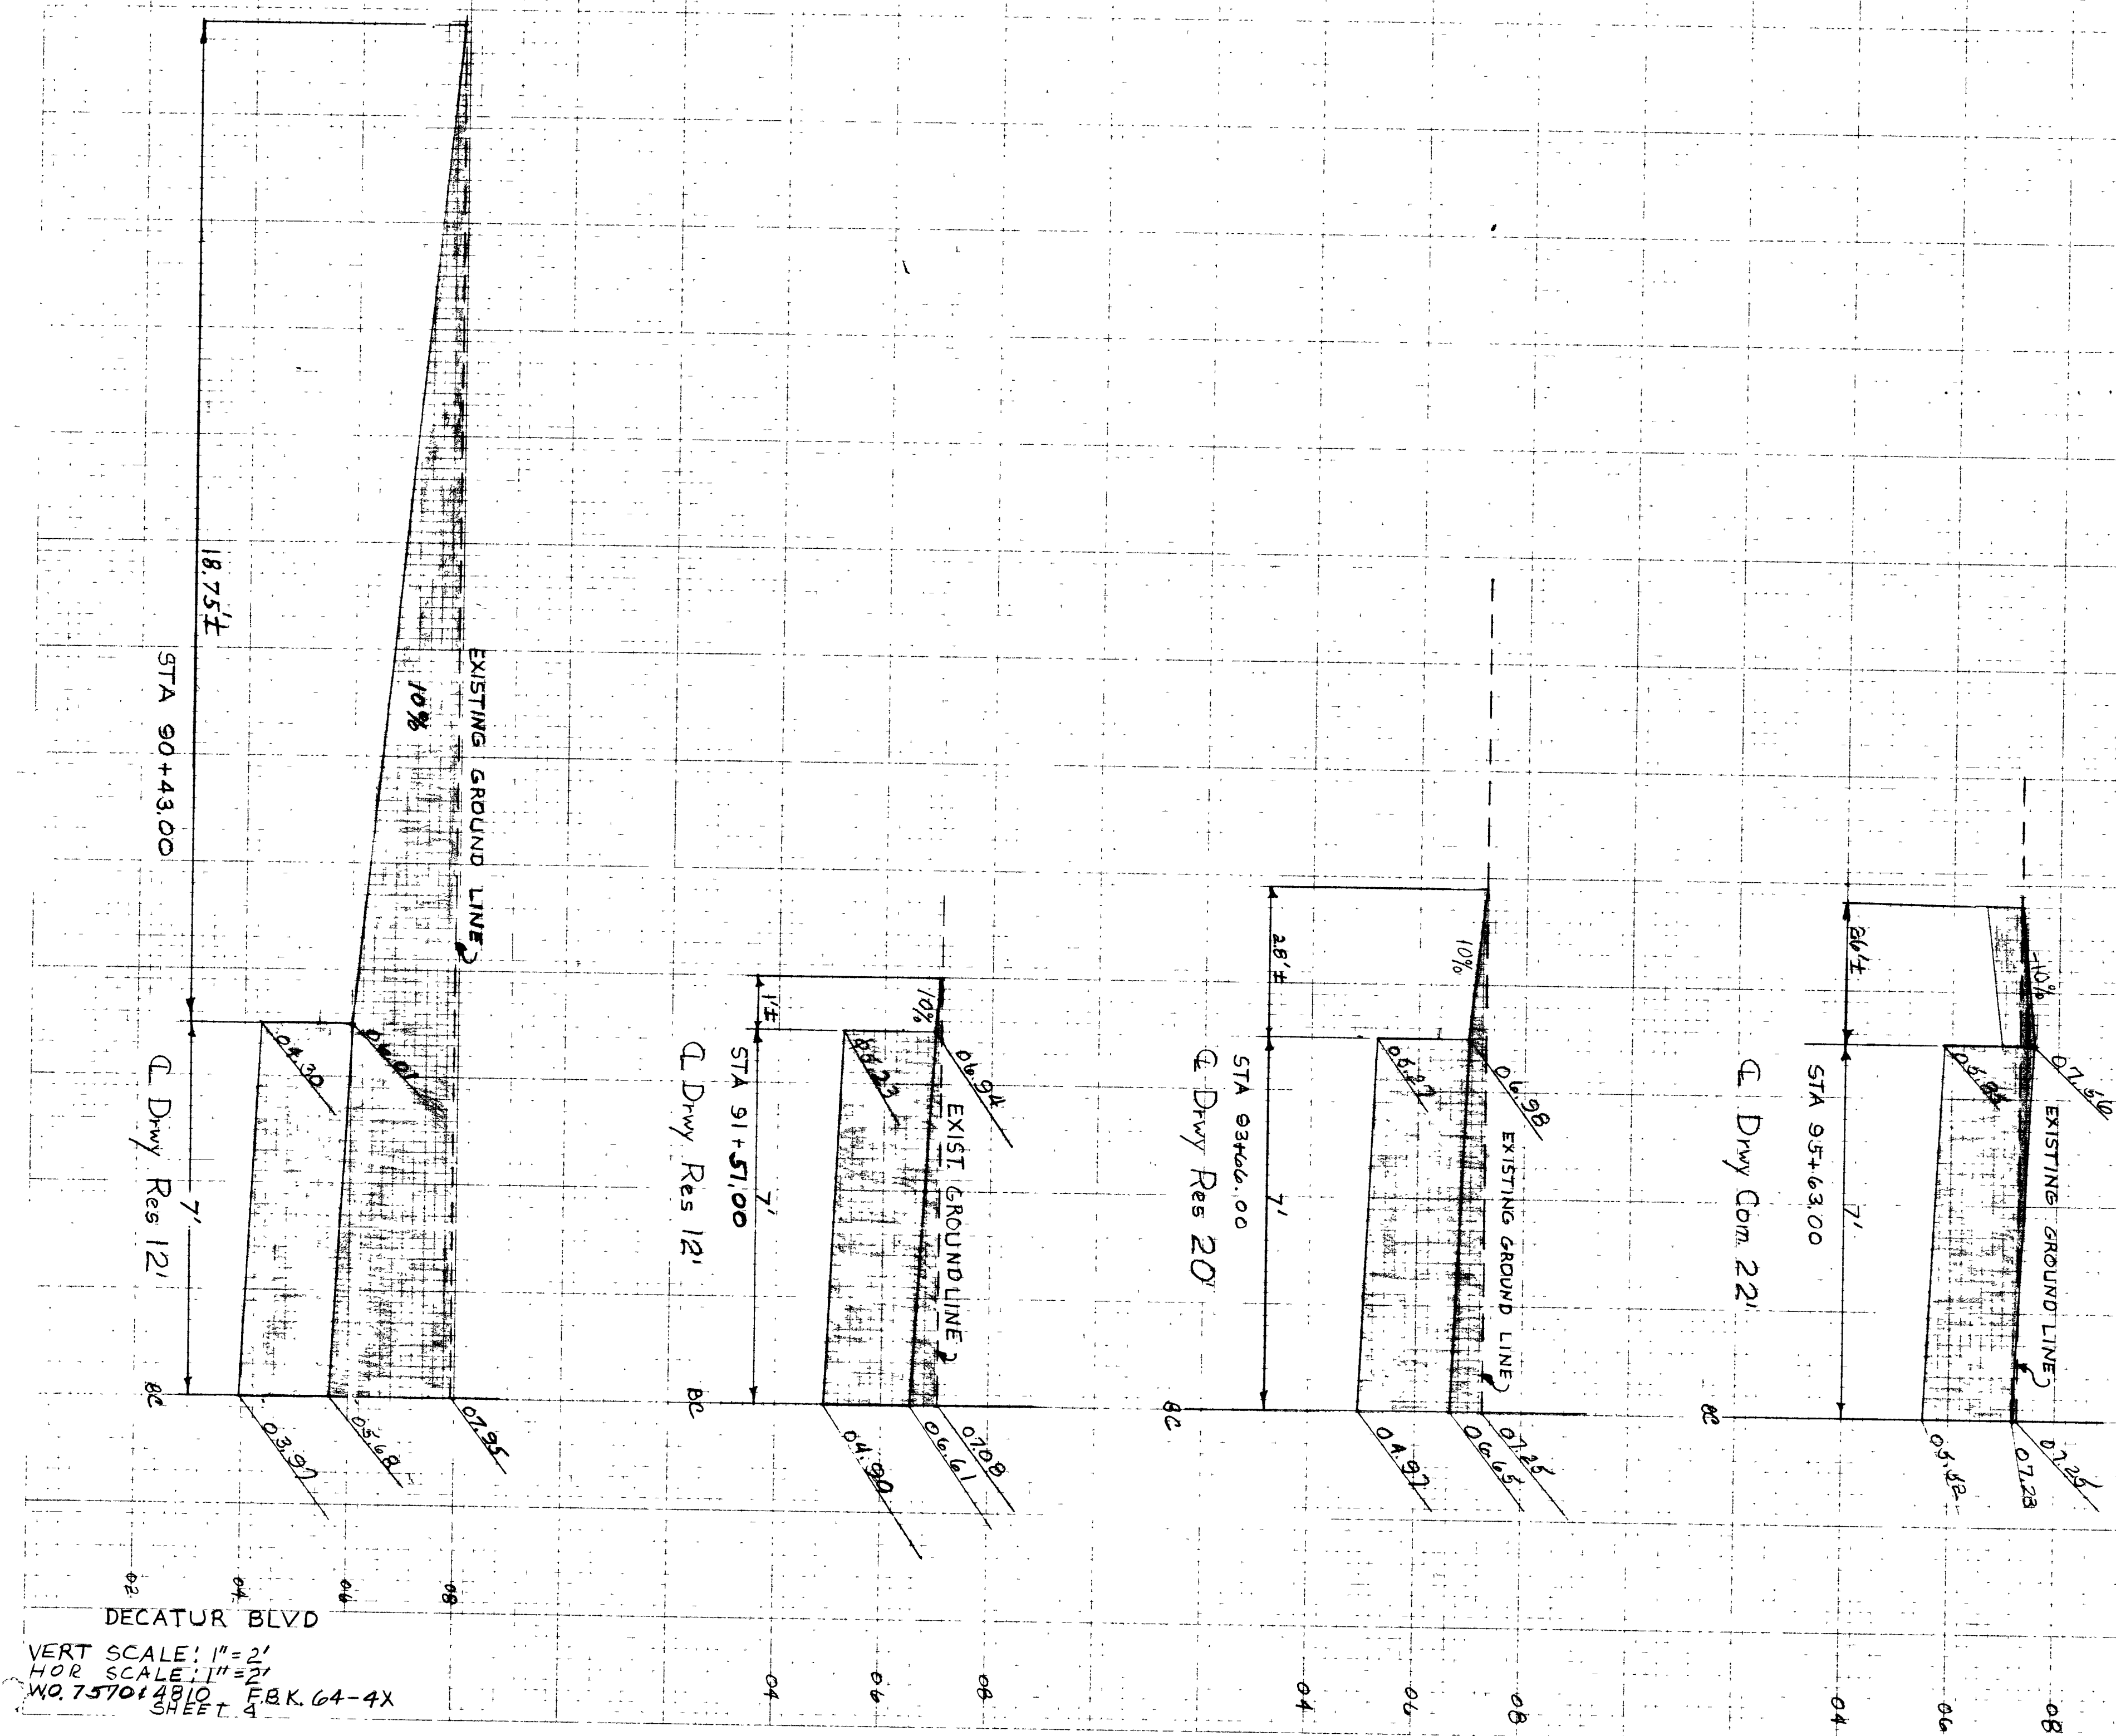

CONTRACT
 DRAWING
 APR 22 1969

APPROVED	DATE
4	D.P.W.
1	ENGR 1/5A 4-18
2	SURV 1/20 4-18
3	SERV
4	TRFEE


"AS CONSTRUCTED"

CITY OF LAS VEGAS NEVADA
 DEPARTMENT OF PUBLIC WORKS
 SERVICES DIVISION
 DECATUR BOULEVARD
 WASHINGTON AVENUE TO U.S. HIGHWAY NO. 95
 DRIVEWAY DETAILS - STA. 90+43 TO STA. 95+63

W.O. NO. 7570-B-4810	DATE	DRAWING NO.
F.B. NO. 64-4X		107V-738
APPROVED BY DIRECTOR OF PUBLIC WORKS		SHEET NO.
<i>R. Jensen</i>		4A

2104

11-4-46

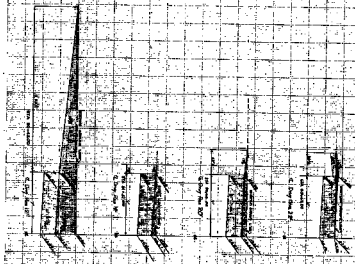

SECTION 3000
 CITY OF LAS VEGAS
 DEPARTMENT OF PUBLIC WORKS

APPROVED
 DATE 11-4-46

CITY OF LAS VEGAS NEVADA
 DEPARTMENT OF PUBLIC WORKS
 DIVISION OF ENGINEERING
 PROJECT NO. 11-4-46
 SHEET NO. 11-4-46-1

"AS CONSTRUCTED"