



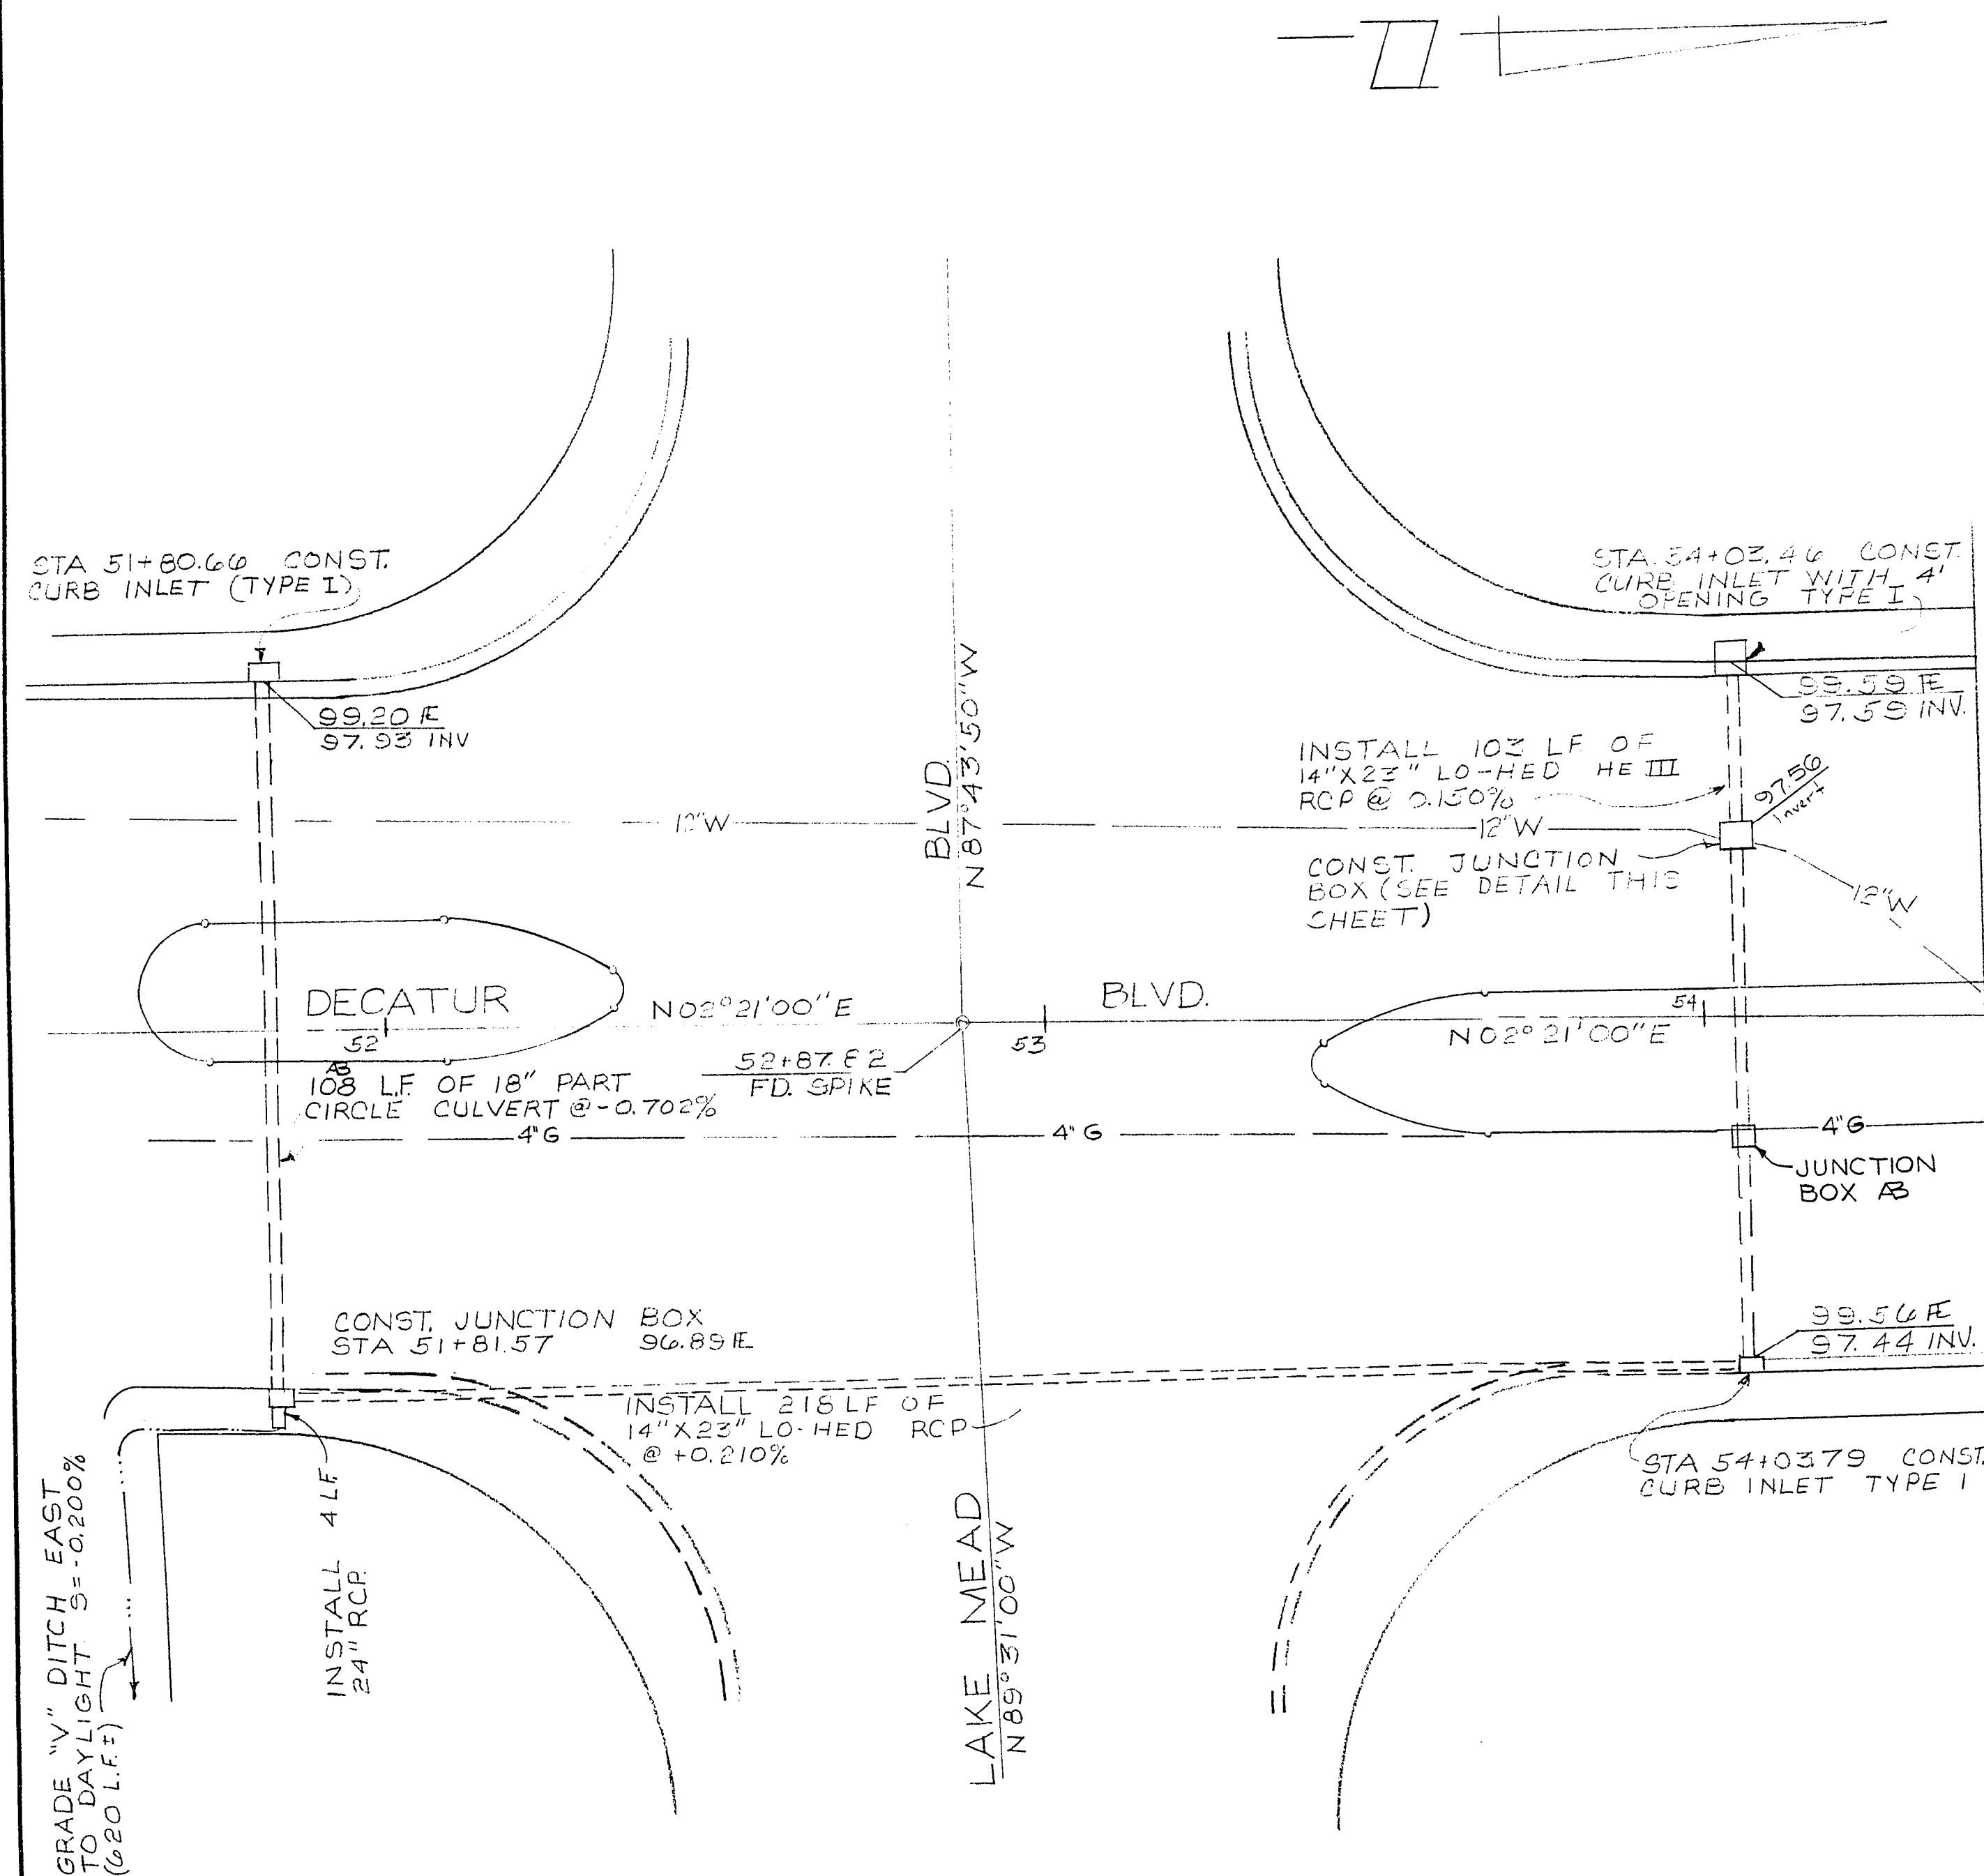


1" = 20'

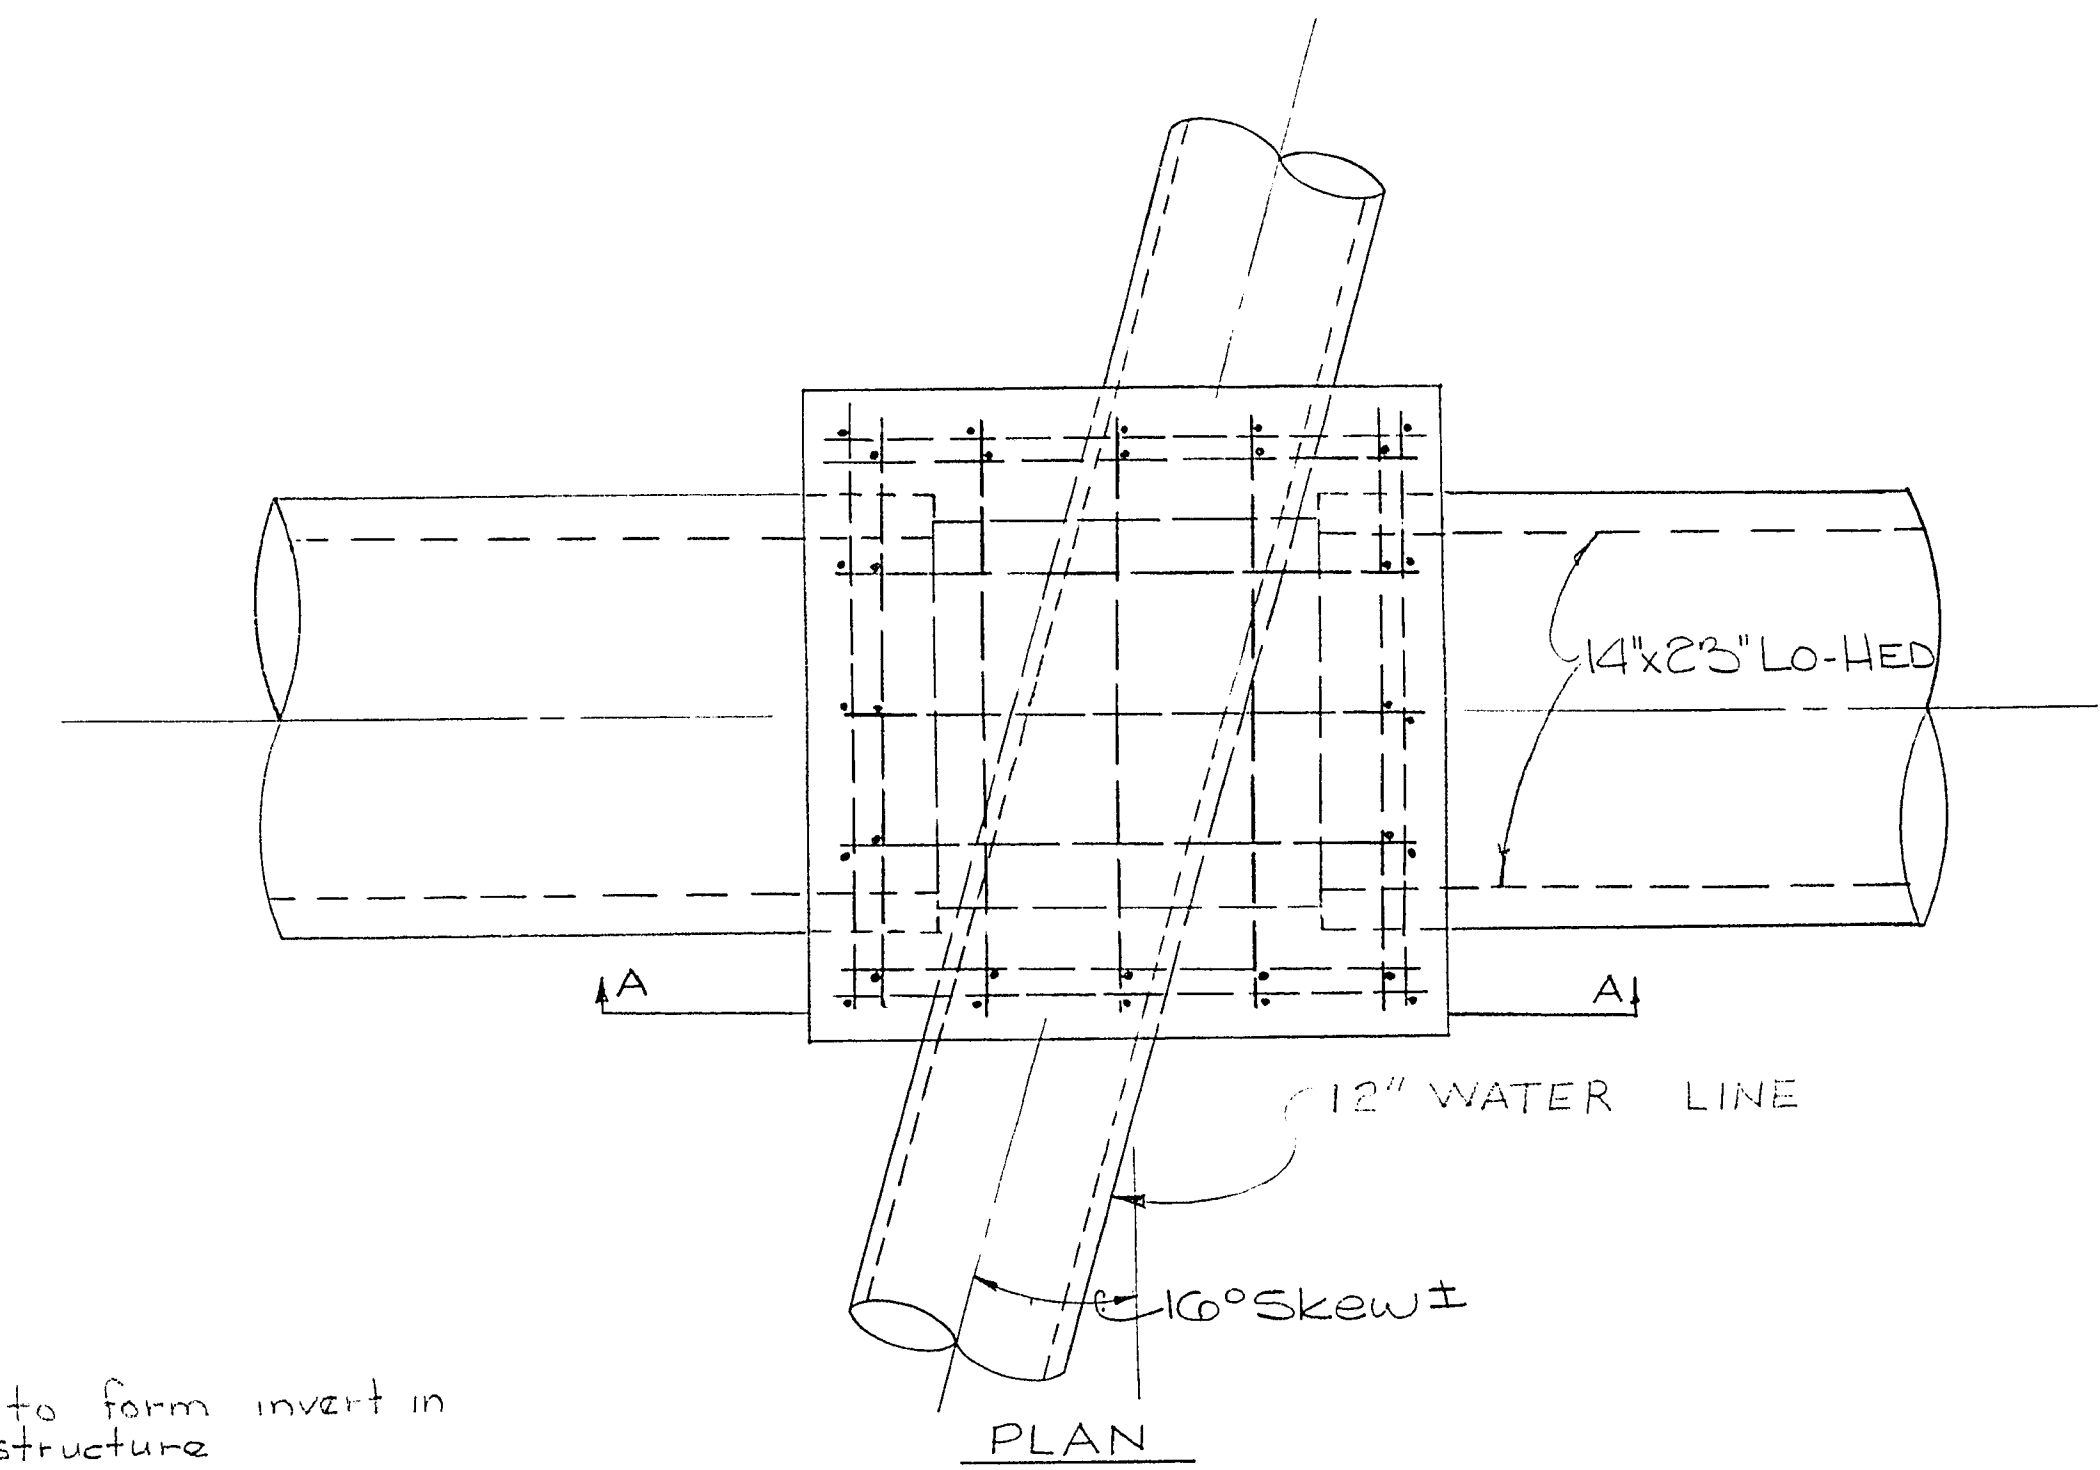

NOTE: Contractor is to form invert in lower 1/3 of structure

NOTE - 12" WATER LINE SHALL BE CONC. ENCASED FOR A DISTANCE OF 84" EITHER SIDE OF BOX. ENCASEMENT TO BE CONTINUOUS UNDER BOX

#4 BARS @ 9" O.C. BOTH WAYS

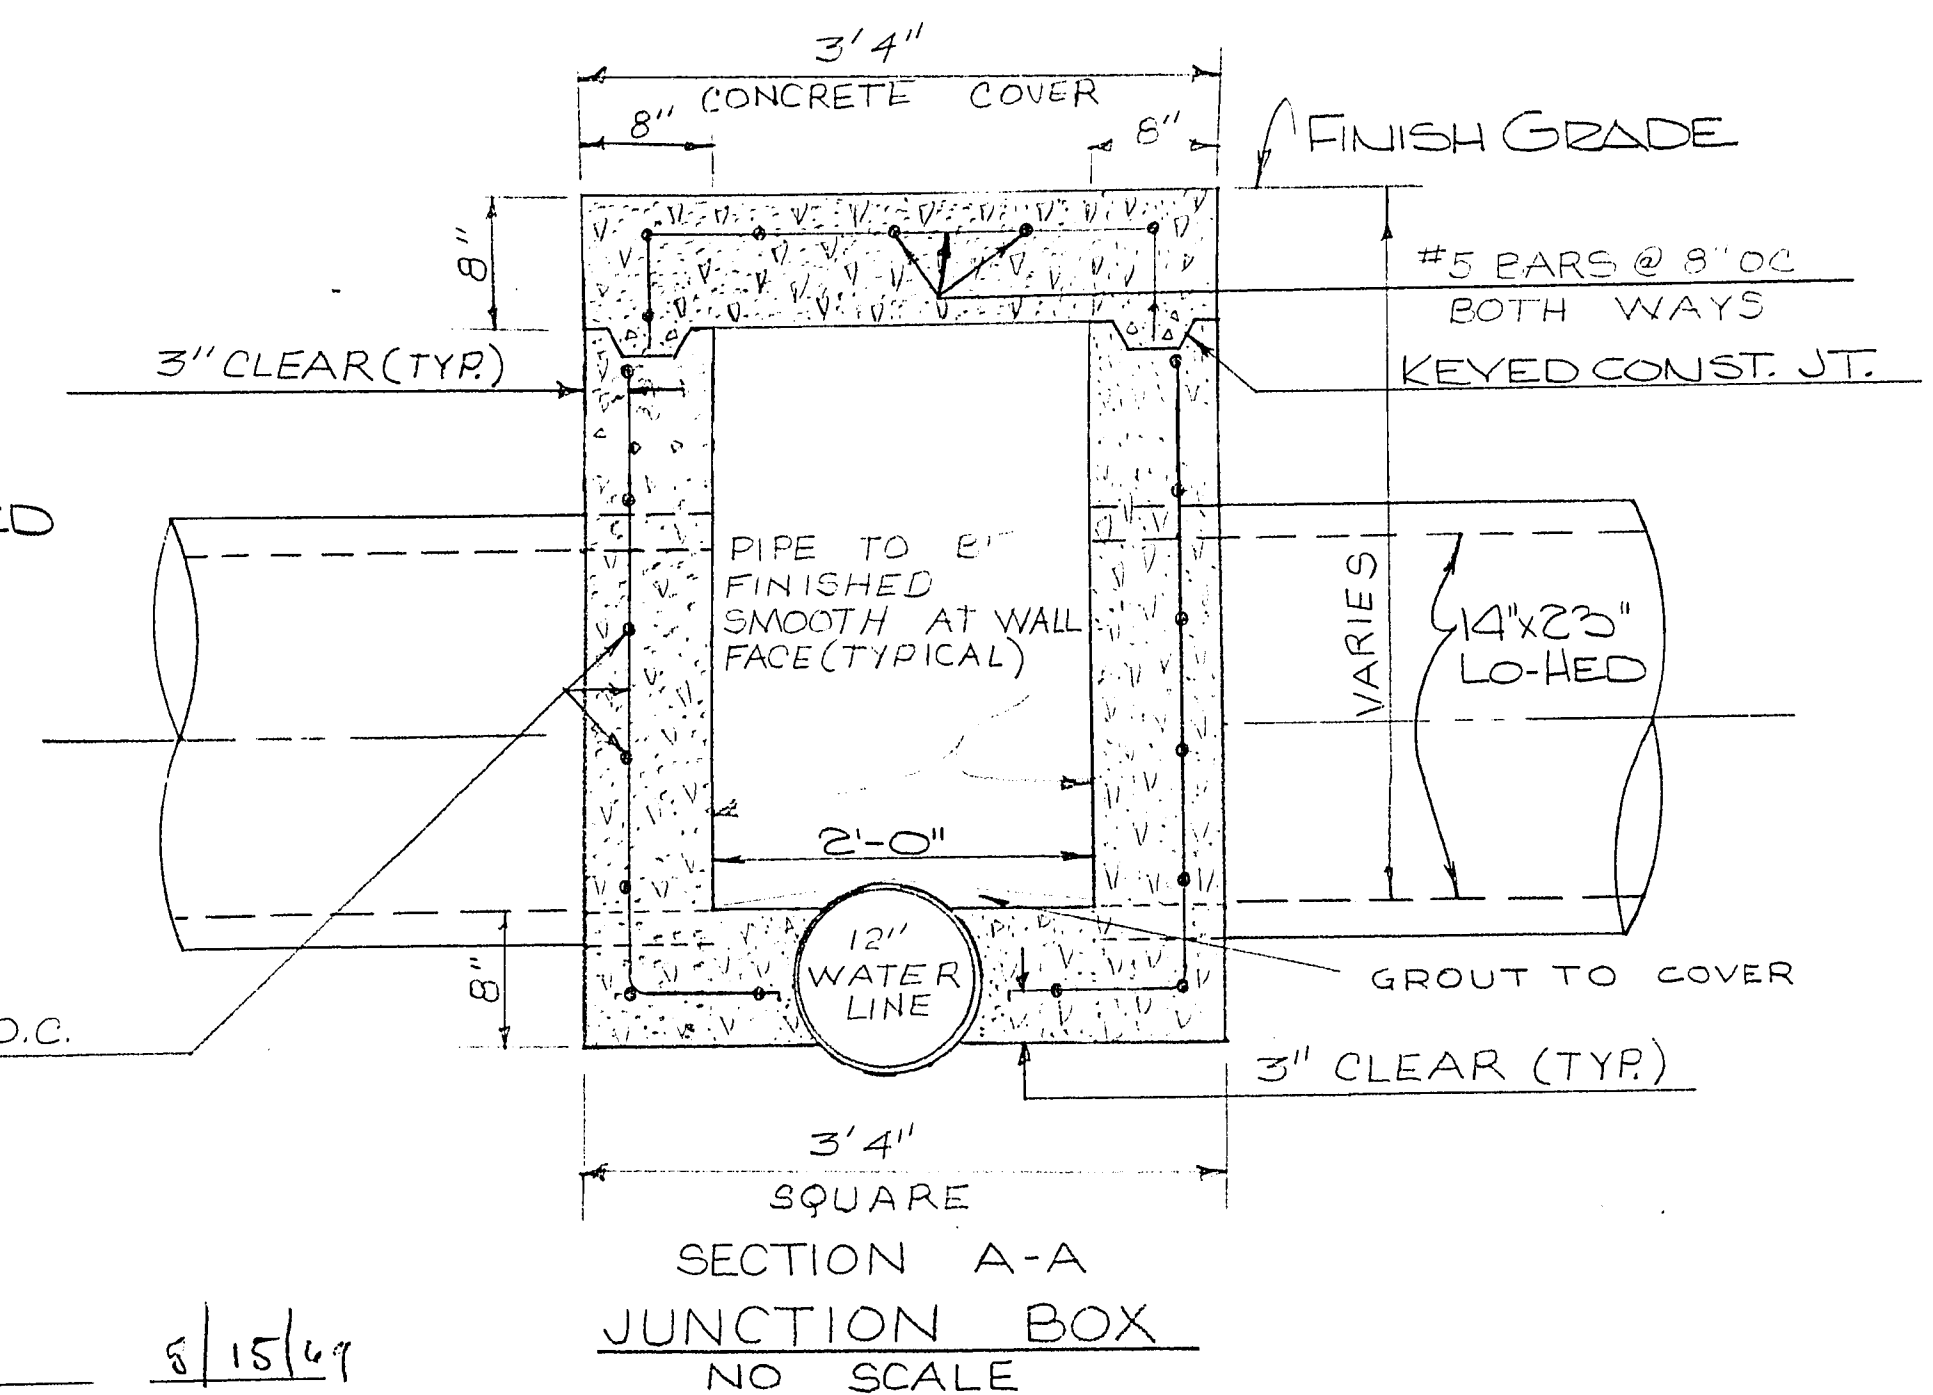

APPROVED *[Signature]* 8/15/69
DIRECTOR OF PUBLIC WORKS
DATE

APPROVED *[Signature]* 8/15/69
MANAGING ENGINEER R.S. & H.C.
DATE

CITY OF LAS VEGAS NEVADA			
DEPARTMENT OF PUBLIC WORKS			
SERVICES DIVISION			
INTERSECTION OF DECATUR AND LAKE MEAD; CONST. SKETCH II			
W.O. NO. 75707	FILE NO. 4810	DATE	DRAWING NO.
SC. (H) AS SHOWN	SC. (V)	8/14/69	107V-738
DES. G. BILLINGSLEY		FILE NO.	
DR. C. KREHNOVI		APPROVED BY DIRECTOR OF PUBLIC WORKS	
8/15/69		8/15/69	
SHEET 54 OF 54			

"AS CONSTRUCTED"