


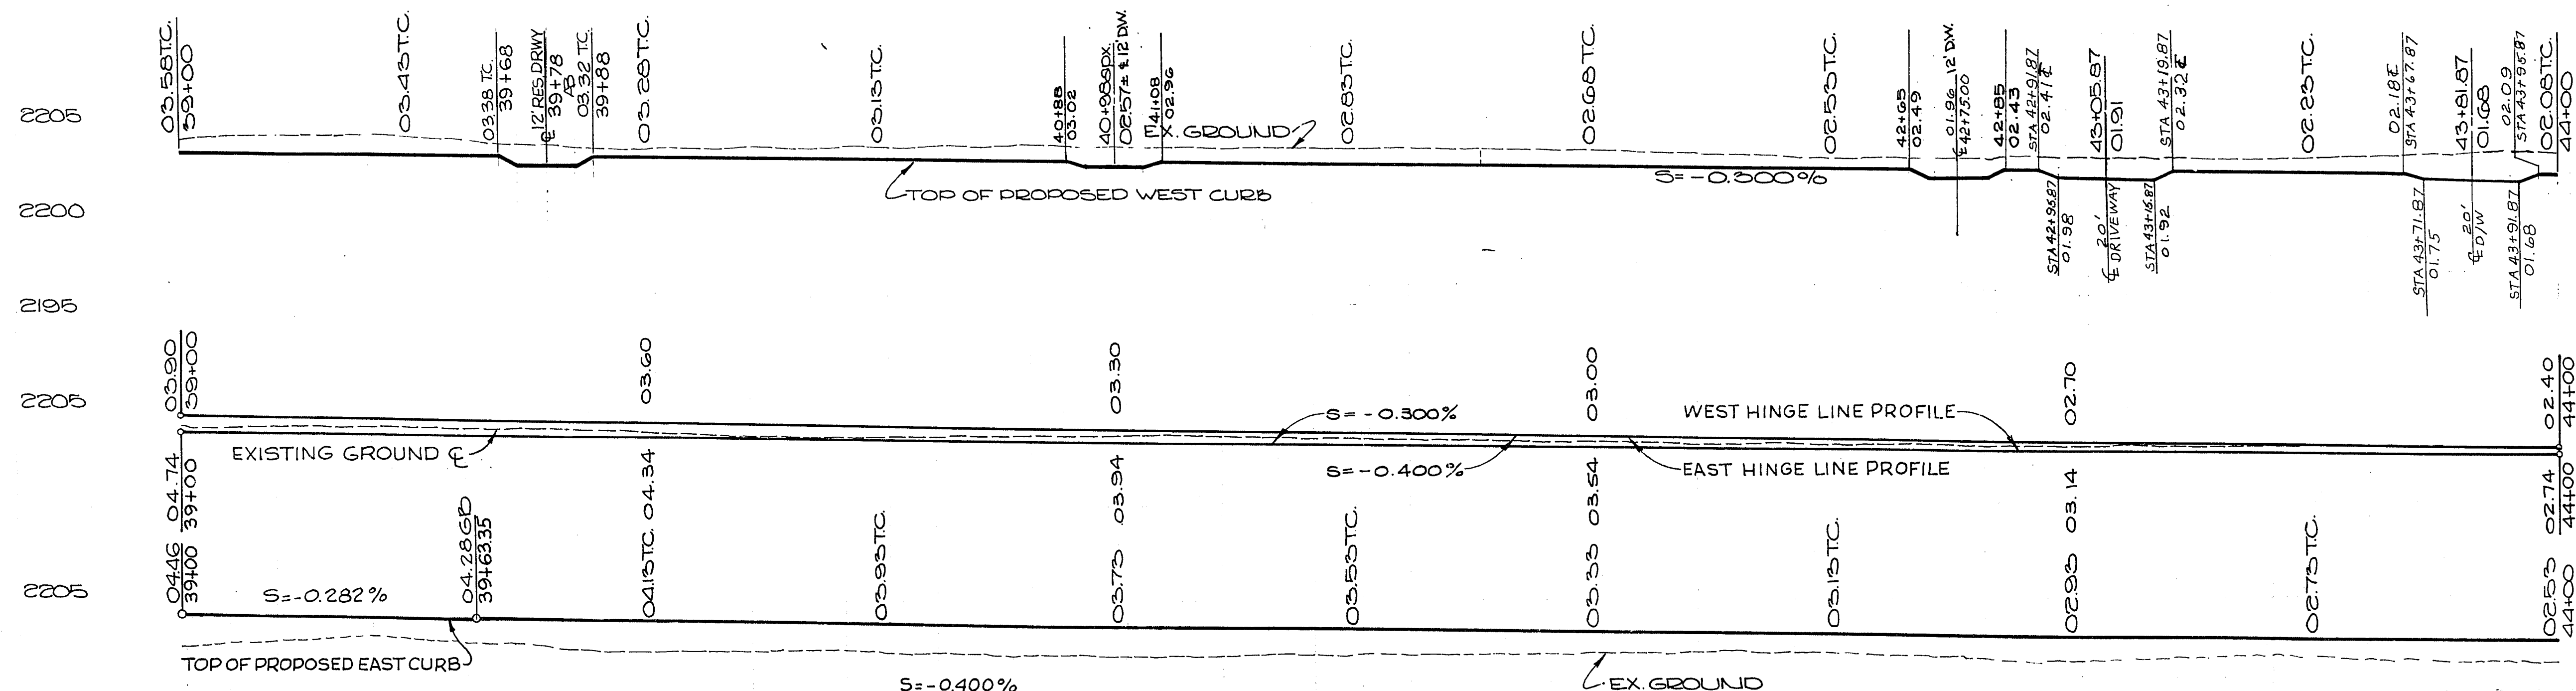

ITEM	DESCRIPTION	R.S.H	S.A.D	C.L.V	C.C.SAD	TOTAL	UNIT
2200.300	REMOVE TREES (4+10')	9			3	12	EACH
201.100	EXCAVATION	1237	1		565	1807	C.Y.
302.100	TYPE I GRAVEL BASE	426	10		150	586	C.Y.
302.200	TYPE II GRAVEL BASE	426	5		97	526	C.Y.
333.500	BIT. PENETRATION	1056				1056	S.Y.
333.500	1/2" OPEN GRADE PLANT MIX	3875	49		729	4605	S.Y.
334.210	A.C. CURB (ISLAND)	912				912	L.F.
334.212	6" A.C. PAVEMENT	3875	49		729	4605	S.Y.
340.190	24" L" TYPE CURB/GUTTER		63		661	924	L.F.
340.410	RESIDENTIAL DRIVEWAY				324	324	S.F.
340.420	COMMERCIAL DRIVEWAY				360	360	S.F.
560.500	INSTALL FIRE HYDRANT			1		1	EACH
	RELOCATE POWER POLE					2	EACH
	RELOCATE WATER METER					4	EACH
	N.I.C.						L.F.
801.000	SAW/CUT A.C. PAVT				75	75	S.Y.
334.900	1 1/2" A.C. PAVEMENT				99	99	S.Y.
335.100	BIT. FOG SEAL				99	99	S.Y.

NO.	DELTA	RADIUS	LENGTH	TANGENT
④	11°28'42"	400.00'	80.13'	40.20'
⑤	11°28'42"	200.00'	40.07'	20.10'
⑥	12°38'22"	4.00'	8.61'	7.43'
⑫	23°18'10"	50.00'	24.70'	12.61'

1	3-27-69	DELETE 6" GATE VALVE AT 40+94	
Δ	3-27-69	MOVED FIRE HYDRANT TO CENTER OF ISLAND	
Δ	3-27-69	ADDED TELEPHONE CONDUIT	
201 4/14/69			
REV	DATE	DESCRIPTION	AP

CITY OF LAS VEGAS, NEVADA
ENGINEERING DEPARTMENT

DECATUR BLVD.
WASHINGTON AVE. TO U.S. HIGHWAY NO 95
STA. 39+00.00 TO STA. 44+00.00

(6) 1/2L 1/2V 1/2C	WO TEST & ABIO DESIGN G.L.C. DRAWN Larry Evans CHECKED S.C.D. CONSULTING ENG. <i>David E. Chappel</i> PE 2407 TRAFFIC ENG. CITY ENGINEER <i>David E. Chappel</i>	DATE 4-11-67 5-17-68 3/5/69	HOR. SCALE: 1" = 20' VERT. SCALE: 1" = 5' FB N° CLV. DRWG. N° 107V-738
24	PREPARED BY TYSON ENGINEERING COMPANY INC.	SHEET 10 OF 4	

"AS CONSTRUCTED"