
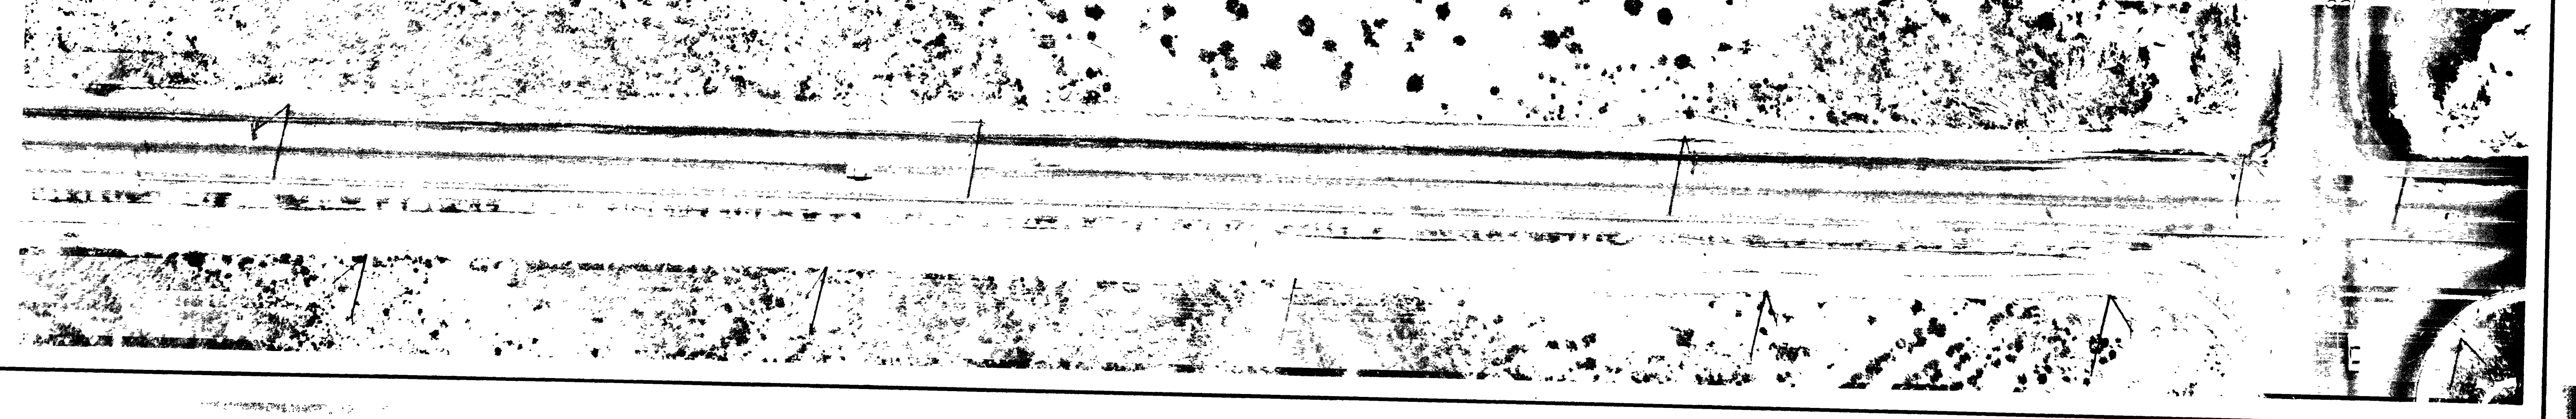


NOTE:
CURVE DATA, BACK OF CURVE

①	91° 27' 10"	80.00'	50.71'	47.88'
②	85° 20' 33"	80.00'	29.14'	46.26'
③	91° 39' 20"	80.00'	30.85'	47.99'
④	89° 32' 57"	80.00'	29.25'	46.34'

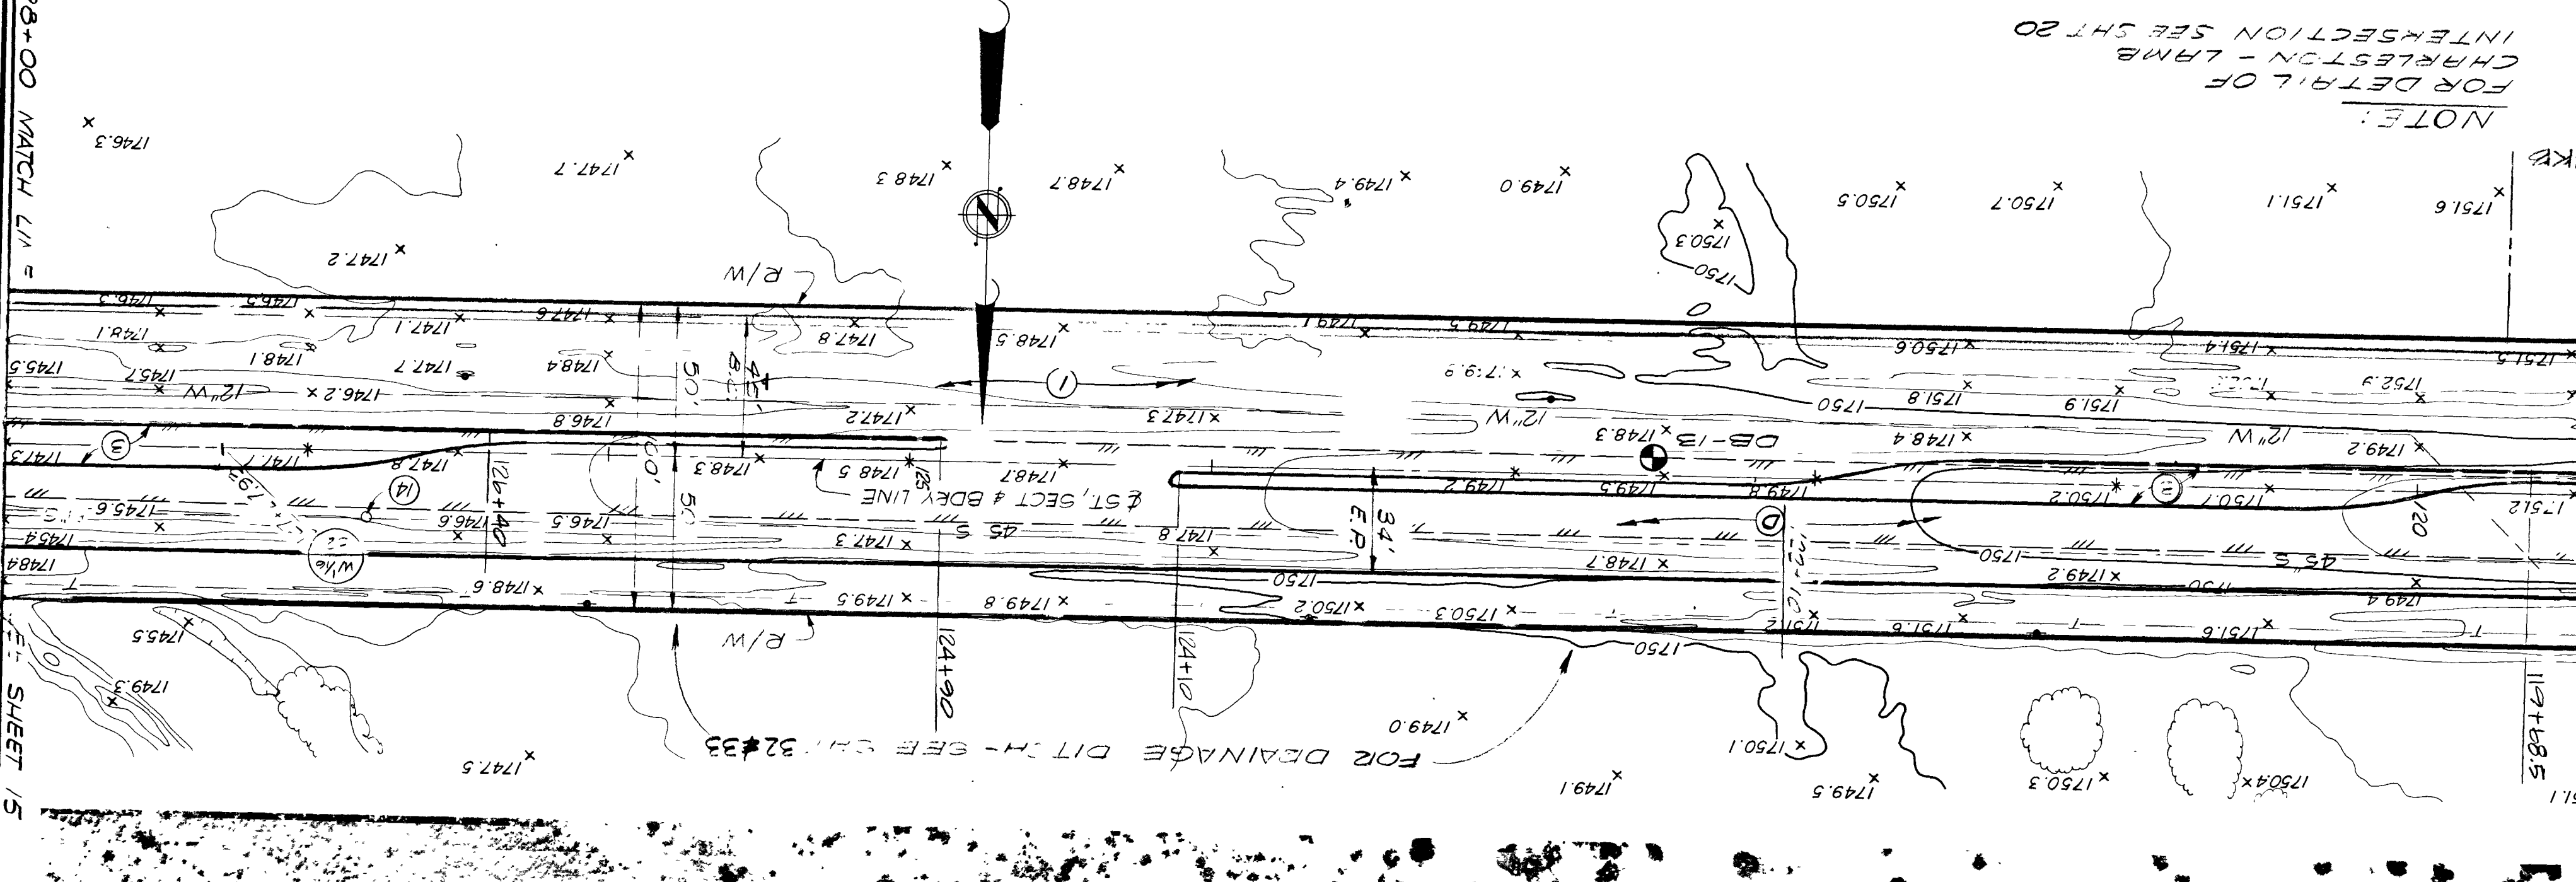

14 SHEET
REGIONAL STREET AND HIGHWAY COMMISSION, CLARK CO., NEV.
EAST CHARLESTON BLVD. FROM FREMONT ST. TO NELLIS BLVD.
PLAN AND PROFILE
115+20 TO 128+00

WALLACE - MONTGOMERY, A JOINT VENTURE
G. C. WALLACE, Consulting Engineer
755-7198
MONTGOMERY ENGINEERS OF NEVADA
755-7198
LAS VEGAS, NEVADA

RECOMMENDED
G. C. WALLACE
1915 5/17/74
2315 5-2-73
DATE
DESCRIPTION
AS-BUILT

107-V943
128+00
127+00
126+00
125+00
124+00
123+00
122+00
121+00
120+00
119+00
118+00
117+00
116+00
115+20
115+00

AS BUILT DRAWING
OF 3 SHEETS

