




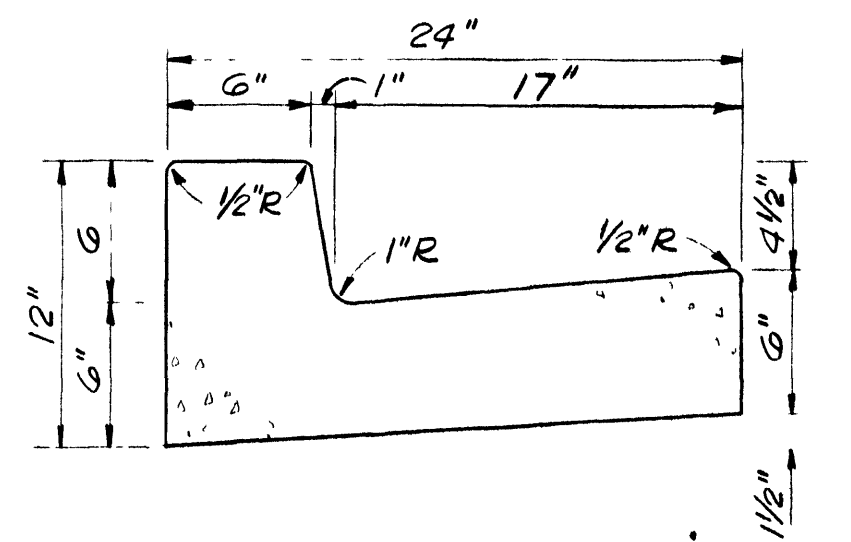


SECTION 4
NO SCALE

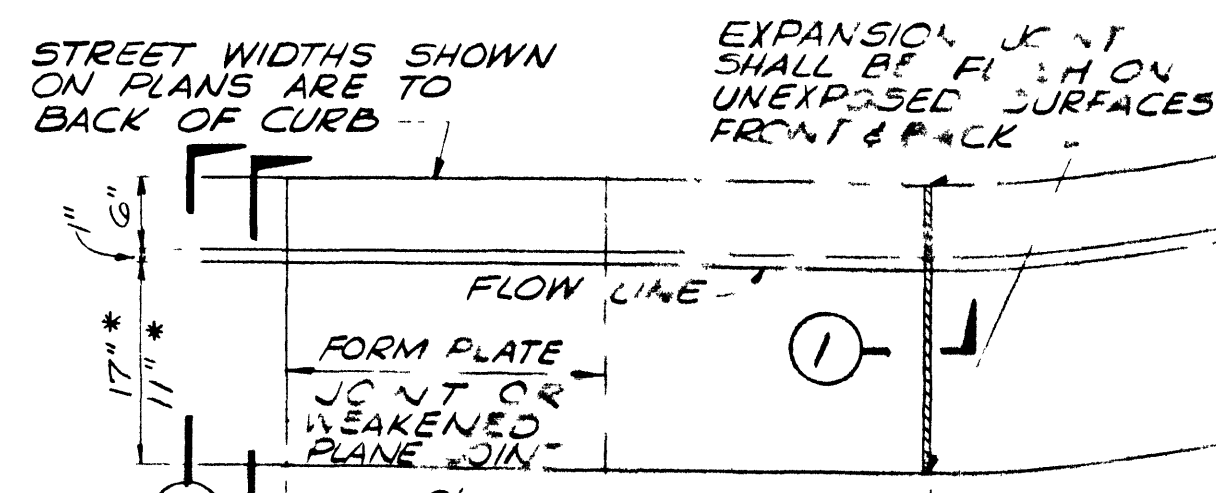

"L" TYPE CURB & GUTTER
NO SCALE

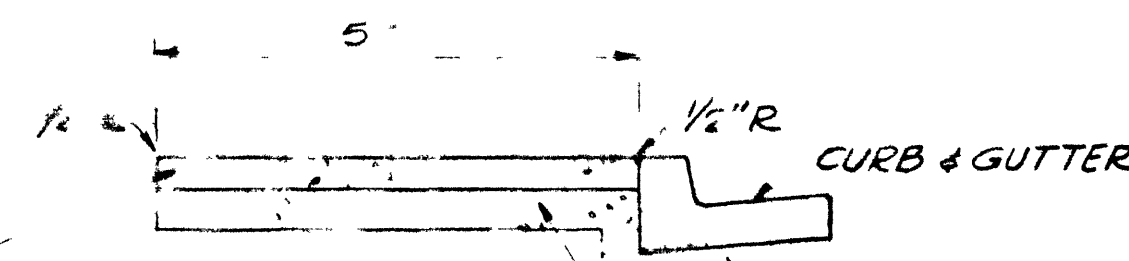

SECTION

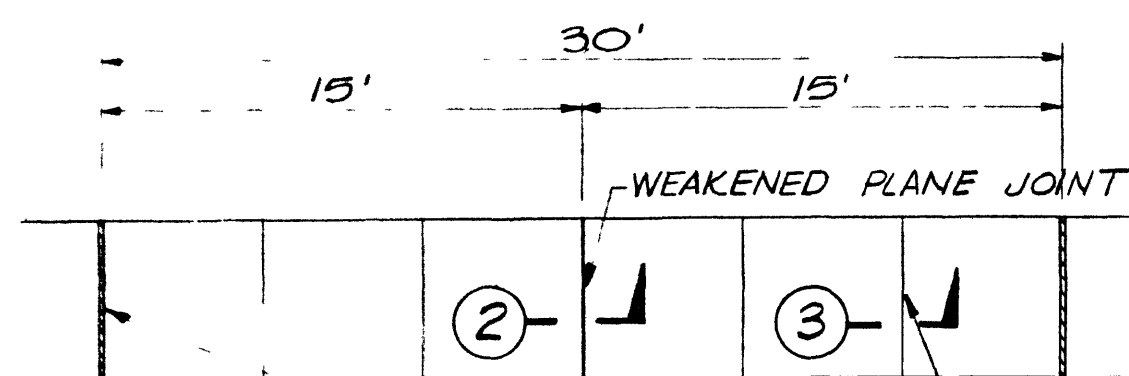


PLAN

CONCRETE SIDEWALK
NO SCALE




WEAKENED PLANE JOINT
SECTION 2
NO SCALE


SCORING LINE
SECTION 3
NO SCALE

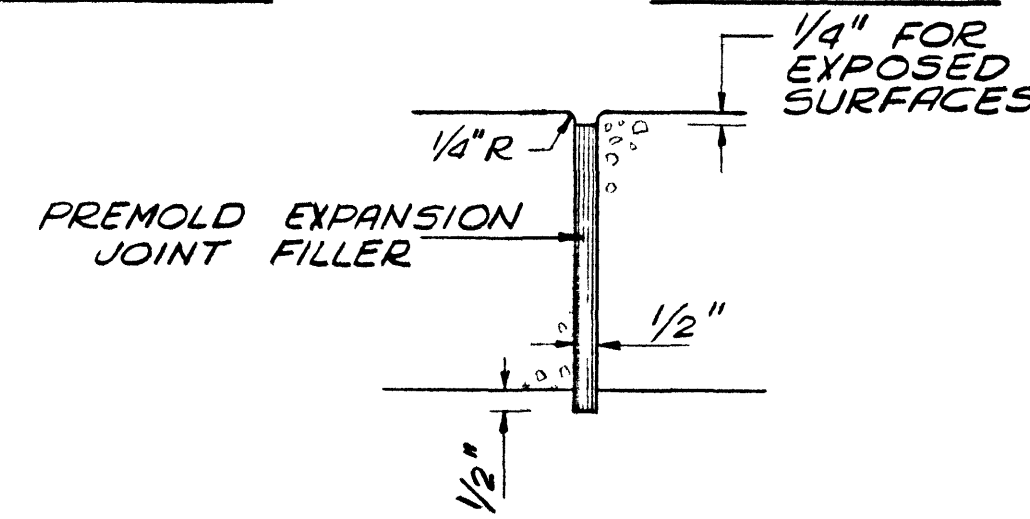


TYP. EXPANSION JOINT
SECTION 1
NO SCALE

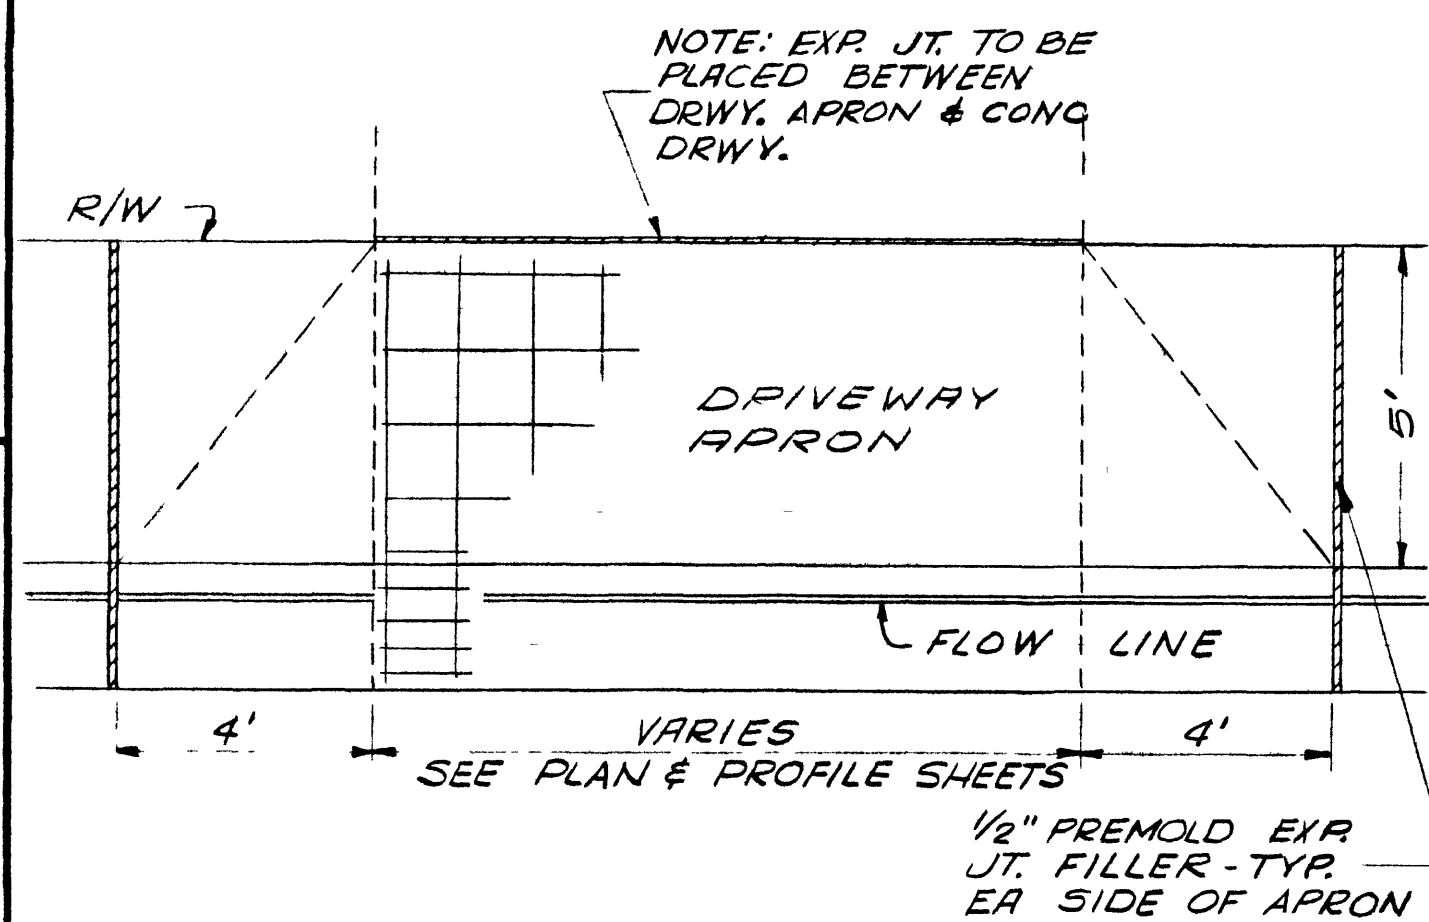


PLAN

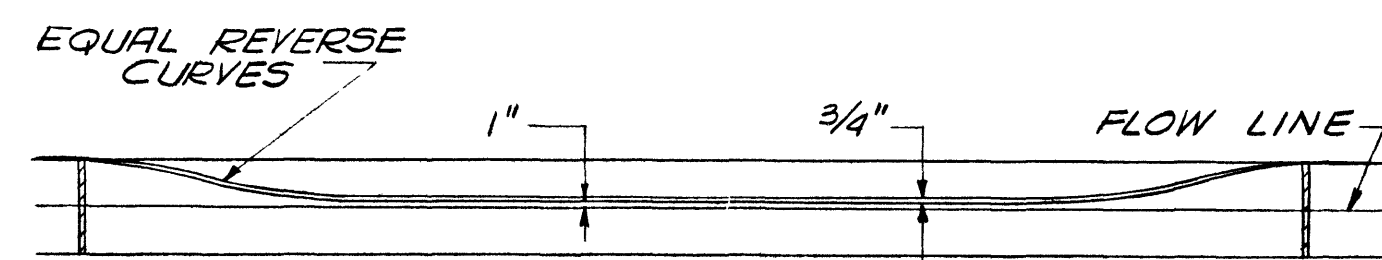


ELEVATION

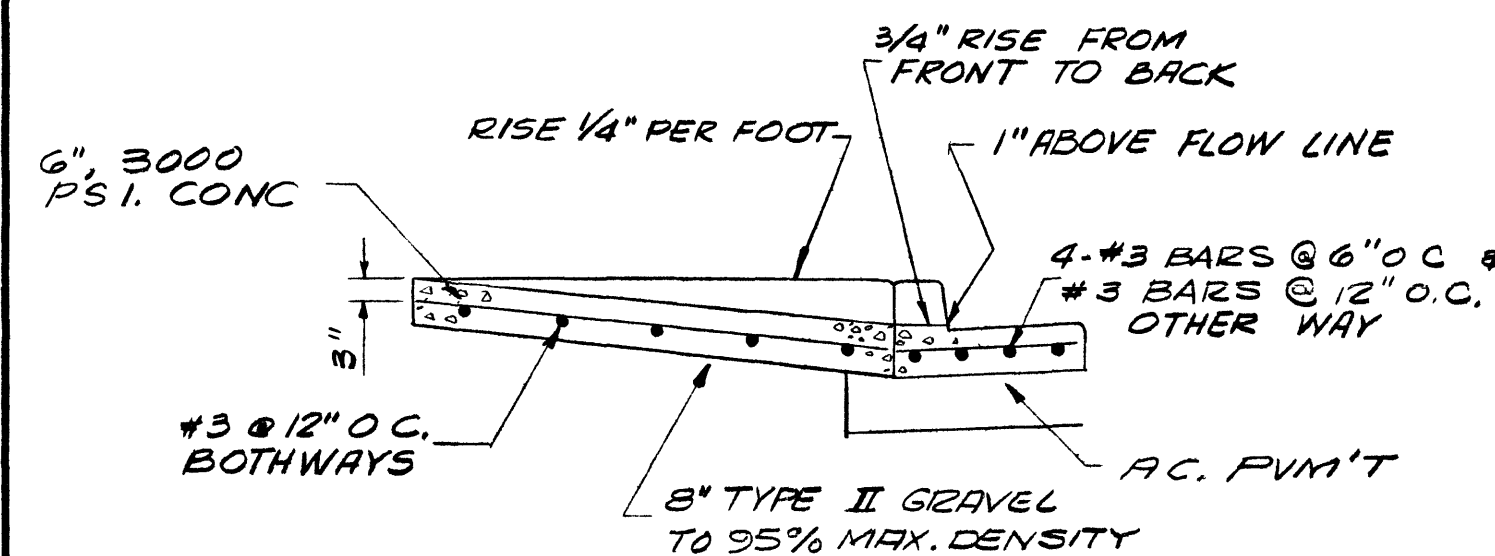


SECTION
COMMERCIAL DRIVEWAY APRON
NO SCALE

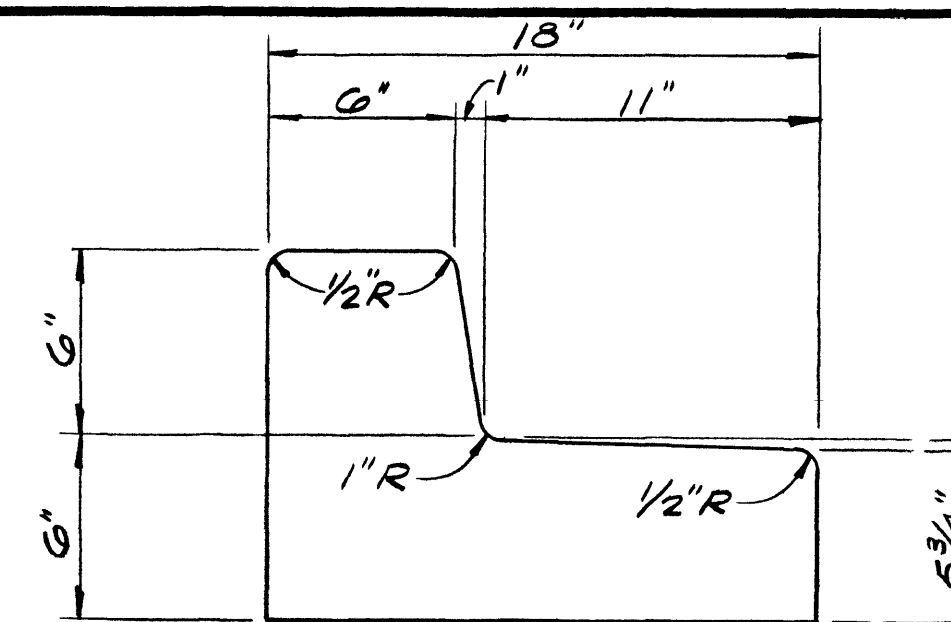


ISLAND CURB
(SEE PLAN AT LEFT)
SECTION 5
NO SCALE

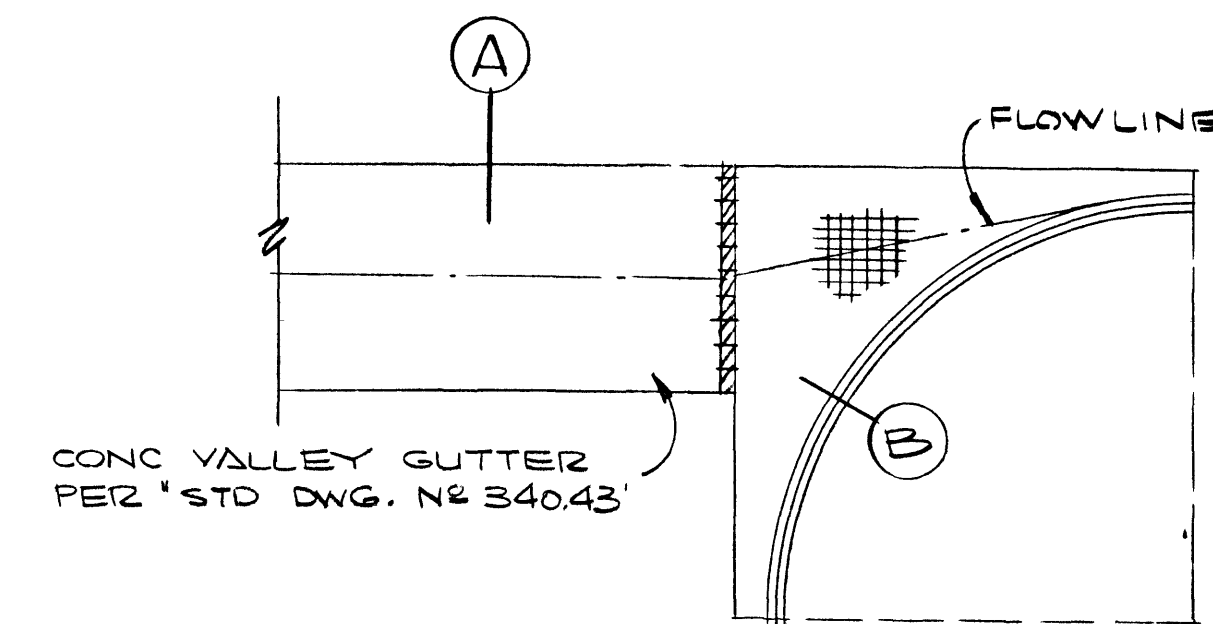


PLAN

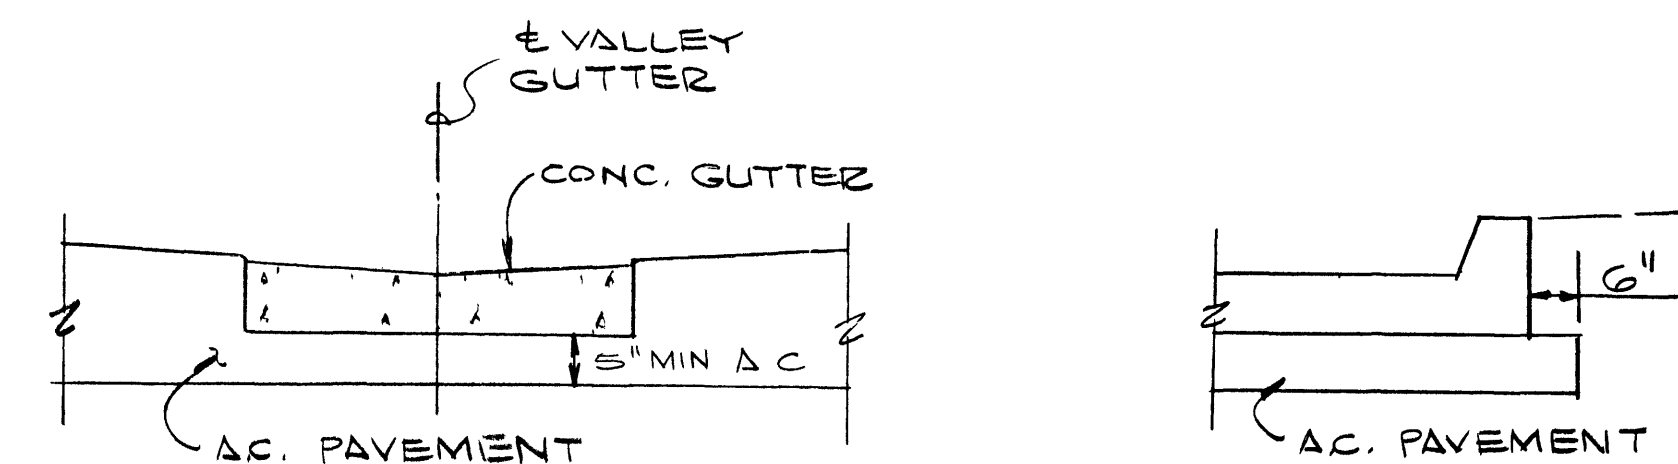


SECTION A
SECTION B
CONCRETE VALLEY GUTTER
NO SCALE

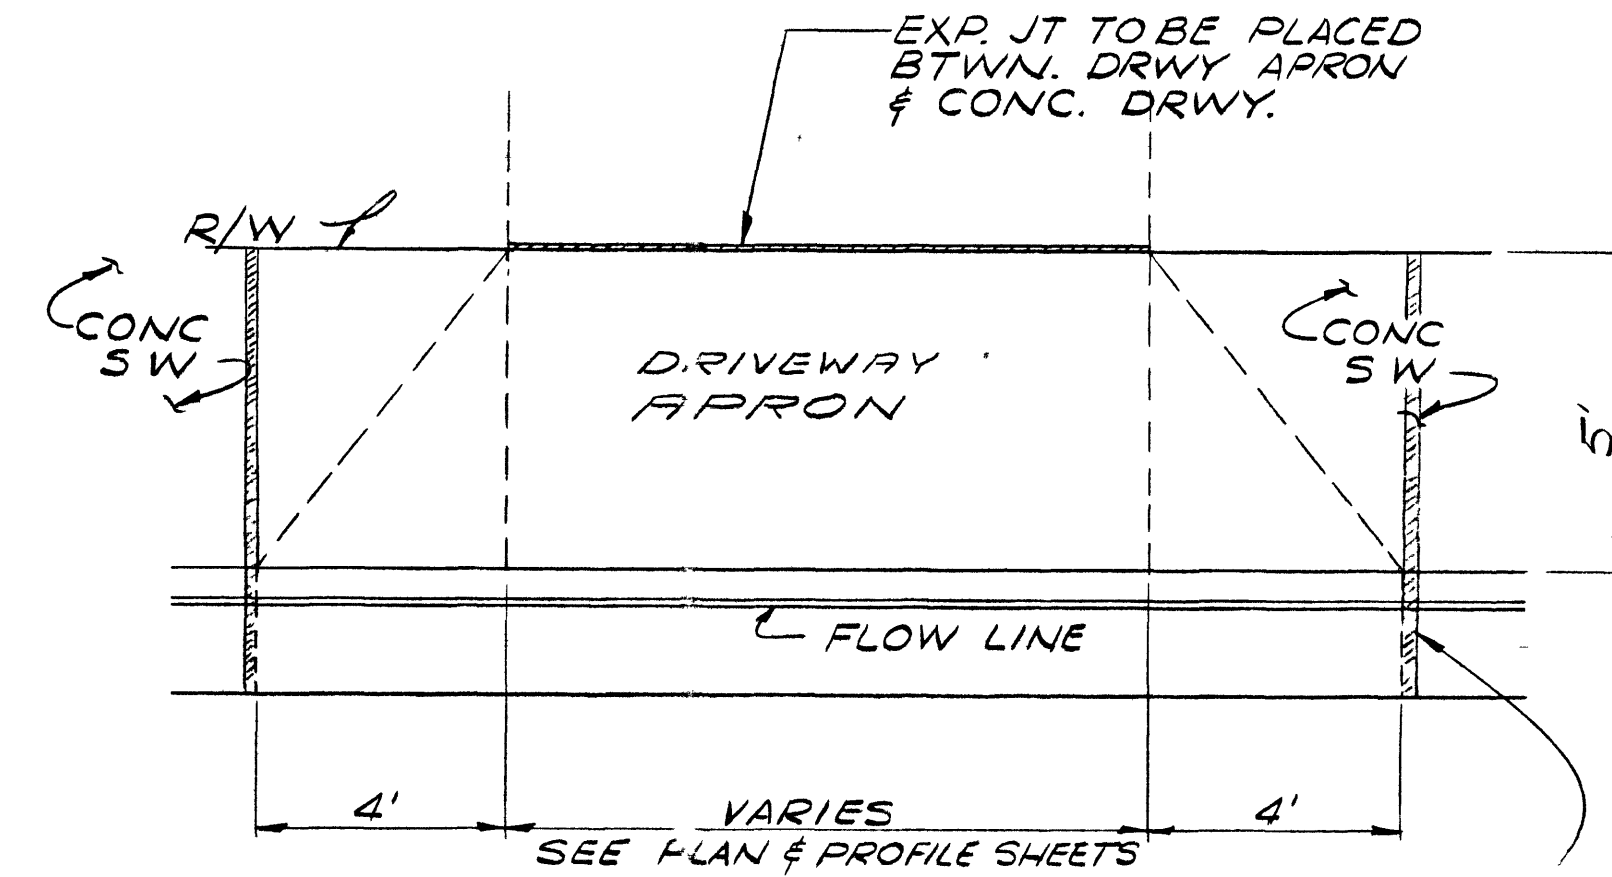


PLAN

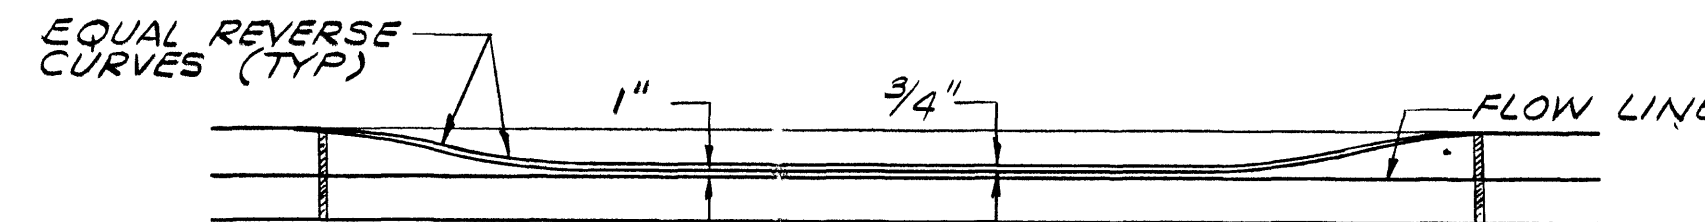

ELEVATION

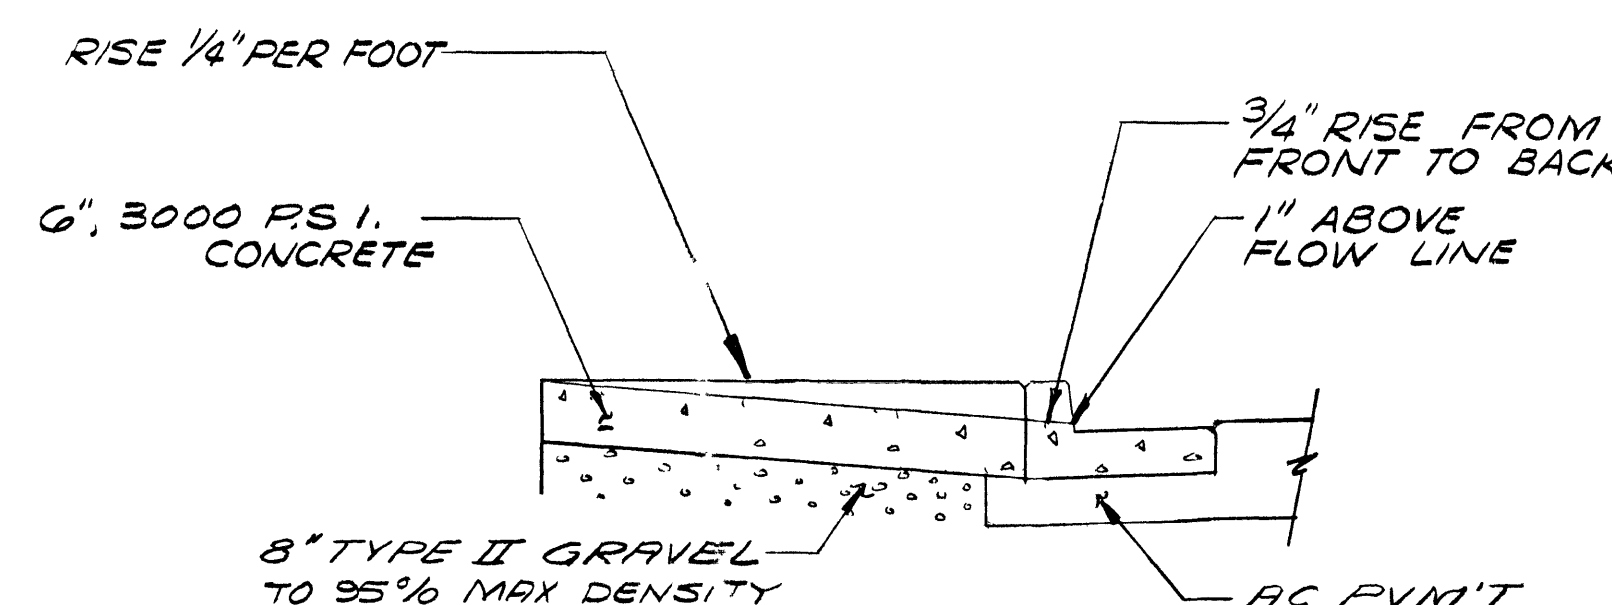

SECTION
RESIDENTIAL DRIVEWAY APRON
NO SCALE

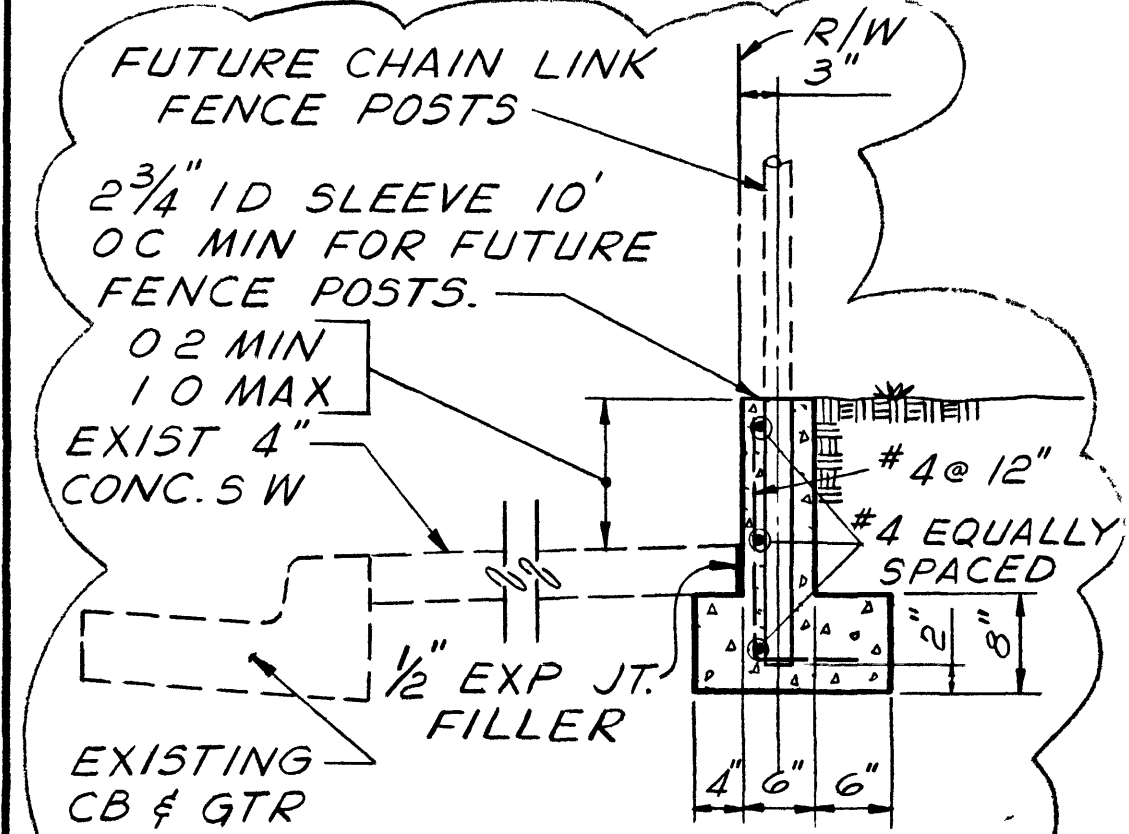

TYPICAL SECTION @
RETAINING WALL
SCALE 3/4" = 1'-0"

REV	DATE	DESCRIPTION
1	12/15/15	AS-BUILT, ADDED
2	12/15/15	RETAINING WALL SECT
3	12/15/15	DATE
4	12/15/15	DATE
WALLACE - MONTGOMERY, A JOINT VENTURE
G. C. WALLACE, Consulting Engineer
MONTGOMERY ENGINEERS OF NEVADA
735-5709
LAS VEGAS, NEVADA

REGIONAL STREET AND HIGHWAY COMMISSION, CLARK CO., NEV.
EAST CHARLESTON BLVD FROM FREMONT ST TO NELLIS BLVD.
SHEET 25
OF 53 SHEETS
TYPICAL DETAILS I