

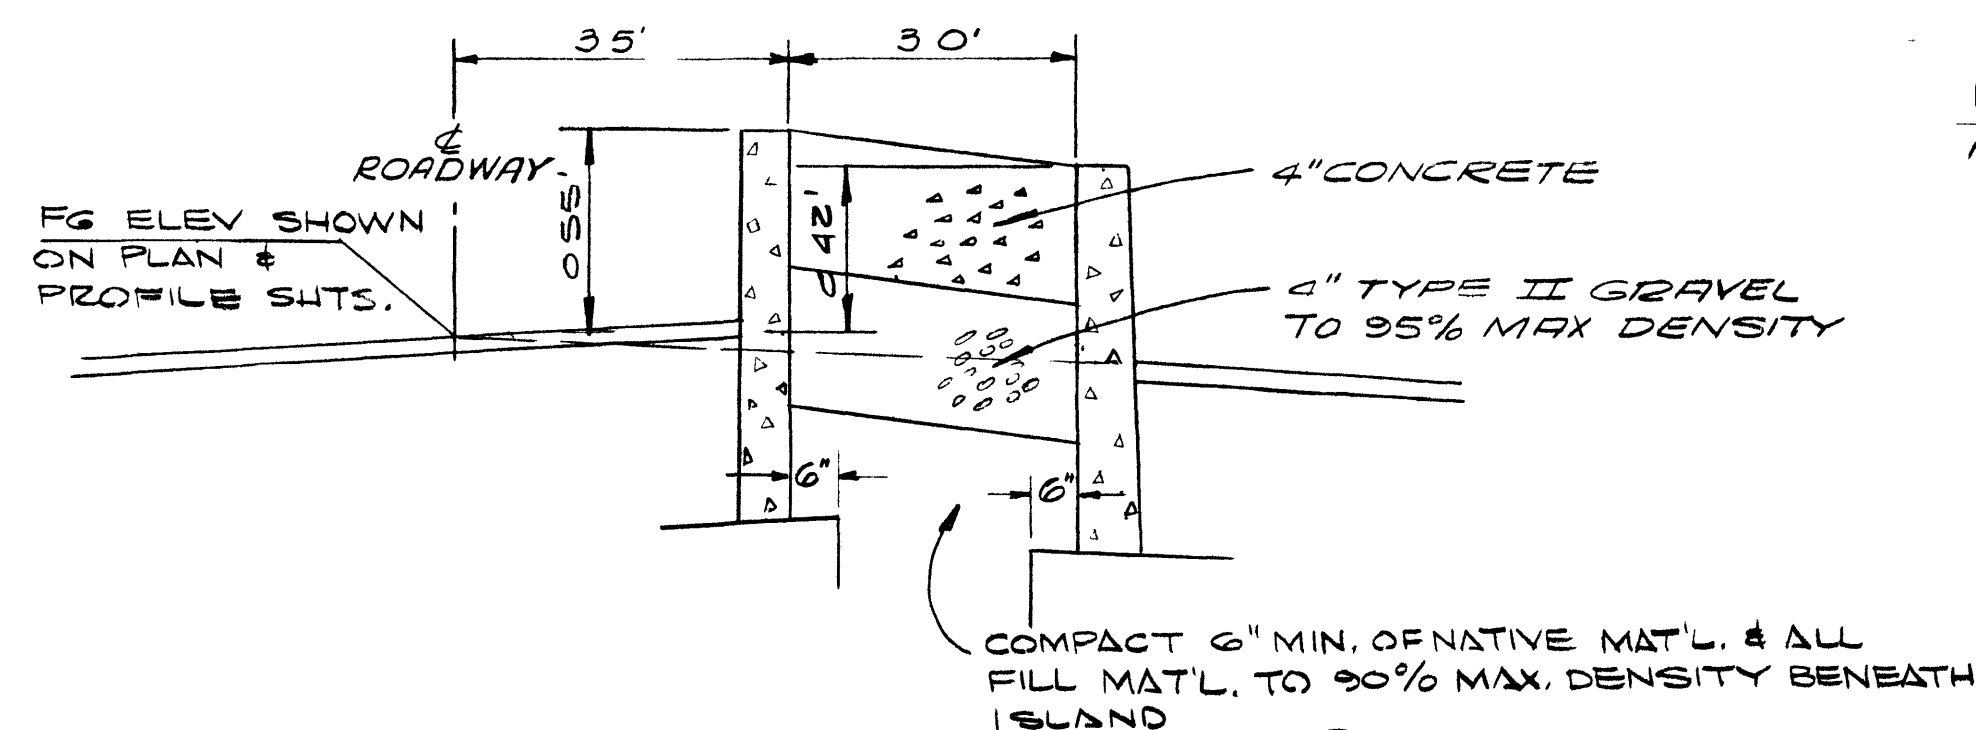


CURVE DATA - BACK OF CURB			
①	Δ	BCR	T
①	180° 00' 00"	150'	4.71
②	14° 50' 00"	150.00'	2.53
③	180° 00' 00"	650'	10.21

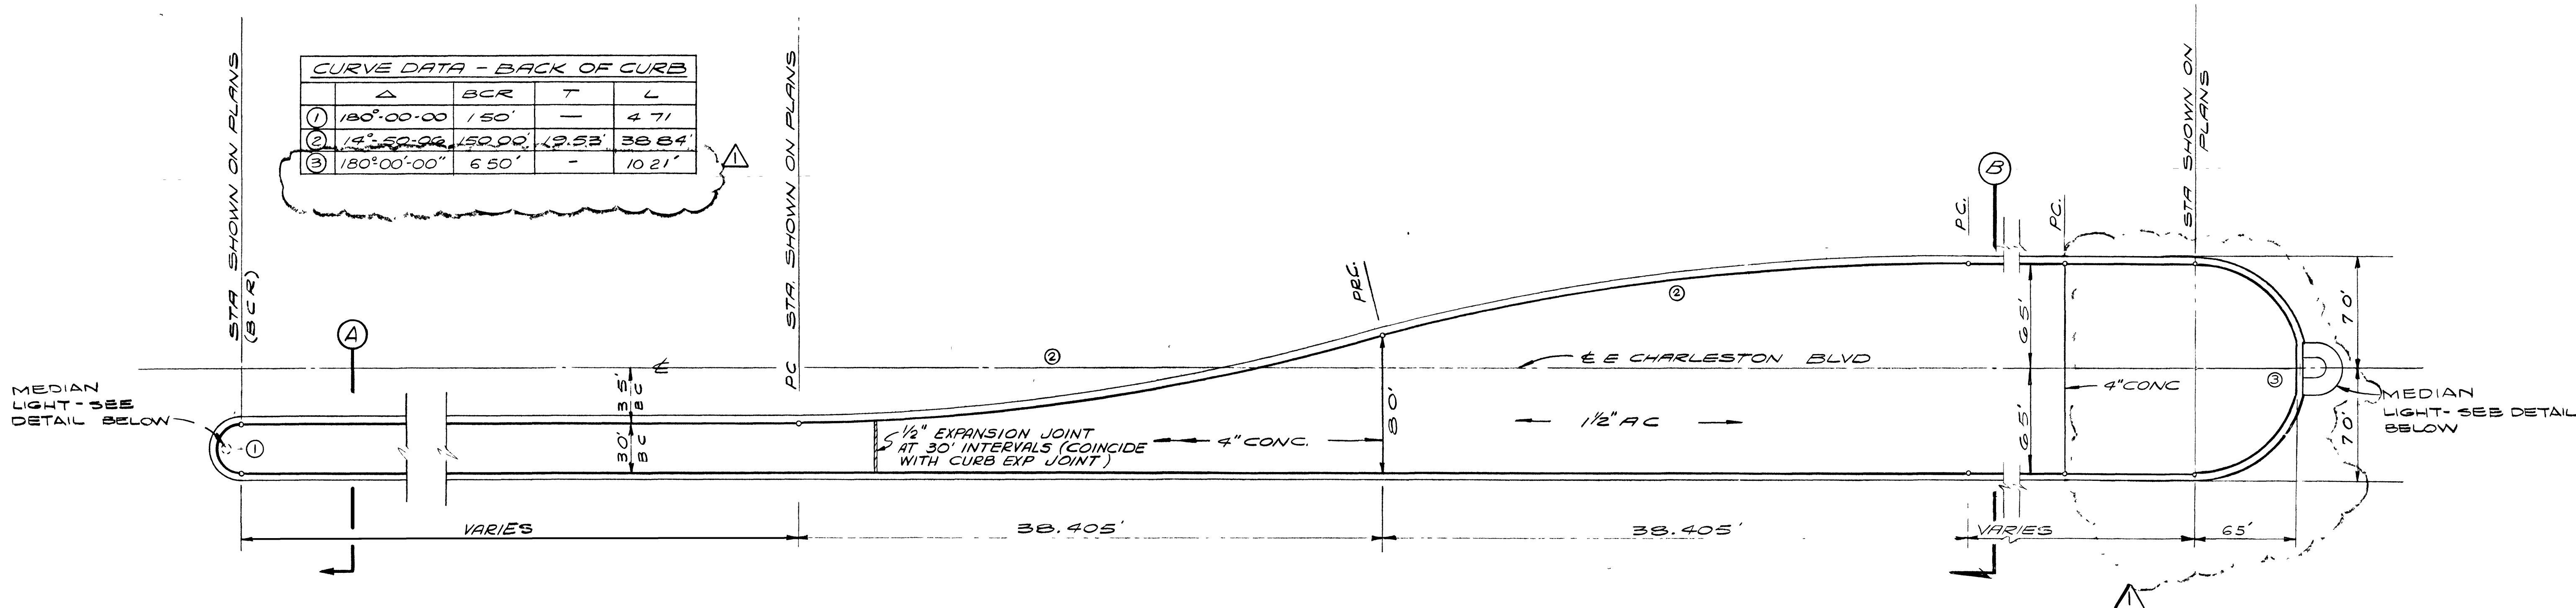


SECTION
NO SCALE

NOTE:
FOR ALTERNATE ISLAND
CURB SEE DET. "C & D" THIS SHT

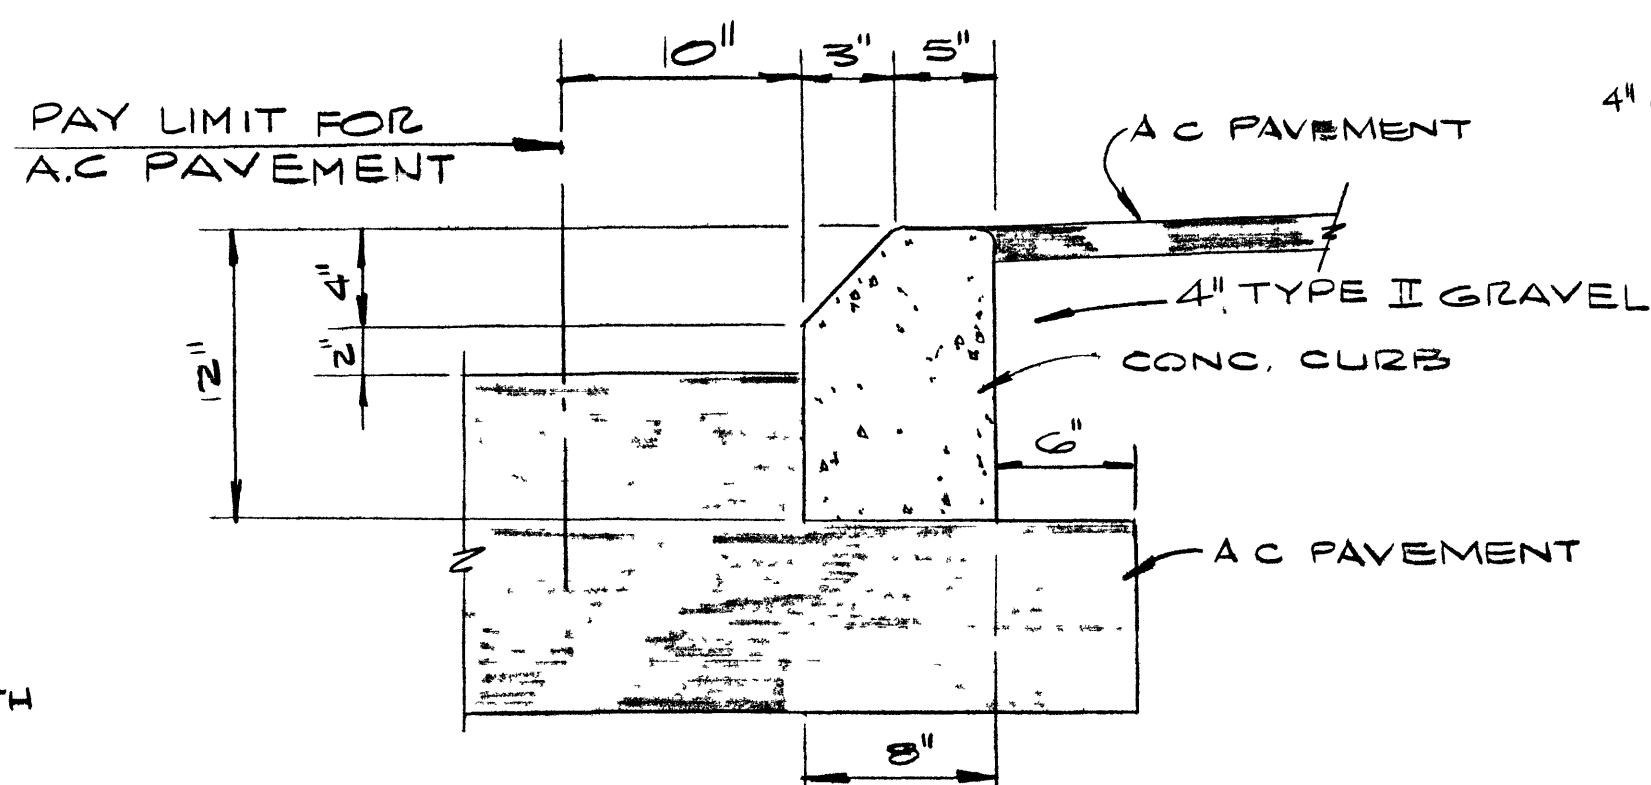


-ALTERNATE ISLAND CURB-
DETAIL
NO SCALE

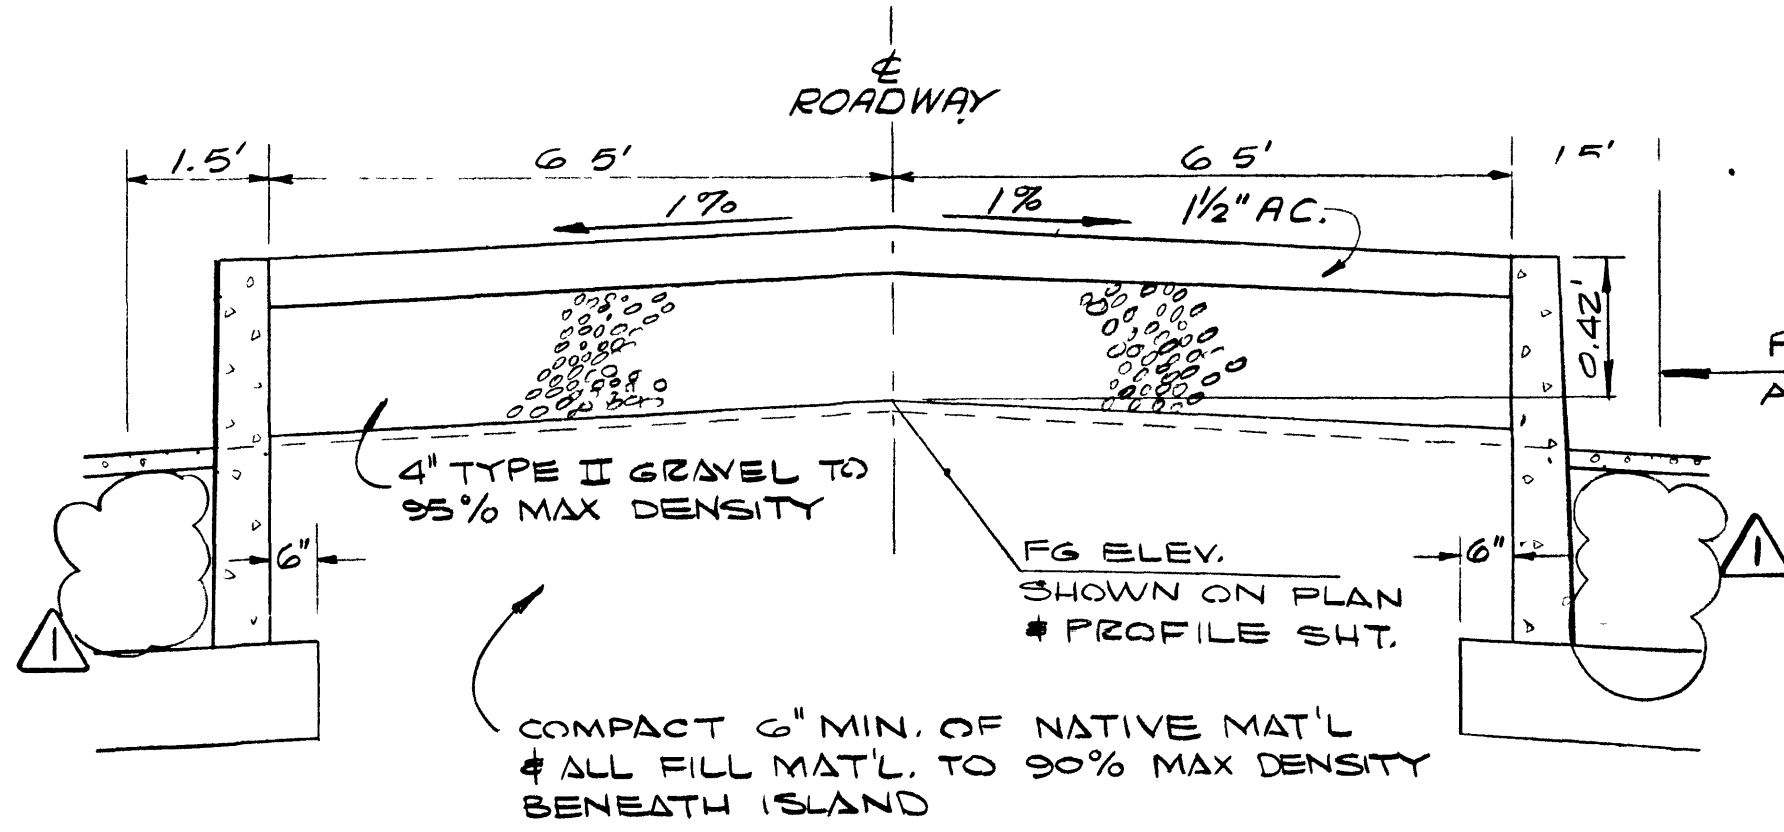


SECTION
NO SCALE

NOTE:
FOR ALTERNATE ISLAND
CURB SEE DET. "C & D" THIS SHT

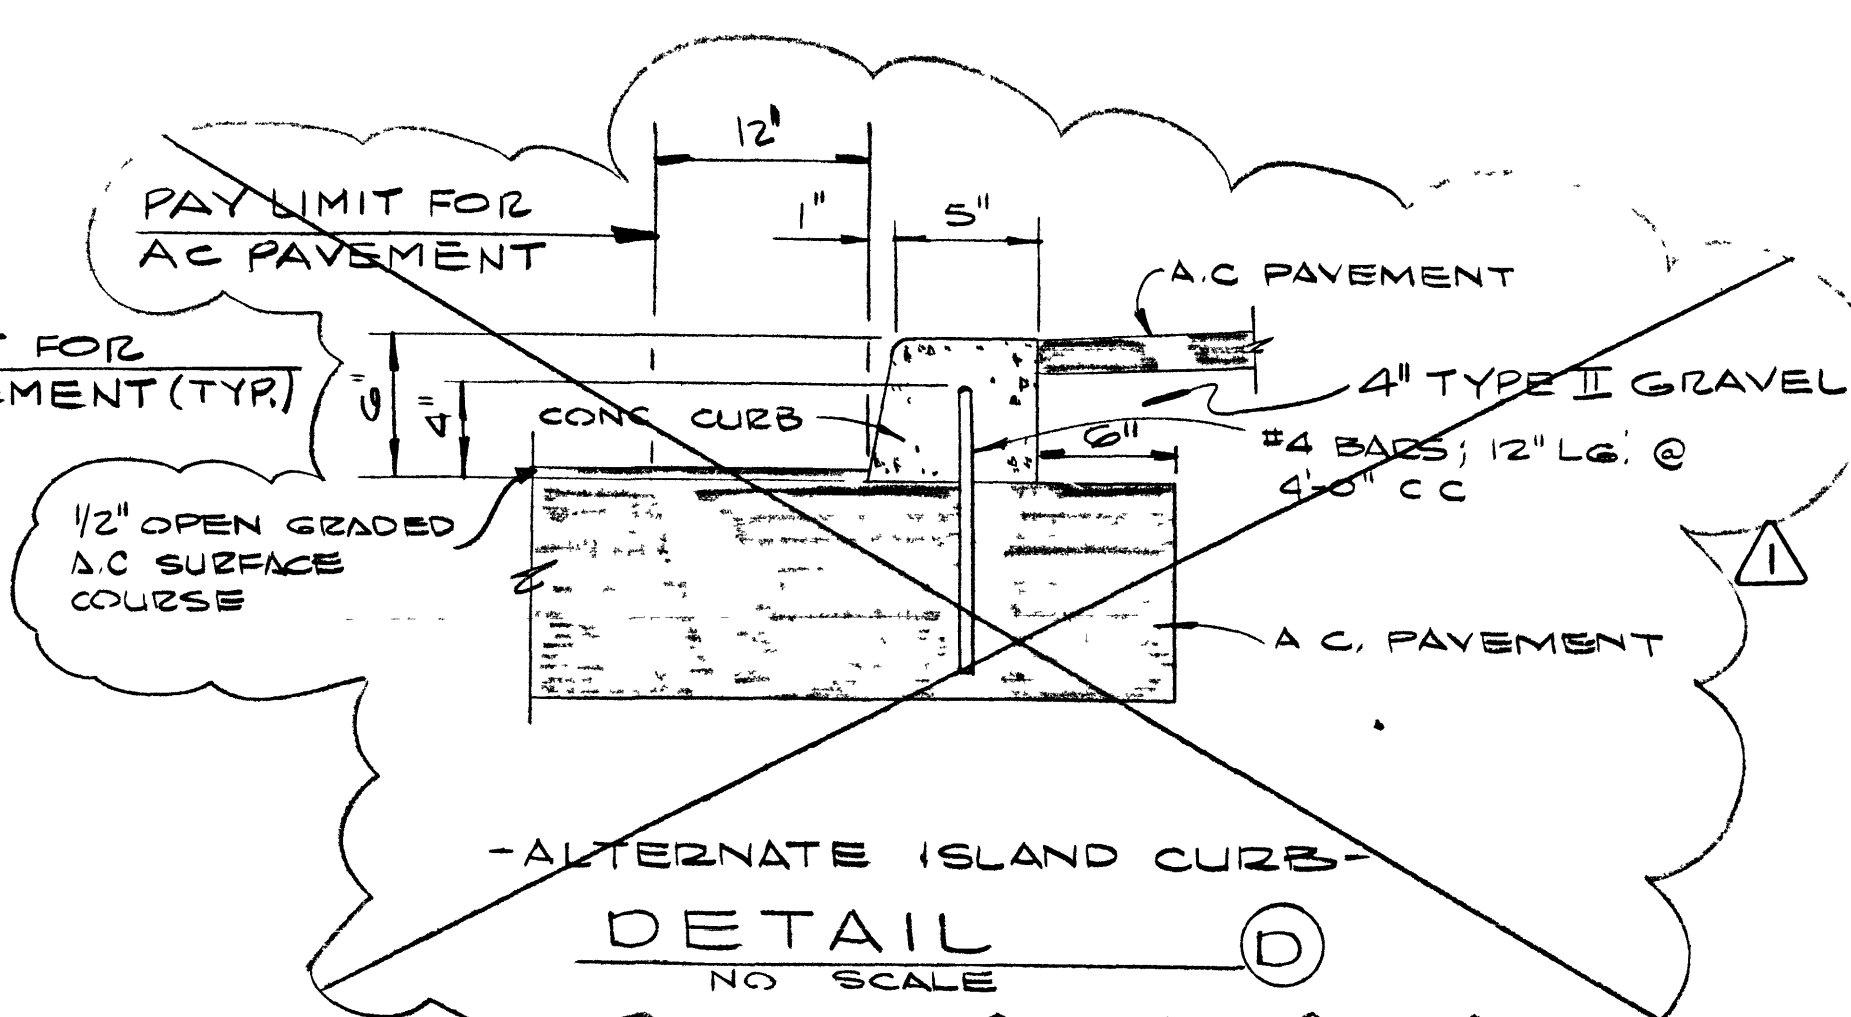


-ALTERNATE ISLAND CURB-
DETAIL
NO SCALE


NOTE: TRACKED TYPE CURB EXTRUDING MACHINES
SHALL NOT BE USED ON NEW A.C. PAVEMENT
FOR CONSTRUCTION OF ALTERNATE ISLAND
CURB PERZ DETAILS C & D ABOVE

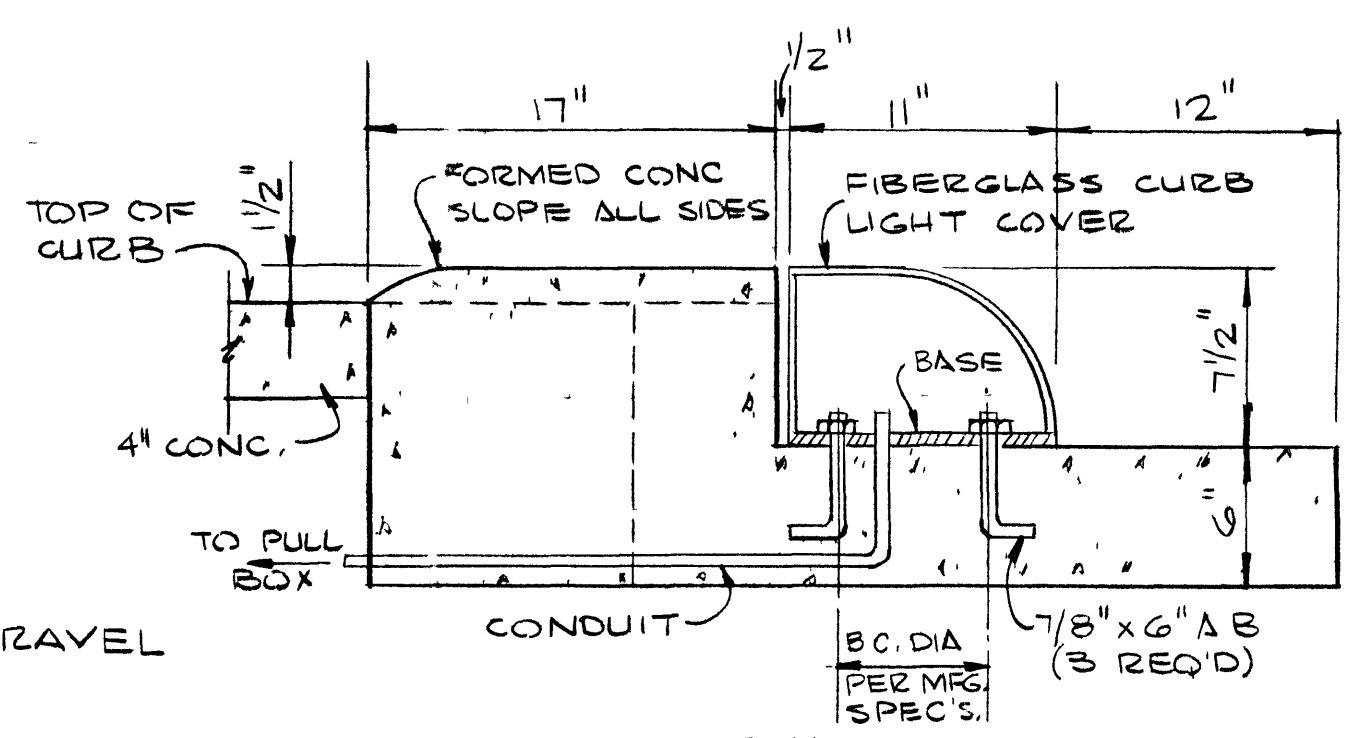


SECTION
SCALE 1/8\"/>

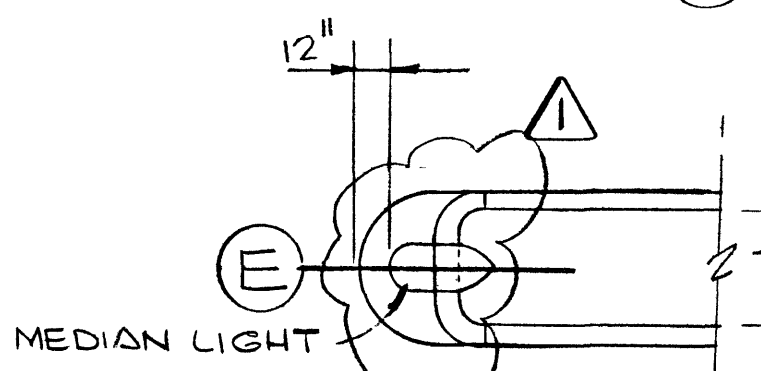

ALTERNATE

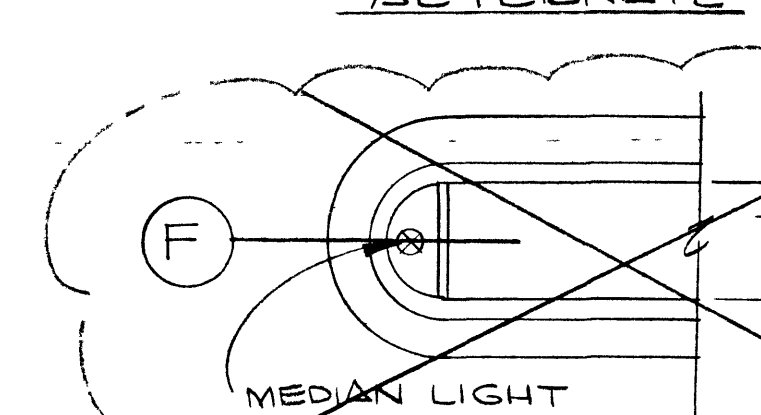

END OF MEDIAN ISLAND WITH LIGHT

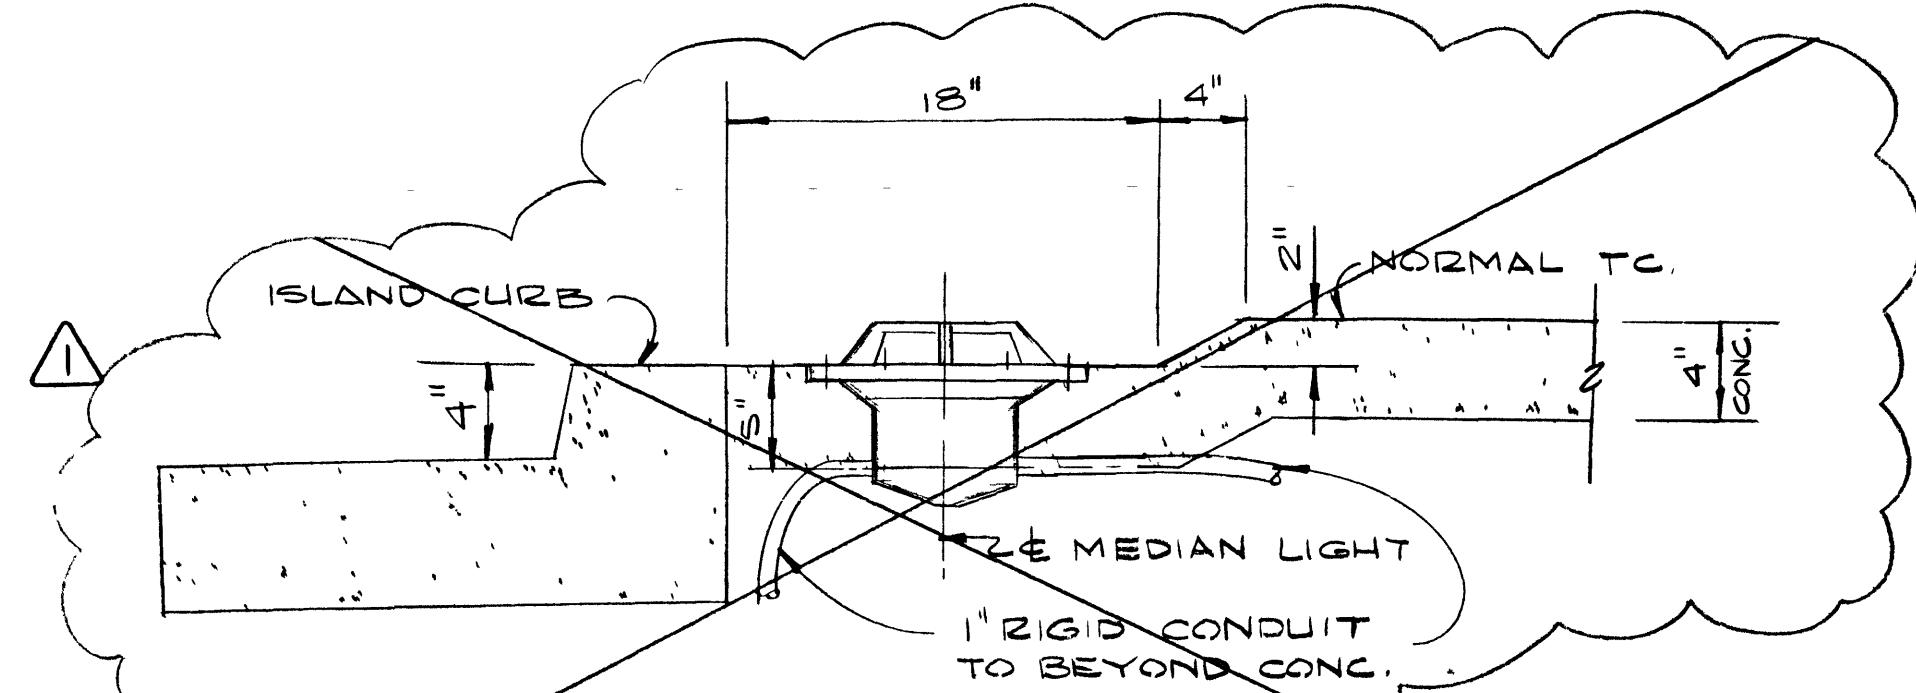

SECTION
SCALE 1/8\"/>

NOTE:
ISLAND LIGHTS
SHALL HAVE
YELLOW LENSES

AS BUILT DRAWING