


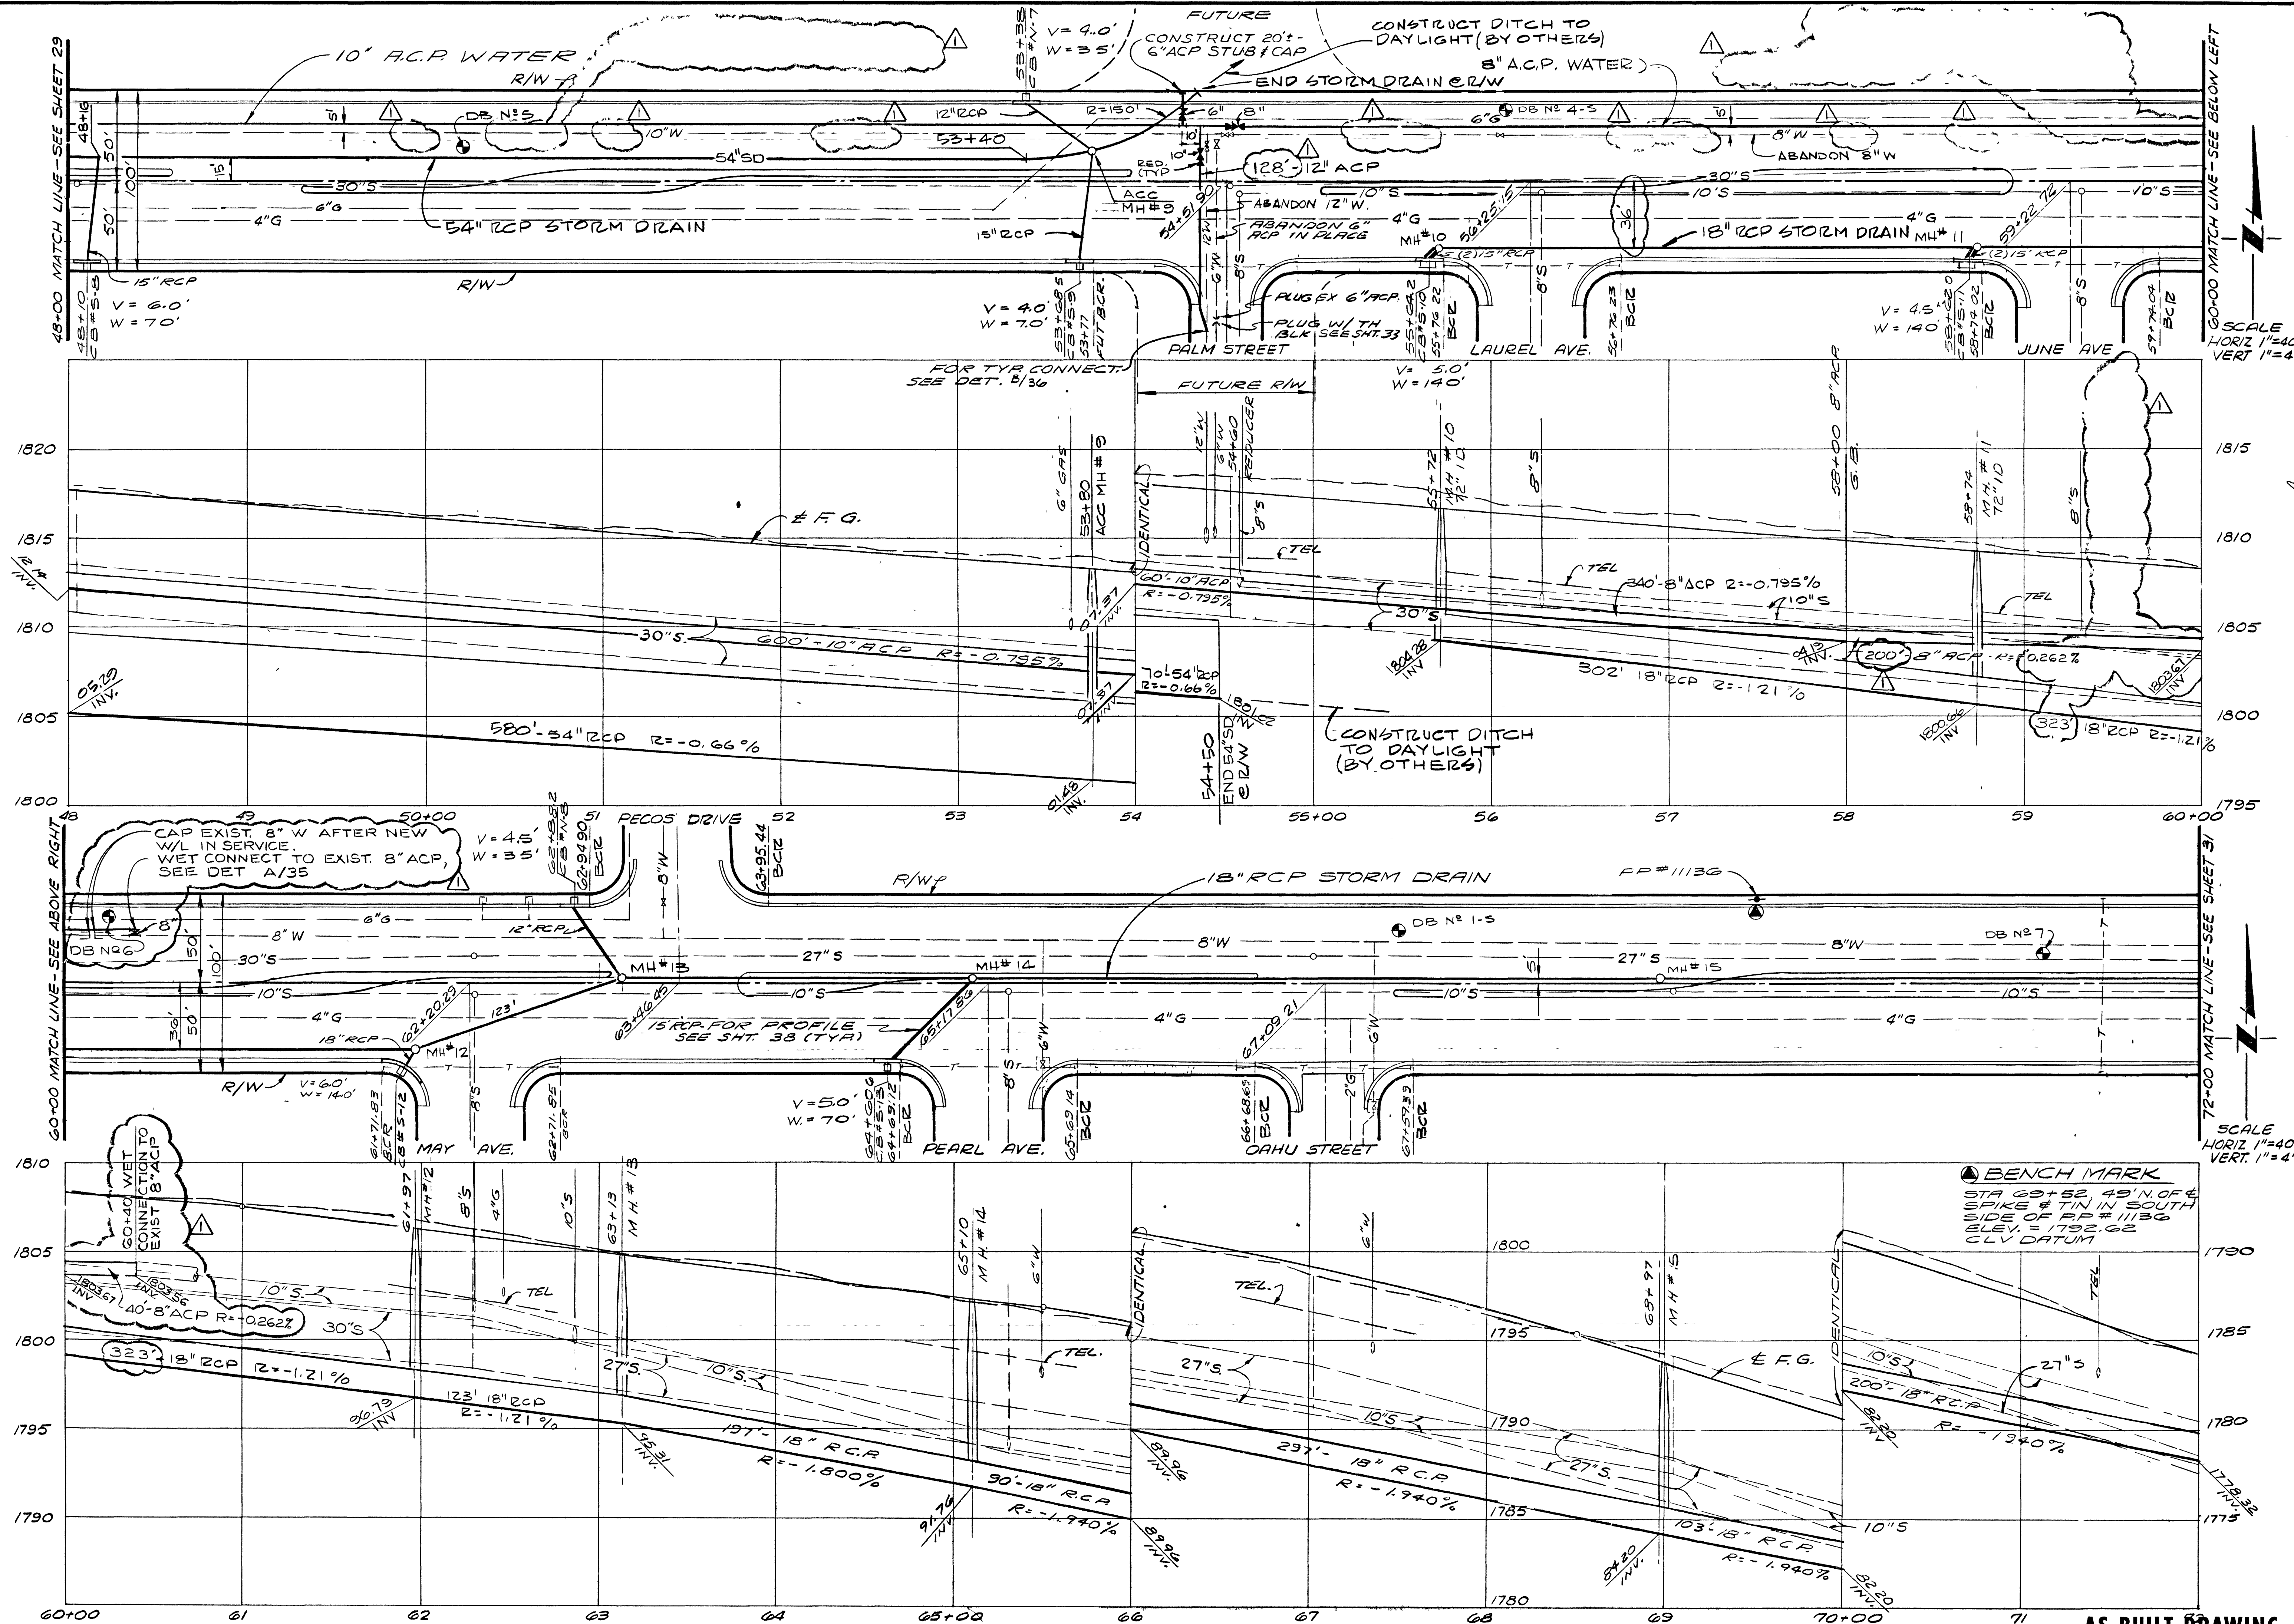

REGIONAL STREET AND HIGHWAY COMMISSION, CLARK CO., NEV EAST CHARLESTON BLVD FROM FREMONT ST TO NELLIS BLVD STORM DRAIN PLAN AND PROFILE 48+00 TO 72+00	WALLACE - MONTGOMERY, A JOINT VENTURE G. C. WALLACE, Consulting Engineer 735-5709 735-7198 LAS VEGAS, NEVADA		RECOMMENDED <i>G. C. Wallace</i> G. C. WALLACE 1/3/15 5/4/13 R.E. NO. DATE	REV 1 9-9-15 DATE	DESCRIPTION AS-BUILT
			23/15 5-2-73 R.E. NO. DATE MONTGOMERY ENGINEERS OF NEVADA		