
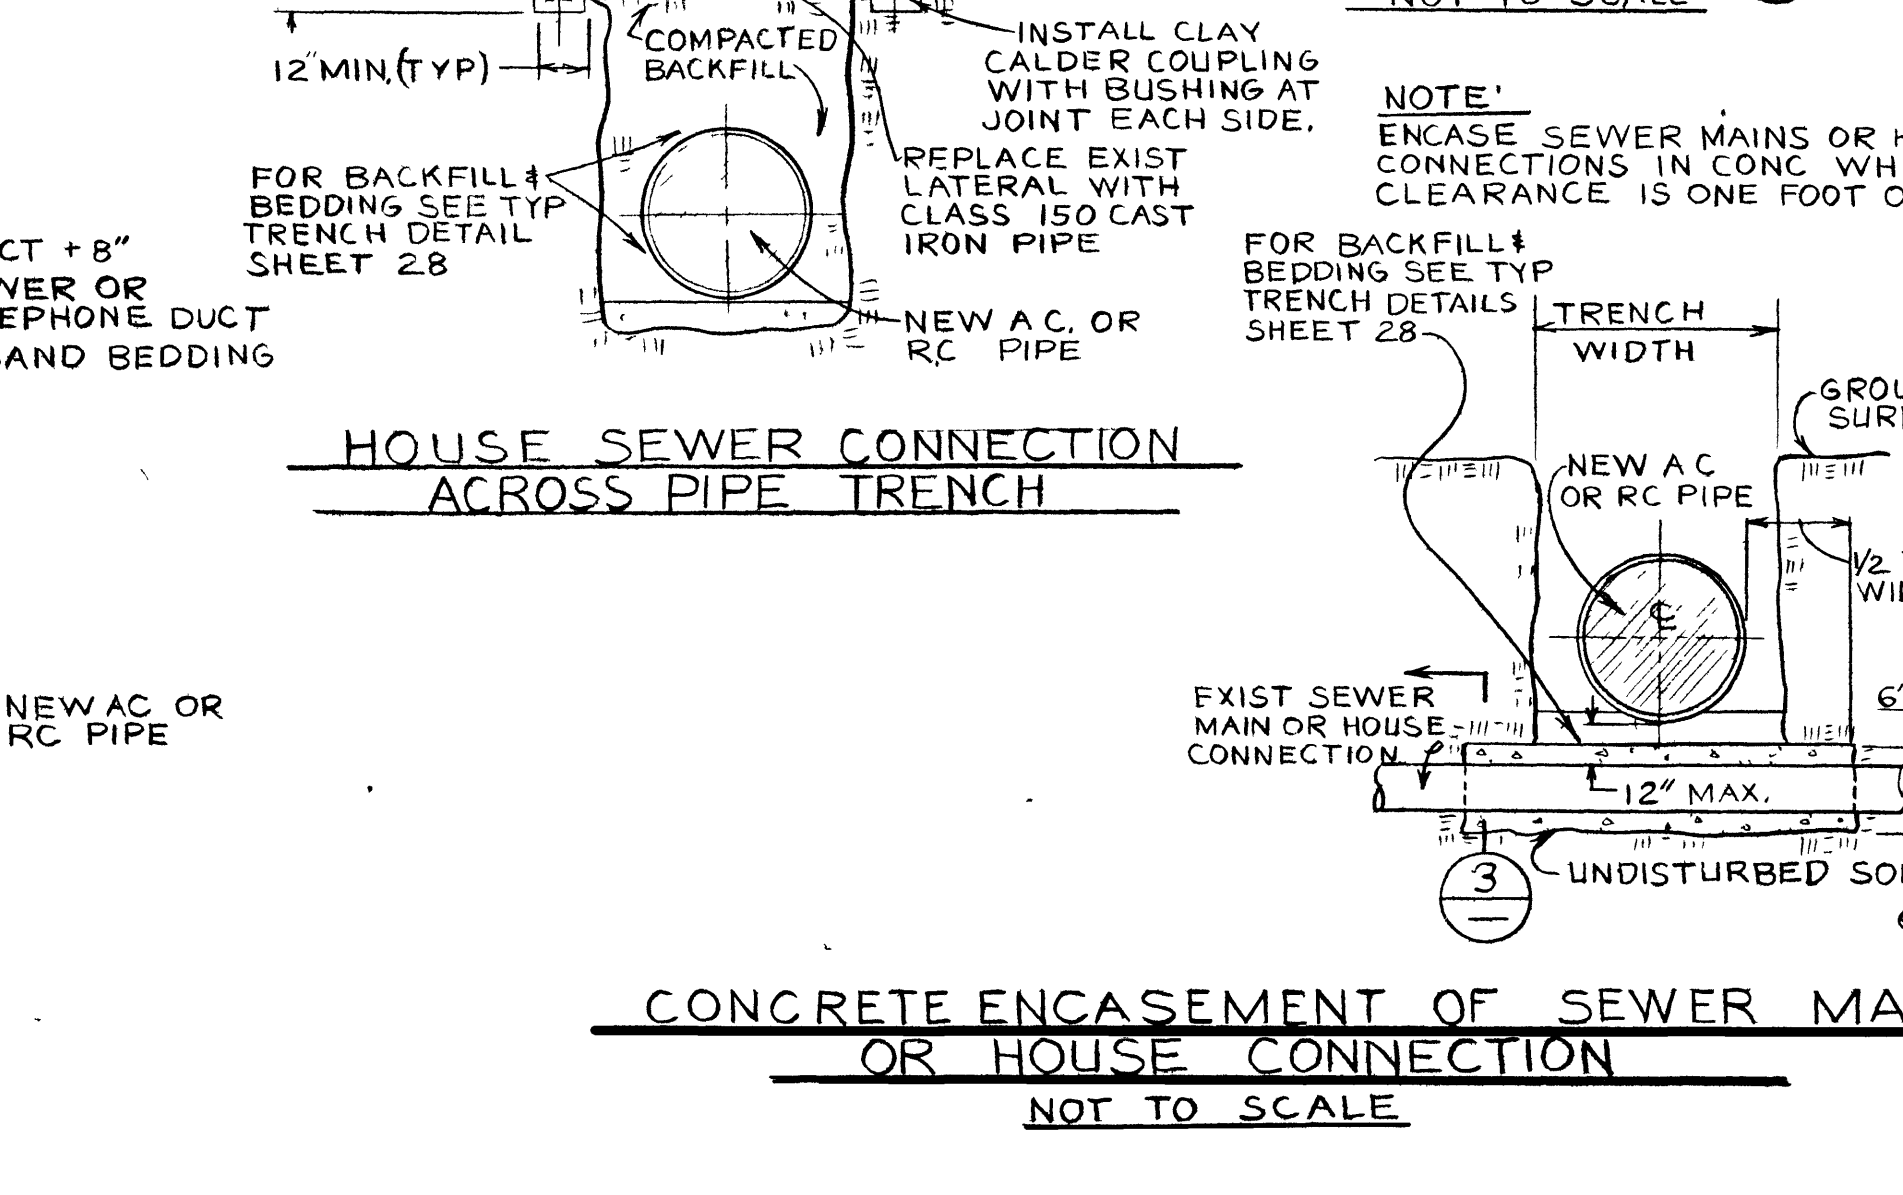
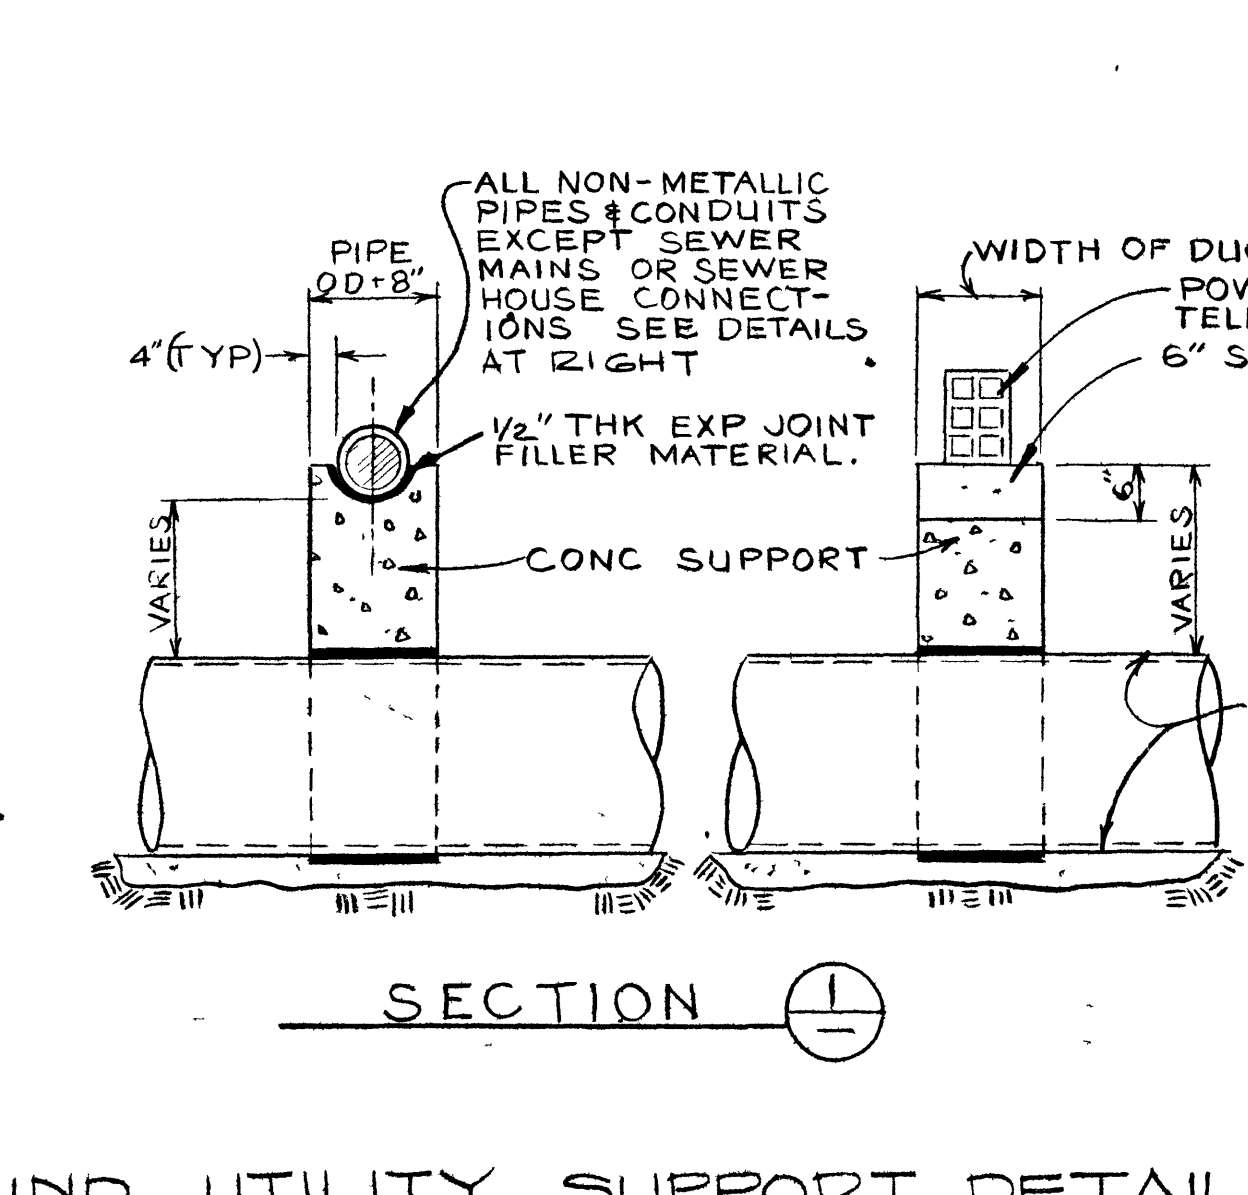
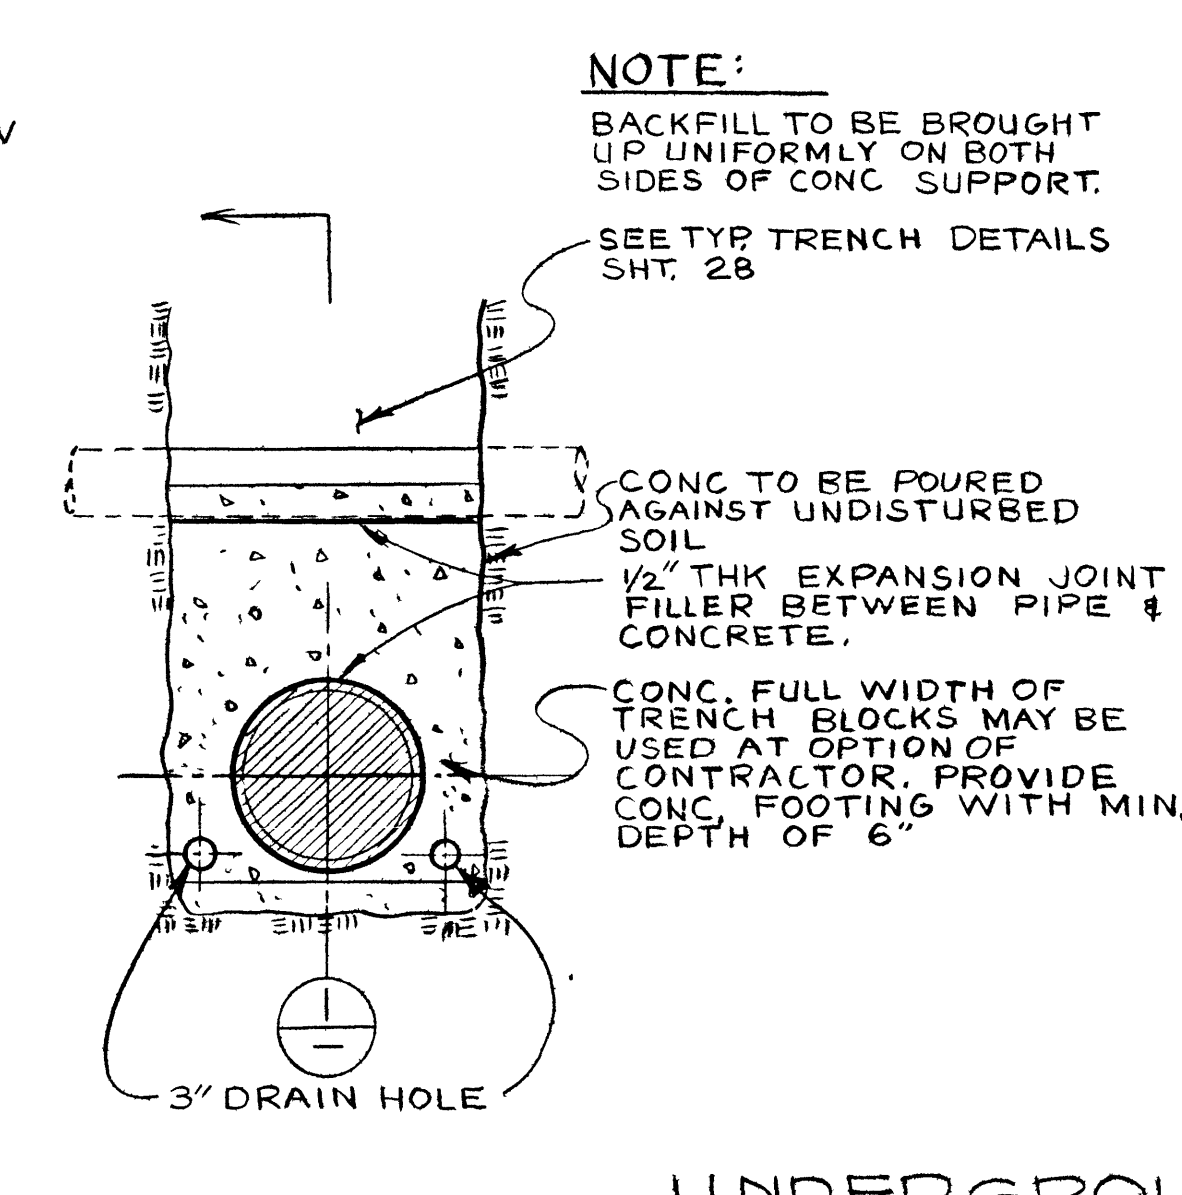
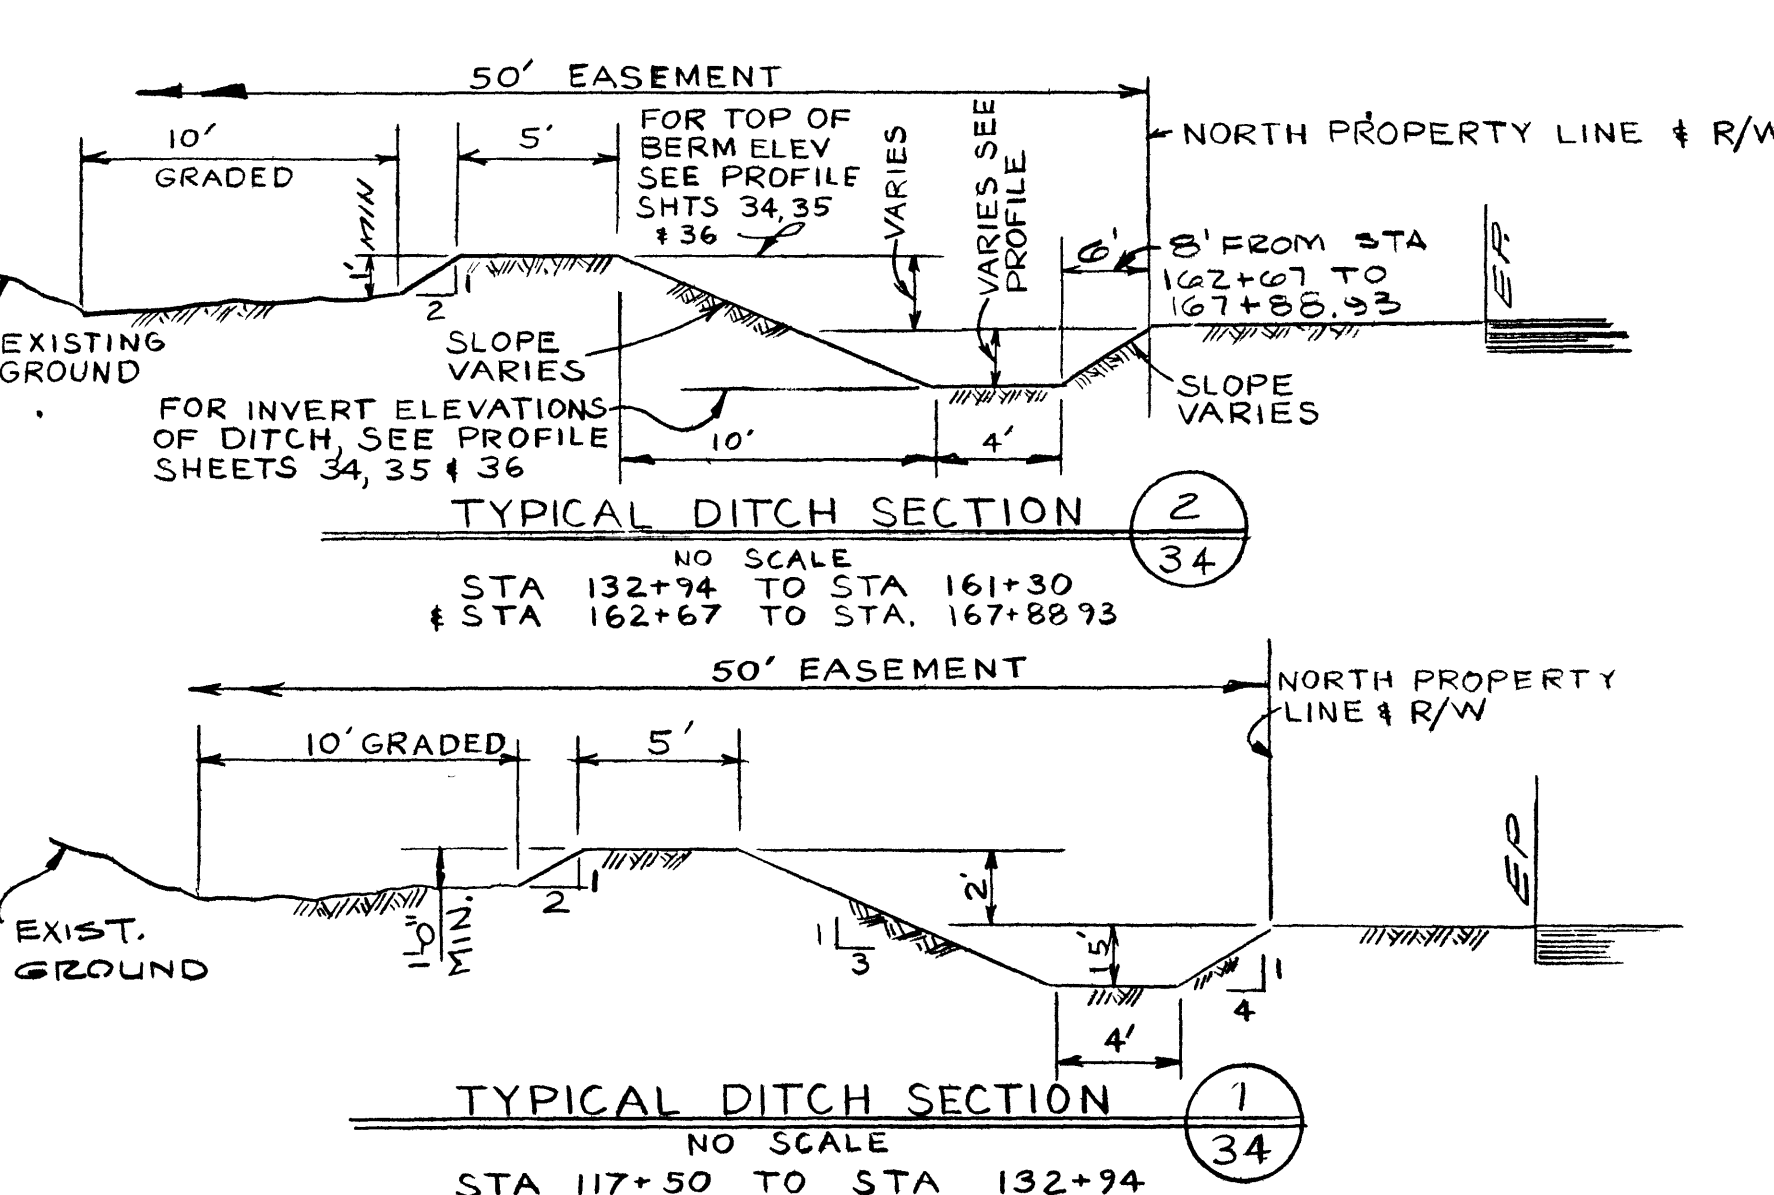


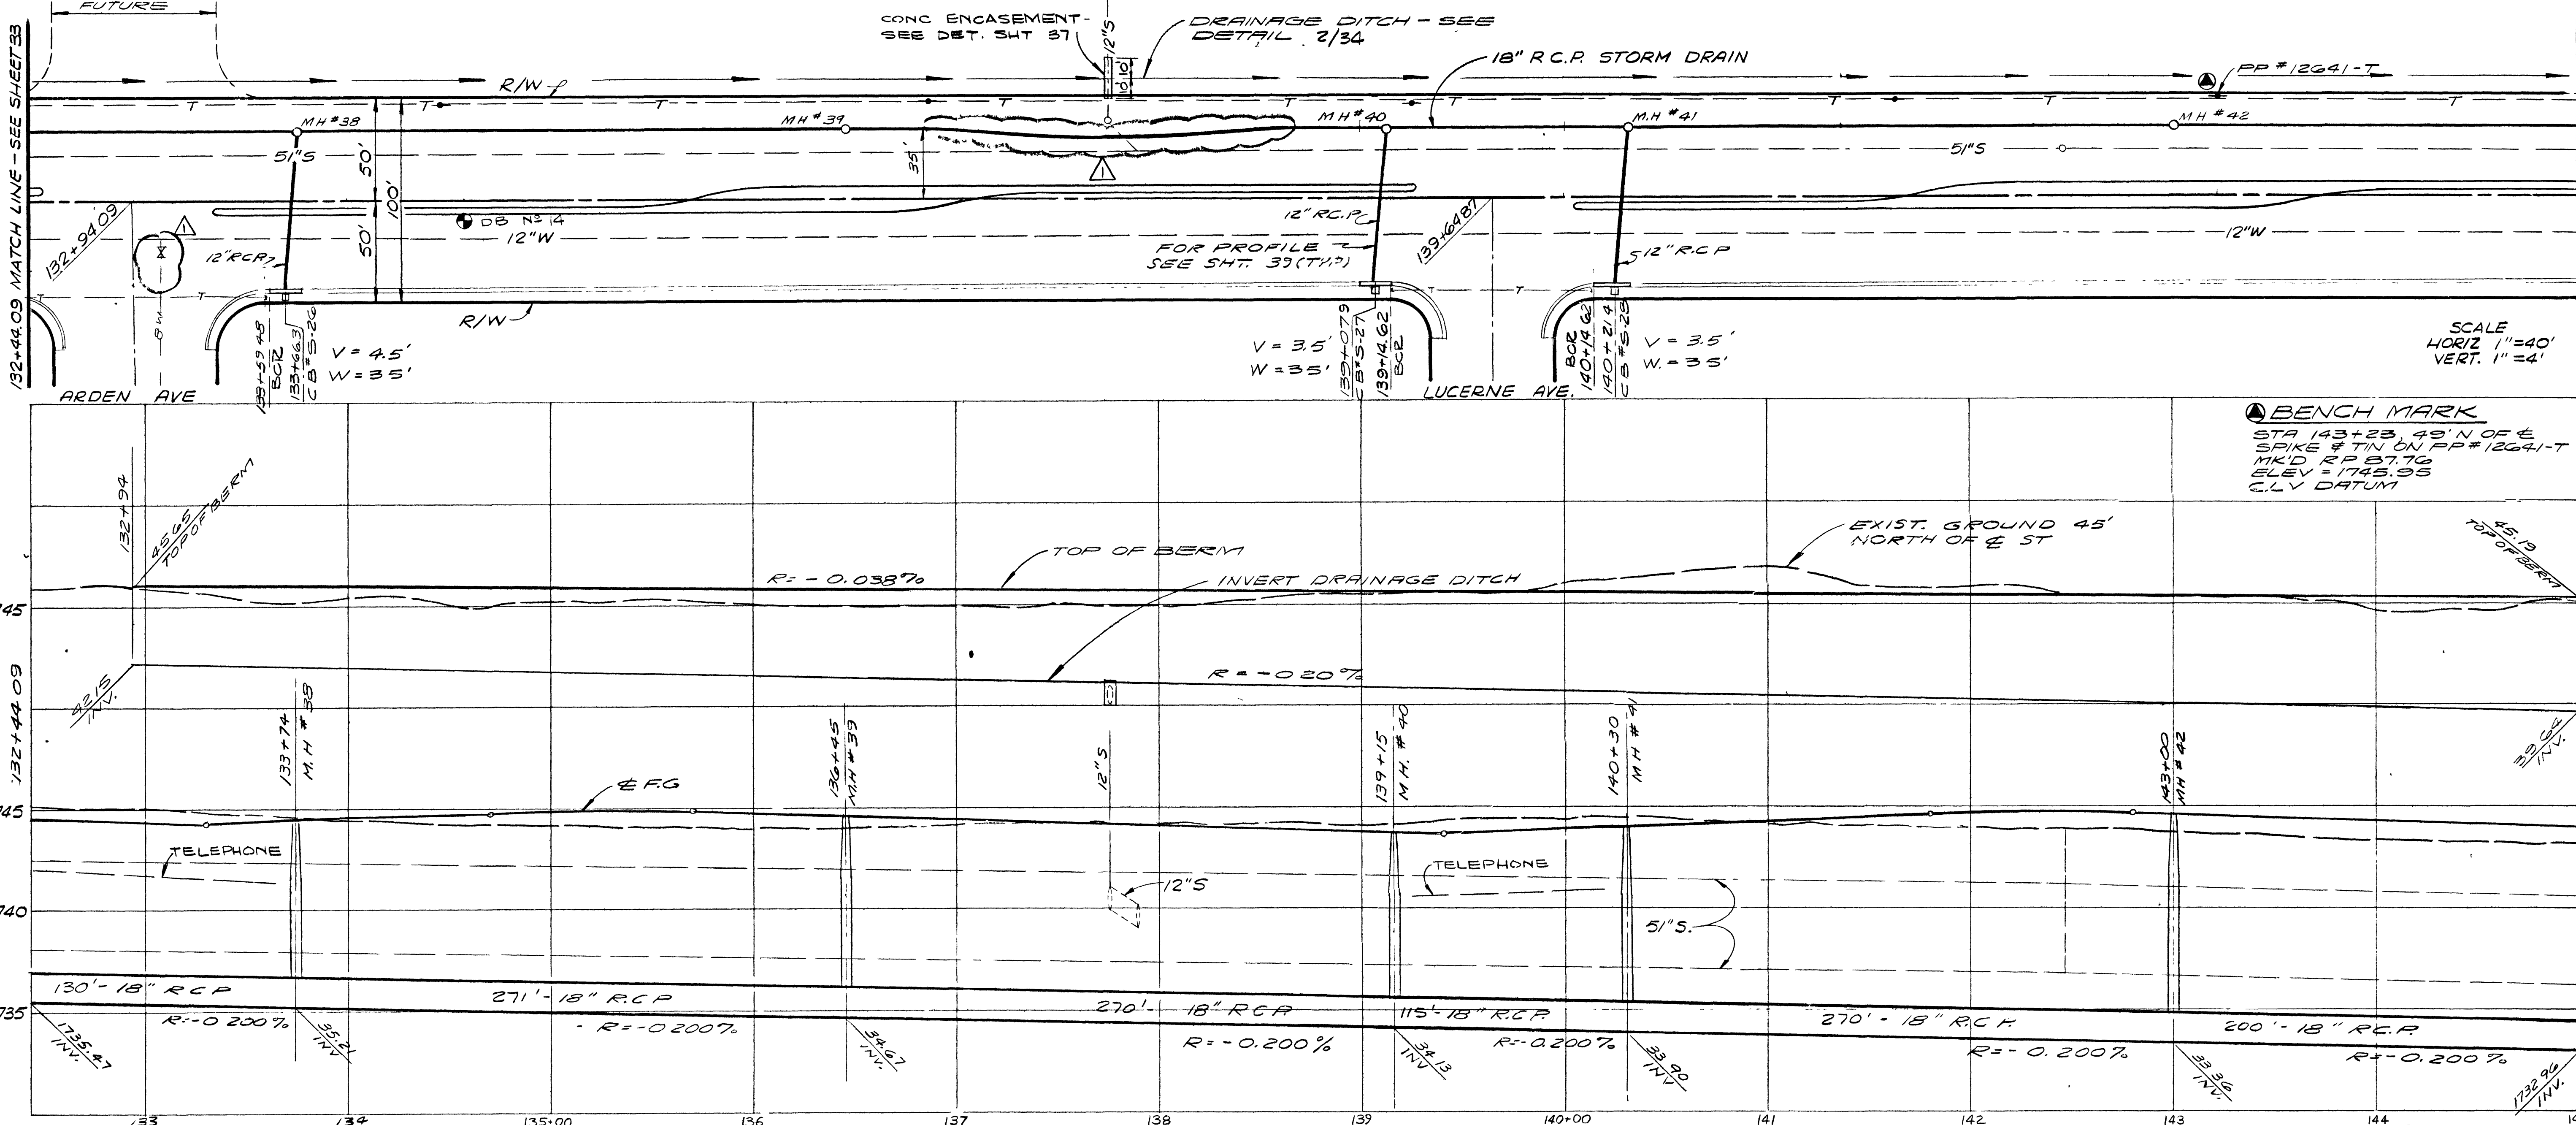

RECOMMENDED BY WALLACE - MONTGOMERY, A JOINT VENTURE G. C. WALLACE, Consulting Engineer MONTGOMERY ENGINEERS OF NEVADA LAS VEGAS, NEVADA 735-5709		DATE 19/5/54 REV 1 AS BUILT	DESCRIPTION STORM DRAIN PLAN AND PROFILE 132+44.09 TO 145+00, AND DETAILS
REGIONAL STREET AND HIGHWAY COMMISSION, CLARK CO., NEV EAST CHARLESTON BLVD FROM FREMONT ST TO NELLIS BLVD		SHEET 34 OF 53 SHEETS	