


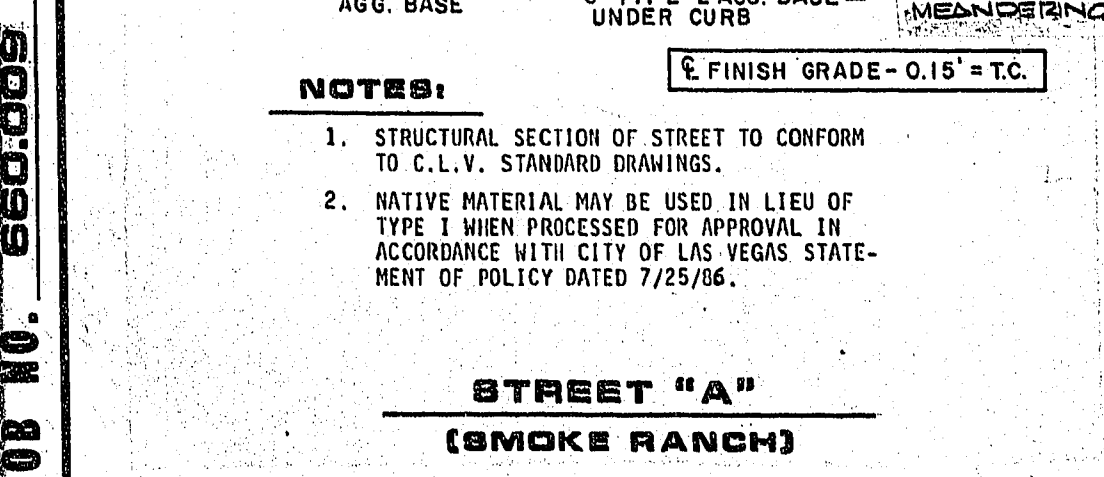

REV	DATE	DESCRIPTION
1	1-19-88	RELOC. SEWER BETWEEN NH= 45
2	1-19-88	3440. ADD. M.I.L. 45A
3	1-19-88	ON SITE WATER METER CONNECTIONS
4	1-19-88	REMOVED ON SITE IMP. & ADDED DETAILS
5	3-16-88	REVISED ON SITE N.P.P.