





SEE L.T. 305
OFFICE SEWER

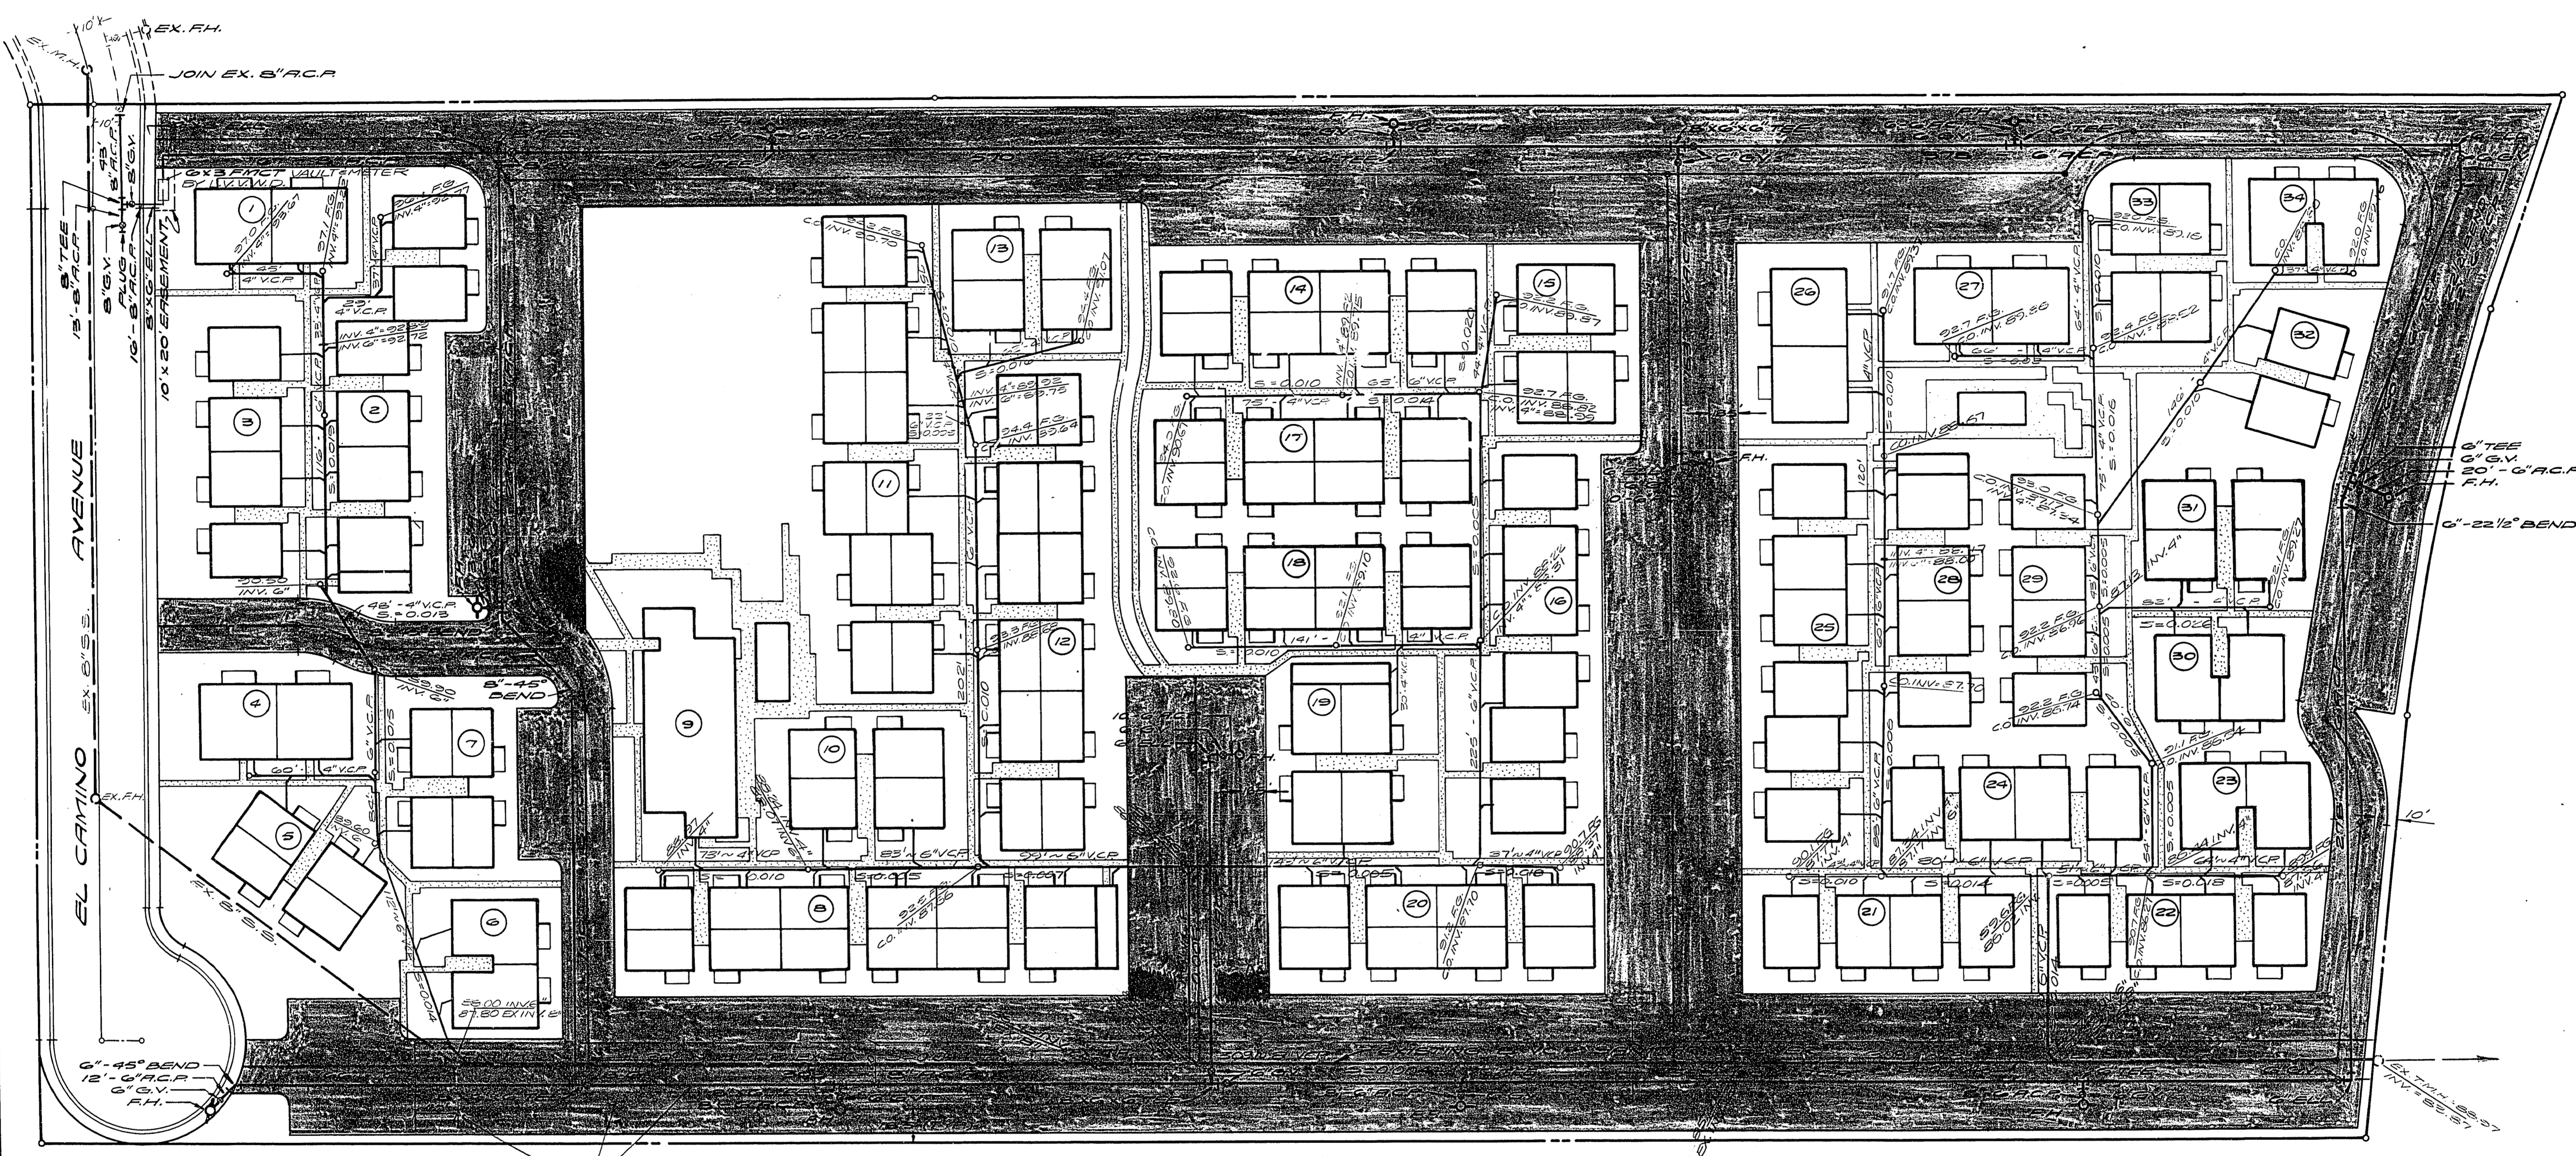

REVISIONS			
NO.	DESCRIPTION/DATE	BY	
1	ROUTE 35 TO EX. ST. 4-25-77	JK	
2	ADD 8' O.V. 4-26-77	JK	

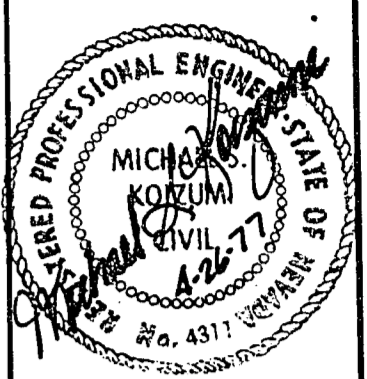

SPARKS, NEVADA
LAS VEGAS, NEVADA
SEATTLE, WASHINGTON
incorporated
S&A
ENGINEERS/PLANNERS
ARCHITECTS

A.G. SPANOS
312 UNIT - APARTMENT COMPLEX
ON-SITE SEWER & WATER PLAN
LAS VEGAS, NEVADA

JOB NO. 2-0102-008-77
DESIGNED HOLT
DRAWN GHT
COMP. HOLT
CHECKED HK
DATE FEB-1977
SHEET NO.

3
3 OF 5 SHEETS

APPROVALS:

<i>William J. Purins</i> CITY OF LAS VEGAS CITY ENGINEER	5-3-77 DATE
<i>John J. [Signature]</i> QUALITY CONTROL ENGINEER	5-2-77 DATE
<i>Robert S. [Signature]</i> CITY OF LAS VEGAS FIELD OPERATIONS ENGINEER	5-2-77 DATE
<i>R.G. [Signature]</i> SANITATION SUPERINTENDENT	4-28-77 DATE
<i>Donna [Signature]</i> CITY OF LAS VEGAS FIRE DEPARTMENT	4-27-77 DATE 2,500 GPM @ 20 PSI RESIDUAL REG. NO.