
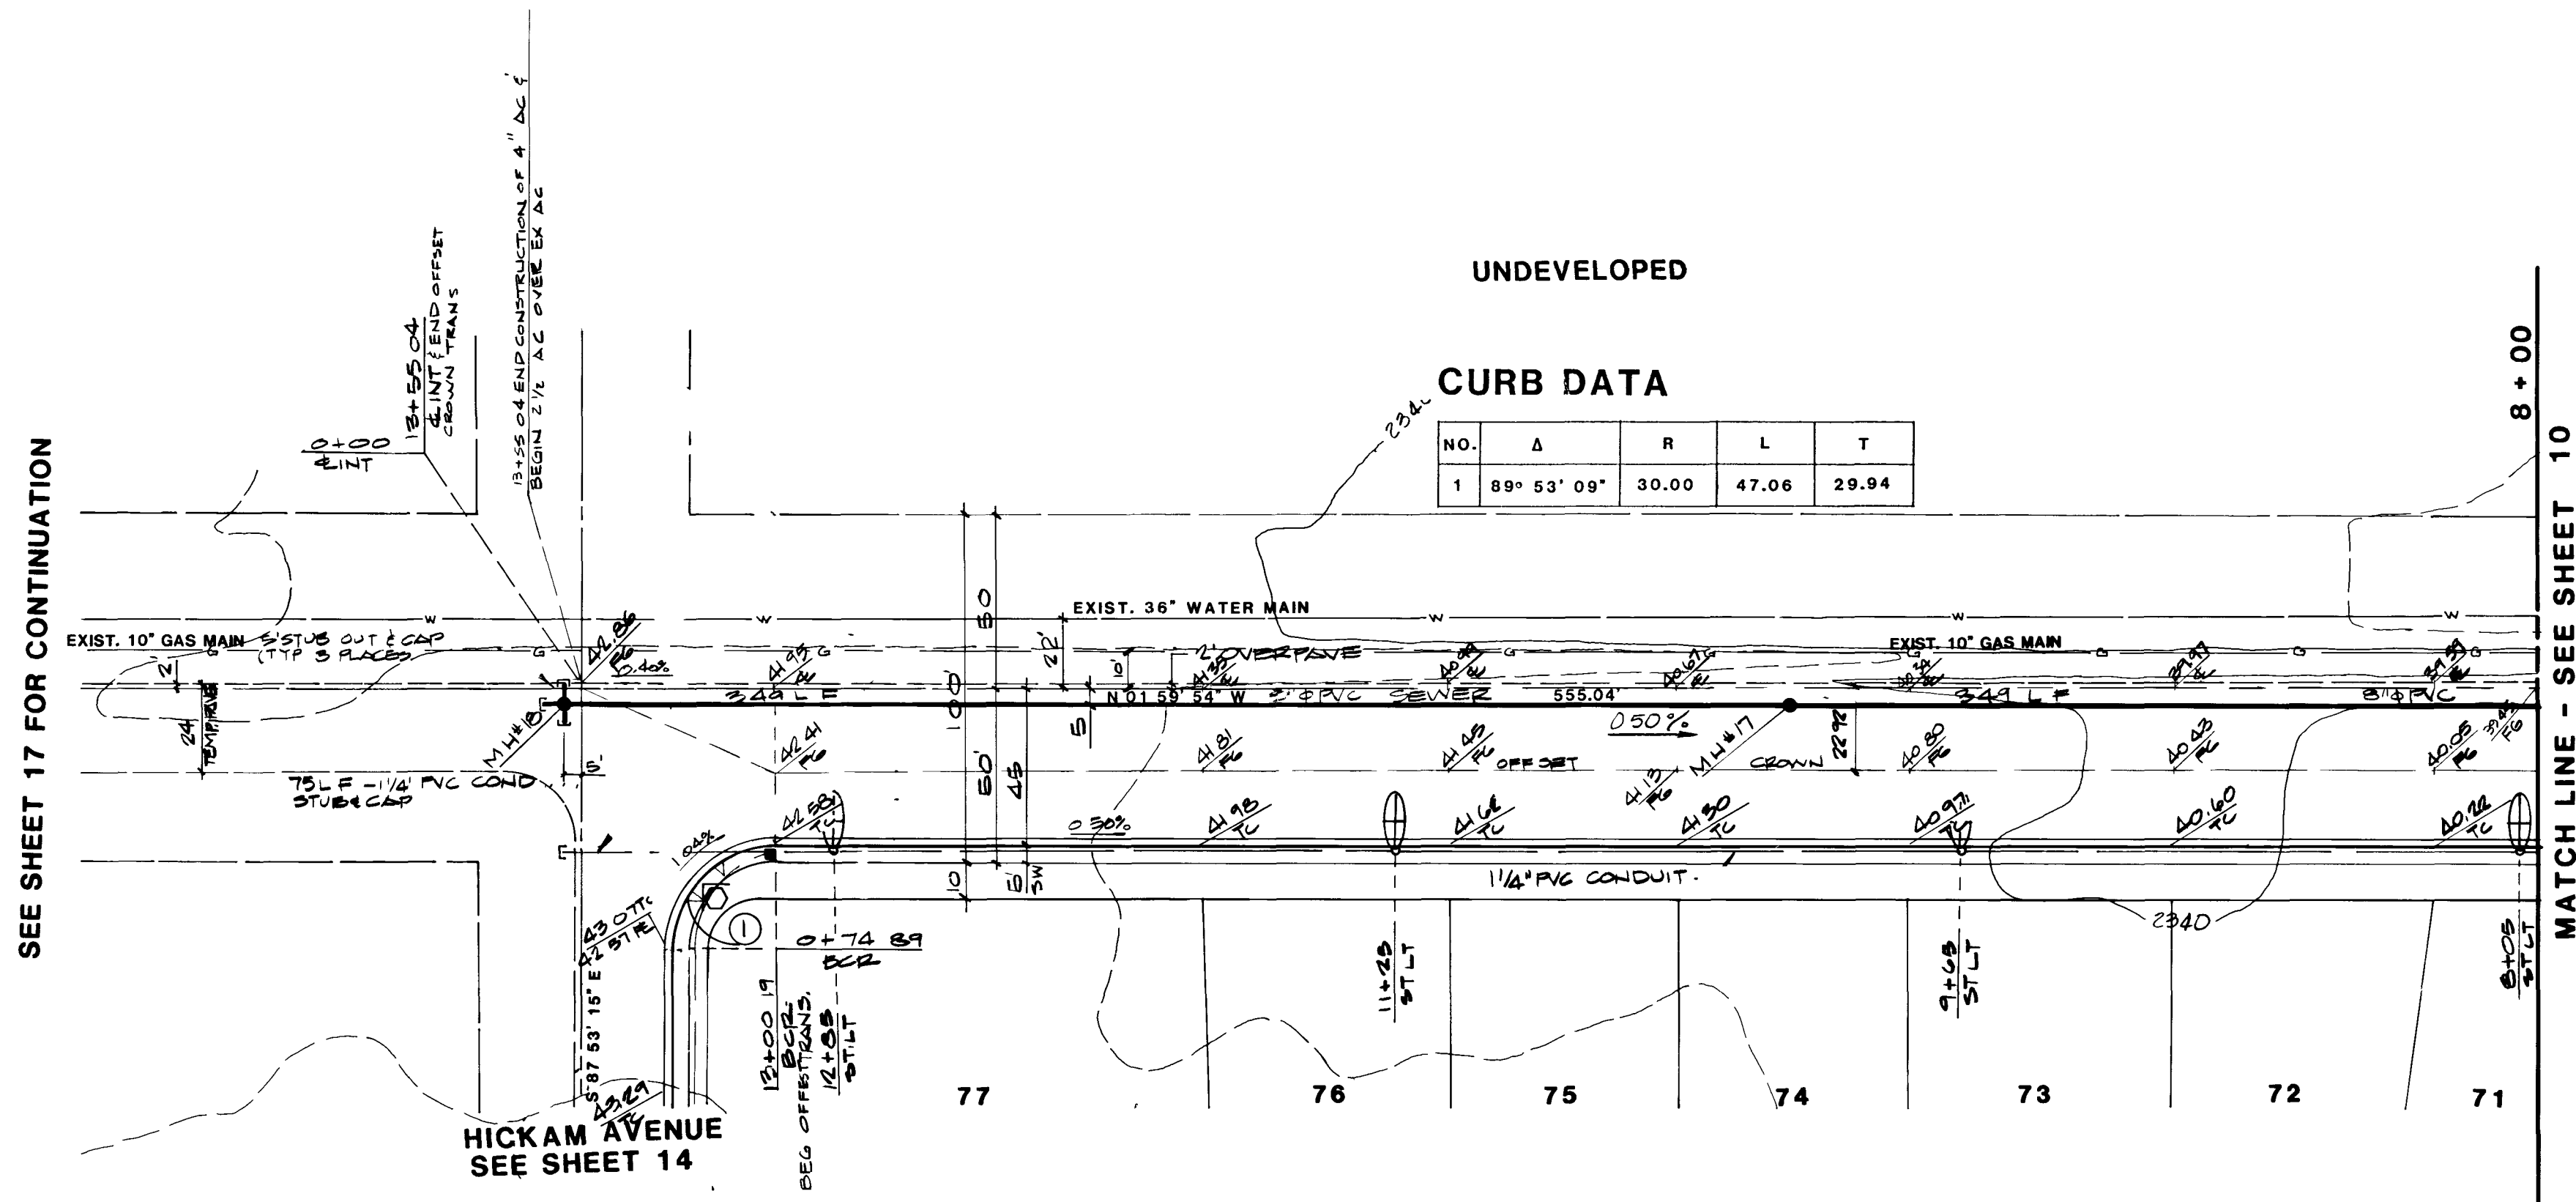


REV	DATE	BY	REVISION
1	12-2-88	G.N.	REVISED TO SHOW
2	1-4-89	PDS	REVISED TO SHOW
3	1-25-89	TB	PROFILE EXIST. WATER MAIN, C.V. CORRECTIONS
4	3-17-89	G.N.	REVISED TO SHOW

ESI ENGINEERS & SURVEYORS INC.
 702 N.W. COMMERCIAL BLVD. SUITE 1000, MIAMI, FL 33136
 SUBMITTED BY: *Paul R. ...* 12/16/88

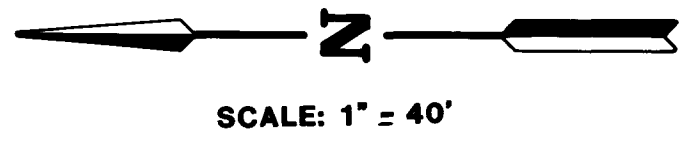

CURB DATA

NO.	Δ	R	L	T
1	89° 53' 09"	30.00	47.06	29.94

IMPROVEMENT QUANTITIES

4" ASPHALTIC CONCRETE PAVING	2780 S.Y.
25" TYPE 'L' CURB AND GUTTER	547 L.F.
5" CONCRETE SIDEWALK	2715 S.F.

THESE QUANTITIES ARE ONLY ESTIMATES, CONTRACTOR TO VERIFY

Call before you Dig.
 1-800-227-2600
UNDERGROUND SERVICE UTILITIES

STREET & SEWER PLAN & PROFILE
 (BUFFALO DRIVE FROM STA. 8+00 TO STA. 13+55.04)
 PROJECT: **DAVE BROWN WEST**

NO. 5071
 BY: PDS
 DATE: 11 / 4 / 88
 SCALE: HORIZ. 1" = 40'
 VERT. 1" = 4'

SHEET: **11**
 OF 23 SHEETS

64.2

1074-4077

