



112891

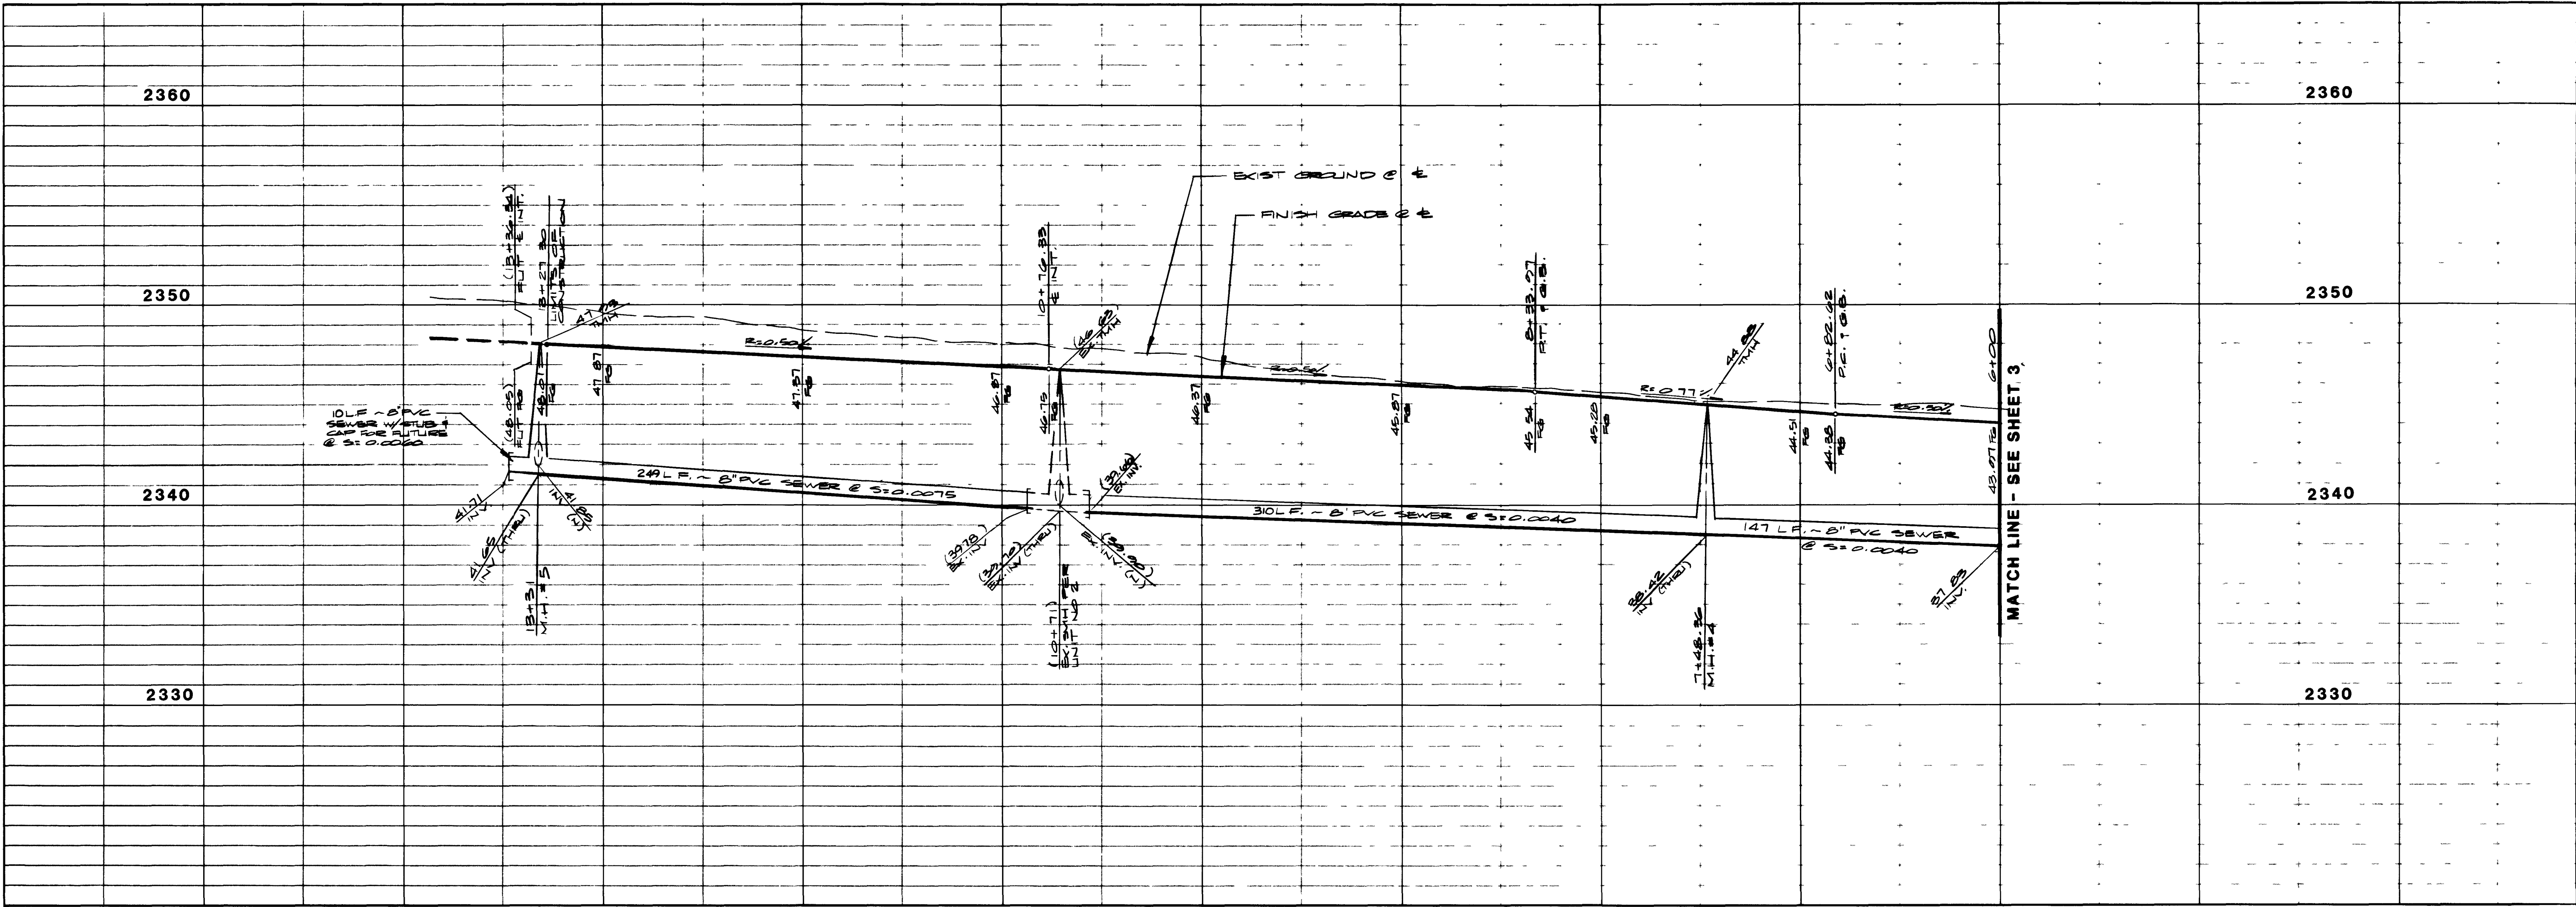

REV	DATE	BY	REVISION
1	2-15-90	CL	KEY SET CHANGE
2	6-27-90	TB	REV. SEWER & STUB LENGTHS

ESI ENGINEERS & SURVEYORS INC.
 7018 W. CHARLESTON BLVD. #200 CHARLOTTE, NC 28215
 SUBMITTED BY: *Paul E. Machine*
 DATE: 12/14/90

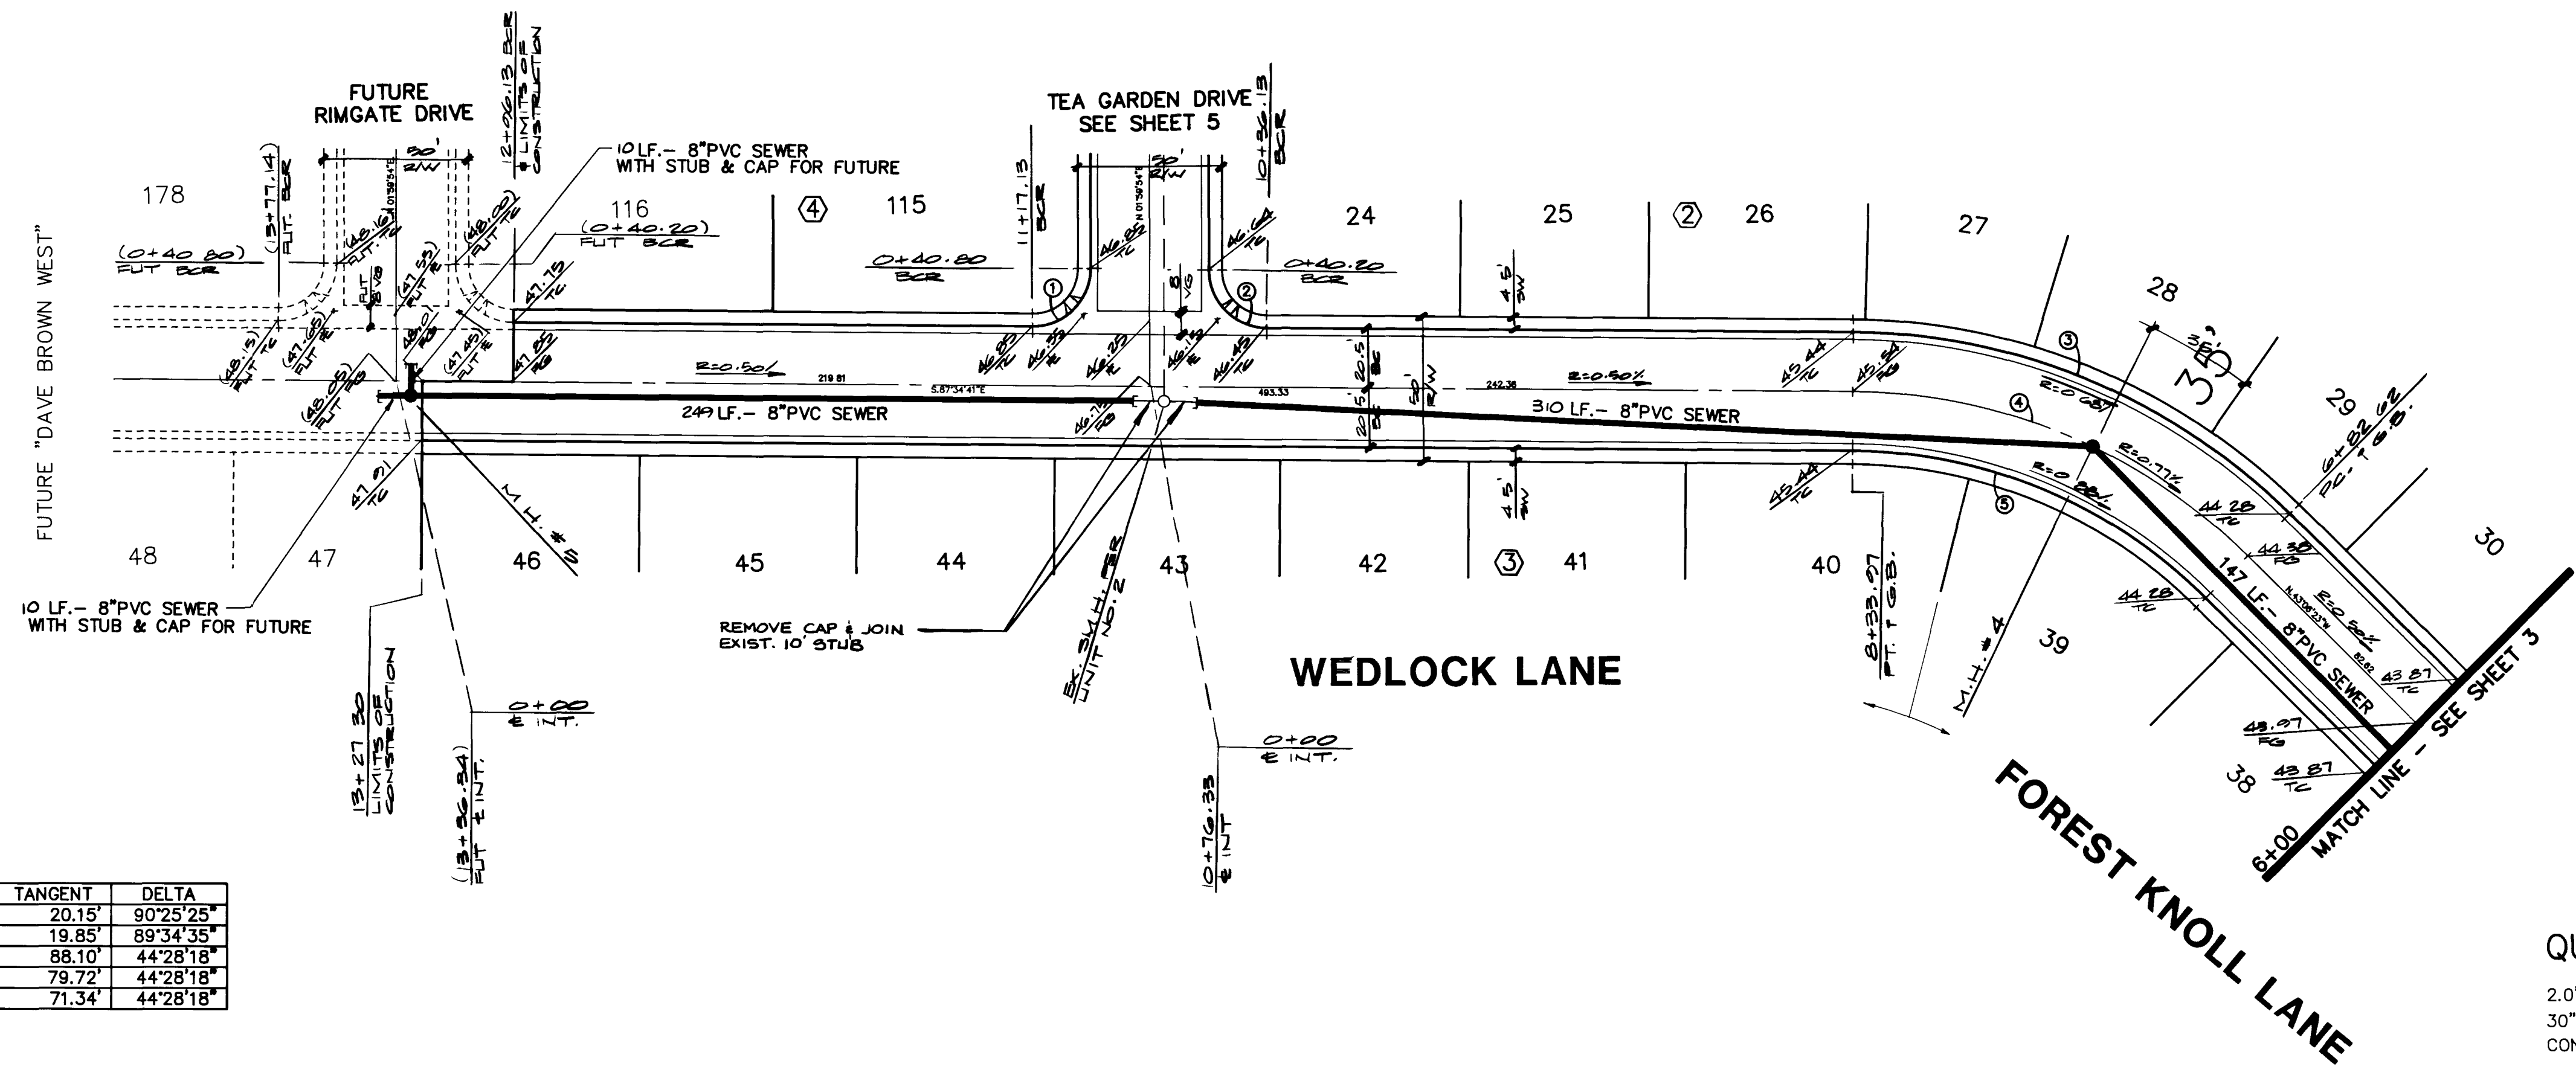

BENCHMARK
 CLARK COUNTY BENCHMARK NO. C001001 RAILROAD SPIKE ON EAST SIDE OF P.P. #62837 POWER LINE RUNS NORTH/SOUTH AND ON THE WEST SIDE OF DIRT ROAD (1106A)
 C.C. ELEVATION 2334.96'
 C.L.V. ELEVATION 2333.92'



1-800-227-2600
 UNDERGROUND SERVICE JAPAN

CURVE DATA TABLE

CURVE	RADIUS	LENGTH	TANGENT	DELTA
1	20.00'	31.56'	20.15'	90°25'25"
2	20.00'	31.27'	19.85'	89°34'35"
3	215.50'	167.27'	88.10'	44°28'18"
4	195.00'	151.35'	79.72'	44°28'18"
5	174.50'	135.44'	71.34'	44°28'18"

QUANTITY ESTIMATE
 2.0" ASPHALTIC CONCRETE PAVING ----- 2,847 S.Y.
 30" ROLL" TYPE CURB & GUTTER ----- 1,342 L.F.
 CONCRETE SIDEWALK ----- 6,041 S.F.

TITLE
 STREET & SEWER PLAN & PROFILE
 (WEDLOCK LANE - STA.6+00 TO STA.13+27.31)


PROJECT
 DAVE BROWN WEST UNIT NO.3

WO NO	5262
BY	P. CHAO
DATE	12/88
SCALE	HORIZ. 1" = 40' VERT. 1" = 4'

SHEET
 4
 OF 8 SHEETS


6445

107Y-4077-3 u

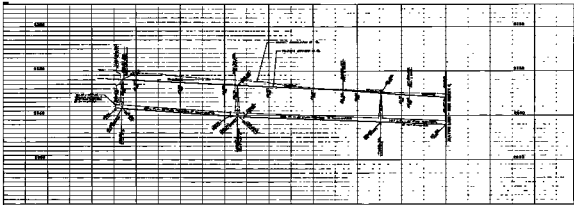

1. DATE: 10/15/2014
 2. DRAWN BY: [Signature]
 3. CHECKED BY: [Signature]
 4. PROJECT NO.: [Blank]
 5. SHEET NO.: [Blank] OF [Blank]

DESIGN
 ENGINEERING & ARCHITECTURE, INC.
 1000 W. 10th Street, Suite 100
 Lincoln, NE 68502
 Phone: (402) 441-1111
 Fax: (402) 441-1112
 Website: www.designinc.com

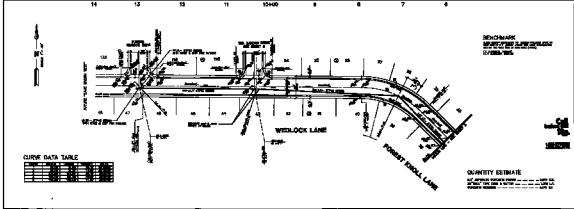

CURVE DATA TABLE

Station	PC	PT	PI	Curve Length	Curve Type
13+00	13+00	13+00	13+00	0	0
12+00	12+00	12+00	12+00	0	0
11+00	11+00	11+00	11+00	0	0
10+00	10+00	10+00	10+00	0	0
9+00	9+00	9+00	9+00	0	0
8+00	8+00	8+00	8+00	0	0
7+00	7+00	7+00	7+00	0	0
6+00	6+00	6+00	6+00	0	0
5+00	5+00	5+00	5+00	0	0
4+00	4+00	4+00	4+00	0	0
3+00	3+00	3+00	3+00	0	0
2+00	2+00	2+00	2+00	0	0
1+00	1+00	1+00	1+00	0	0
0+00	0+00	0+00	0+00	0	0

BENCHMARK
 10+00 1018.50
 10+00 1018.50
 10+00 1018.50

QUANTITY ESTIMATE
 10' Diameter Sewer Pipe --- 1000 LF
 10' Diameter Sewer Manhole --- 10 LF
 10' Diameter Sewer Valve --- 10 LF

1. STREET & SEWER PLAN & PROFILE
 (BENCH MARK - RELATED TO STATION 10+00)
 2. DAVE BROWN WEST UNIT NO. 3

10/15/2014
 10/15/2014
 10/15/2014
 10/15/2014

4