


AS-BUILT SEWER PLAN
 Dimensions given here have been
 provided by the contractor. Startec
 Engineering assumes not responsibility
 for their accuracy or completeness


Dated: 5/02/02

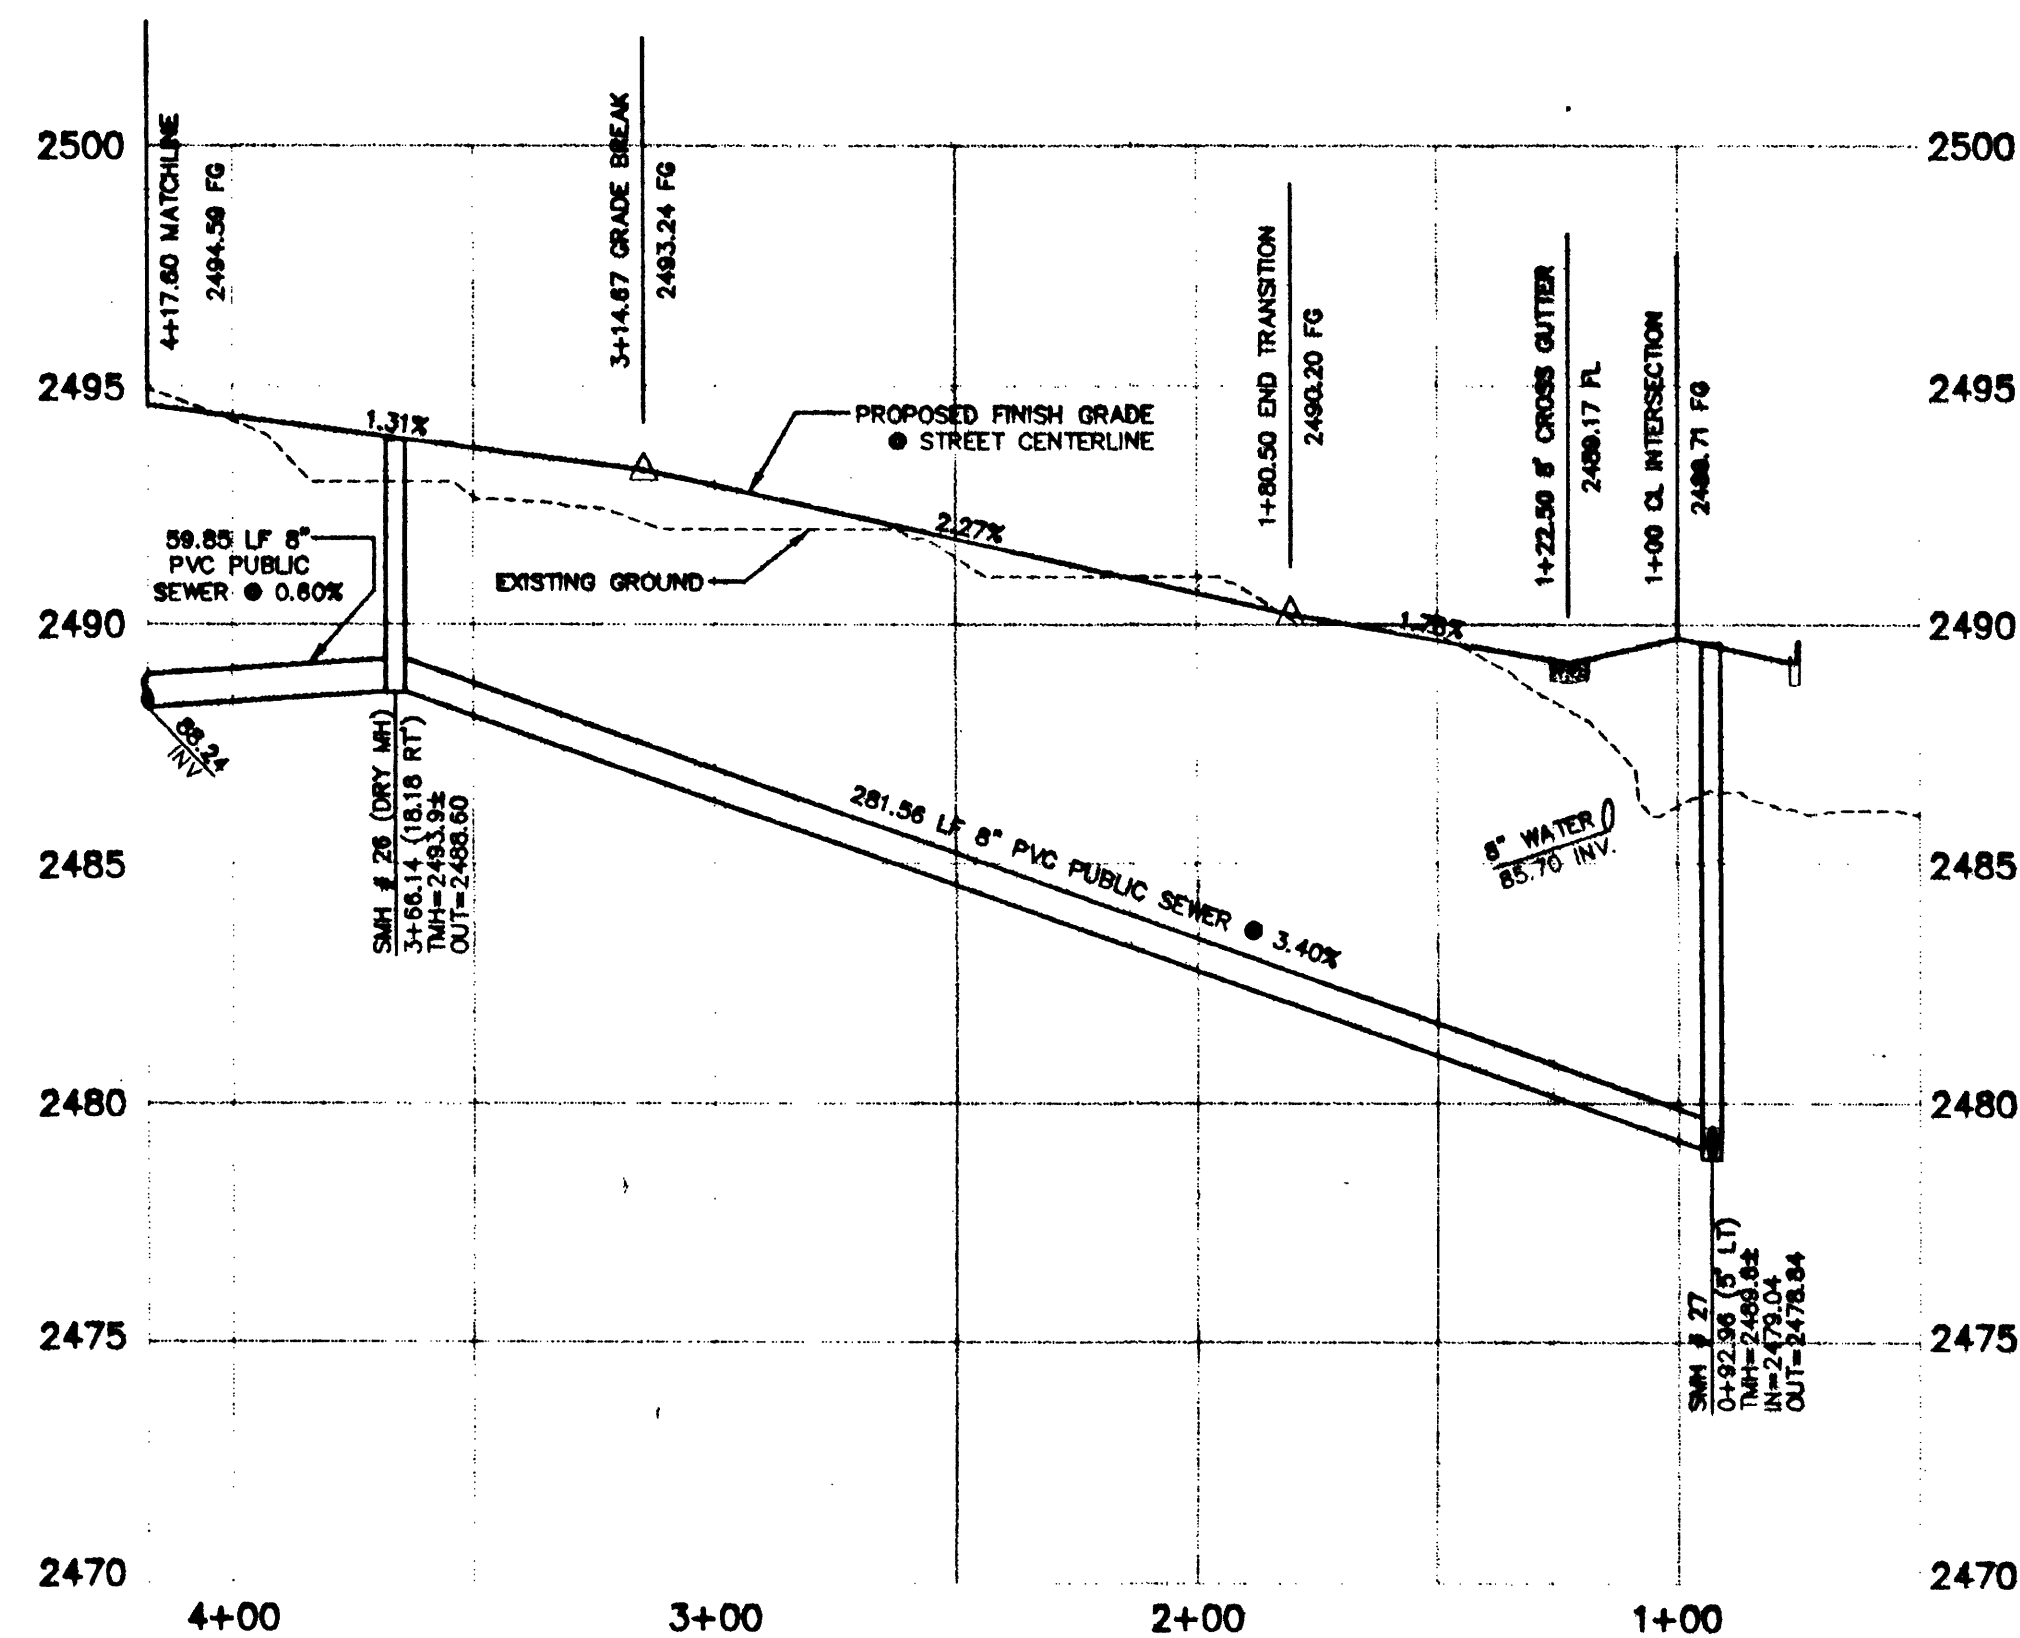


LANCELEAF AVENUE (PUBLIC)

PROFILE

SCALE: HORIZ. 1" = 40'
 VERT. 1" = 4'

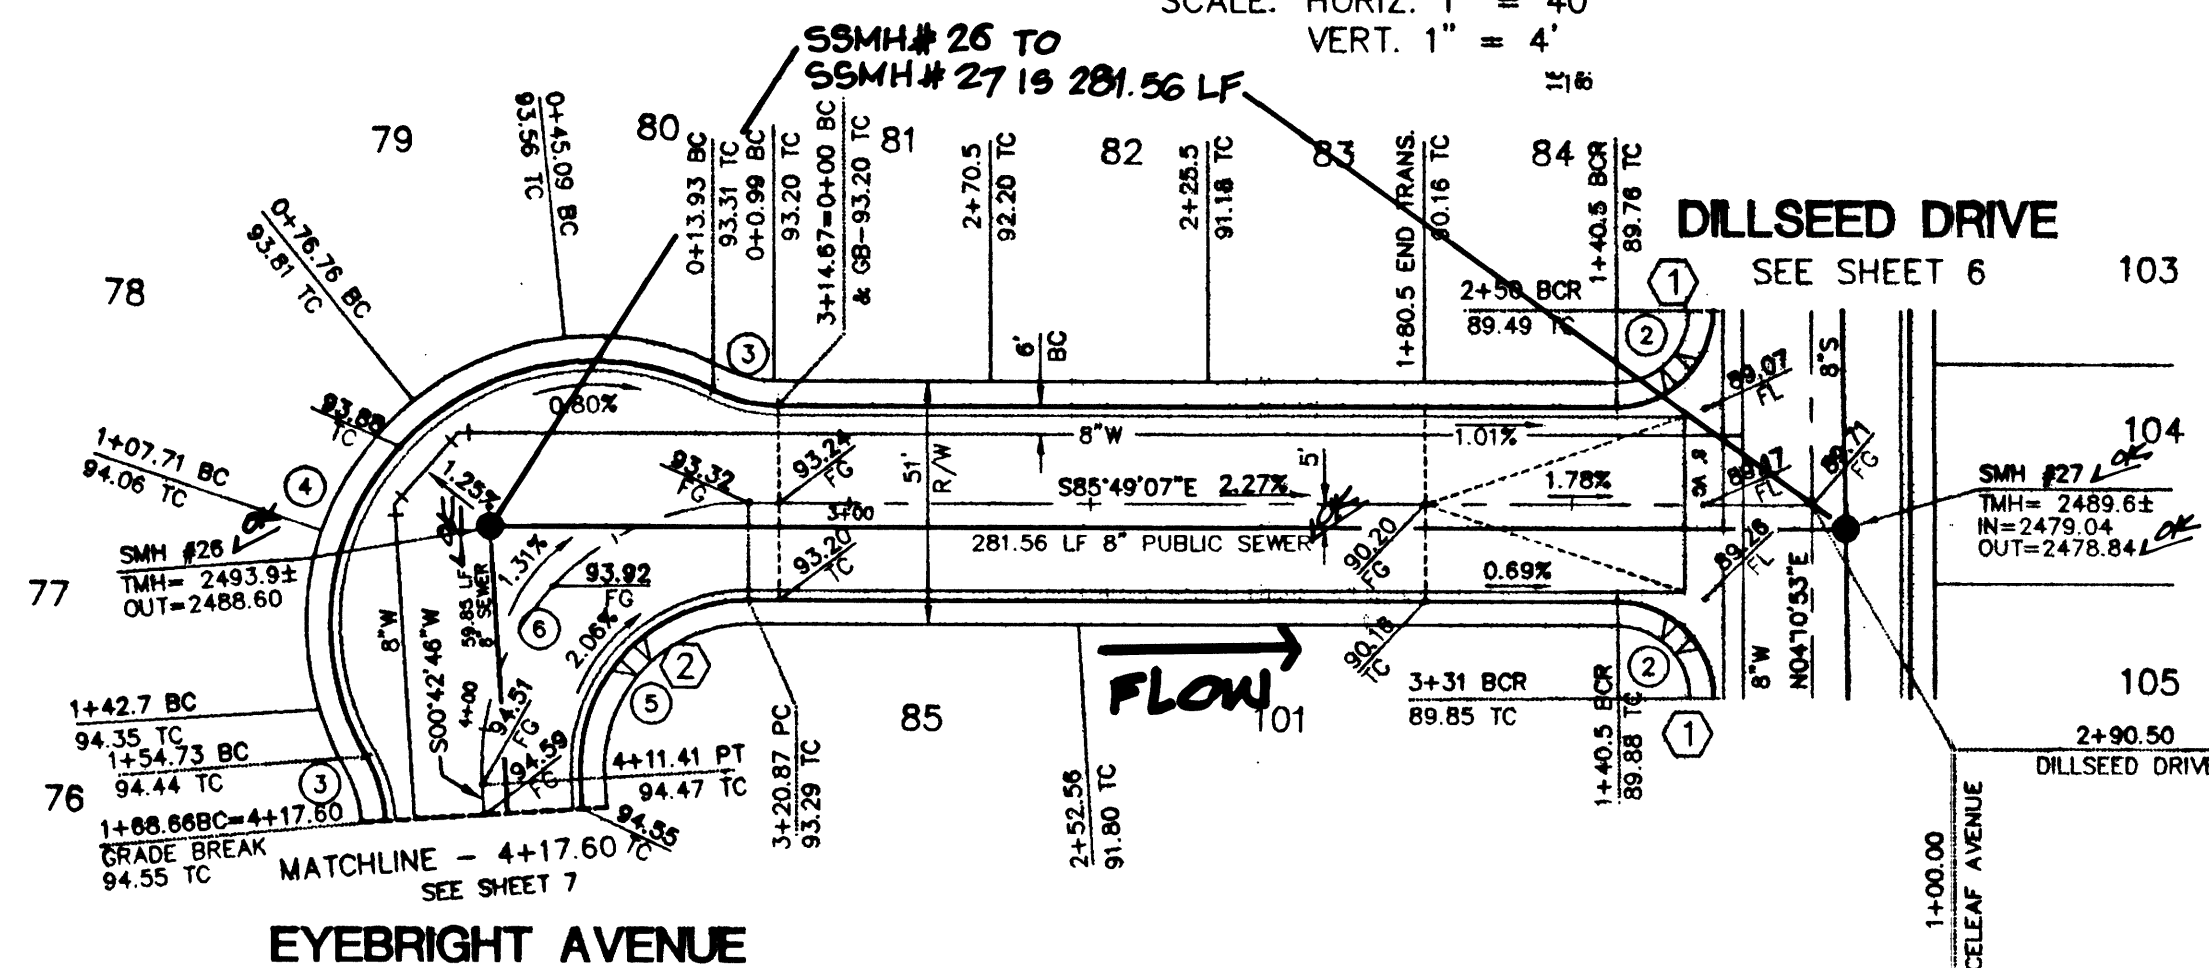

LANCELEAF AVENUE (PUBLIC)

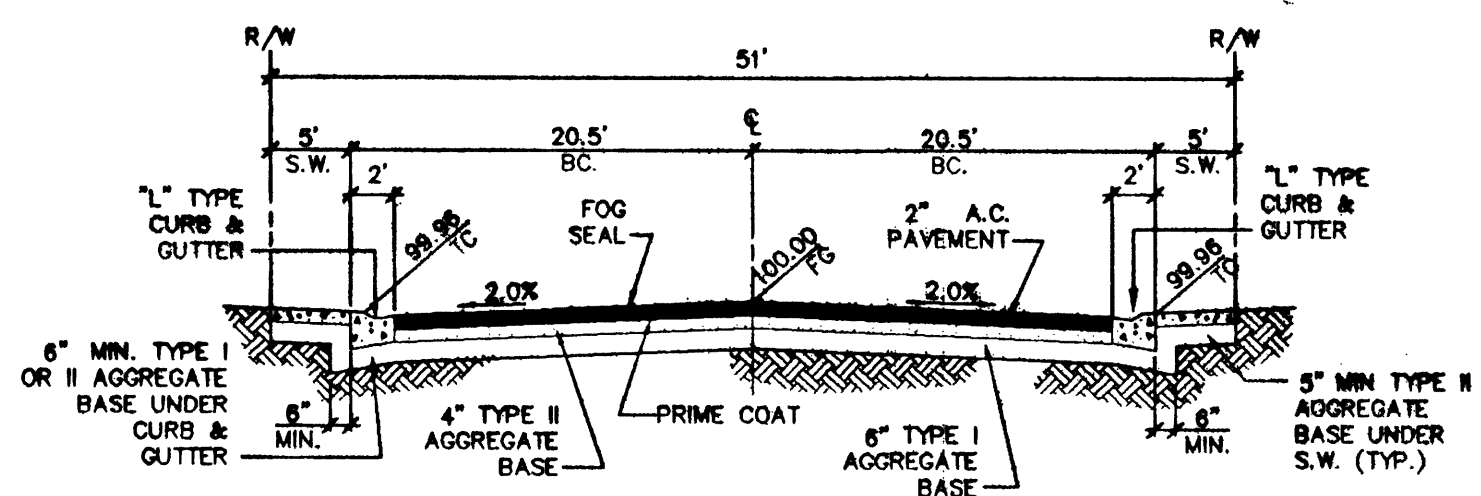

TYPICAL STREET SECTION

NO SCALE
 U.S.D. STD. DWG. NO. 207

SIDEWALK RAMP TRANSITION TABLE

RAMP NO.	GRADE (%)	"A" (FT) MIN.	"B" (FT) MIN.
(1)	-2 TO 2	8.0	8.0
(2)	-3 TO -2.01	4.5	9.5


U.S.D. STD DWG 235
 CASE 1

BACK OF CURB CURVE DATA

CURVE	DELTA	RADIUS	LENGTH	TANGENT
1	90°00'00"	30.00'	47.12'	30.00'
2	90°00'00"	20.00'	31.42'	20.00'
3	26°36'17"	30.00'	13.93'	7.09'
4	146°40'41"	55.00'	140.80'	183.78'
5	93°28'08"	35.00'	57.10'	37.19'

CENTERLINE CURVE DATA

CURVE	DELTA	RADIUS	LENGTH	TANGENT
6	93°28'08"	55.50'	90.54'	58.97'

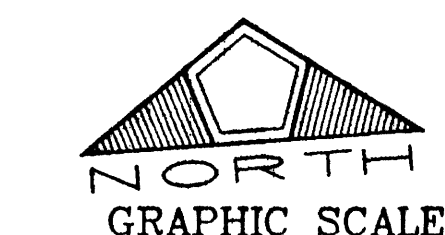


(IN FEET)
 1 inch = 40 ft.

ELKHORN ROAD (PUBLIC)


PROFILE

SCALE: HORIZ. 1" = 40'
 VERT. 1" = 4'

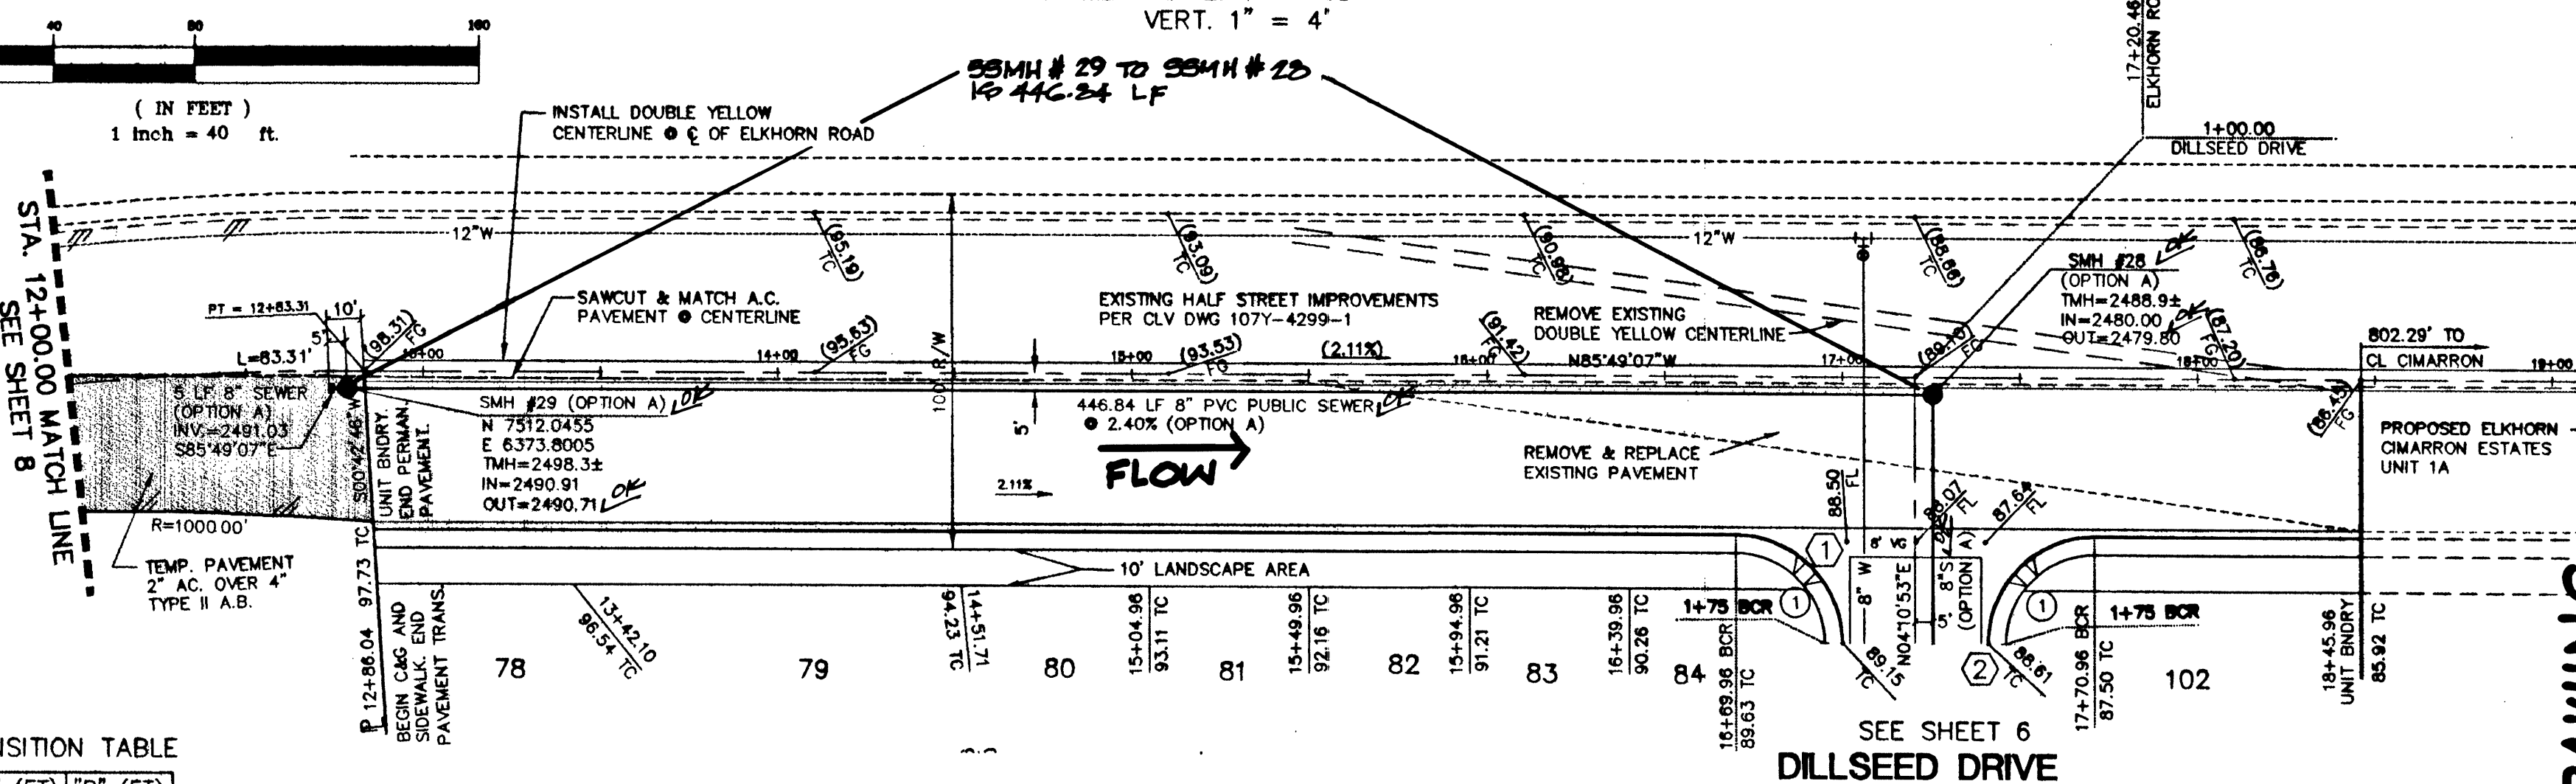

ELKHORN ROAD (PUBLIC)

SEWER
 * 48\"/>

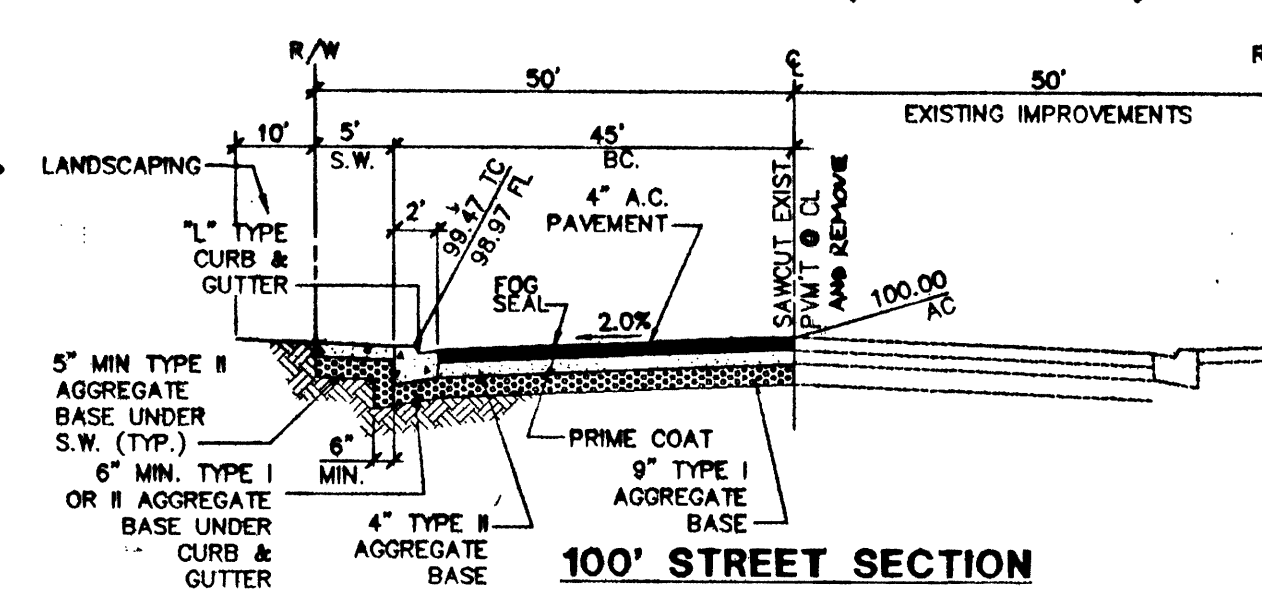

100' STREET SECTION

NO SCALE
 U.S.D. STD. DWG 203

BENCHMARK
 ELEV. BM # 1 LV90 21 N6 1
 3\"/>

"AS-BUILT" DRAWING

EXECUTIVE DEVELOPMENT CORPORATION

ELKHORN - CIMARRON ESTATES UNIT 2A

STREET PLAN - PROFILE

ELKHORN ROAD & LANCELEAF AVENUE


SHEET

5

OF 12

As-Built

107Y-4498-2A

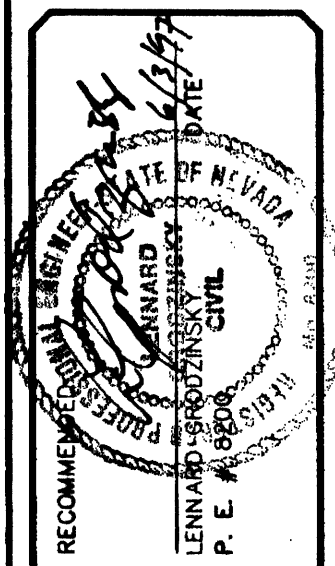

DATE: 4/17/97
 DRAWN BY:
 DESIGNED BY:
 CHECKED BY: 0141.0006
 JOB NO.:
 SCALE: 1"=40'

PENTACORE
 CIVIL ENGINEERING • LAND SURVEYING • PLANNING
 CONSTRUCTION MANAGEMENT • ADA CONSULTING
 6763 WEST CHARLESTON BOULEVARD
 LAS VEGAS, NEVADA 89102 (702)258-0115

NO.	DESCRIPTION	DATE	APP'D.