
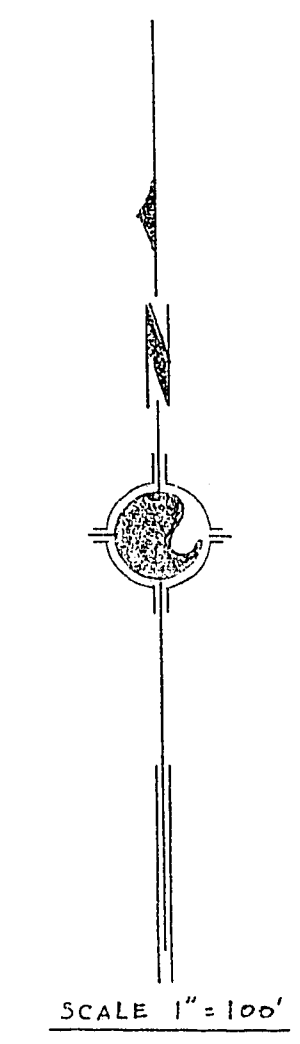


10-7-87

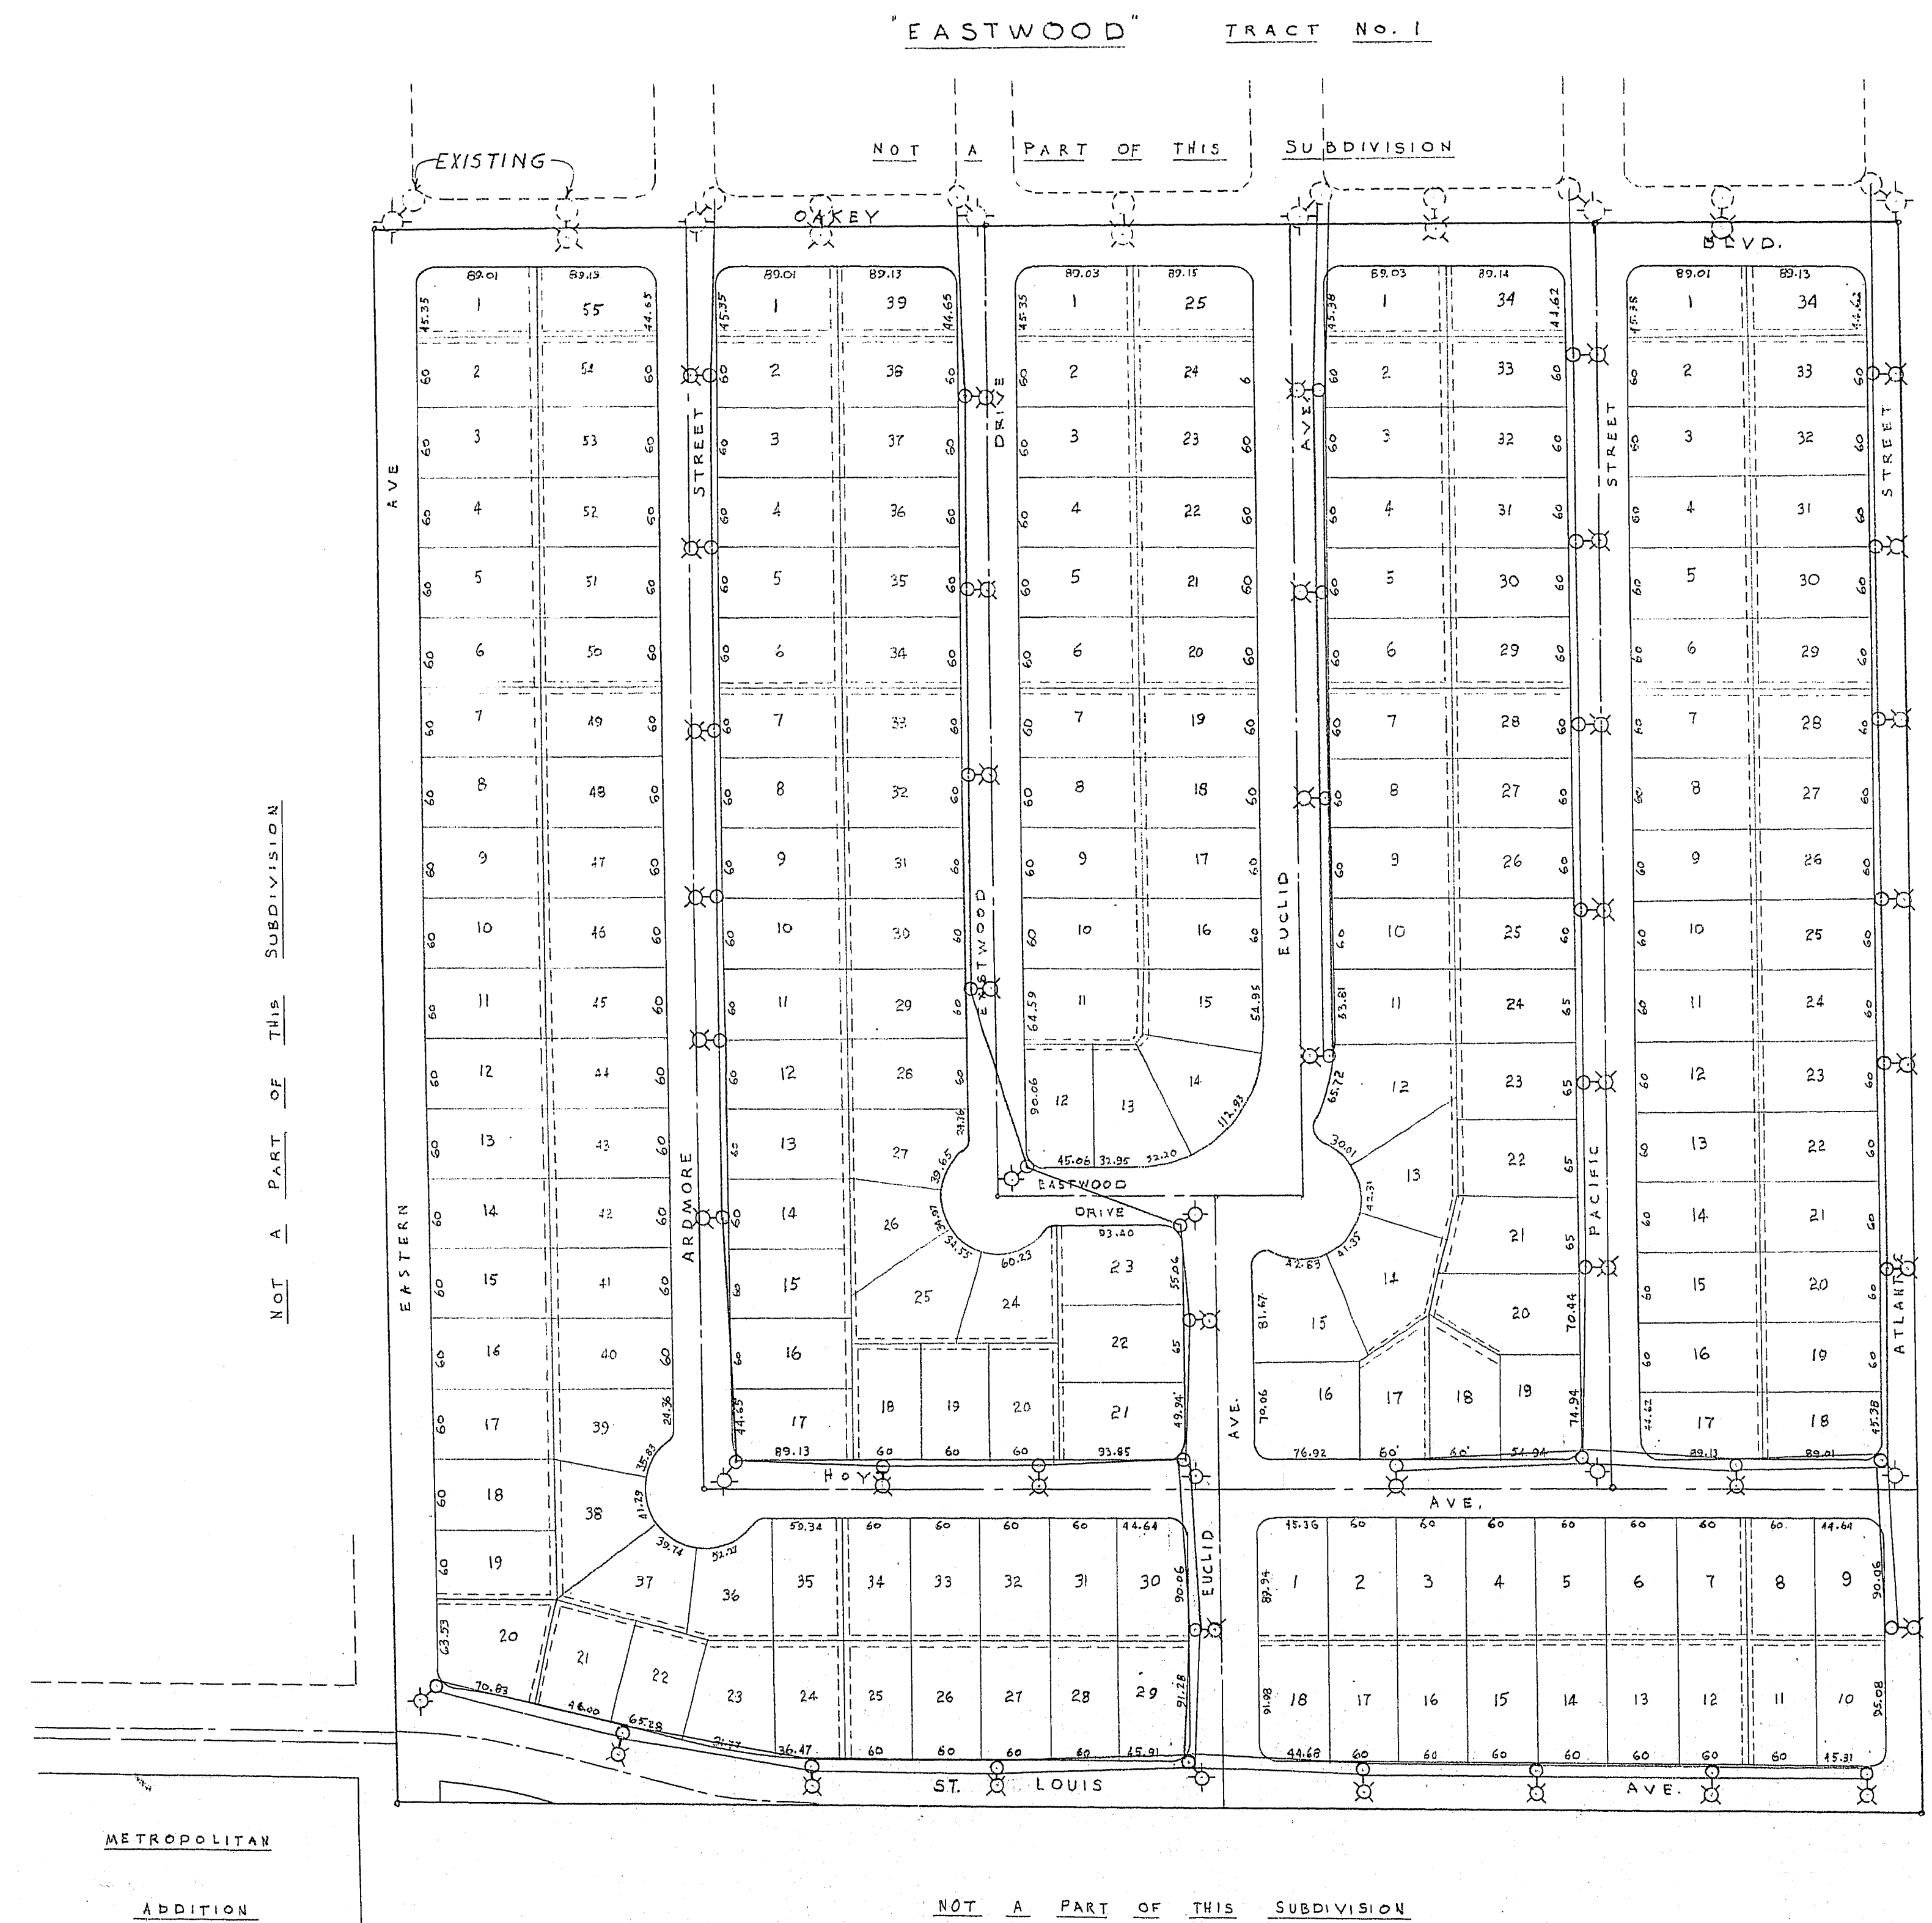

LEGEND
○---○ STREET LIGHTING STANDARD 18
subdivision 10350

AS BUILT

C-4-39

CITY OF LAS VEGAS NEVADA ENGINEERING DEPT.	
STREET LIGHTING IN EASTWOOD TRACT NO. 2	
DESIGNED BY	DATE
DRAWN BY	SCALE: 1" = 100'
CHECKED BY	FIELD BOOK NO.
APPROVED	WORK ORDER NO.
CITY ENGR.	DRAWING NO.
	207Y-7280-2

REVISIONS		
NO.	BY	DESCRIPTION
1	AS BUILT	11-3-87