



EXISTING UTILITIES ARE LOCATED ON PLANS FOR THE CONVICTION OF THE CONTRACTOR. THE ENGINEER BEARS NO RESPONSIBILITY FOR THE LOCATION OF UTILITIES SHOWN OR NOT SHOWN ON THE PLANS. THE CONTRACTOR SHALL VERIFY THE LOCATION OF ALL UTILITIES WITH THE UTILITY COMPANIES. SPECIFICATION AND IT SHALL BE THE RESPONSIBILITY OF THE CONTRACTOR TO LOCATE ALL UTILITIES BEFORE STARTING CONSTRUCTION.

Call before you Dig.
1 800 227 2800

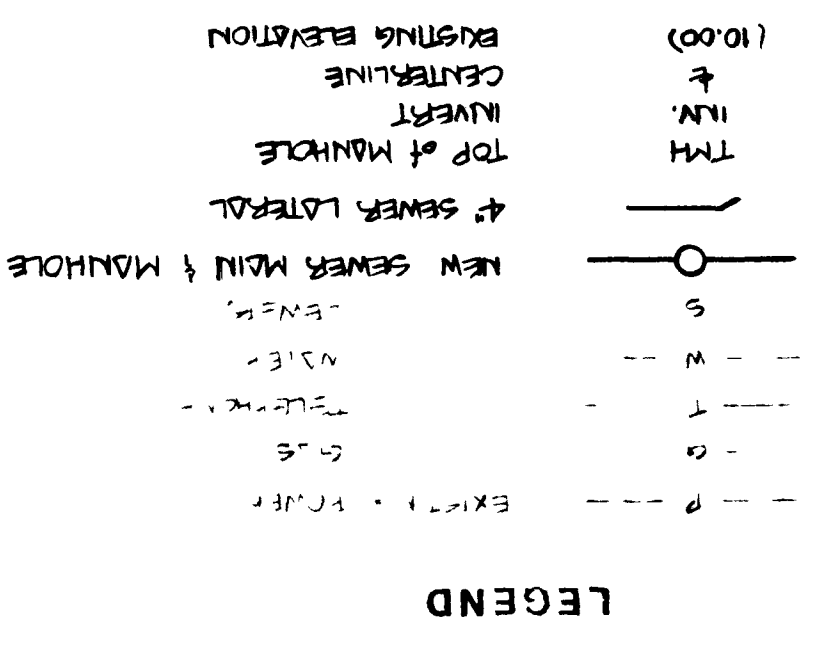

Project Location

Vicinity Map

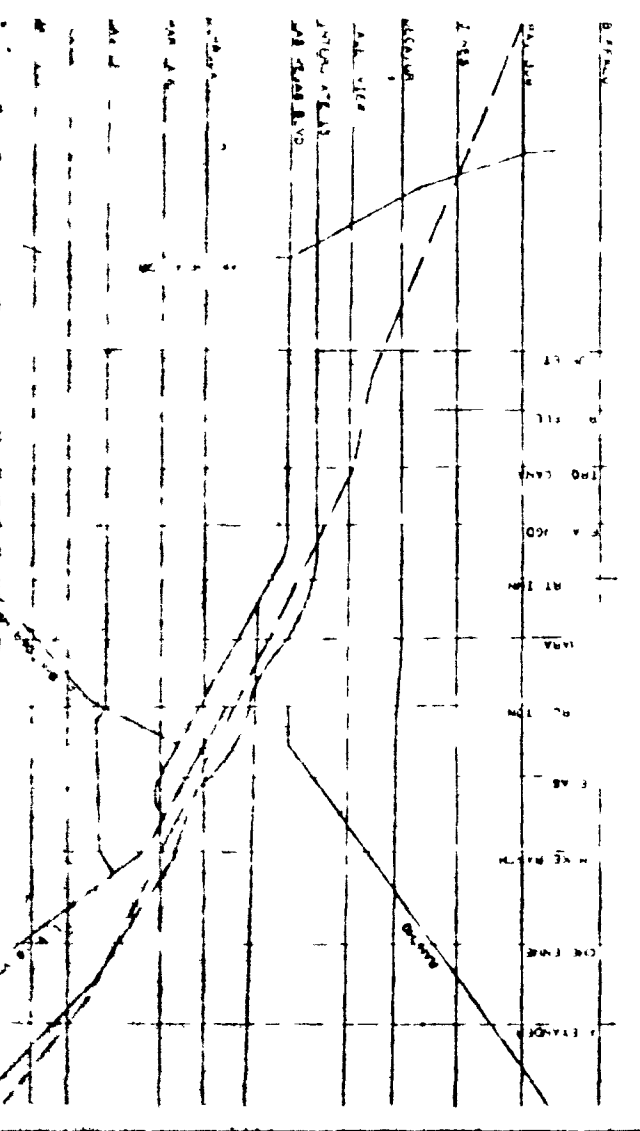

MASTER SEWER PLAN
PHASE 1
EDGEWATER

- C L V NOTES
1. ALL EXISTING SEWER INSTALLATIONS SHALL CONFORM TO THE STANDARD DETAILS AND SPECIFICATIONS OF THE CITY OF LAS VEGAS, AND SHALL ALSO CONFORM TO THE UNIFORM STANDARD SPECIFICATIONS FOR PUBLIC WORKS CONSTRUCTION OF 1995 WITH THE LATEST REVISIONS.
 2. EXISTING 12" OR 15" DIA. CHASES UNDER ROADS OR GAS LATERALS PASS UNDER THE CHASE.
 3. EXISTING 12" OR 15" DIA. CHASES UNDER ROADS OR GAS LATERALS PASS UNDER THE CHASE.
 4. ALL MANHOLES IN EXISTING STREETS OR 15" DIA. LATERALS SHALL HAVE CONCRETE COLLARS, CEMENT, AND INSTALLATION WITH SAND BEDDING AND BACKFILL ON TYPE II GRAVEL.
 5. THE LATERALS SHALL BE USED TO CONNECT EXISTING LATERALS TO EXISTING MAIN LINES.
 6. SPECIAL PROVISIONS:

* SEWER DIMENSIONS AS-BUILT 12/7/11
(NOT TO SCALE)

SEWER ESTIMATE

- 8" SINKHOLE
4" SINKHOLE
2400 L.F.
2400 L.F.

13
SHEET
3074-4000-1

DATE: 1/1/88
BY: M. JONES
PROJECT: 871002

