


SEWER AS-BUILT MAP

ELKHORN\ CIMARRON ESTATES UNIT 4-B

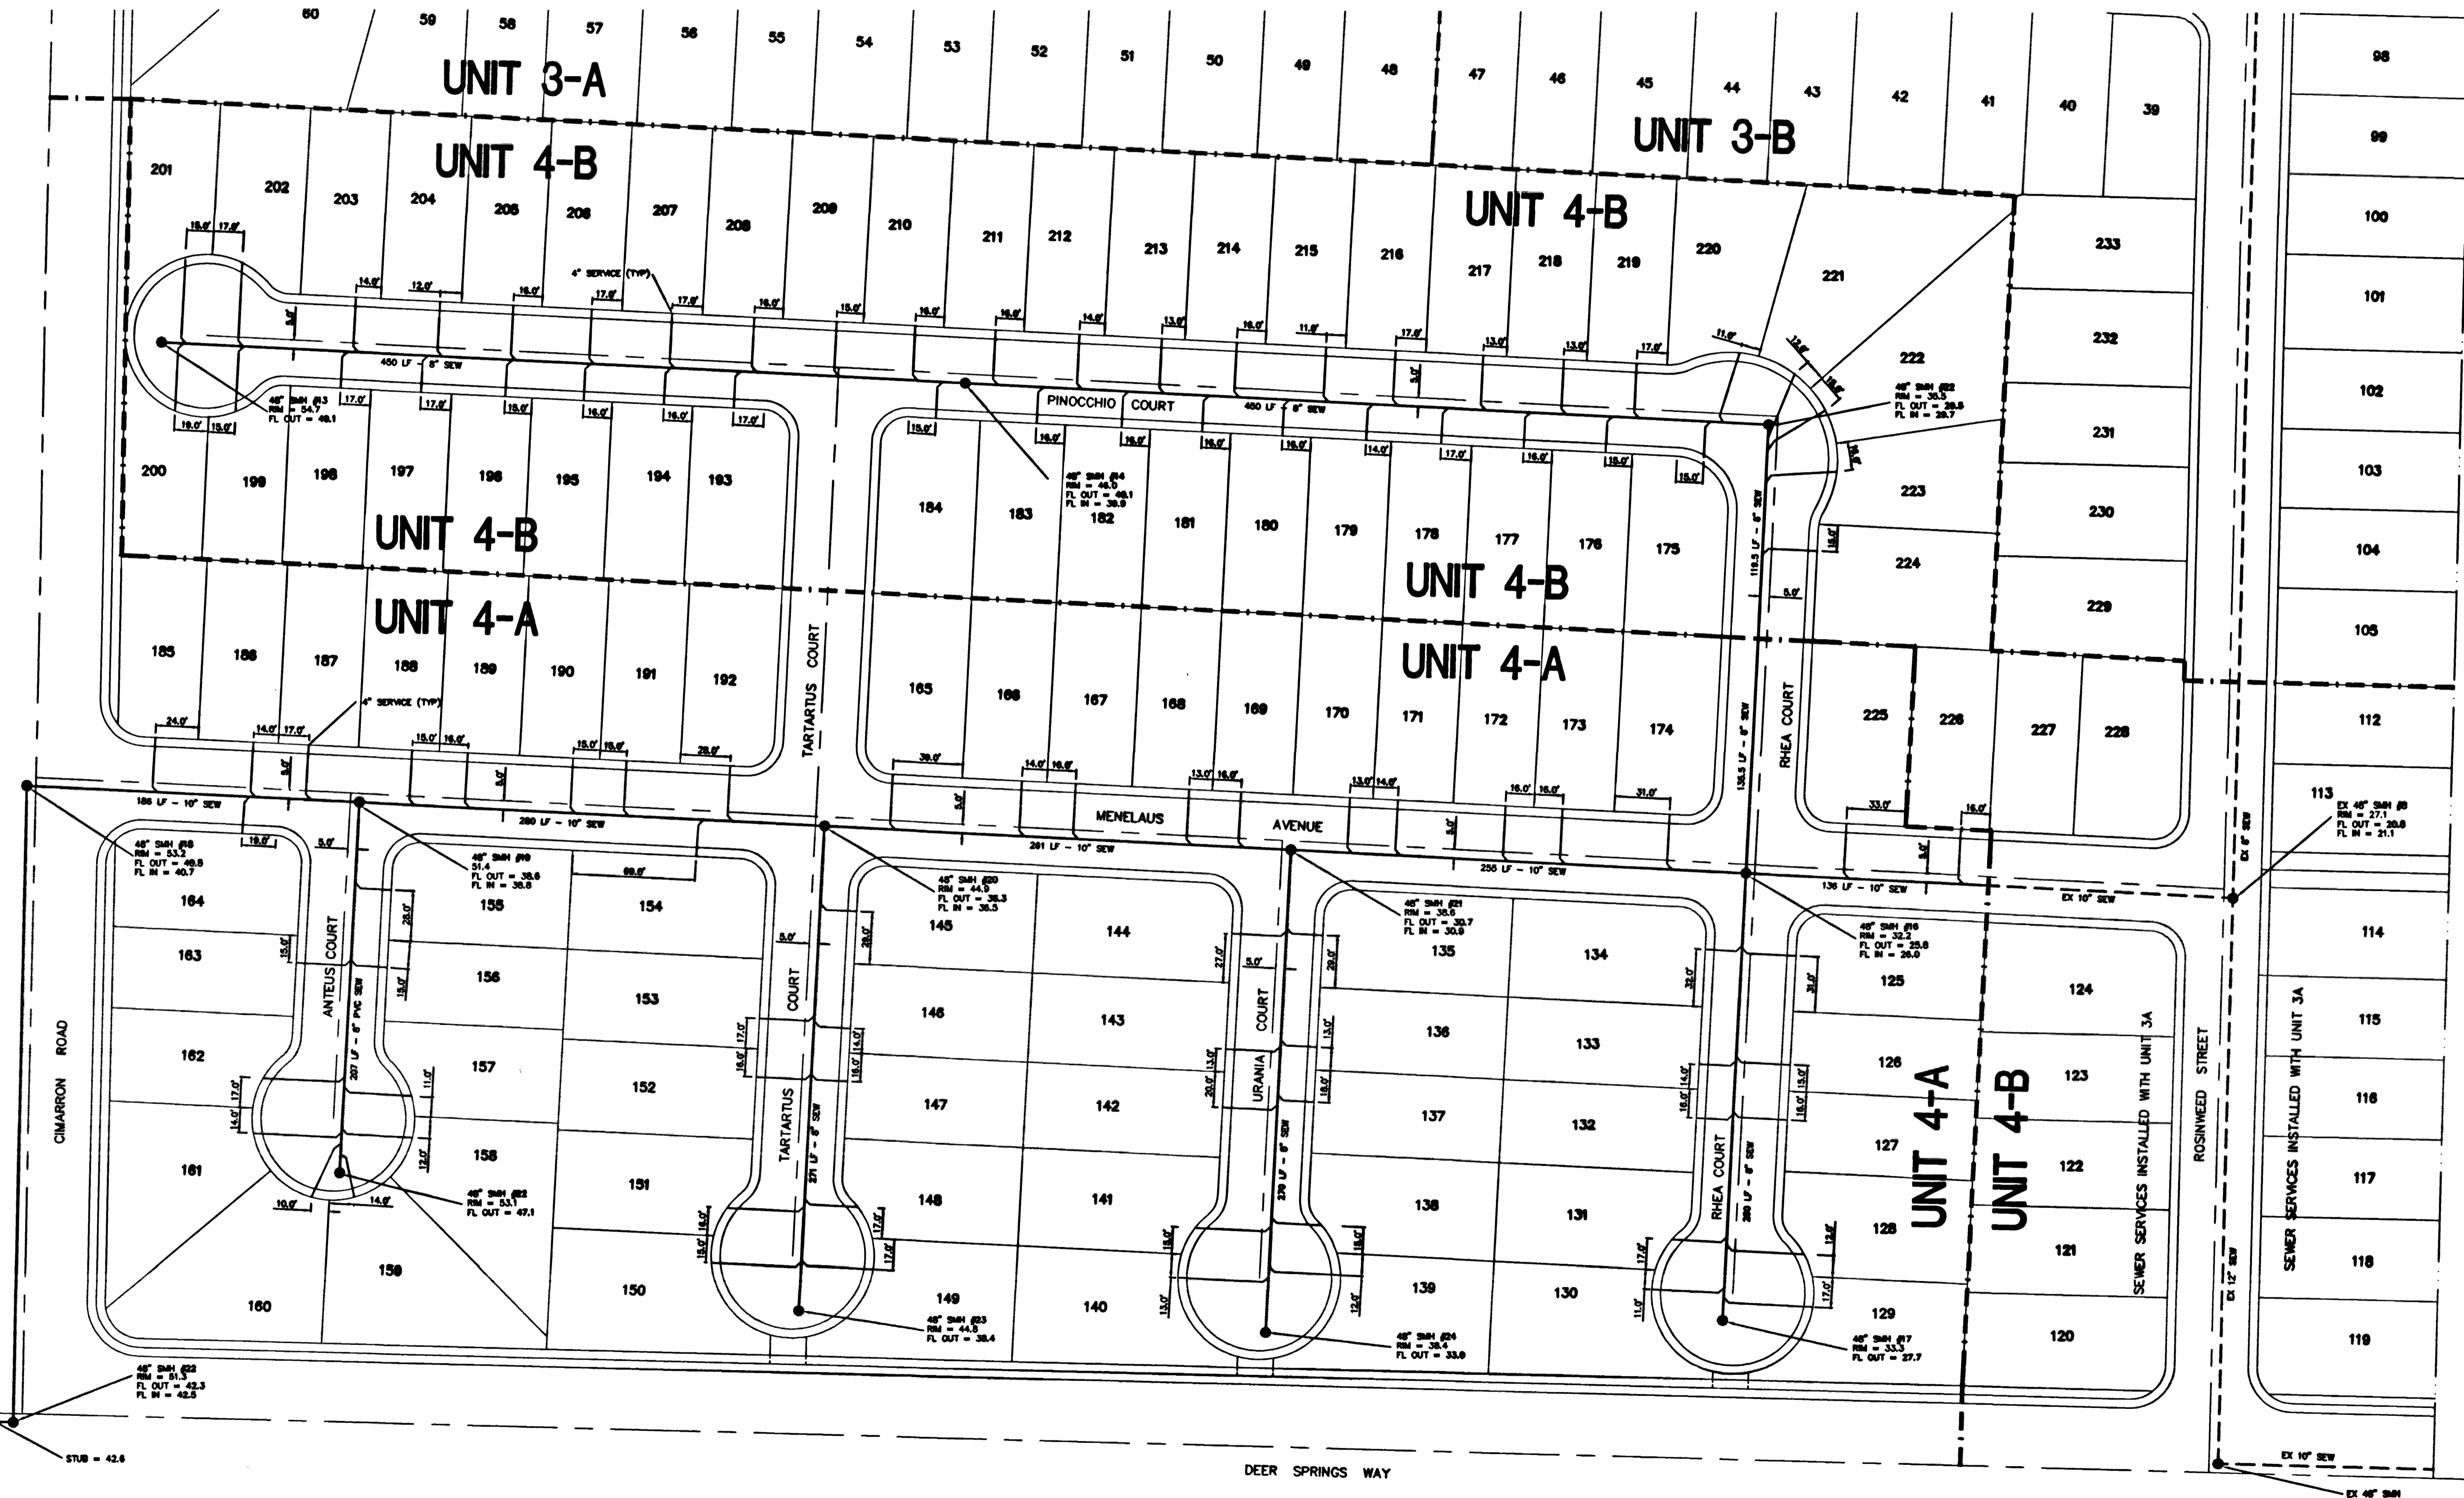


WILLIAM LYON HOMES
 500 PILOT RD. SITE C
 LAS VEGAS, NV
 263-8200

ALPHA &
 ENGINEERING COMPANY
 50 So. Jones #202, Las Vegas, NV, 89107
 Telephone: (702) 877-1300

ELKHORN\CIMARRON ESTATES UNIT 4-B

SEWER AS-BUILT MAP

SHEET 9.1.00
 DRAWN BY: _____
 DESIGNED BY: _____
 CHECKED BY: _____
 PROJECT NO: 712905
 SCALE: 1" = 50'

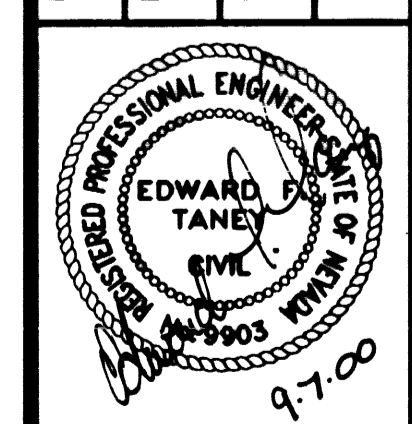

NOTE:
 1) SEWER SERVICE LOCATIONS AS SHOWN ON THIS MAP WERE PROVIDED BY THE CONTRACTOR. ALPHA ENGINEERING ASSUMES NO LIABILITY FOR MISPLACED SERVICES REPRESENTED ON THIS MAP.

2) ALL SEWER MAIN MATERIALS SDR - 35.

SHEET 01
 OF 01 SHEETS
 DRAWING NO. 307Y-4498-4B

FILE NAME: 25856

REV DATE BY