




**SITE 2 - MEISENHEIMER AVE. - PLAN**  
SCALE: 1" = 30'

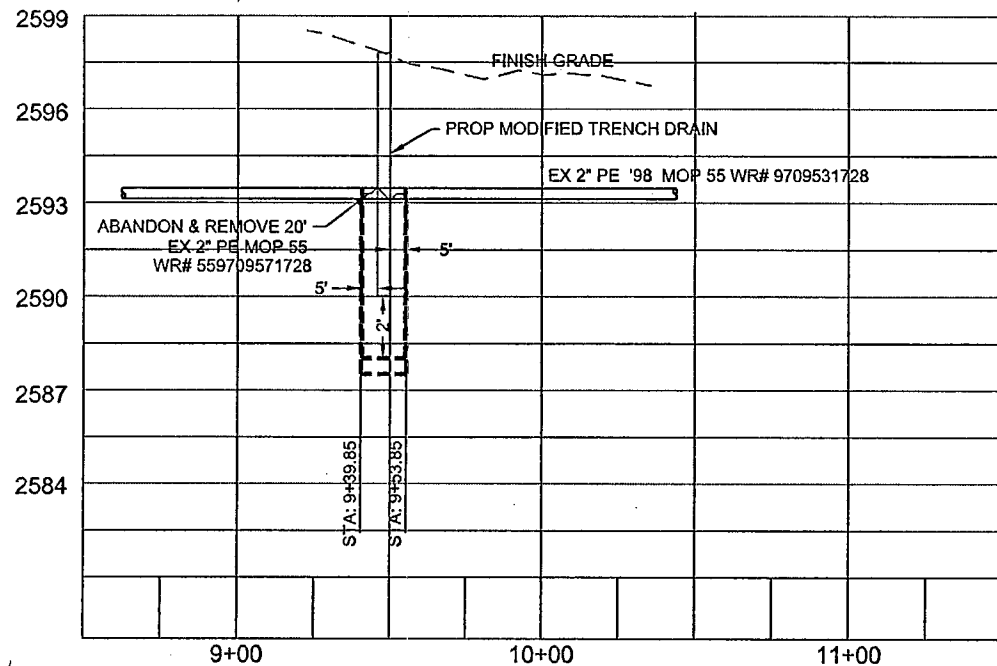


**SITE 2 DETAIL - MEISENHEIMER AVE - PROFILE**  
HORIZ: 1" = 30'  
VERT: 1" = 3'

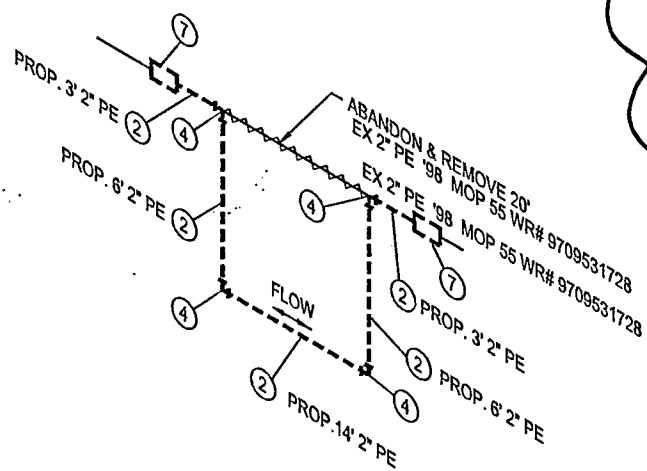

**SITE 2 - MEISENHEIMER AVE - DETAIL**  
N.T.S.

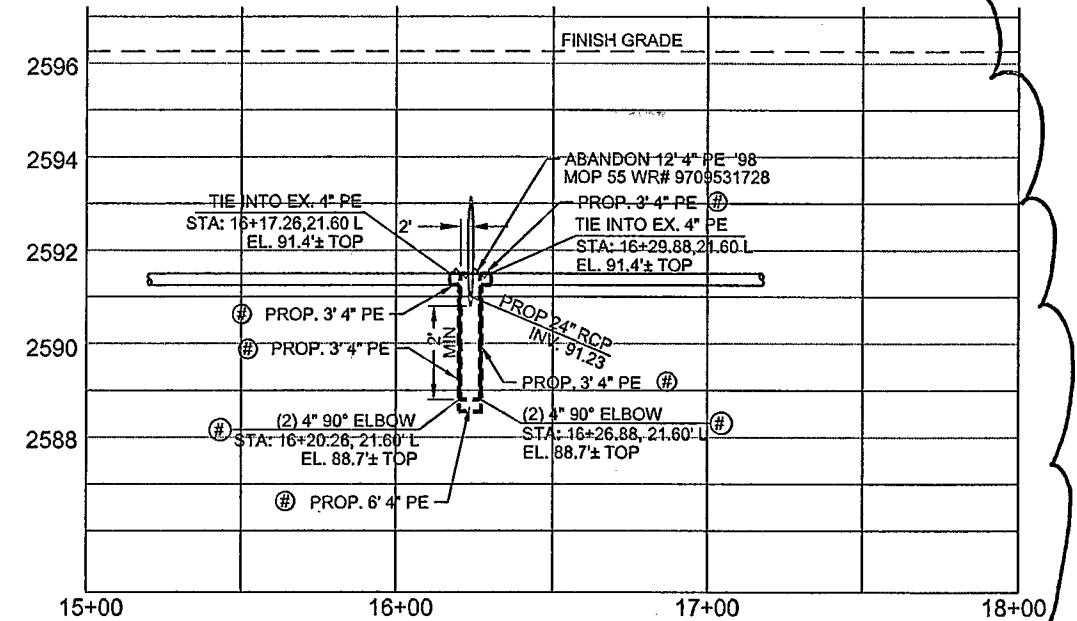

**DETAIL "A" - EL CAPITAN/ MEISENHEIMER AVE - PROFILE**  
HORIZ: 1" = 30'  
VERT: 1" = 3'

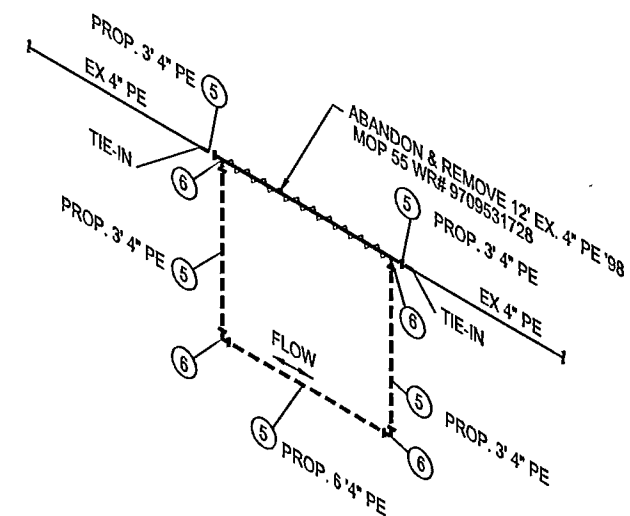

**DETAIL "A" - EL CAPITAN/ MEISENHEIMER AVE - DETAIL**  
N.T.S.

CALL BEFORE YOU DIG  
Avoid cutting underground utility lines. It's costly.  
**CALL 811**  
OR  
1-800-227-2600  
AND  
CLARK COUNTY TRAFFIC OPERATIONS  
1-702-455-7544

*av*  
*5/6/10*

REVISIONS				AS-BUILT DRAWING-PRESSURE TEST DATA				VISUAL INSPECTION CERTIFICATION				CONSTRUCTION				ISOLATION AREA				ENGINEER/TECHNICIAN: SONAL PATNI			
NO.	DESCRIPTION	BY	DATE	PIPE DIA.	TEST MEDIUM	TEST METHOD	NAME	DATE	INSPECTOR	FOREMAN	REVIEWED BY	PERMIT INFORMATION	CLV	TAX CODE	02-0200	117	1125989	Sec S-8	T19S R60E	x585y568	x588y568	F-CLV EL CAPITAN PE RELOCATIONS	
122	894																						
<b>Southwest Gas Corporation</b>				TEST PRES. (PSIG) START END TIME PROPOSED COMPLETED DATE PERFORMED BY				I HAVE VISUALLY INSPECTED ALL HEATED FUSIONS, SOLVENT CEMENT, MECHANICAL JOINTS, AND WELDS THAT I HAVE PERFORMED.				CONSTRUCTION PERMIT INFORMATION CLV TAX CODE 02-0200				ENGINEER/TECHNICIAN: SONAL PATNI ACCOUNT REP: PROJECT CONTACT: SONAL PATNI SHEET NO. 5 OF 10 DWN. BY: DW SCALE: AS NOTED CHKD. BY: JK DATE: 2-23-10 APPVD. BY:							
<b>Southwest Gas Corporation</b>				UNIT NO. UNIT TYPE INSTL. RET. INSTL. RET. COMPLETED PROPERTY UNITS				AS-BUILTS ACCEPTED BY DATE POSTED BY DATE POSTING OCD BY DATE				PERMIT INFORMATION CLV TAX CODE 02-0200				ENGINEER/TECHNICIAN: SONAL PATNI ACCOUNT REP: PROJECT CONTACT: SONAL PATNI SHEET NO. 5 OF 10 DWN. BY: DW SCALE: AS NOTED CHKD. BY: JK DATE: 2-23-10 APPVD. BY:							

H# 38212  
 L-1  
 M-1  
 S-10-16