

GENERAL NOTES


1. REFER TO ARCHITECTURAL REFLECTED CEILING PLANS, SECTIONS, ELEVATIONS, ETC. FOR EXACT LOCATION OF LIGHTING FIXTURES.
2. PROVIDE AN UNSWITCHED CIRCUIT CONDUCTOR TO EXIT SIGNS AND EMERGENCY LIGHTS.
3. REFER TO SHEET E3.03 FOR PANELBOARD LOCATIONS.

SHEET NOTES


- ① PROVIDE ON-LINE UNINTERRUPTIBLE AC POWER SYSTEM, LITHONIA CATALOG NUMBER ELV-LO-FT-10000-277-120/277-12HR-ACF-5/20/OCB-FSP OR EQUAL. UNIT SHALL BE FURNISHED WITH (6) 20A, 1P OUTPUT CIRCUIT BREAKERS. UNITS SHALL BE CAPABLE OF DISCHARGE-RECHARGE EVERY 30 DAYS FOR 5 MINUTES AND EVERY 180 DAYS FOR 30 MINUTES. INVERTER SHALL BE PROVIDED WITH LOAD SIDE EMERGENCY POWER OFF SWITCH AND WRED TO SHUNT TRIP STATION AS LOCATED ON SHEET E3.03.
- ② SEE WIRING DIAGRAM 6/E7.01 FOR ADDITIONAL INFORMATION REGARDING WIRING OF EMERGENCY LIGHTING.
- ③ CEILING MOUNTED ROOM OCCUPANCY SENSOR FOR CONTROL OF NORMAL LIGHTING ONLY. SEE DETAILS 3/E7.01, 4/E7.01 AND 5/E7.01 FOR ADDITIONAL WIRING INFORMATION.
- ④ CIRCUIT EXAM LIGHT TO NEAREST 120V POWER CIRCUIT.
- ⑤ CIRCUIT UNDERCOUNTER LIGHTS TO NEAREST 120V POWER CIRCUIT.
- ⑥ SEE SHEET E2.01 FOR CONTINUATION.
- ⑦ CIRCUIT TYPE 'Y' LIGHTS TO NEAREST 120V. POWER CIRCUIT.
- ⑧ MOUNT OFCI DUPLEX RECEPTACLE IN WEATHERPROOF ENCLOSURE AT 14'-0" A.F.G. ON COLUMN.
- ⑨ ROUTE CIRCUITS TO PANEL THRU CONTACTOR. SEE DETAIL 6/E7.01 FOR ADDITIONAL INFORMATION.
- ⑩ ROUTE CIRCUIT TO PANEL THRU LIGHTING CONTACTOR. SEE DETAIL 7/E7.01 FOR ADDITIONAL INFORMATION.
- ⑪ CIRCUIT TWO (2) DOWNLIGHT LAMPS OF TYPE 'Q' FIXTURE TO EMERGENCY LIGHTING CIRCUIT.
- ⑫ CIRCUIT UPLIGHT PORTION OF TYPE 'Q' LIGHTING FIXTURE TO '3b' AND DOWNLIGHT PORTION OF FIXTURE TO '5c'.

LIGHTING PLAN

SCALE: 1/8" = 1' - 0"

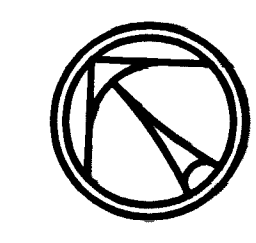

55512

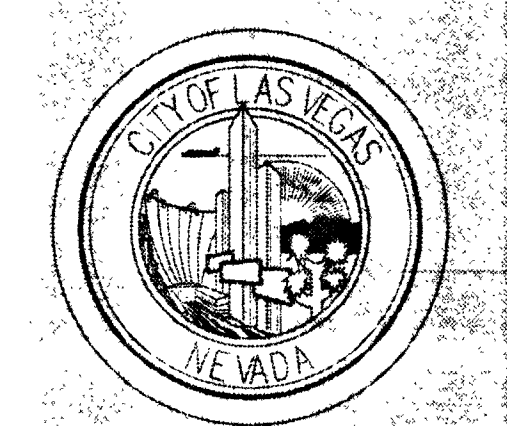

DEPARTMENT OF PUBLIC WORKS

JMA ARCHITECTURE STUDIOS

11450 WINDMILL CREEK DRIVE SUITE 100 LAS VEGAS, NEVADA 89135

East Las Vegas Community Center

Eastern and Stewart

HARRIS & ASSOCIATES, INC.

PROJECT NO. 200801.00

DATE: 07/25/08

CHECKED BY: J.L. HARRIS

DRAWN BY: D. FLETCHER

OWNER: CITY OF LAS VEGAS
DEPARTMENT OF PUBLIC WORKS
ARCHITECTURAL SERVICES

RECORD DRAWINGS

Date: 5/21/03 The record drawing has been prepared in part, based upon information furnished by others. While the information is believed to be reliable, Harris Consulting Engineers P.C. cannot ensure its accuracy, and is not responsible for the accuracy of this record drawing or for any errors or omissions which may have been incorporated into it as a result. Those relying on this record drawing are advised to obtain independent verification of its accuracy before applying it for any purpose.

DATE	DATE
FILE	August 2, 2001
SCALE	1/8" = 1'-0"
BD NO	01.15301.22
CLIPPING NO	521-288

E2.02