


**GENERAL NOTES**

1. ALL DRAINAGE PIPING 4" AND SMALLER SHALL BE SLOPED AT 1/4" PER FOOT.
2. ALL DRAINAGE PIPING 5" AND LARGER SHALL BE SLOPED AT 1/8" PER FOOT.
3. ALL CONDENSATE DRAINAGE (CD) PIPING SHALL BE SLOPED AT 1/8" PER FOOT.
4. ALL STORM DRAIN (SD) AND OVERFLOW STORM DRAIN (OSD) PIPING SHALL BE SLOPED AT 1/8" PER FOOT.
5. NO PLUMBING PIPING SHALL BE INSTALL IN CONCRETE OR MASONRY WALLS UNLESS A PIPE CHASE IS PROVIDED.

**SHEET NOTES**

- ① 1/2" GAS SUPPLY TO GAS PACKAGE UNIT.
- ② 3/4" GAS SUPPLY TO GAS PACKAGE UNIT.
- ③ FOR CONTINUATION, SEE P2.03.
- ④ GAS PRESSURE REGULATOR, 5 PSIG TO 7" W.C.
- ⑤ 1-1/2" MEDIUM PRESSURE GAS SUPPLY DOWN THRU ROOF.
- ⑥ 1-1/2" MEDIUM PRESSURE GAS SUPPLY UP FROM BELOW.

554916 PARTIAL PLUMBING PLAN - ROOF LEVEL  
SCALE: 1/8" = 1' - 0"

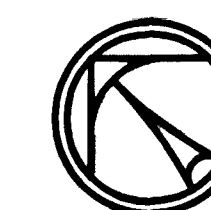


RECORD DRAWINGS  
Date: 5/21/03 This record drawing has been prepared in part, based upon information furnished by others. While this information is believed to be reliable, Harris Consulting Engineers P.C. cannot ensure its accuracy, and is not responsible for the accuracy of this record drawing or for any errors or omissions which may have been incorporated into it as a result. Those relying on this record drawing are advised to obtain independent verification of its accuracy before relying on it for any purpose.

OWNER: CITY OF LAS VEGAS  
DEPARTMENT OF PUBLIC WORKS  
ARCHITECTURAL SERVICES

400 EAST STEWART AVENUE  
LAS VEGAS, NEVADA 89101  
PHONE: (702) 258-8038  
FAX: (702) 258-3238  
TDD: (702) 386-2108

DATE	8/2/2001
BY	S.G.P.
CHECKED	
SCALE	1/8"=1'-0"
PROJECT NO.	01.15301.22
DWG NO.	52-288

P2.04

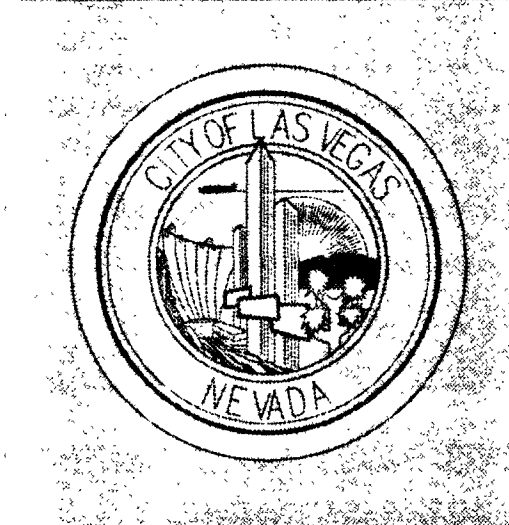

REVISIONS  
CONSULTANT  
JMA ARCHITECTURE STUDIOS  
1117 EAST FLORISSANT AVENUE  
SUITE 1000 LAS VEGAS, NV 89101  
TEL: (702) 258-8038  
WWW.JMA-ARCHITECTURE.COM

East Las Vegas Community Center  
Eastern and Stewart

HARRIS  
CONSULTING ENGINEERS P.C.  
PROJECT NO. 20026.30  
DESIGNED BY: J.A. DUBILES  
DRAWN BY: J.A. DUBILES

STAMP