





A PARTIAL ROOF PLAN - AREA 'A'
1/8"=1'-0"

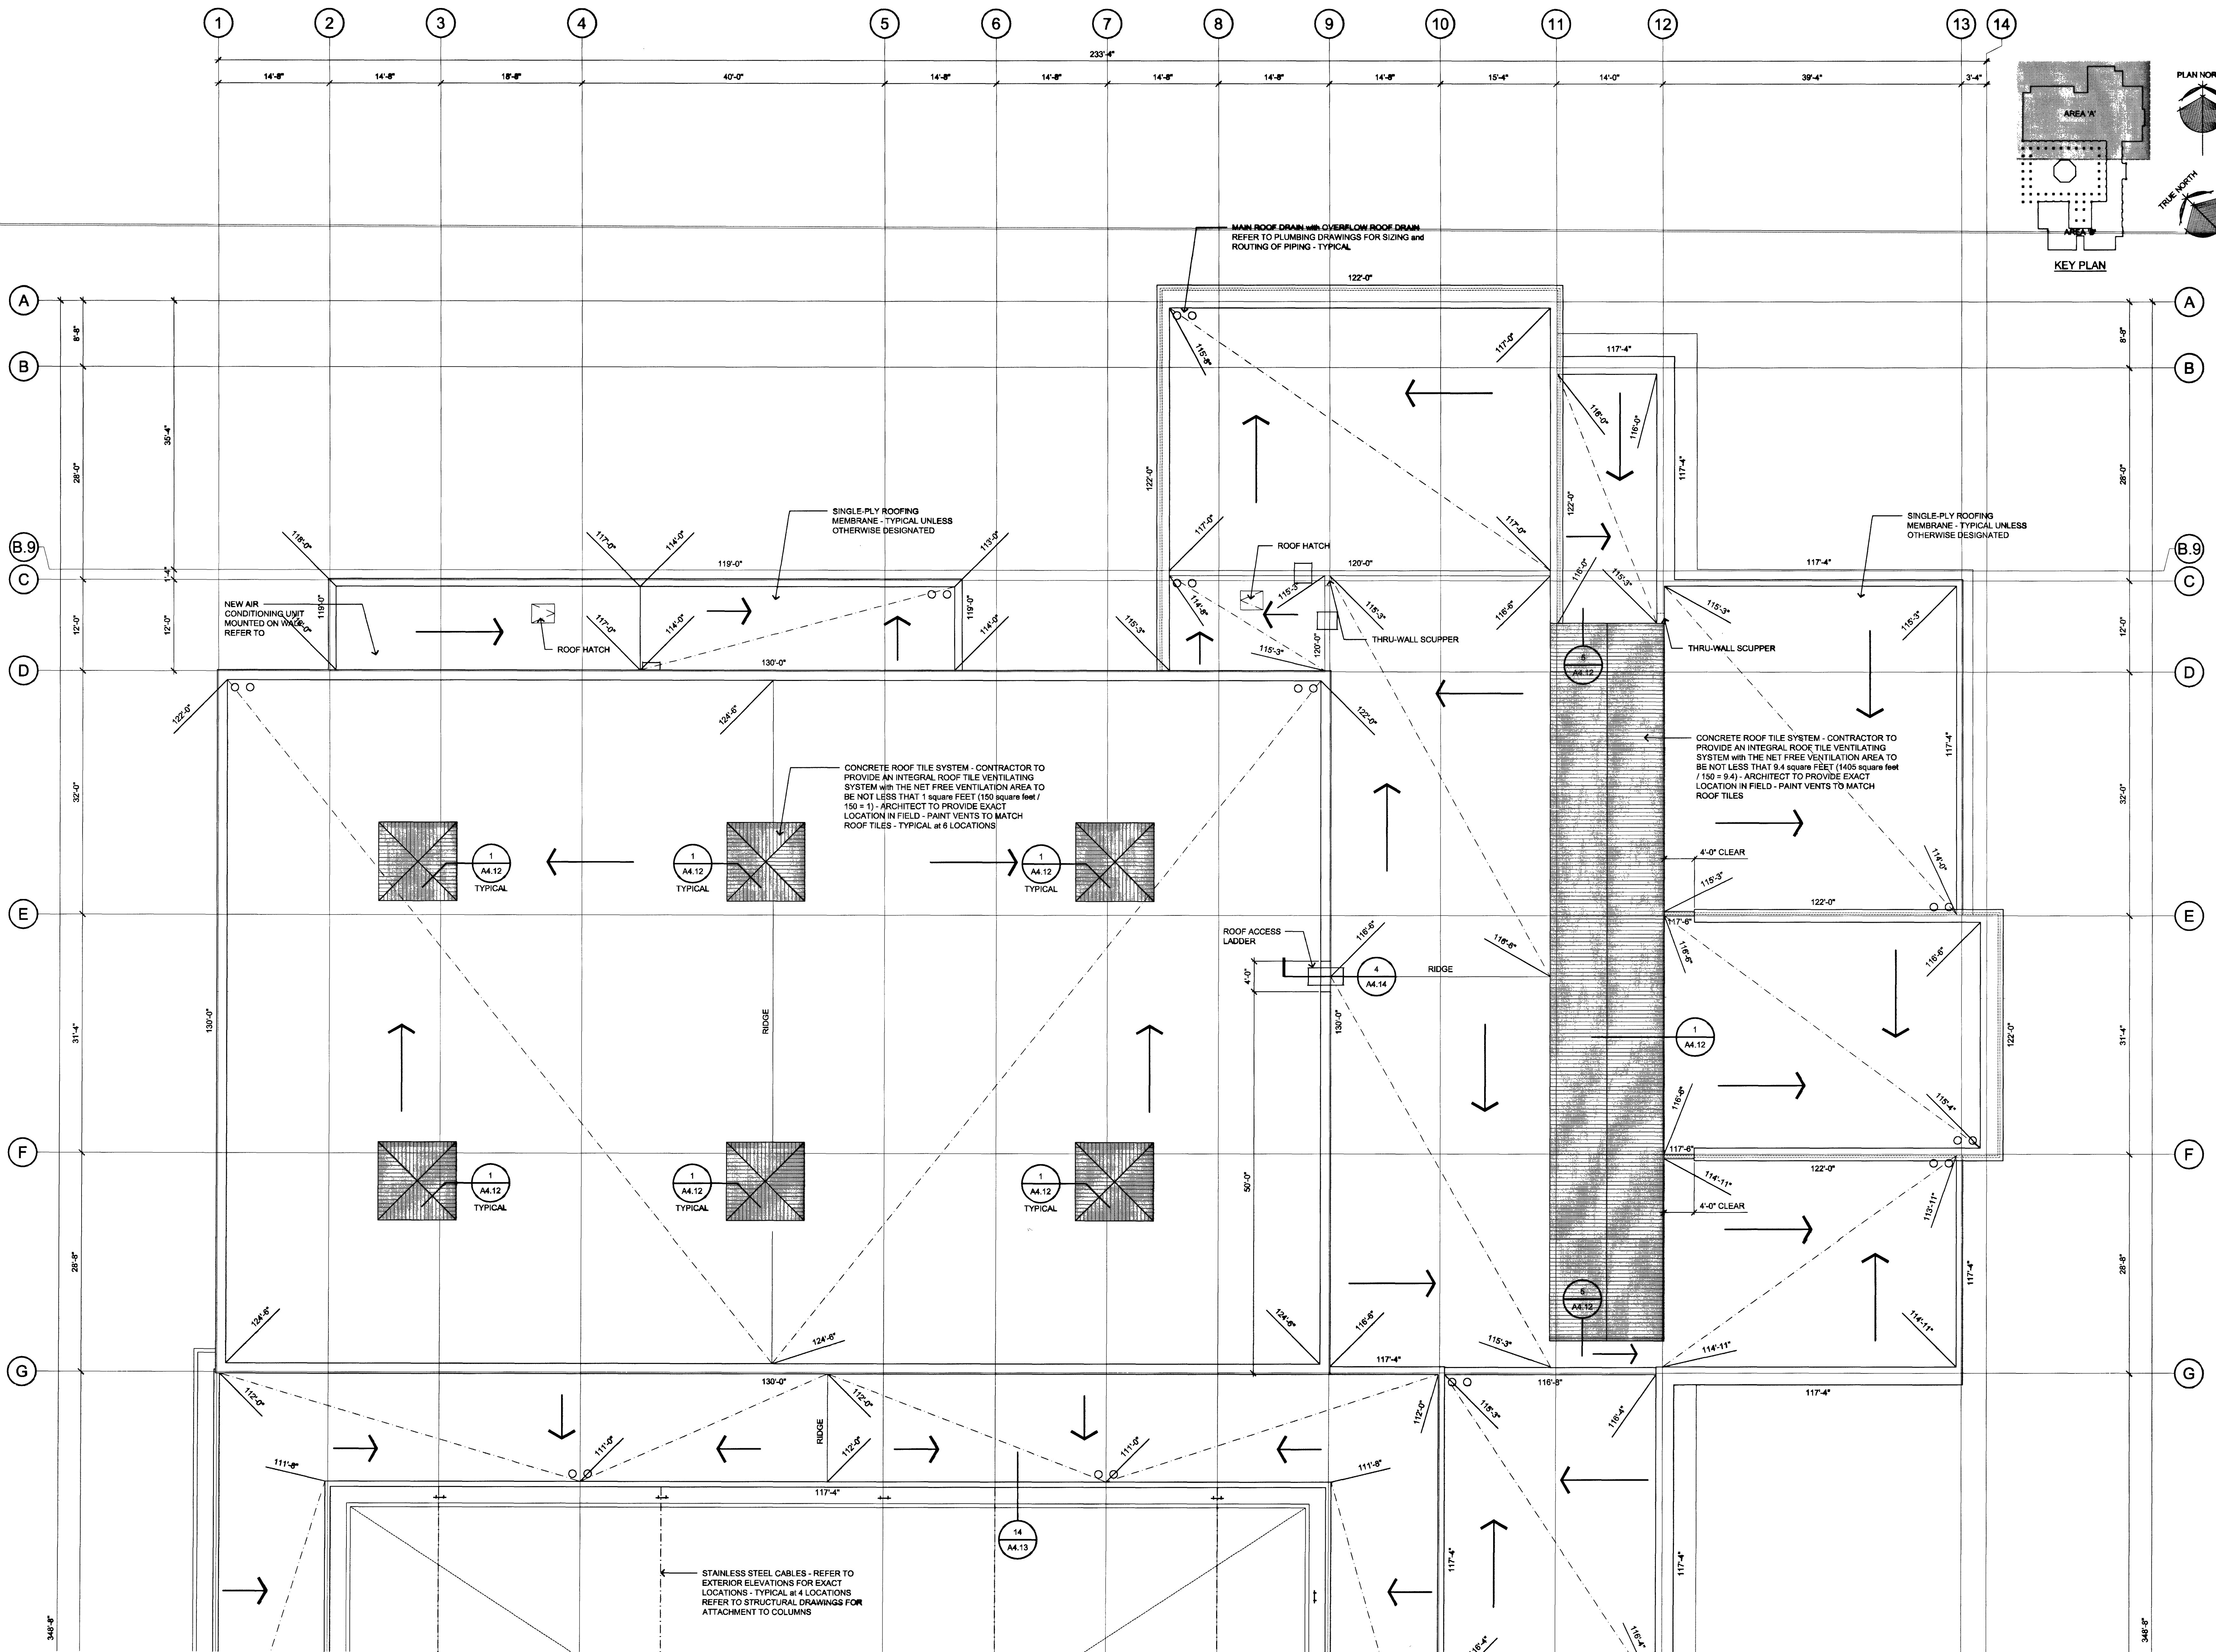

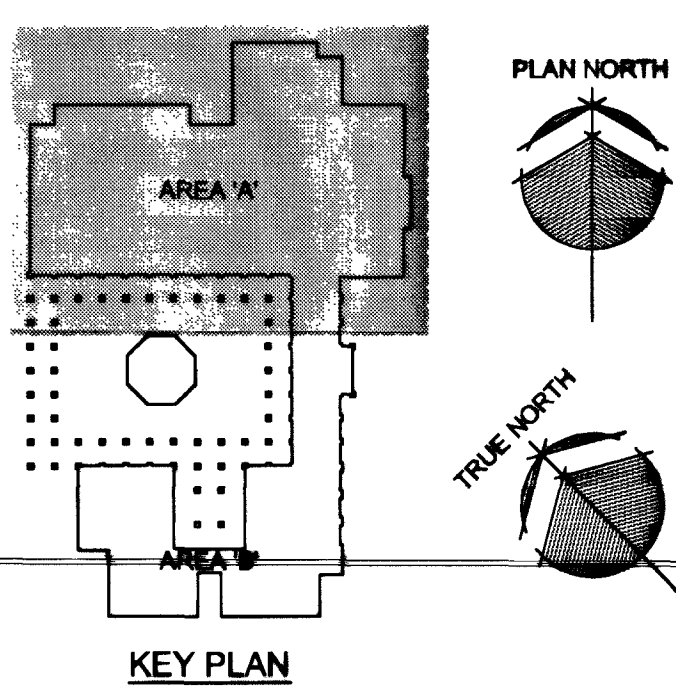

REVISIONS

NO.	DATE	DESCRIPTION
1		
2		
CONSULTANT

JMA ARCHITECTURE STUDIOS
10110 CHANDLER BLVD. SUITE 100
LAS VEGAS, NV 89121
(702) 362-3232
FAX: (702) 362-3233
WWW.JMA-ARCH.COM

DEPARTMENT OF PUBLIC WORKS

East Las Vegas Community Center
Eastern and Stewart

Construction Documents

RECORD DRAWING
This record drawing, dated May 12, 2003, has been prepared, in part, based upon information furnished by others.

While this information is believed to be reliable, JMA Architecture Studios, General Architects, and its staff are not responsible for the accuracy of the record drawing or for any errors or omissions which may have been incorporated into it as a result.

Those relying on this record drawing are advised to obtain independent verification of its accuracy before using it for any purpose.

OWNER: CITY OF LAS VEGAS
DEPARTMENT OF PUBLIC WORKS
ARCHITECTURAL SERVICES

4401 EAST STEWART AVENUE
LAS VEGAS, NEVADA 89101
PHONE: (702) 226-8538
FAX: (702) 362-3232
TDD: (702) 362-3233

DRAWN: M. Phillips
ALL
DATE: August 2, 2001
SCALE
REV NO: 01-15301.22
CIVILS NO: 521-288
REV NO

A4.01