




REVISIONS

CONSULTANT
JMA ARCHITECTURE STUDIOS
ARCHITECTURAL CONSULTANT

East Las Vegas Community Center

Eastern and Stewart
Construction Documents

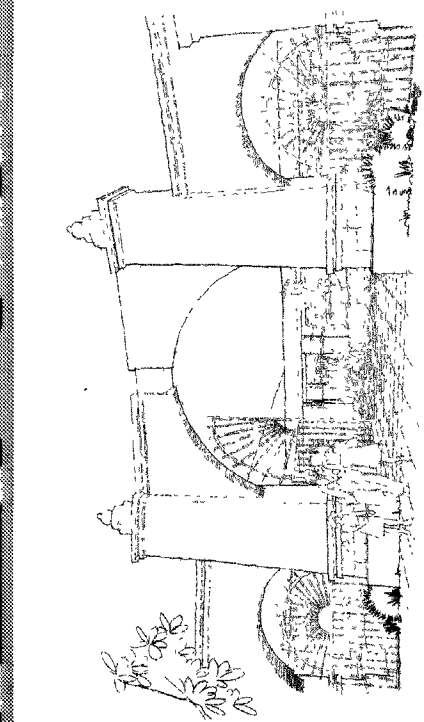

RECORD DRAWING

This record drawing, dated May 12, 2003, has been prepared in accordance with the provisions of the Nevada State Board of Professional Engineers and Architects. It is not responsible for the accuracy of this record drawing or for any errors or omissions that may have been incorporated into it as a result.


OWNER: CITY OF LAS VEGAS
DEPARTMENT OF PUBLIC WORKS
ARCHITECTURAL SERVICES

400 EAST STEWART AVENUE
LAS VEGAS, NEVADA 89101
PHONE: (702) 362-3224
FAX: (702) 362-3222
TDD: (702) 368-8106

DATE: M. Phillips
SCALE: August 2, 2001
SHEET NO: 01.15301.22
CITY DRAWING NO: 521-268

236A201.DWG 01/18/01 18:38

A2.02

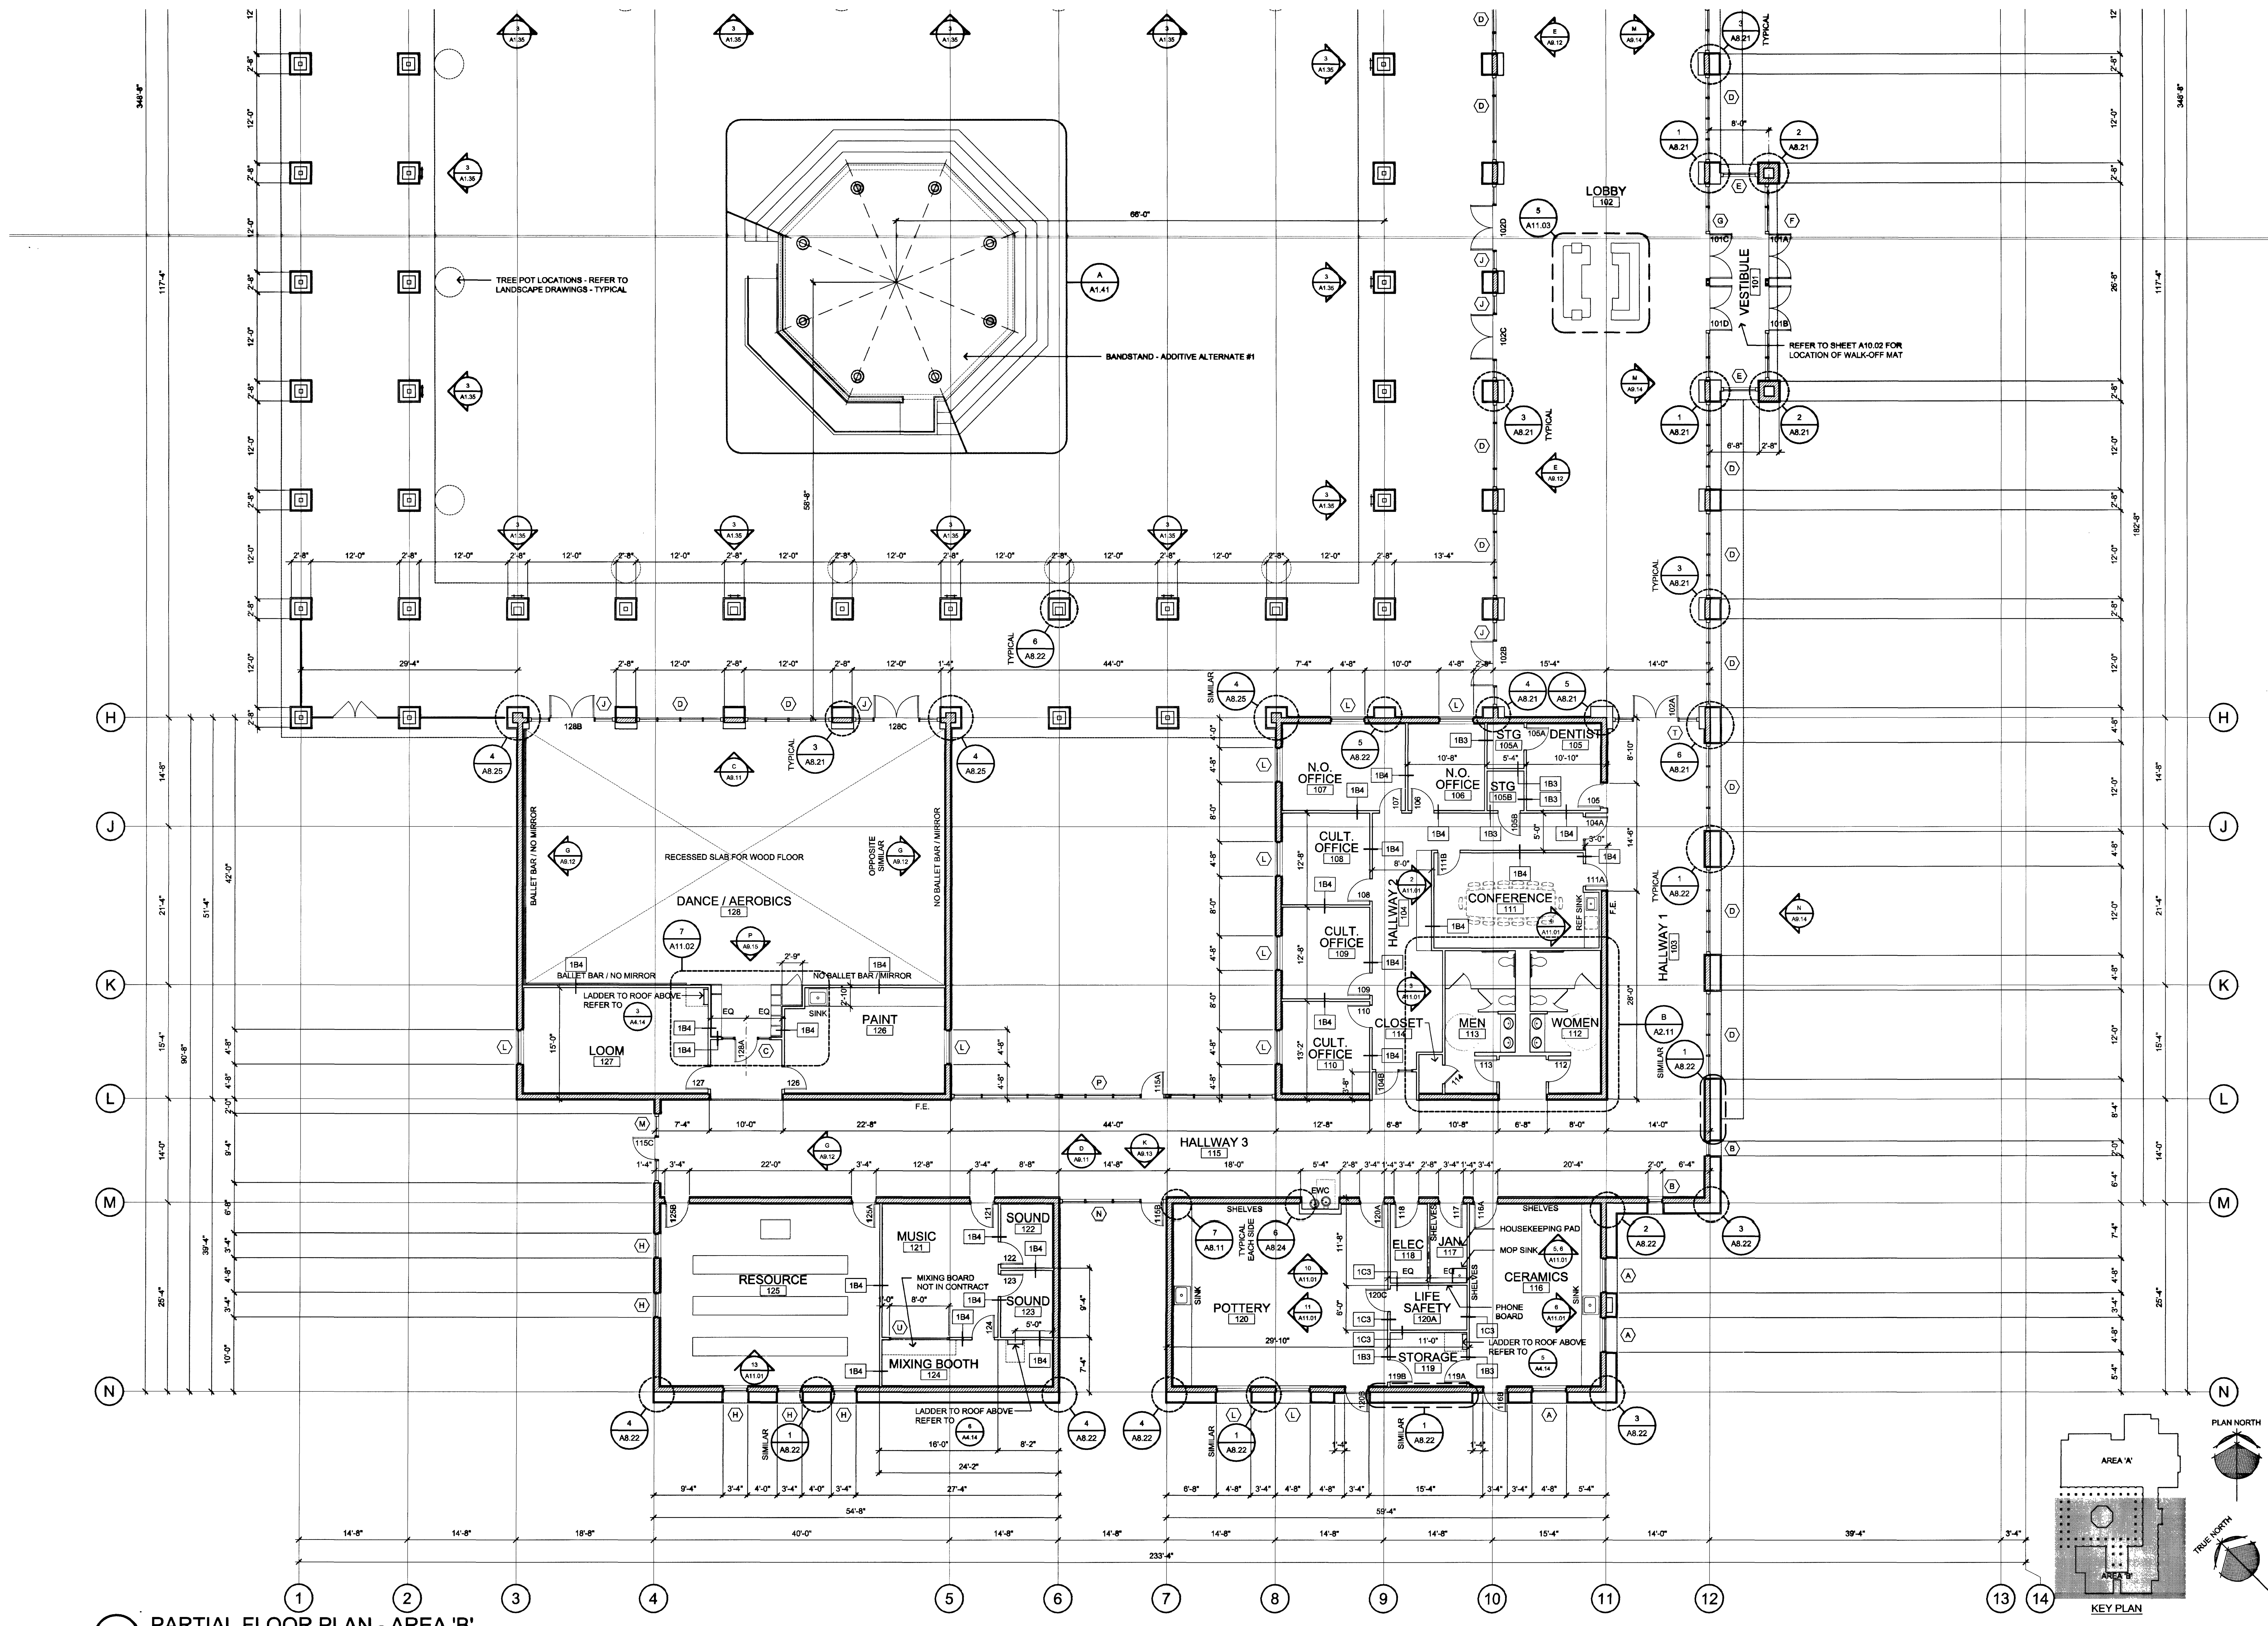

B PARTIAL FLOOR PLAN - AREA 'B'

1/8"=1'-0"

55416

KEY PLAN

