


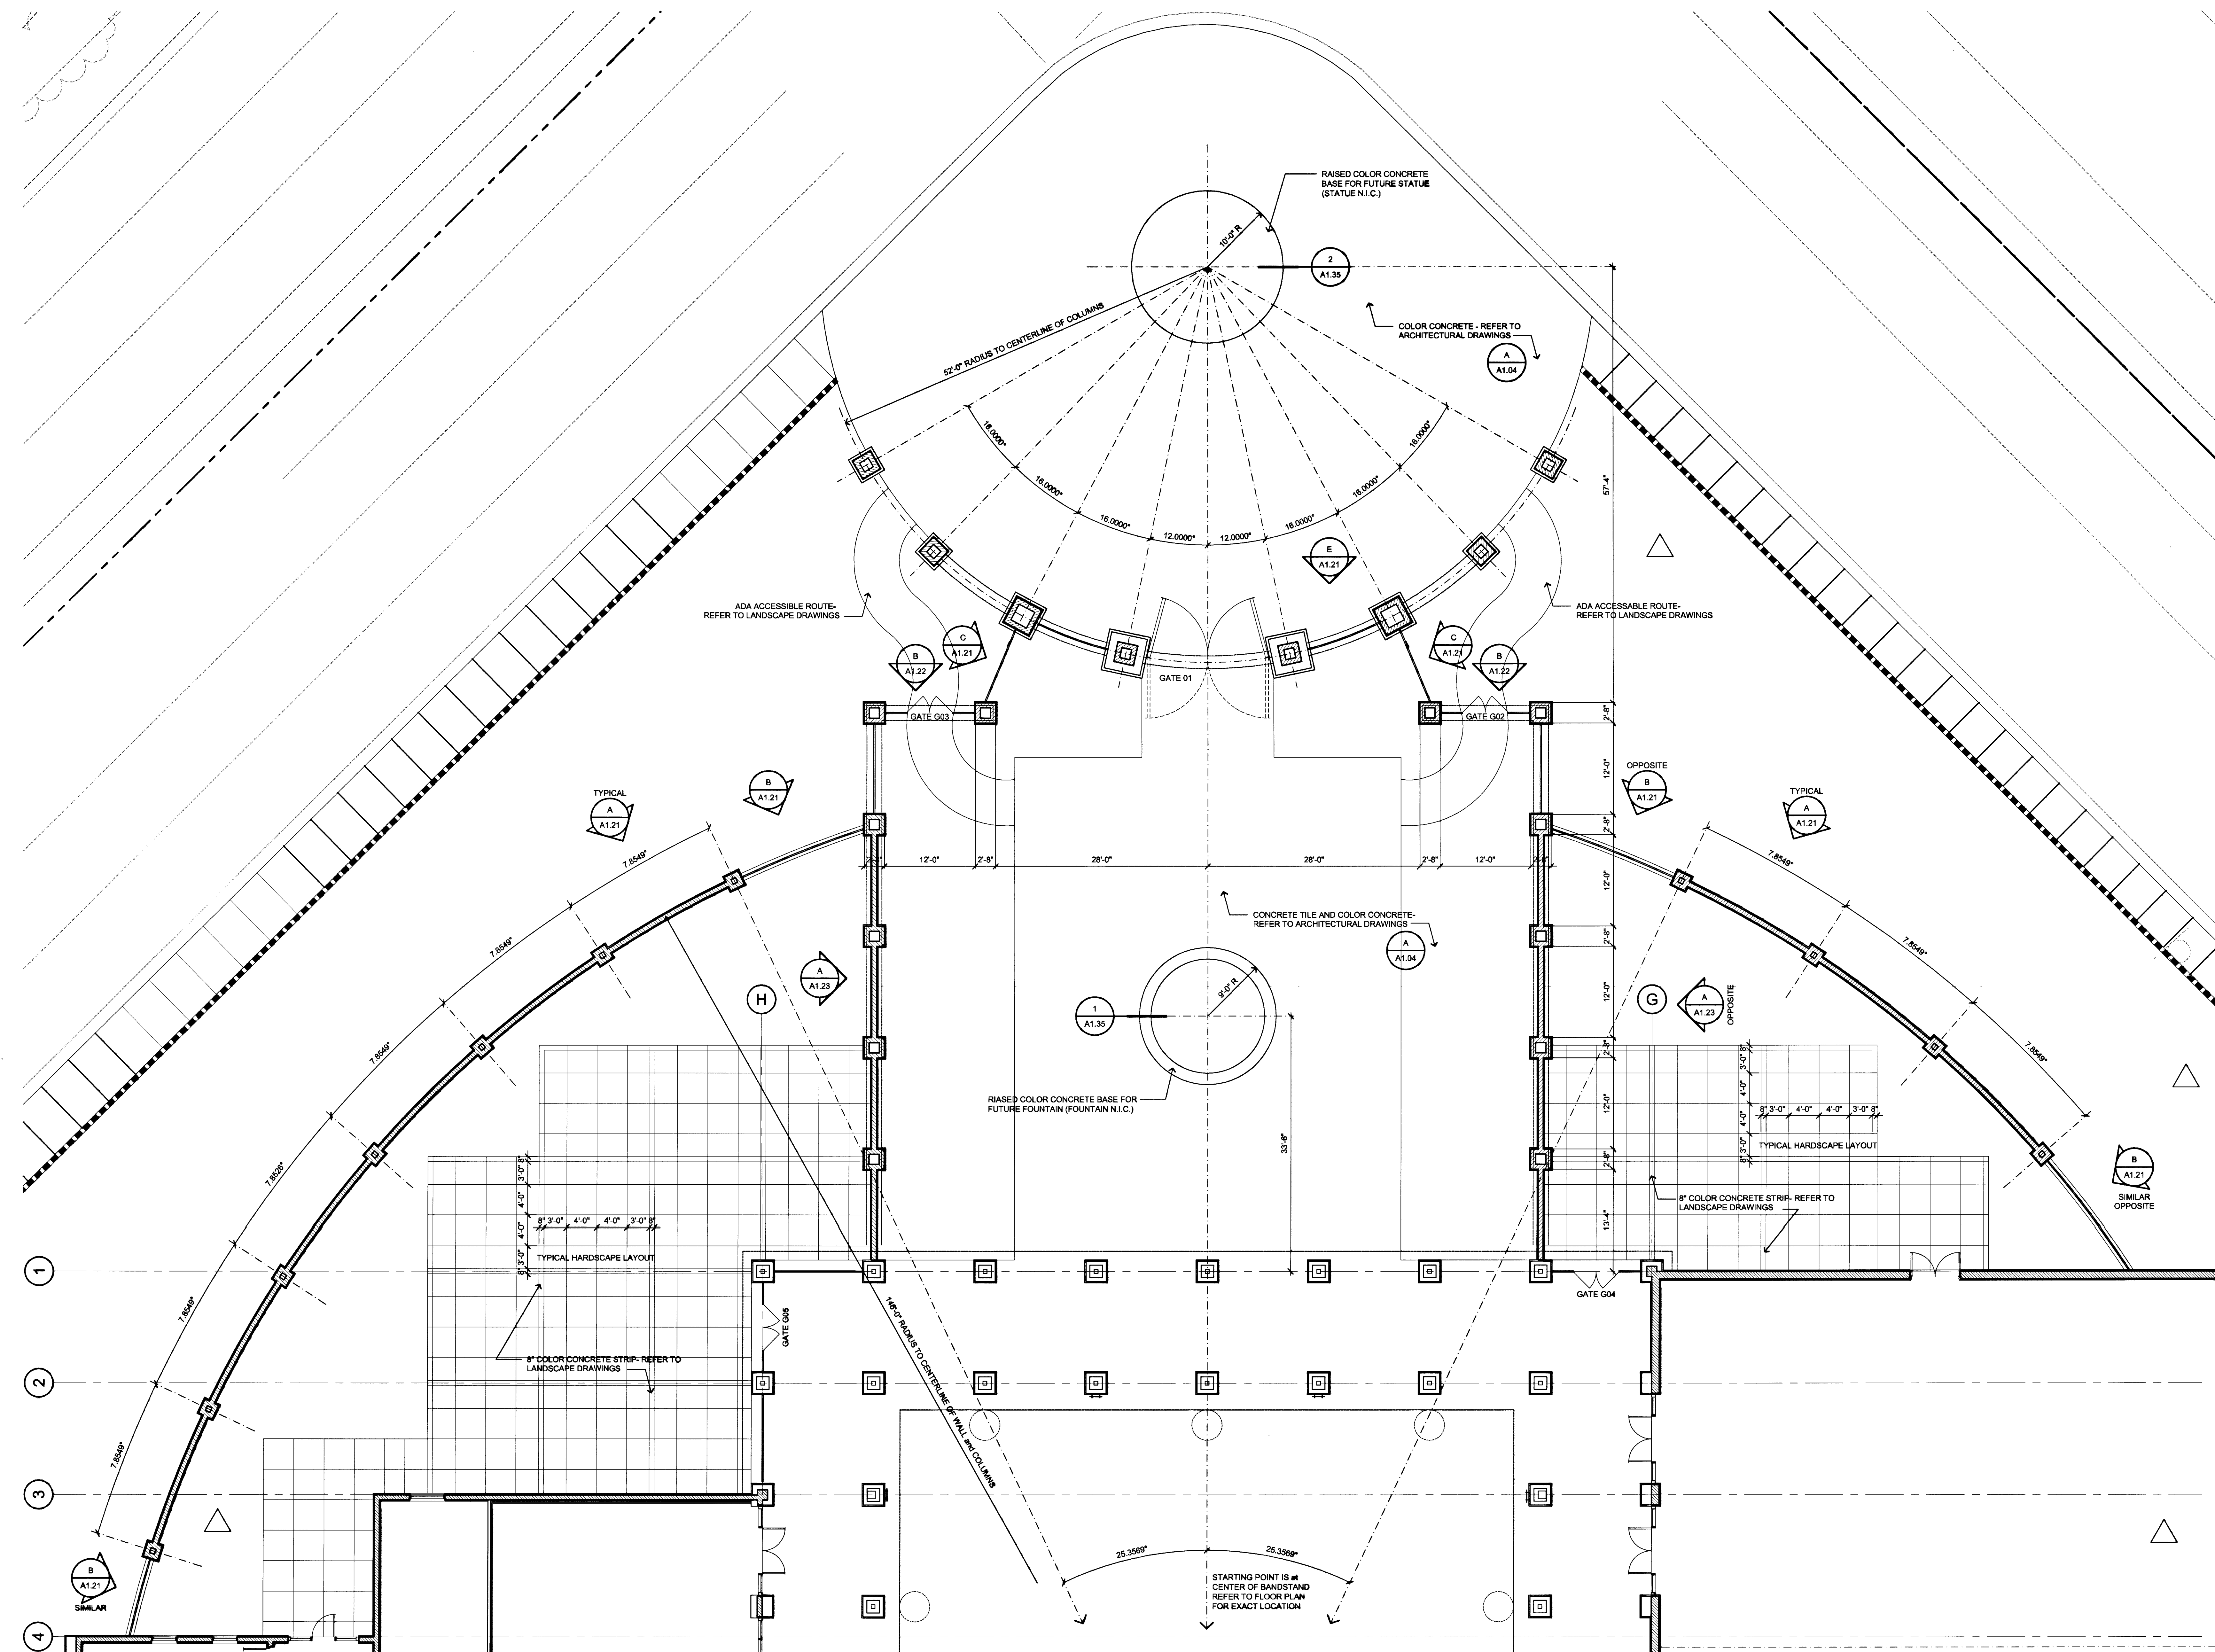

A ENLARGED SITE PLAN
1/8"=1'-0"
55 401

23581TE02.DWG 01/31/01 11:28




14/02 Wall Revision

CONSULTANT



East Las Vegas Community Center
Eastern and Stewart
Construction Documents

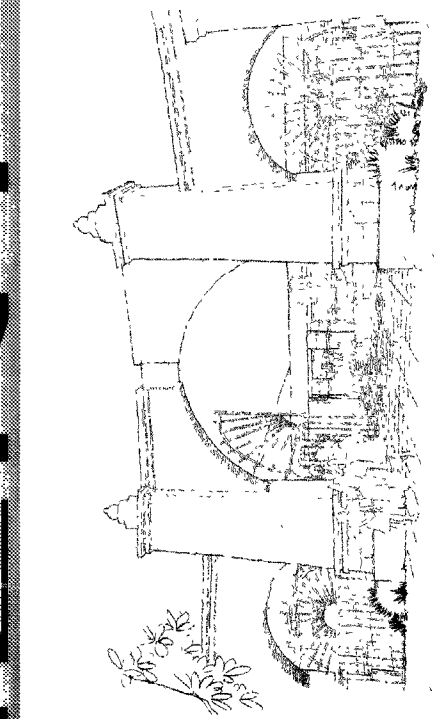

RECORD DRAWING

This record drawing, dated May 12, 2003, has been prepared, in part, based on information furnished by others.

While this information is believed to be reliable, JMA Architecture Studios, cannot assume its accuracy, and this is not responsible for the accuracy of the record drawing or for any errors or omissions which may have been incorporated into the record.

Those relying on this record drawing are advised to obtain independent verification of its accuracy before relying on it for any purpose.

OWNER: CITY OF LAS VEGAS
DEPARTMENT OF PUBLIC WORKS
ARCHITECTURAL SERVICES

400 EAST STEWART AVENUE
LAS VEGAS, NEVADA 89101
PHONE: (702) 229-6328
FAX: (702) 382-5258
TDD: (702) 388-9108

DESIGN: N. Niccum

DATE: August 2, 2001

SCALE: 01:15301.22

CITY OF LAS VEGAS 521-258

DRAWING NO.

A1.02