




REVISIONS
14/02 Wall Revision



DEPARTMENT OF PUBLIC WORKS
East Las Vegas Community Center
Eastern and Stewart
Construction Documents

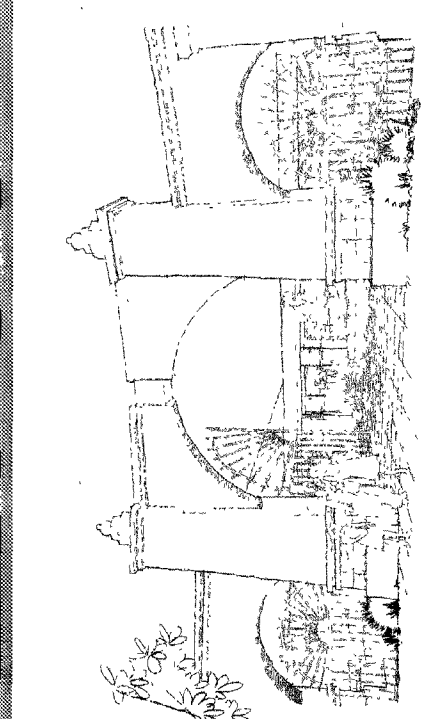

STAMP
RECORD DRAWING

The record drawing, dated May 13, 2003, has been prepared, in part, based upon information furnished by others. While this information is believed to be reliable, JMA Architecture Studios, cannot assume its accuracy, and files is not responsible for the accuracy of the record drawing or for any errors or omissions which may have been incorporated into this drawing.

Those relying on this record drawing are advised to obtain independent verification of its accuracy before relying on any portion.


OWNER: CITY OF LAS VEGAS
DEPARTMENT OF PUBLIC WORKS
ARCHITECTURAL SERVICES

400 EAST STEWART AVENUE
LAS VEGAS, NEVADA 89101
PHONE: (702) 258-8000
FAX: (702) 258-8000
TDD: (702) 388-9108

DRAWN: N. Niccum
DATE: August 2, 2001
SCALE:
NO. 01.15301.22
CU. NO. 521-268


DWG NO. A1.22

DRAWINGS AND INSTRUMENTS OF SERVICE ARE THE PROPERTY OF THE DESIGN PROFESSIONAL. WHOSE STAMP OF CERTIFICATION APPEARS ON THE DRAWINGS AND SPECIFICATIONS. ANY USE OR REPRODUCTION IN WHOLE OR IN PART WITHOUT WRITTEN CONSENT IS STRICTLY PROHIBITED. COPIES OF THE DRAWINGS AND SPECIFICATIONS RETURNED BY THE CLIENT MAY BE UTILIZED ONLY FOR THE PROJECT FOR WHICH THEY WERE PREPARED AND NOT FOR THE CONTROL OF OTHER PROJECTS.

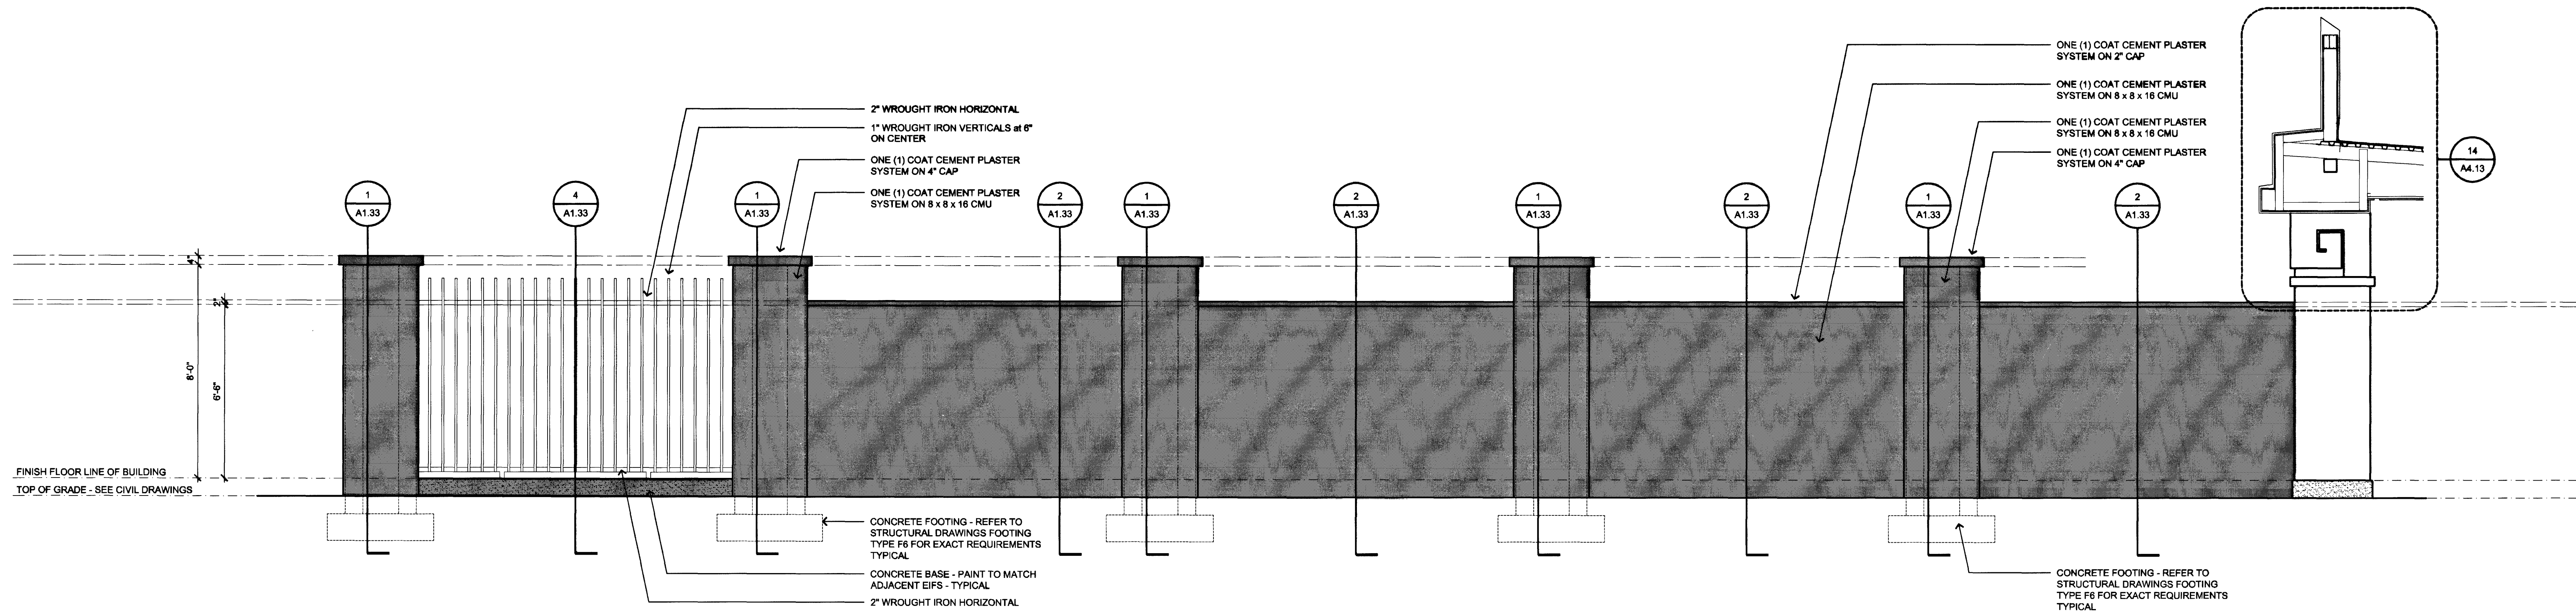

A EXTERIOR WALL
3/8" = 1'-0"

△
△
REVISED ENTIRE SHEET

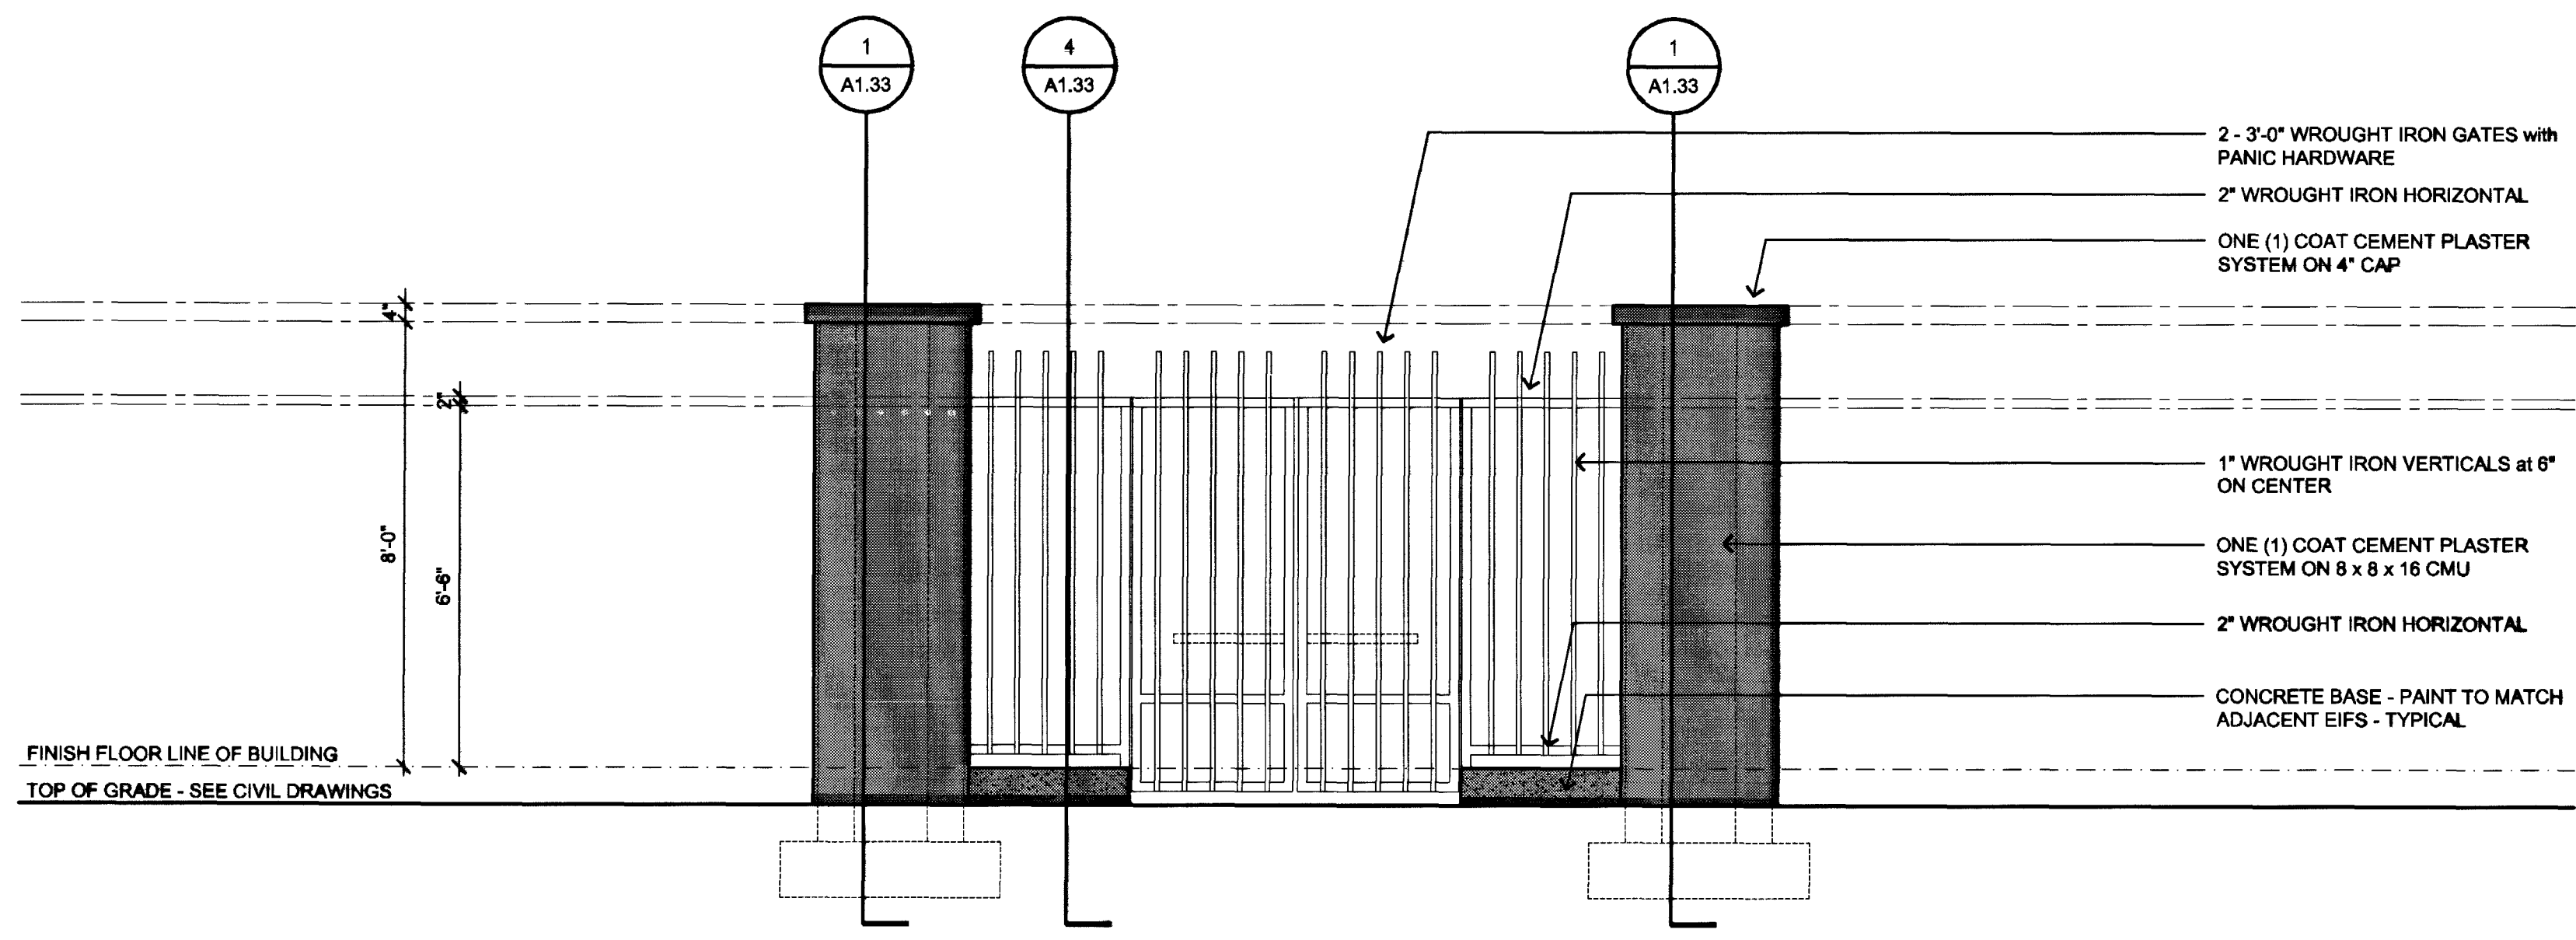

B EXTERIOR WALL
1/4" = 1'-0"
55405

D:\SITE10.DWG 06/08/01 08:57