



WALL SECTION NOTES

1. ALL CMU WALLS TO BE SOLID GROUTED
2. PROVIDE METAL EDGE TRIMS at END OF ALL EXPOSED GYPSUM BOARD EDGES
3. PROVIDE METAL CORNER BEADS at ALL GYPSUM BOARD CORNERS
4. REFER TO STRUCTURAL DRAWINGS FOR MORE INFORMATION
5. REFER TO SPECIFICATIONS FOR MORE INFORMATION
6. FIREPROOFING NOT SHOWN ON ROOF STRUCTURE MEMBERS (I.E. METAL DECK, JOISTS, BEAMS, ETC.) FOR CLARITY ALL ROOF MEMBERS TO BE COVERED with FIREPROOFING FOR 1-HOUR PROTECTION PER UBC TABLE 5-A REFER TO UL DESIGN NUMBER P701 ON SHEET A2.22 FOR MORE INFORMATION
7. ALL EXTERIOR CMU WALLS TO BE 2-HOUR FIRE-RESISTIVE CONSTRUCTION PER UBC TABLE 7-8 ITEM #6 ASSEMBLY 6-1.3


SCHD-WS.DWG 11/28/01 13.37

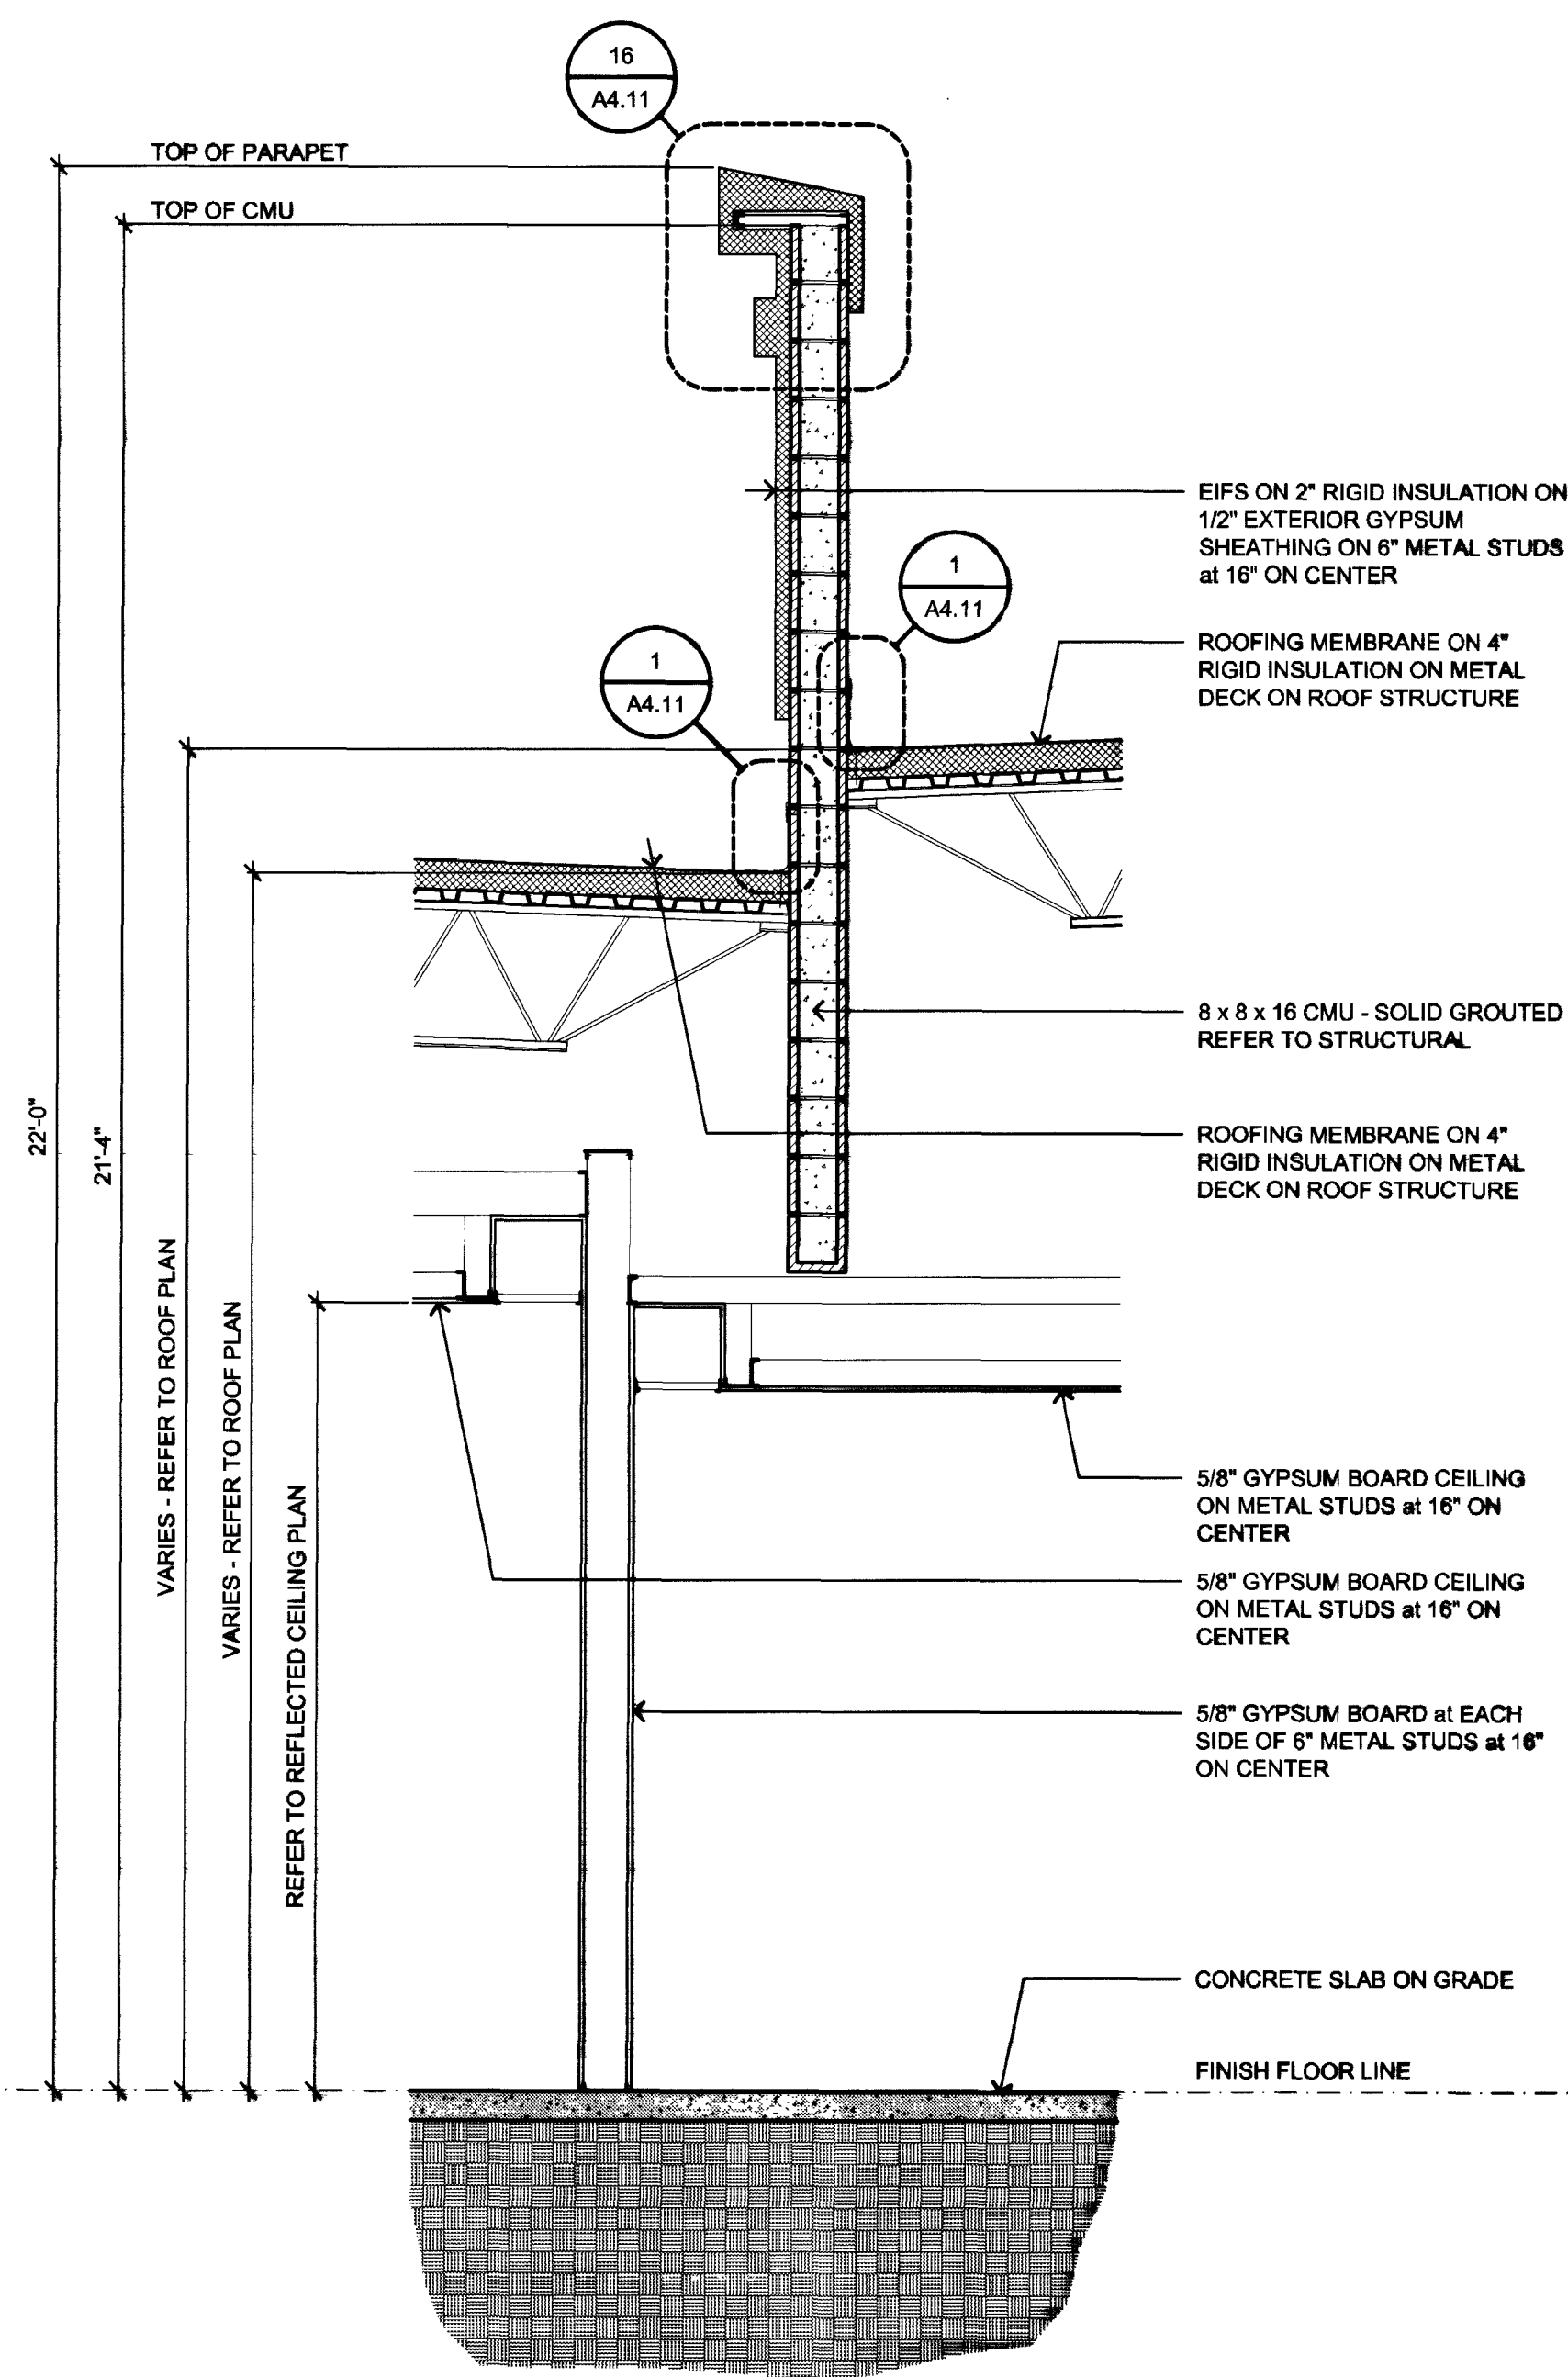


26
WALL SECTION
1/2"=1'-0"

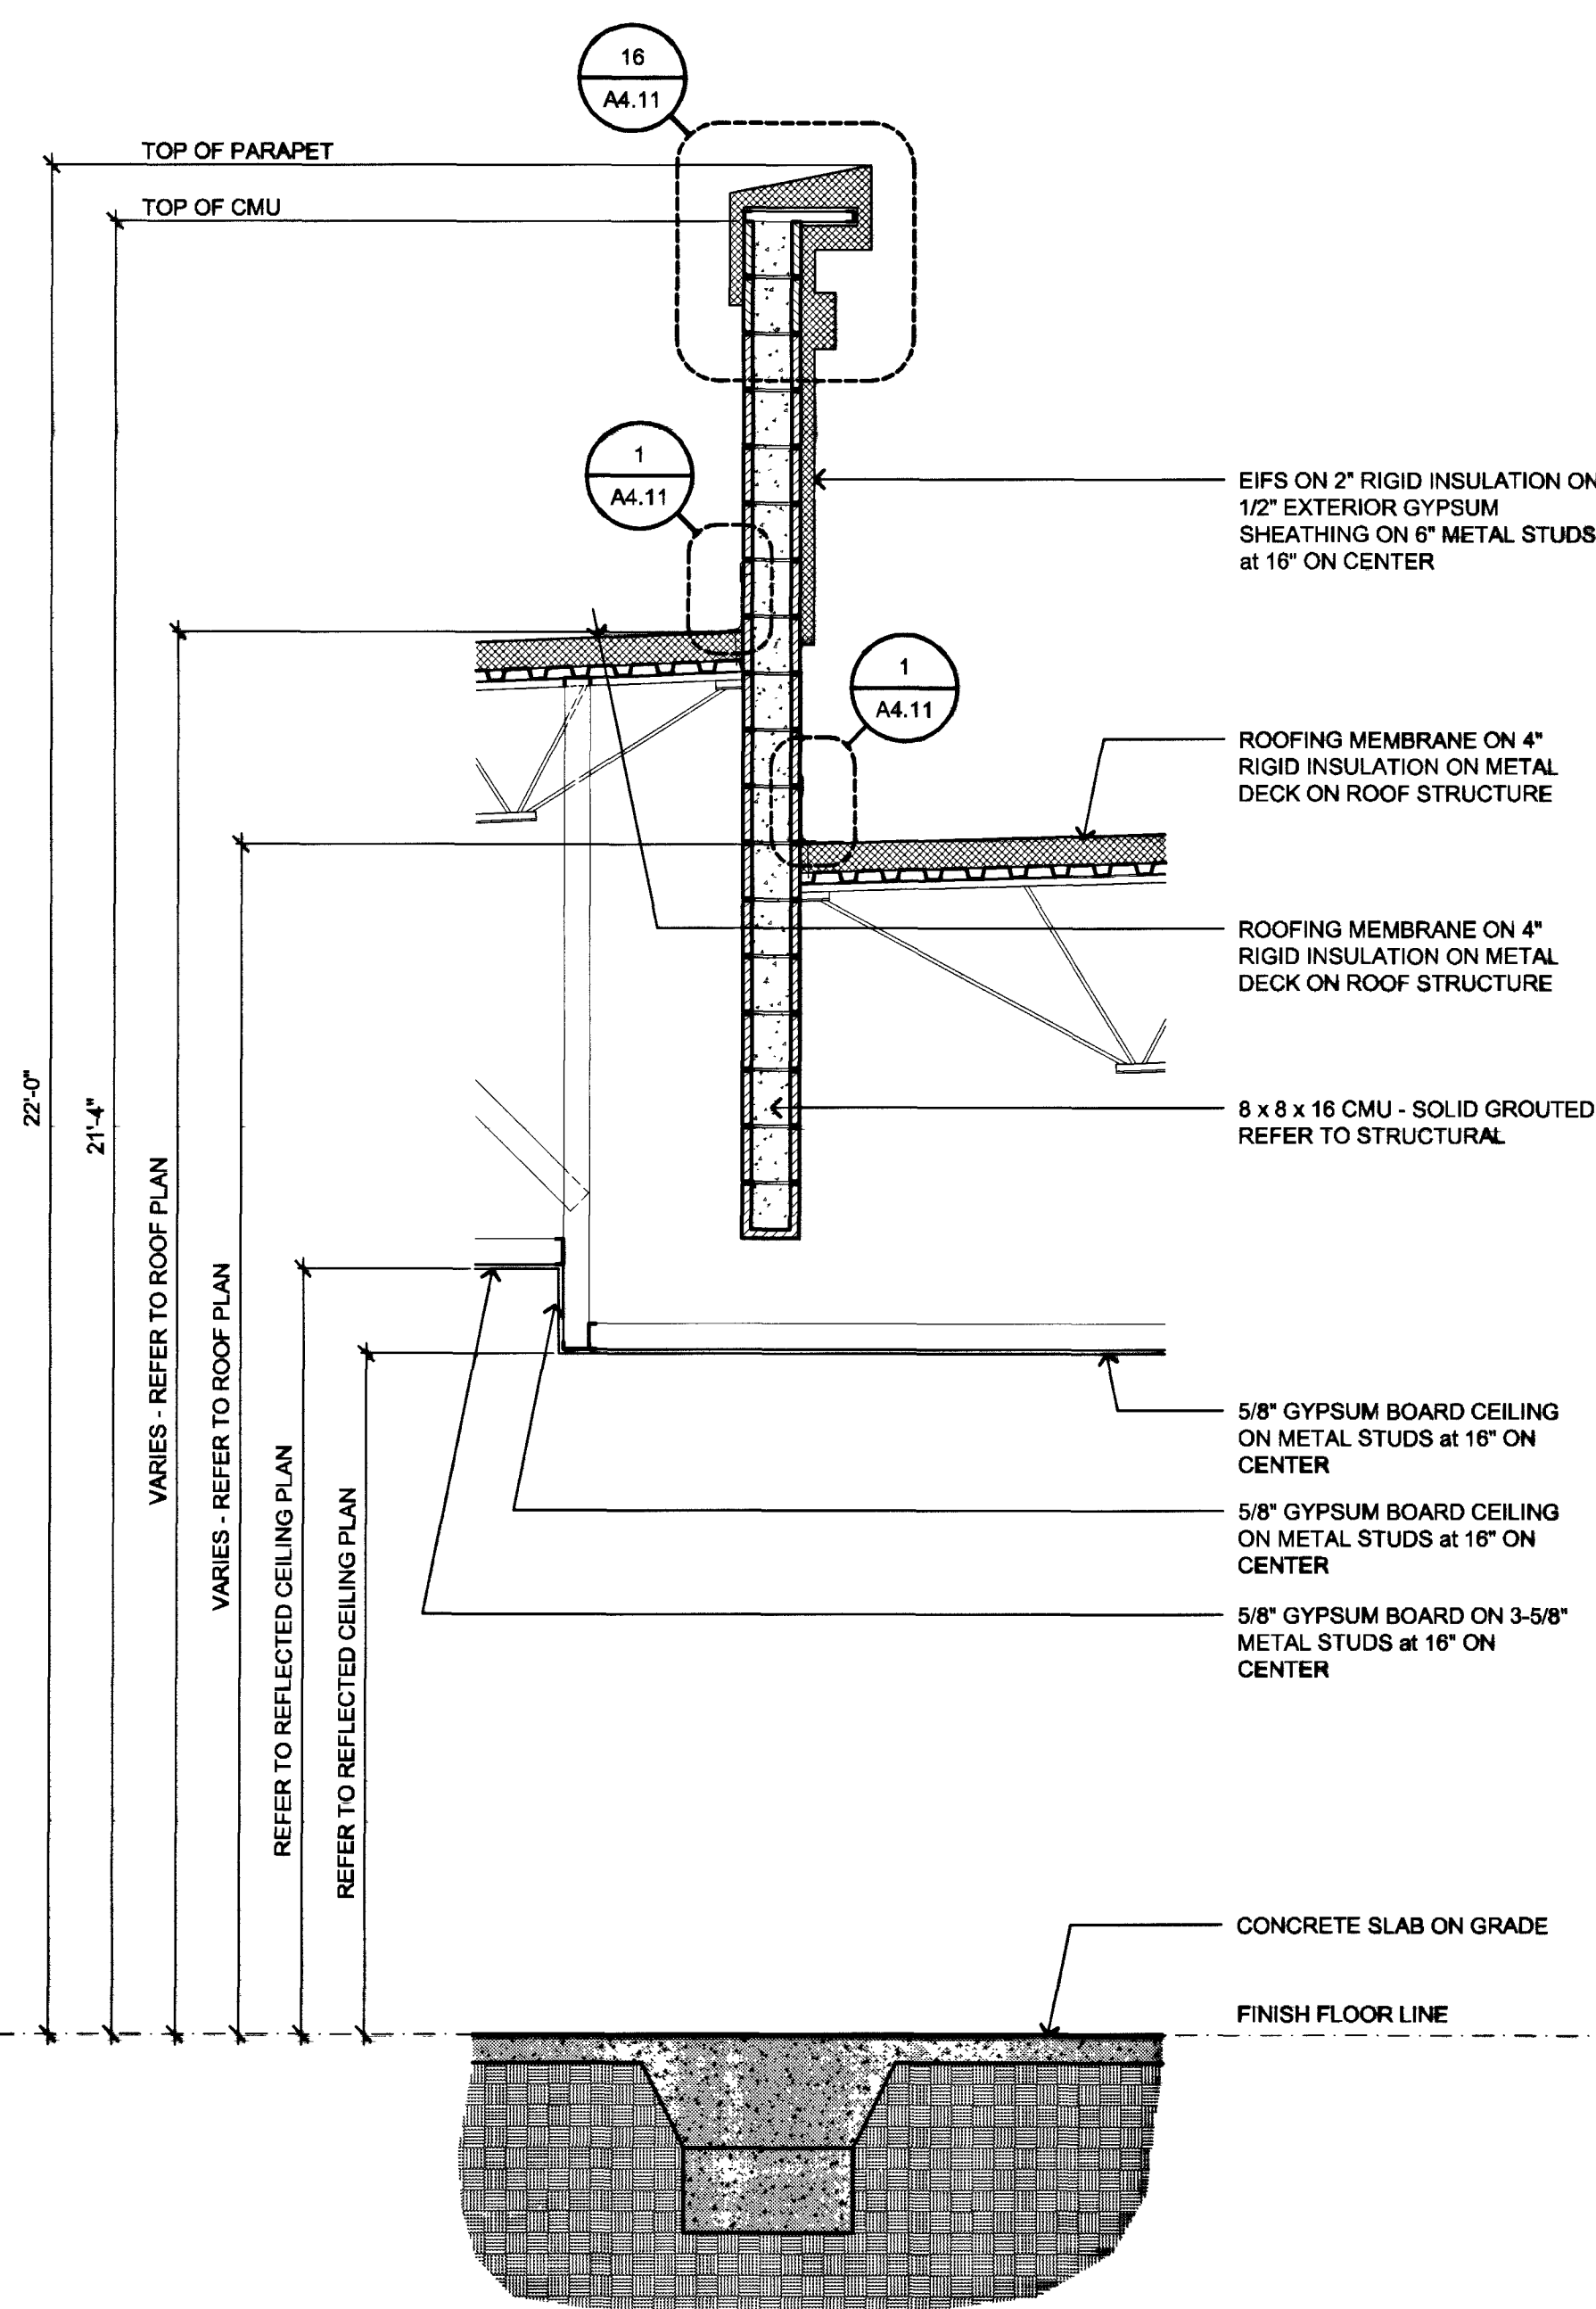



27
WALL SECTION
1/2"=1'-0"

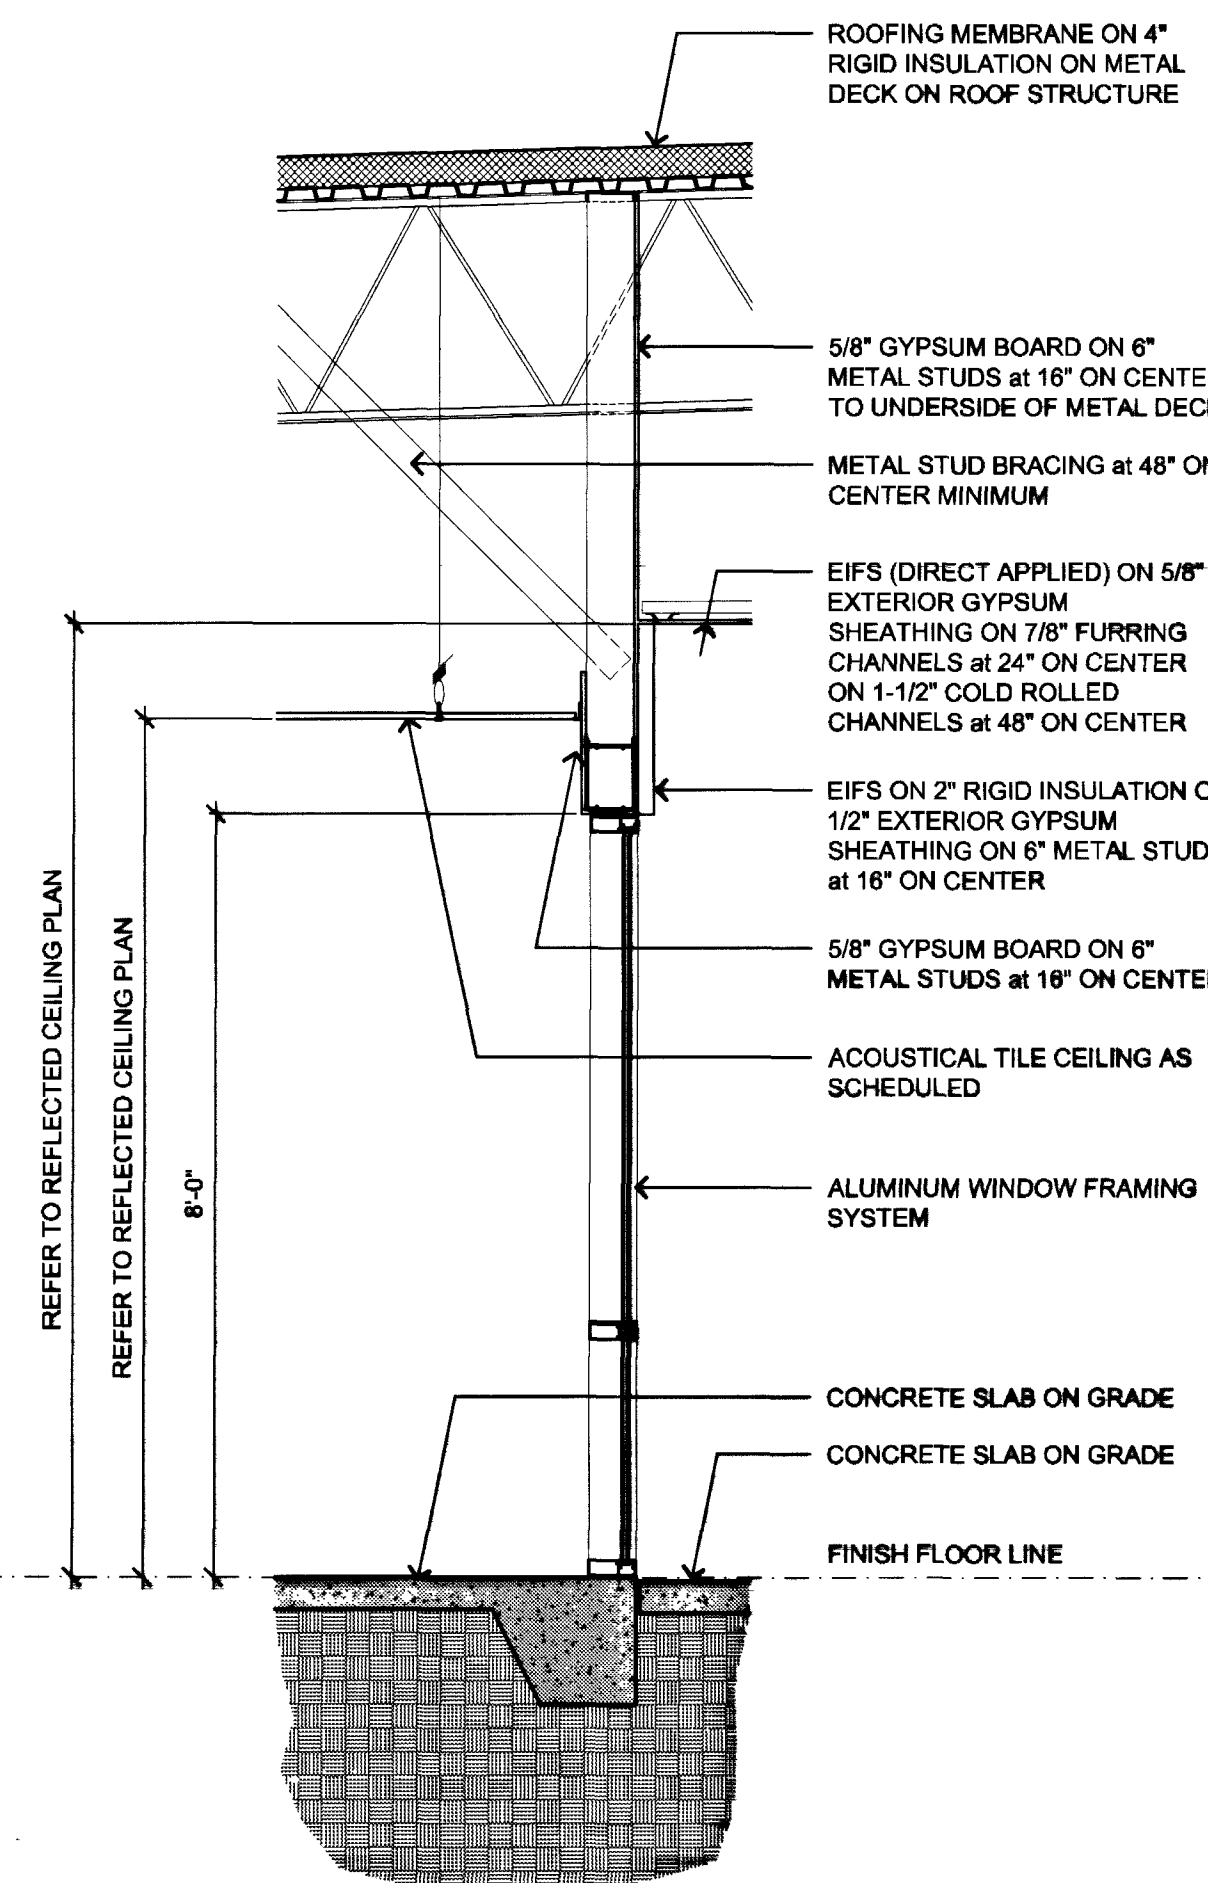


28
WALL SECTION
1/2"=1'-0"

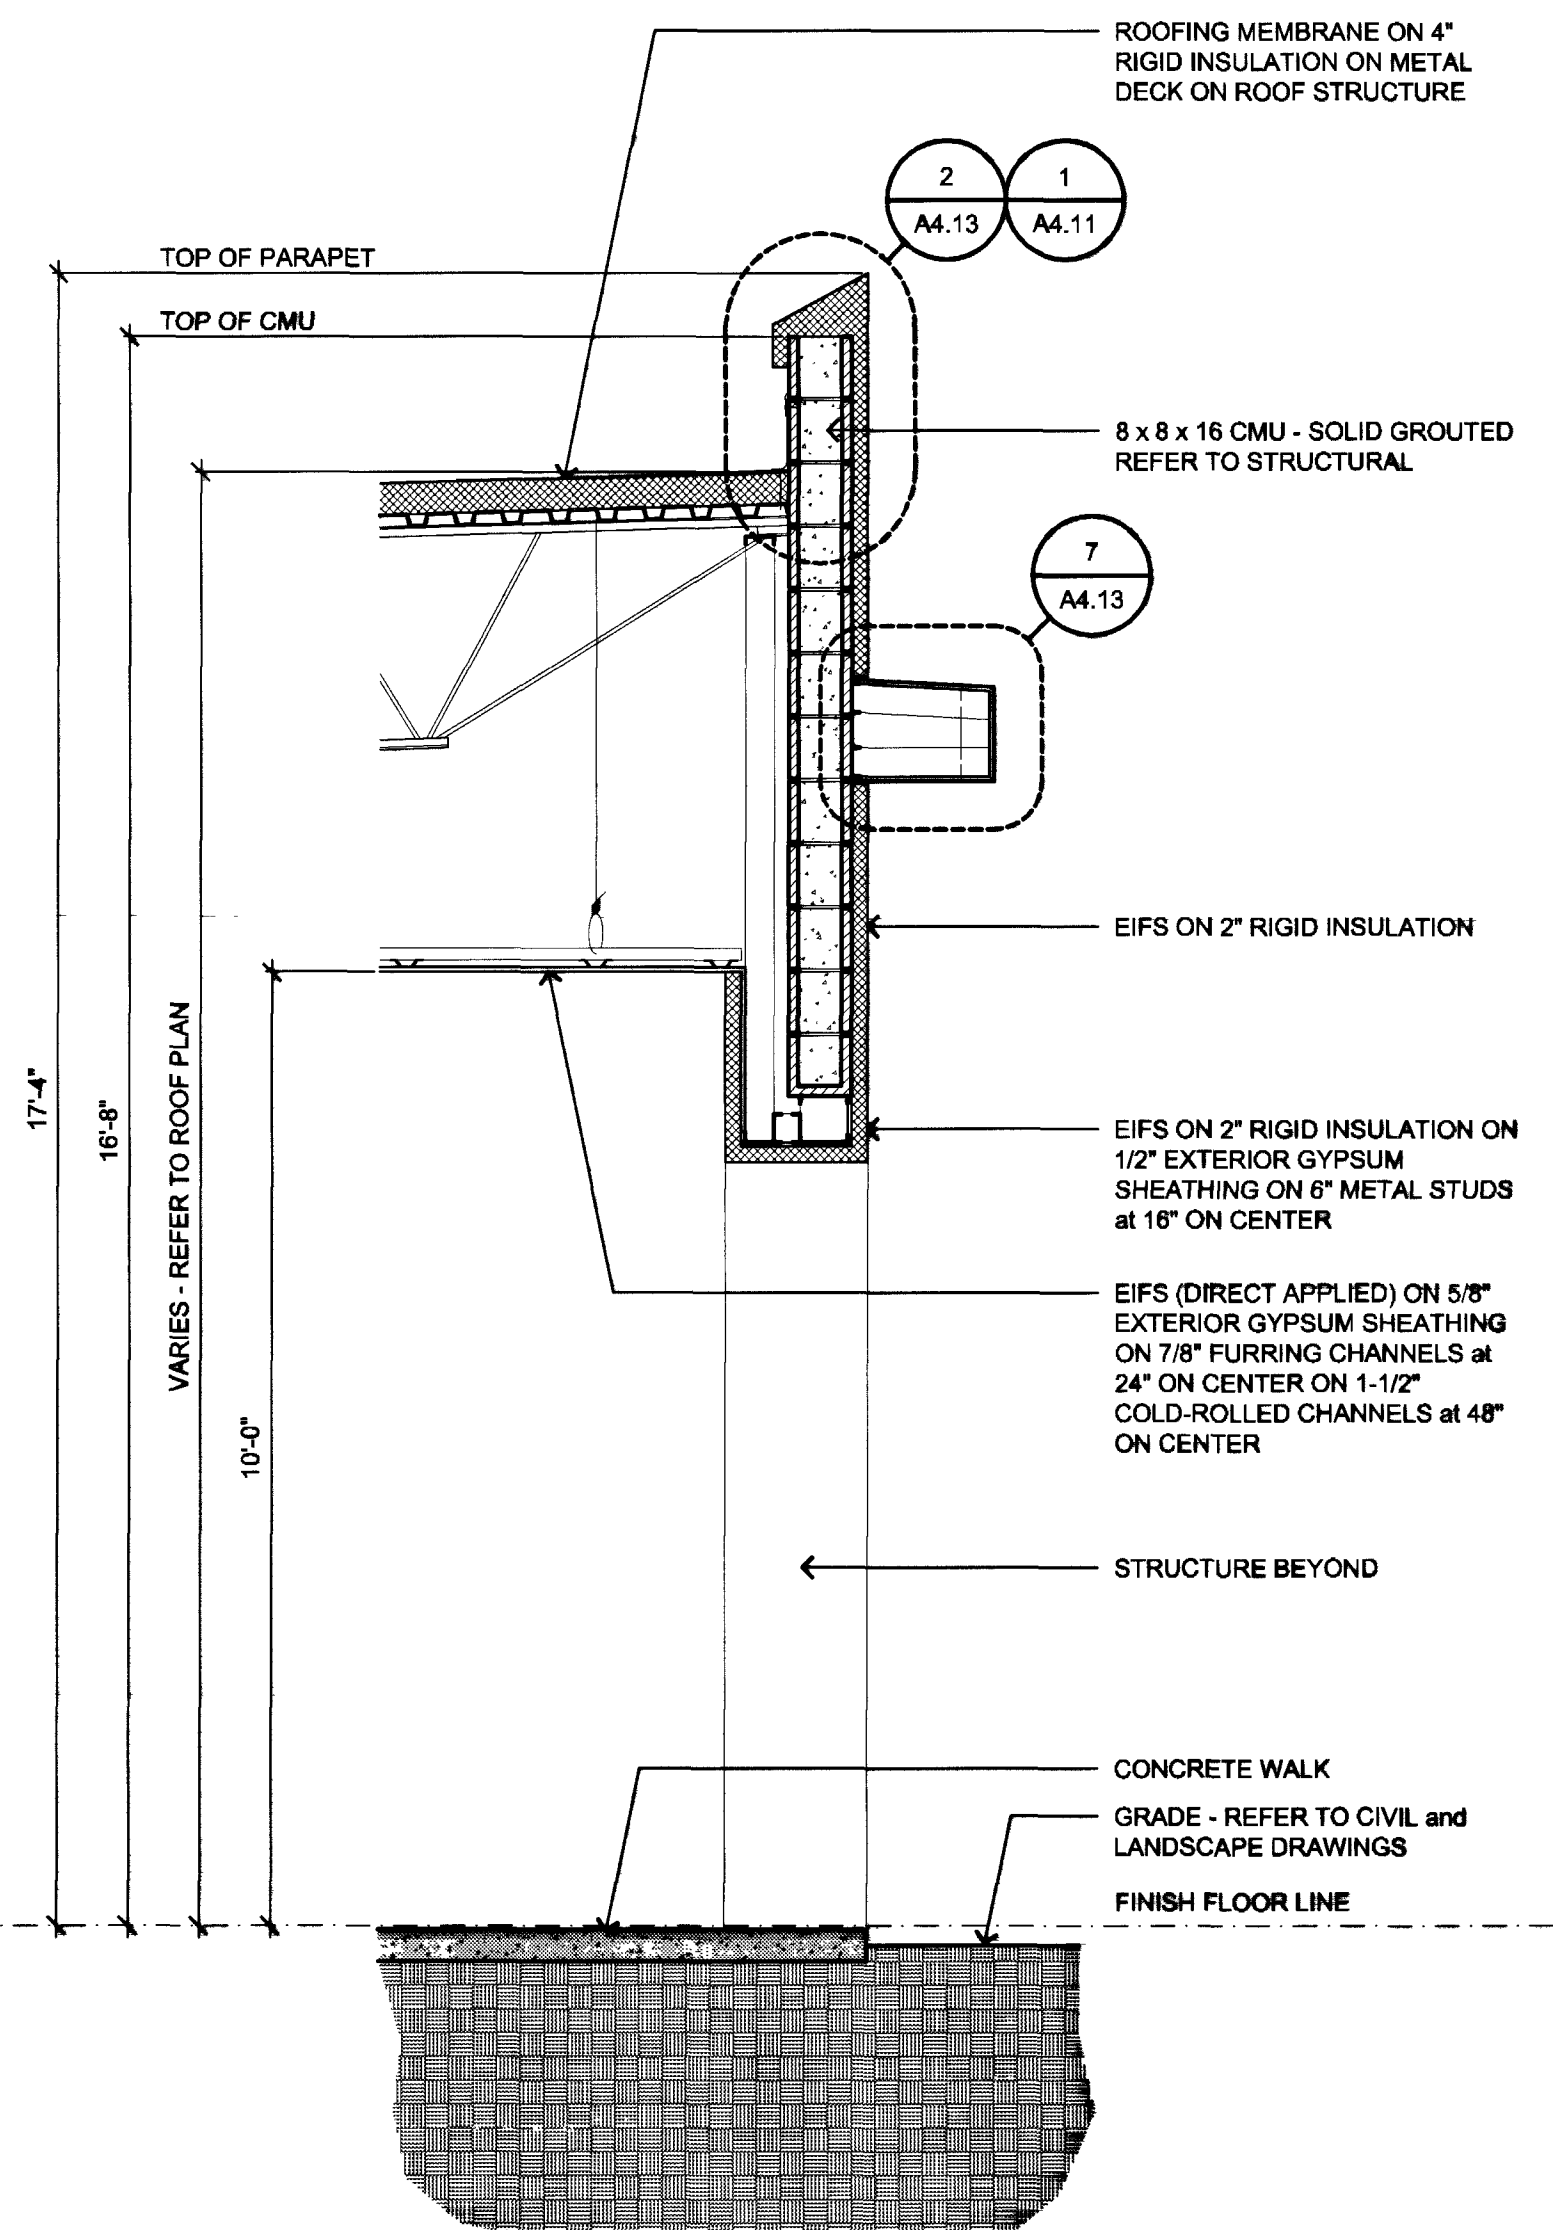

29
WALL SECTION
1/2"=1'-0"

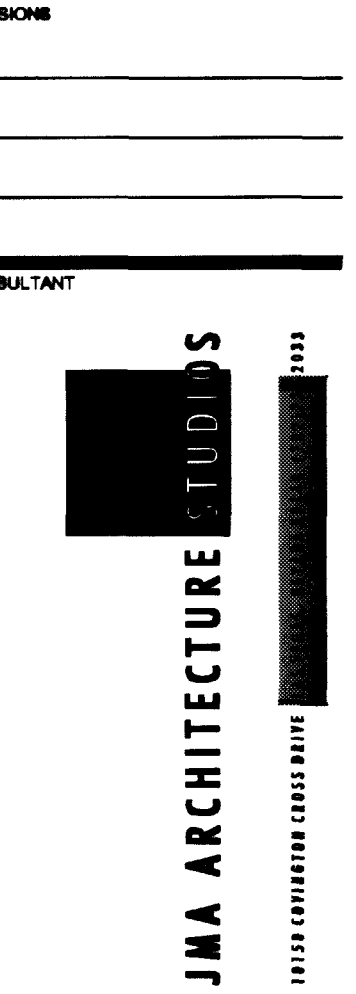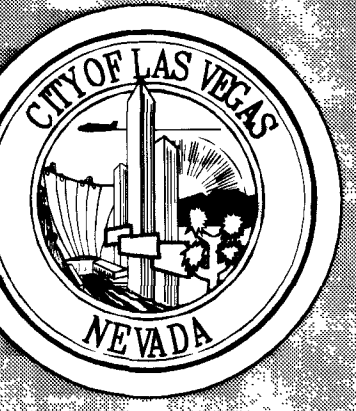

East Las Vegas Community Center
Eastern and Stewart
Construction Documents

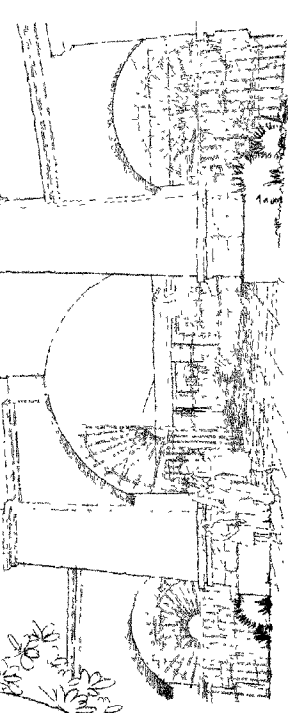

RECORD DRAWING

While this information is believed to be reliable, JMA Architecture, Inc. cannot assume any liability for its accuracy, and the user is responsible for the accuracy of the information shown on this drawing or for any errors or omissions which may have been introduced into this drawing.

OWNER: CITY OF LAS VEGAS
DEPARTMENT OF PUBLIC WORKS
ARCHITECTURAL SERVICES

400 EAST STEWART AVENUE
LAS VEGAS, NEVADA 89101
PHONE: (702) 258-8030
FAX: (702) 258-8030
TDD: (702) 258-8030

DATE: M. Phillips

FILE

DATE: August 2, 2001

SCALE

NO. 01.15301.22

CL. 521.268

DATE

A7.07