



REVISIONS

DATE

BY

DESCRIPTION

1

2


74

75


76

77

78

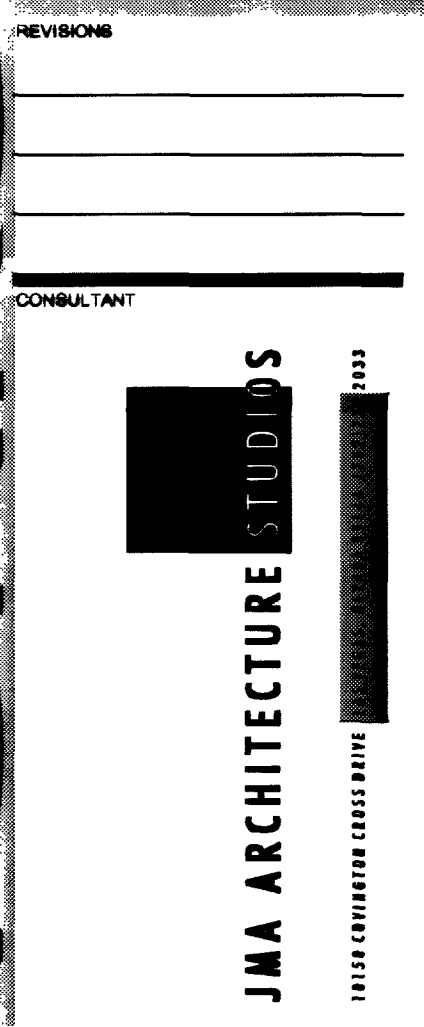

DEPARTMENT OF PUBLIC WORKS
East Las Vegas Community Center
Eastern and Stewart
Construction Documents

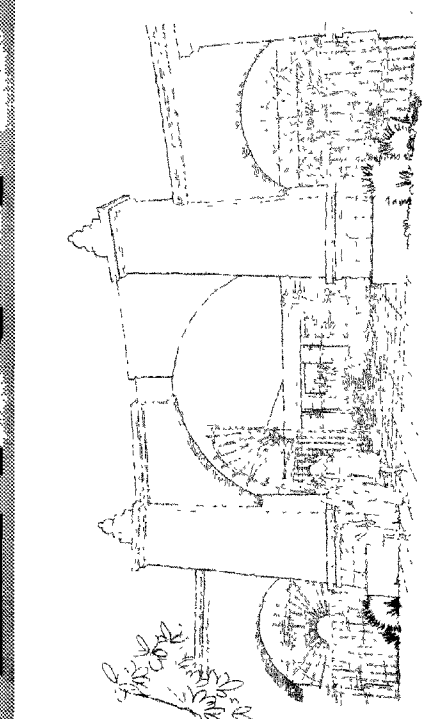

STAMP

RECORD DRAWING

The record drawing shall be prepared by the contractor.

While this information is believed to be reliable, JMA Architecture Studios, cannot make its accuracy, and does not accept responsibility for the accuracy of the record drawing or for any errors or omissions which may have been incorporated into the record.

These notes on this record drawing are added to obtain independent verification of the accuracy before printing the record drawing.

OWNER: CITY OF LAS VEGAS
DEPARTMENT OF PUBLIC WORKS
ARCHITECTURAL SERVICES

400 EAST STEWART AVENUE
LAS VEGAS, NEVADA 89101
PHONE: (702) 258-3030
TDD: (702) 388-9108

OWNER: M. Phillips

DATE: August 2, 2001

SCALE:

NO. 01.15301.22

ISSUE NO. 521-268

DATE:

DATE:


DATE:

DATE: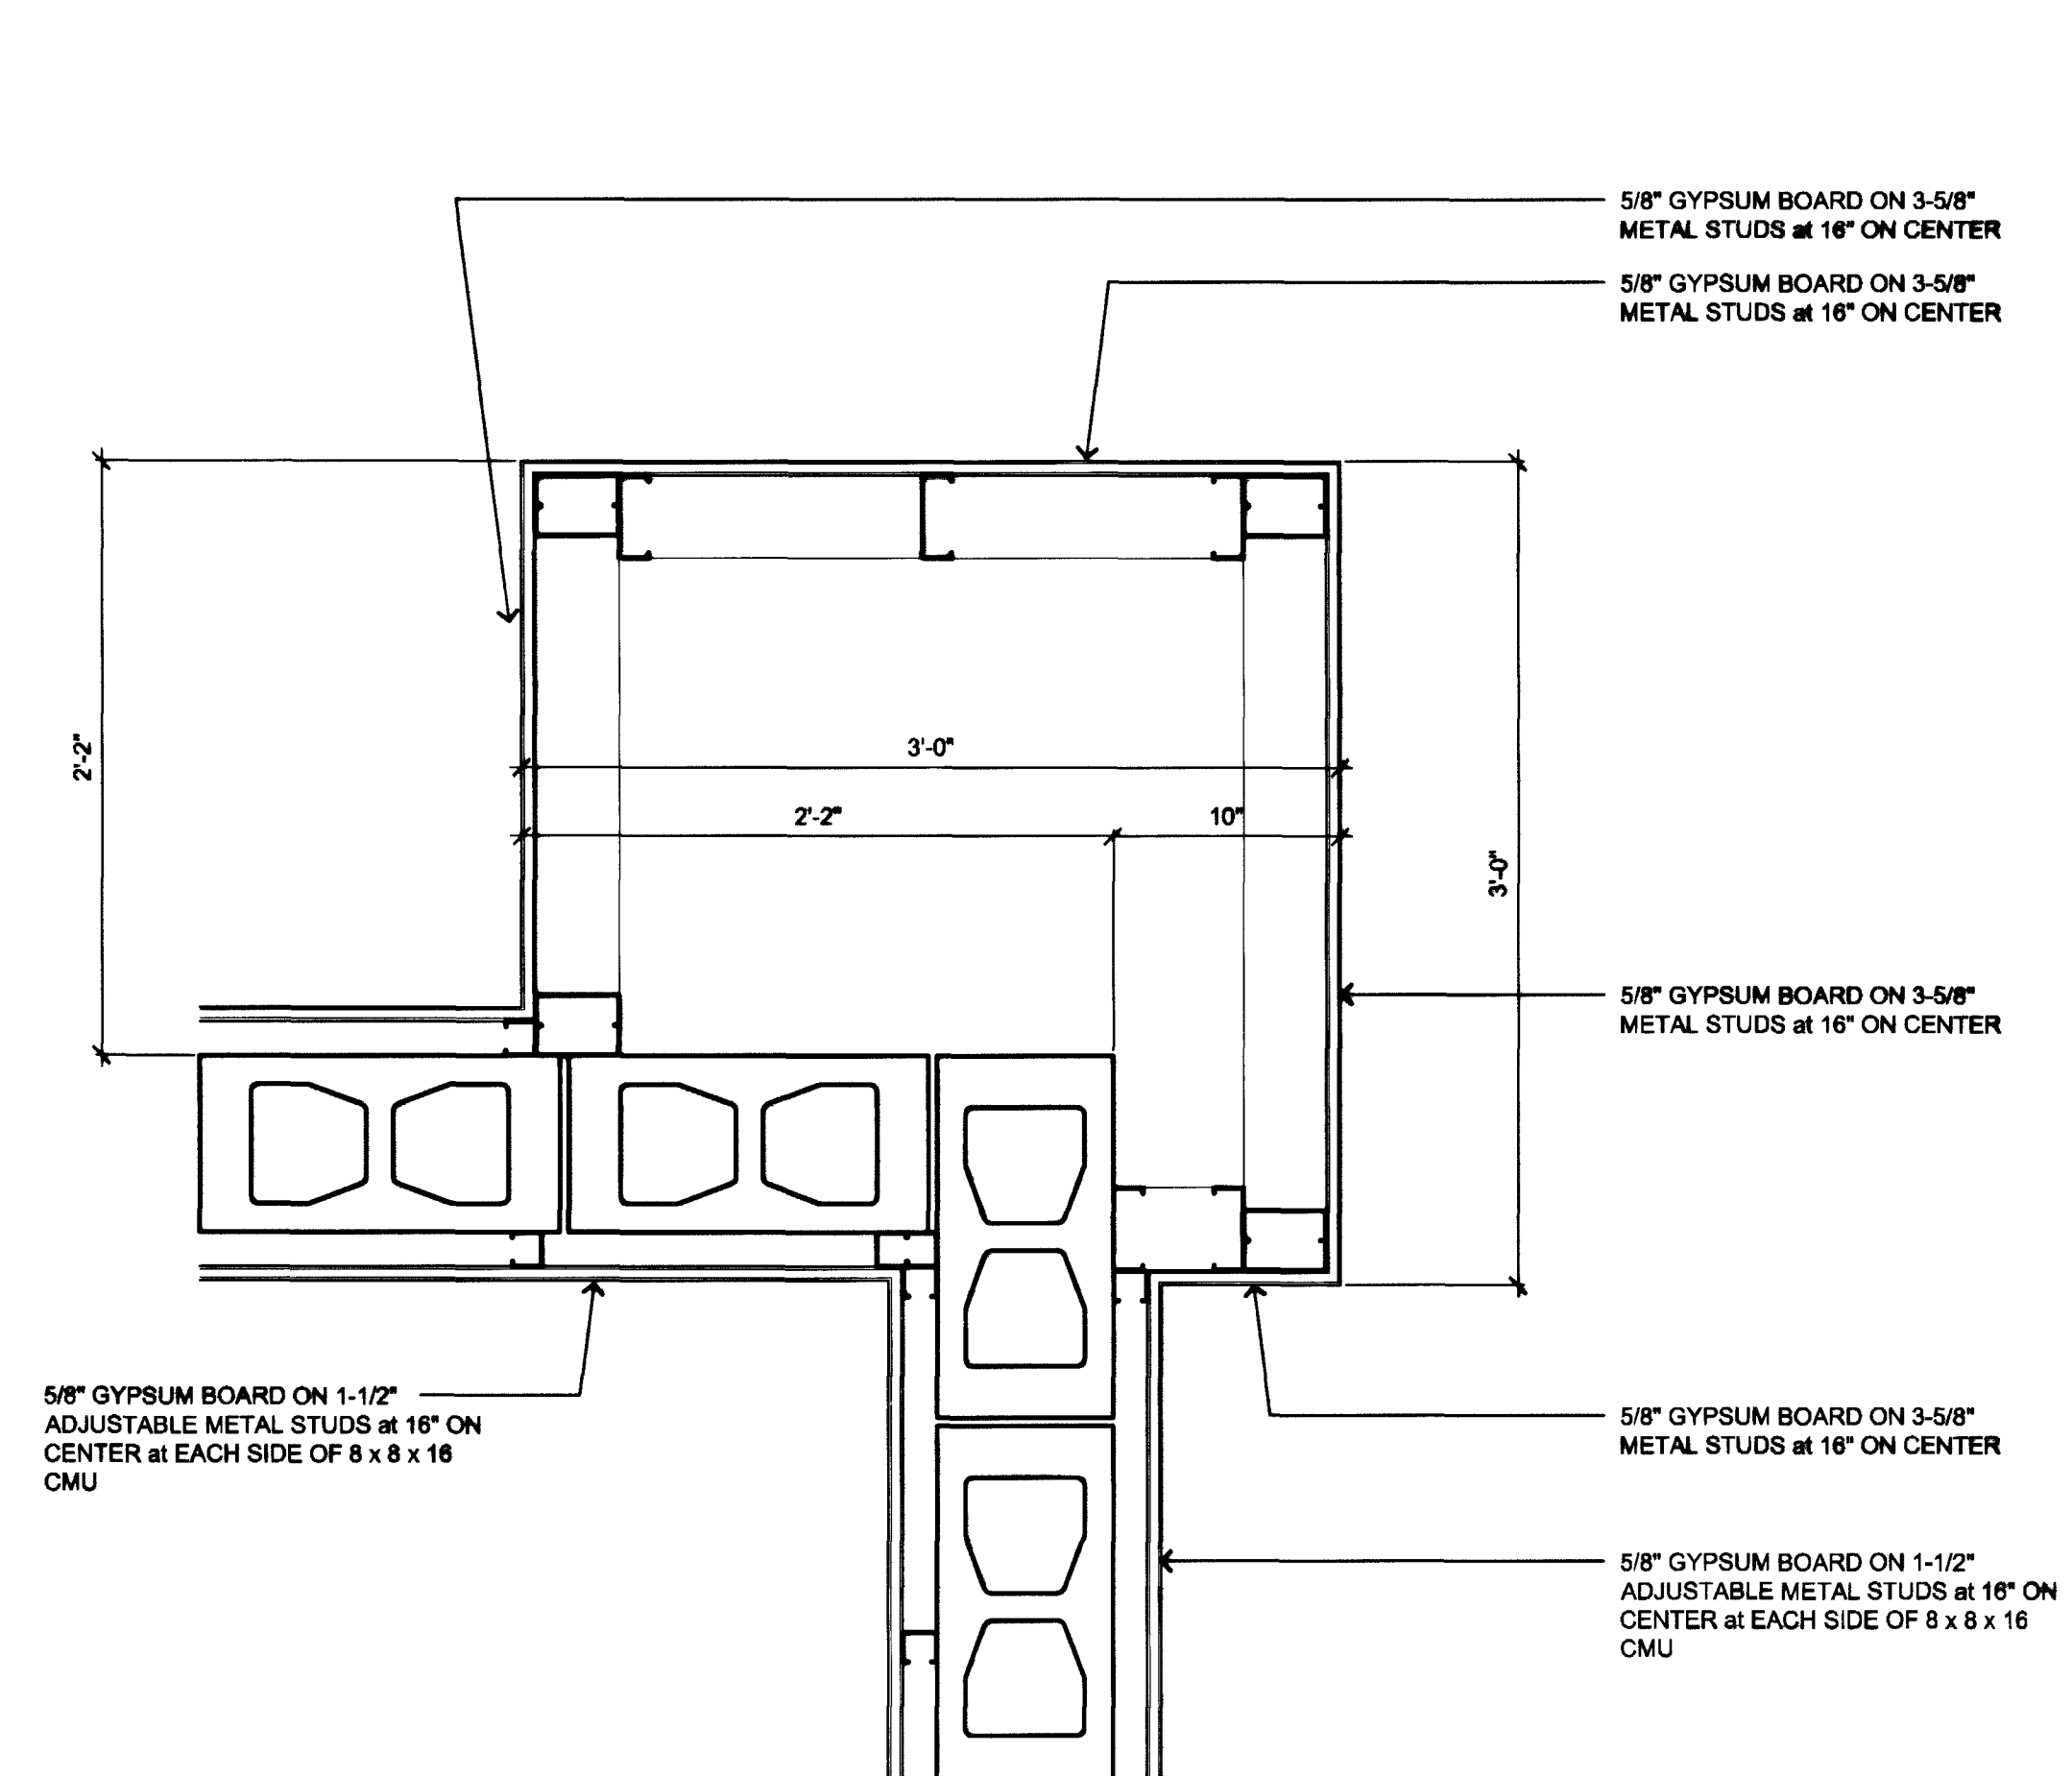


3 WALL DETAIL
1 1/2"=1'-0"

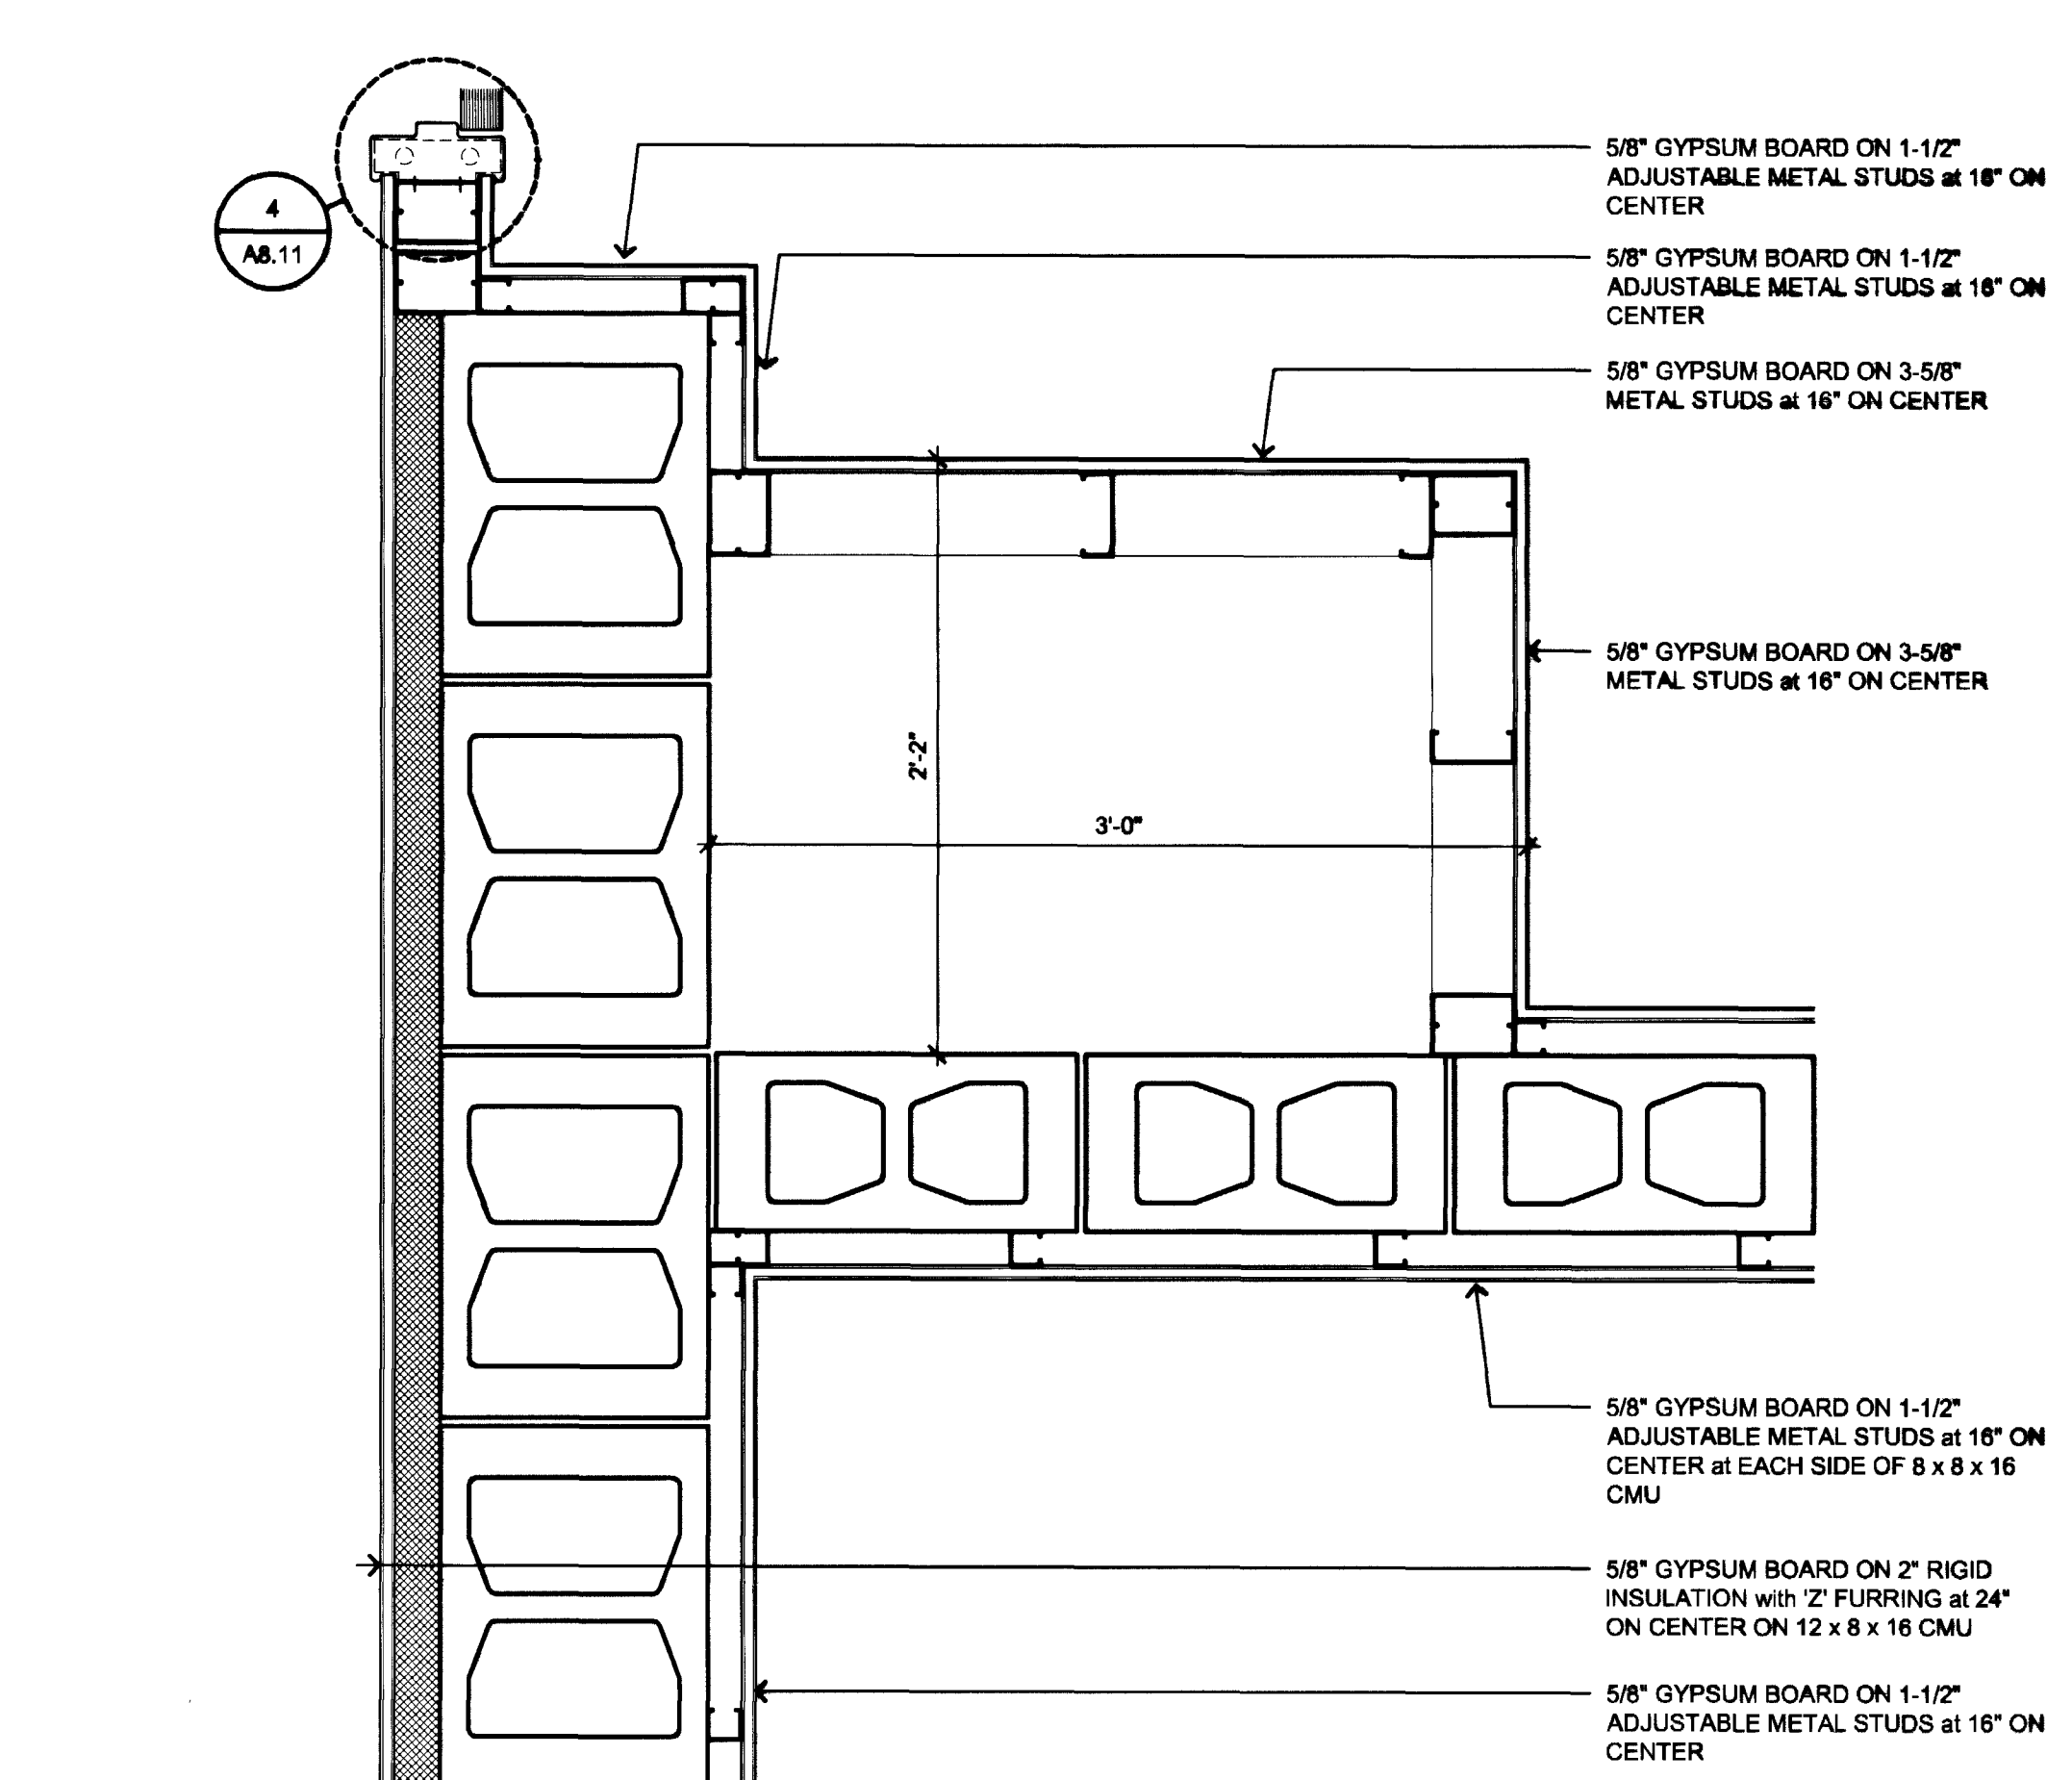


2 WALL DETAIL
1 1/2"=1'-0"

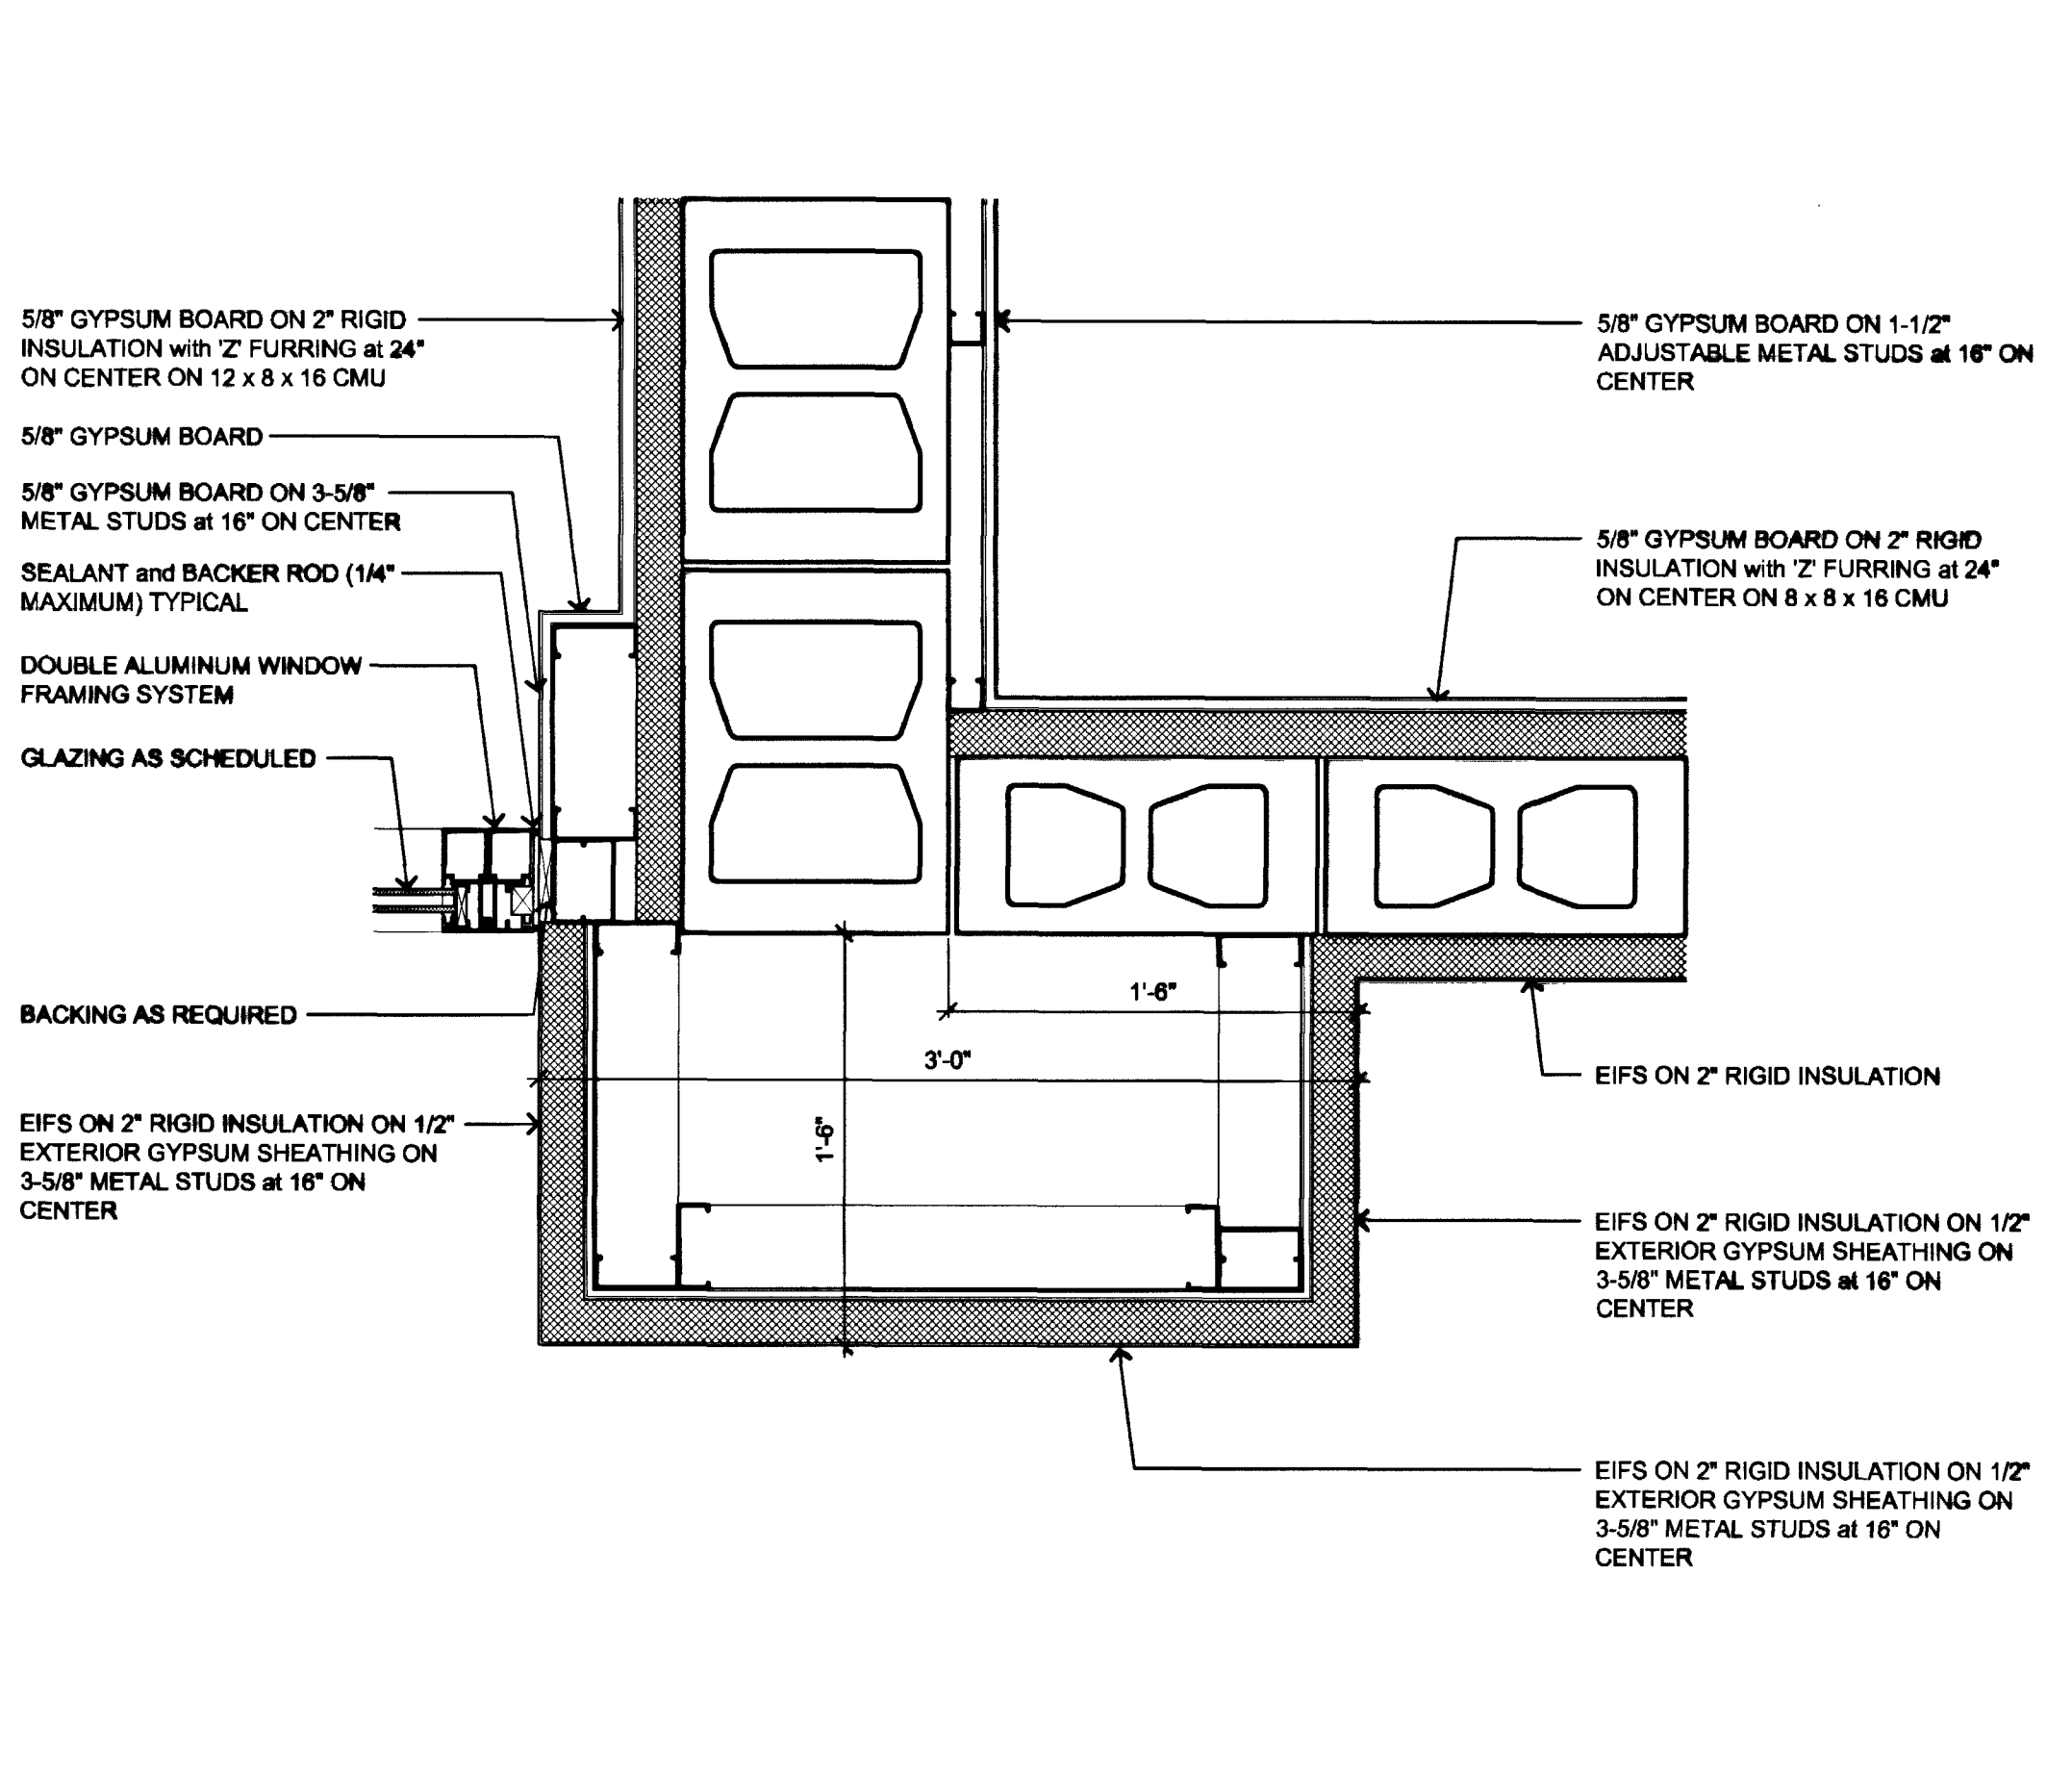


1 WALL DETAIL
1 1/2"=1'-0"

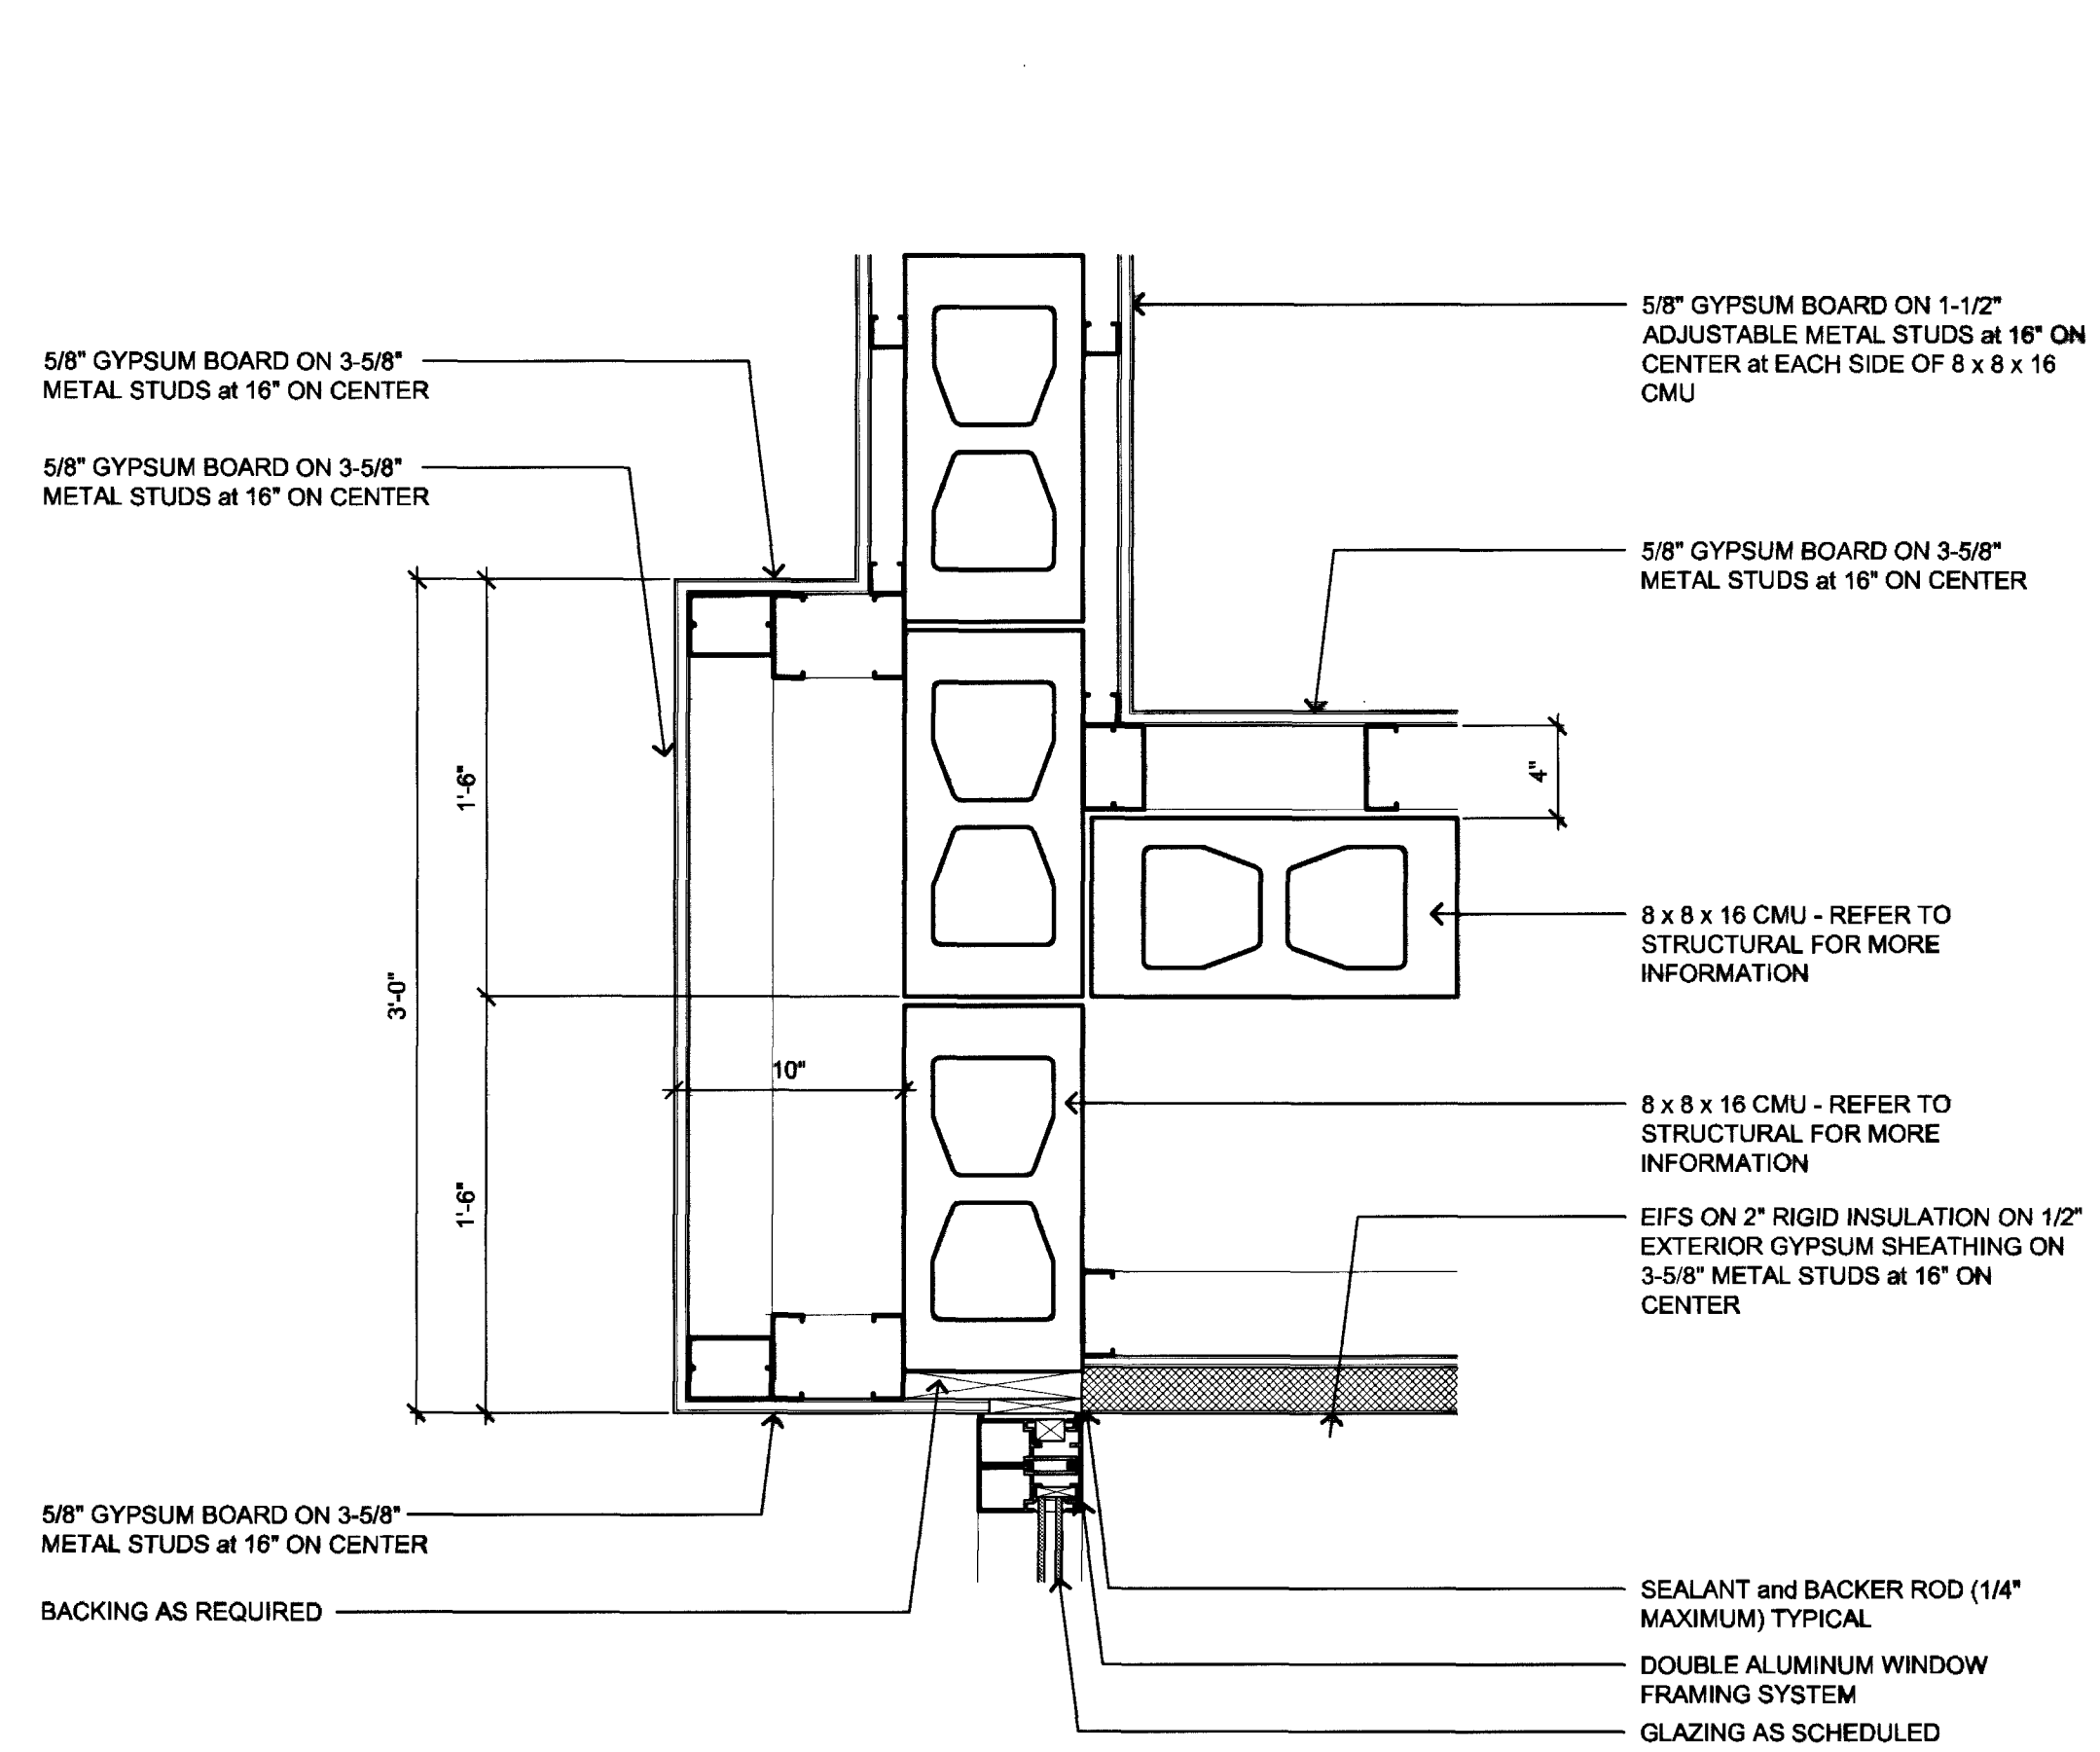


6 WALL DETAIL
1 1/2"=1'-0"

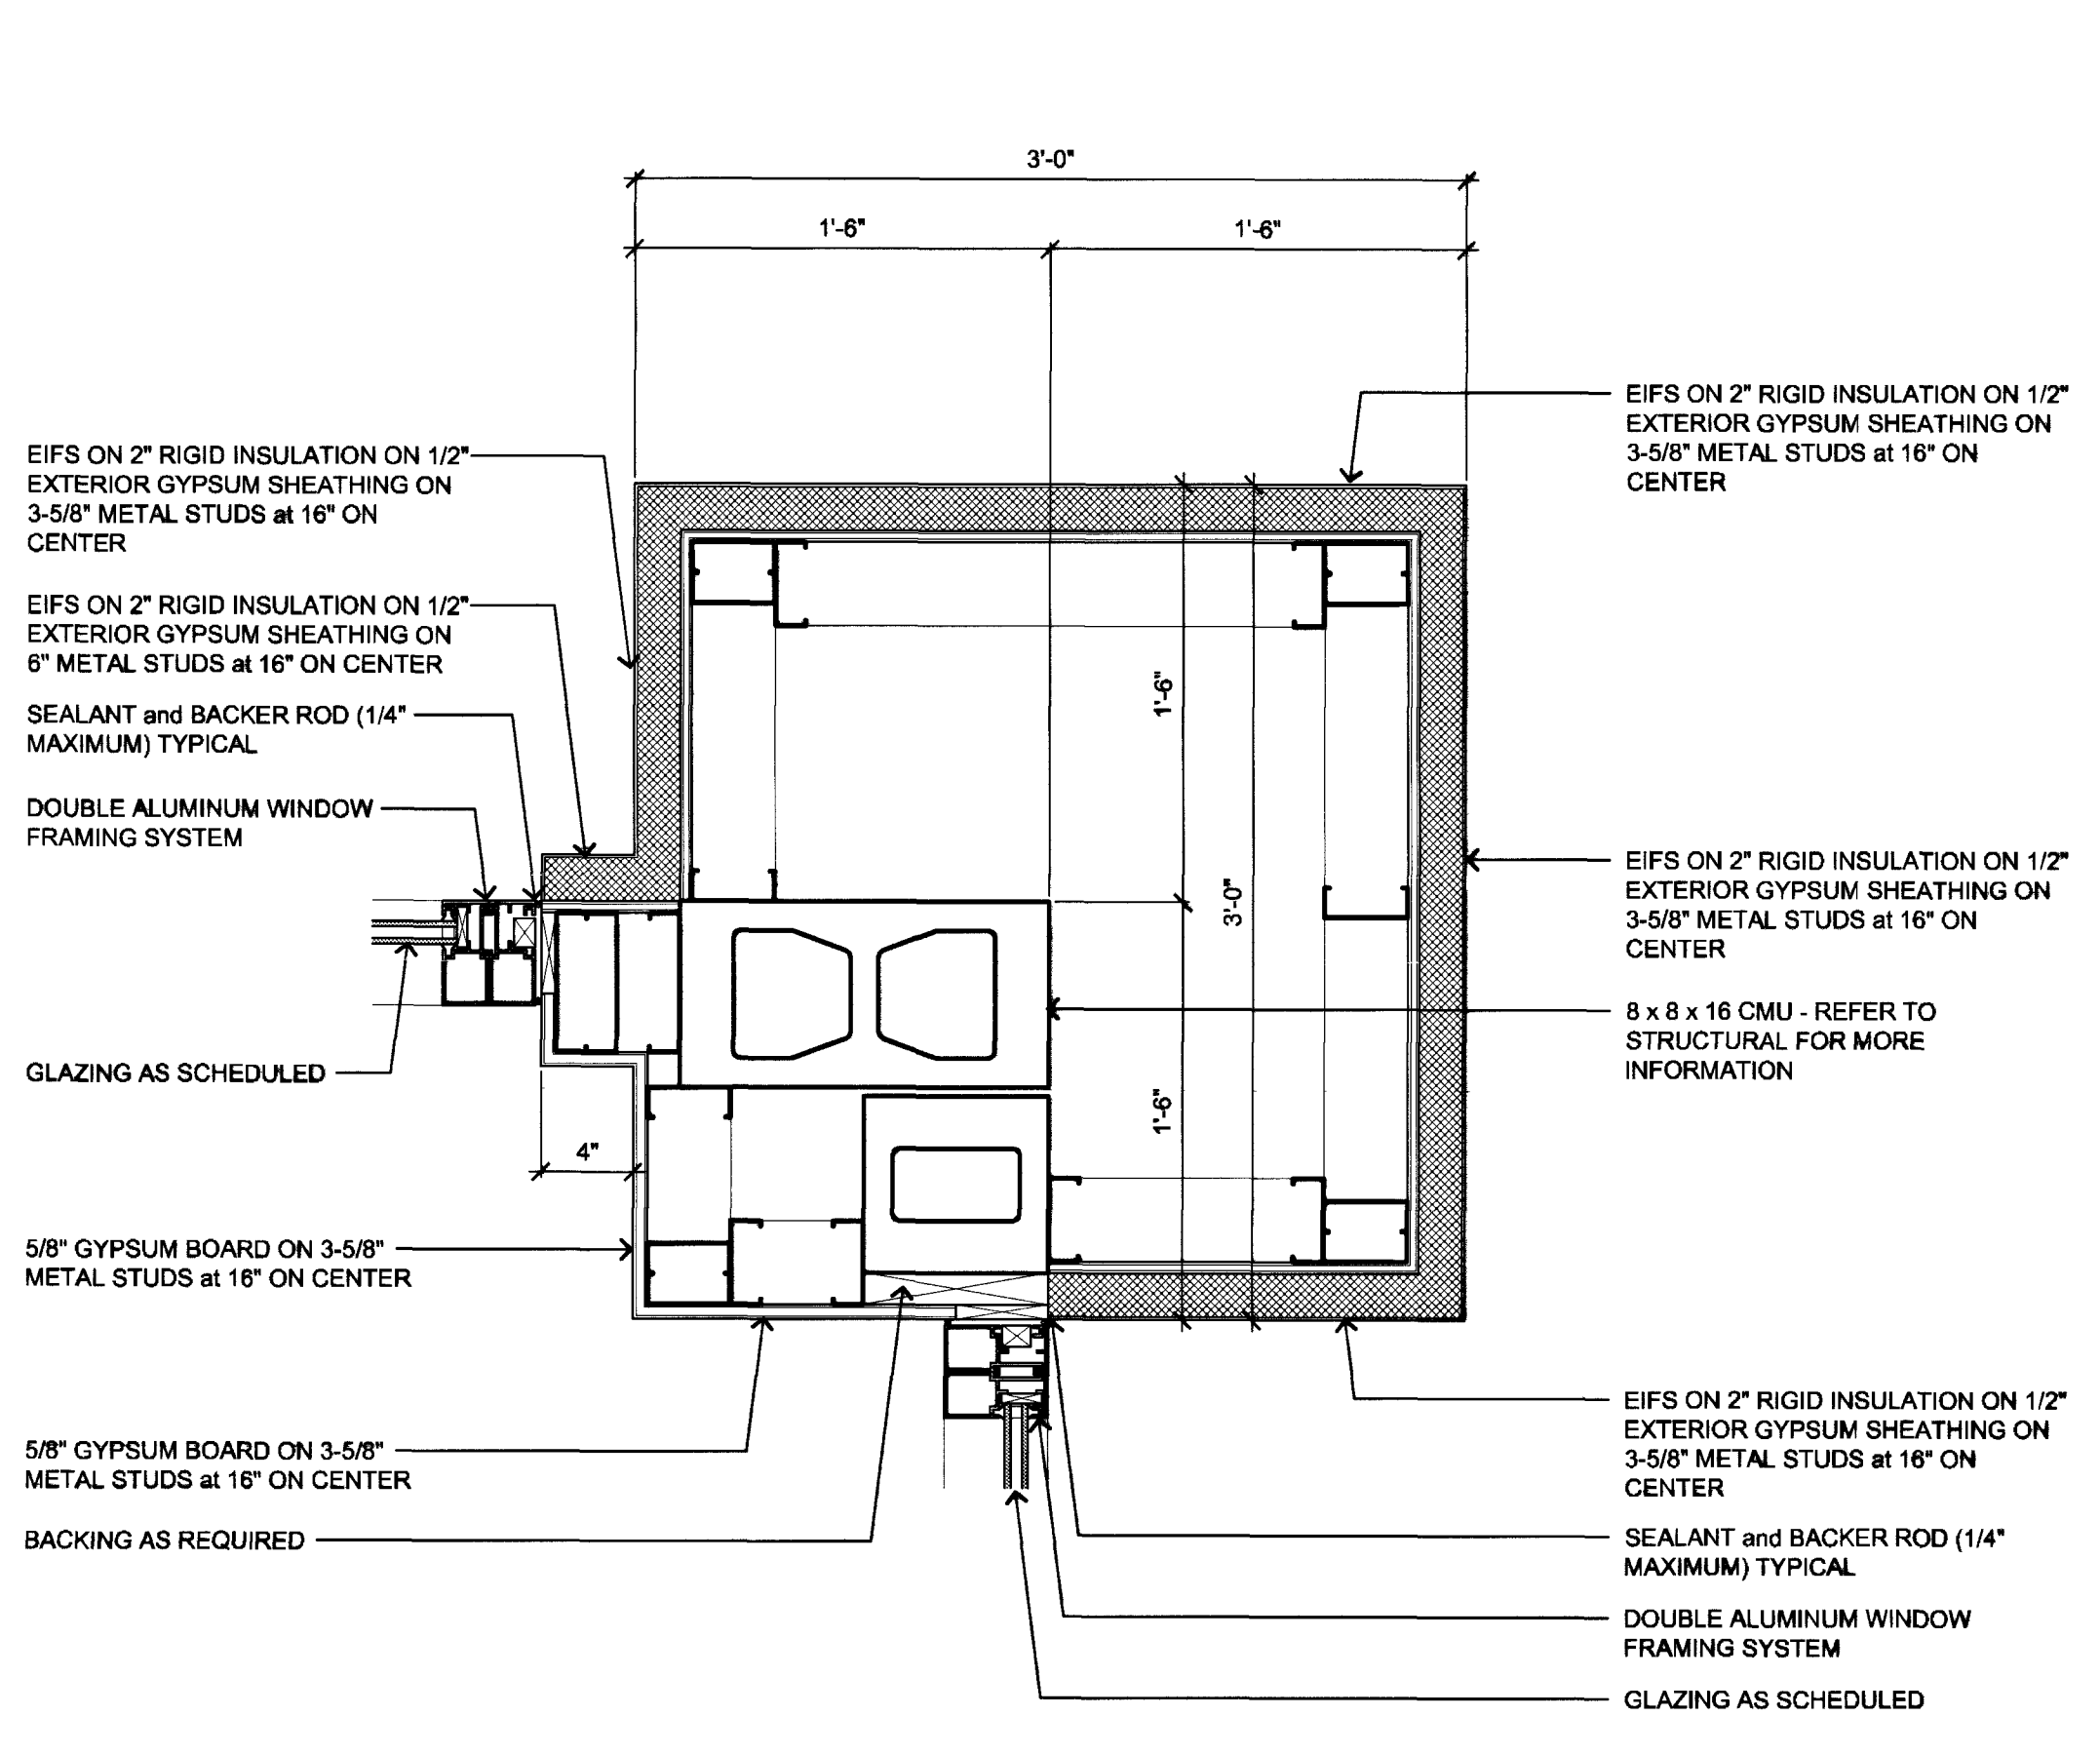


5 WALL DETAIL
1 1/2"=1'-0"

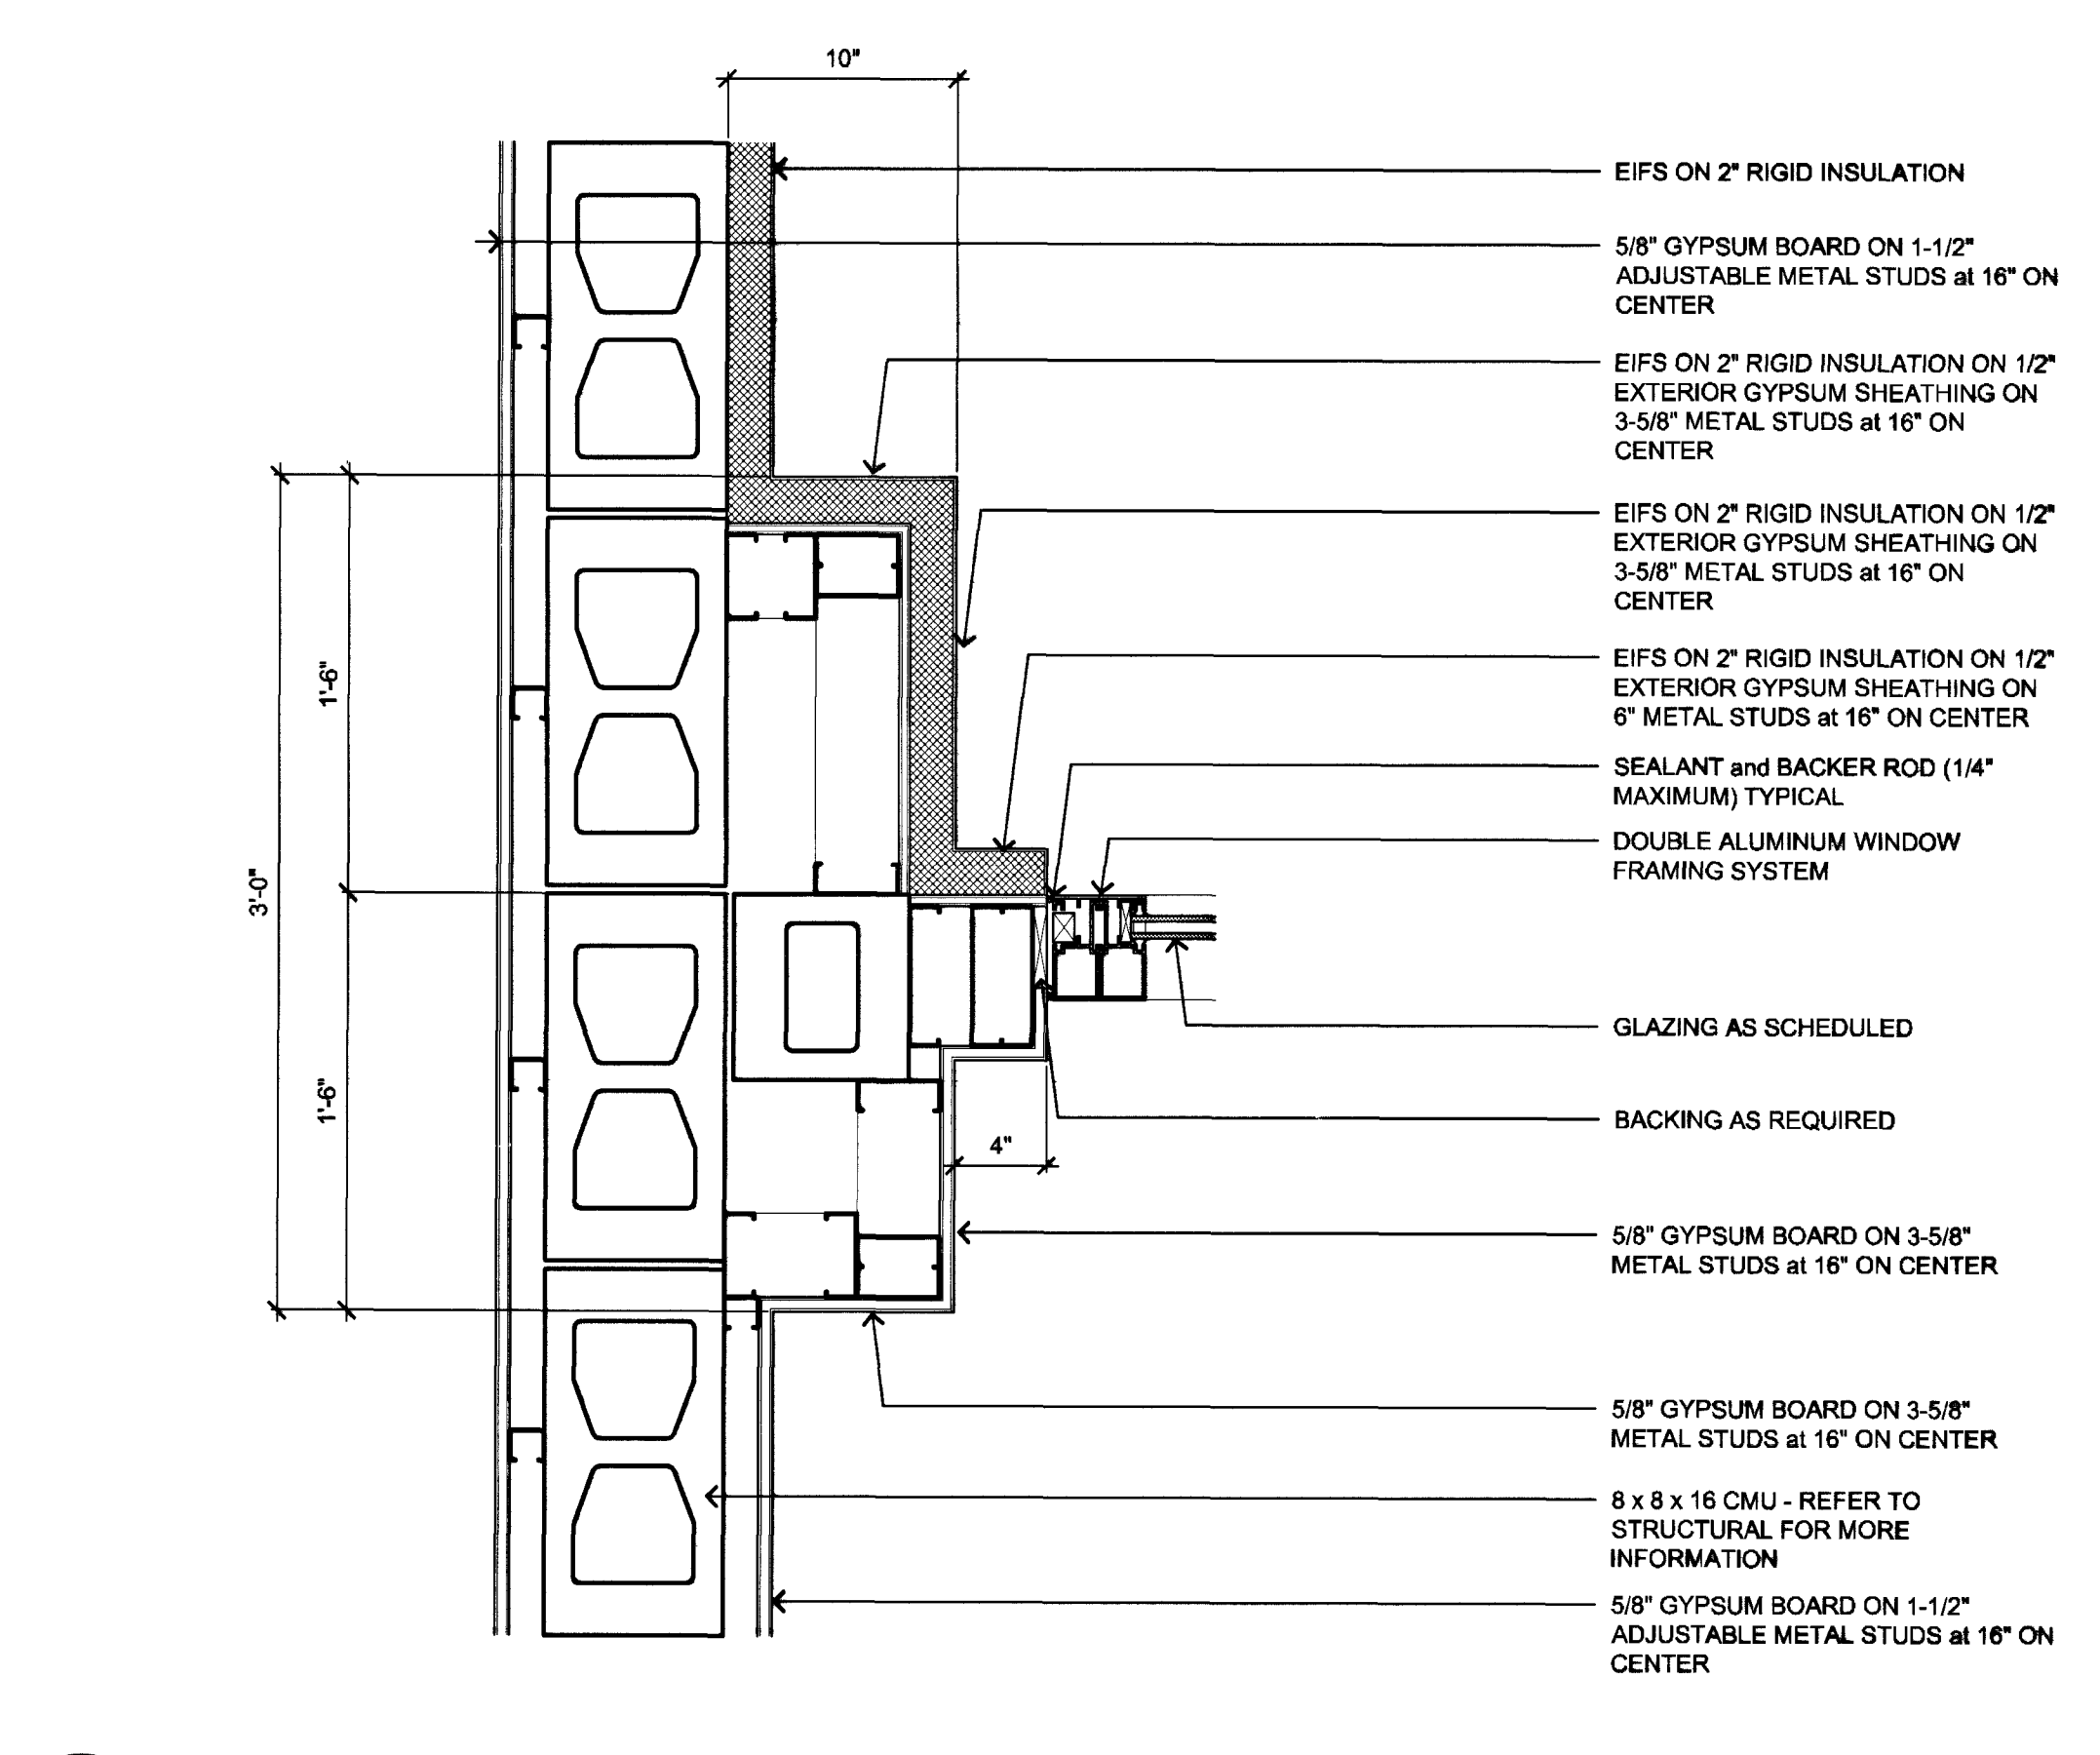


4 WALL DETAIL
1 1/2"=1'-0"

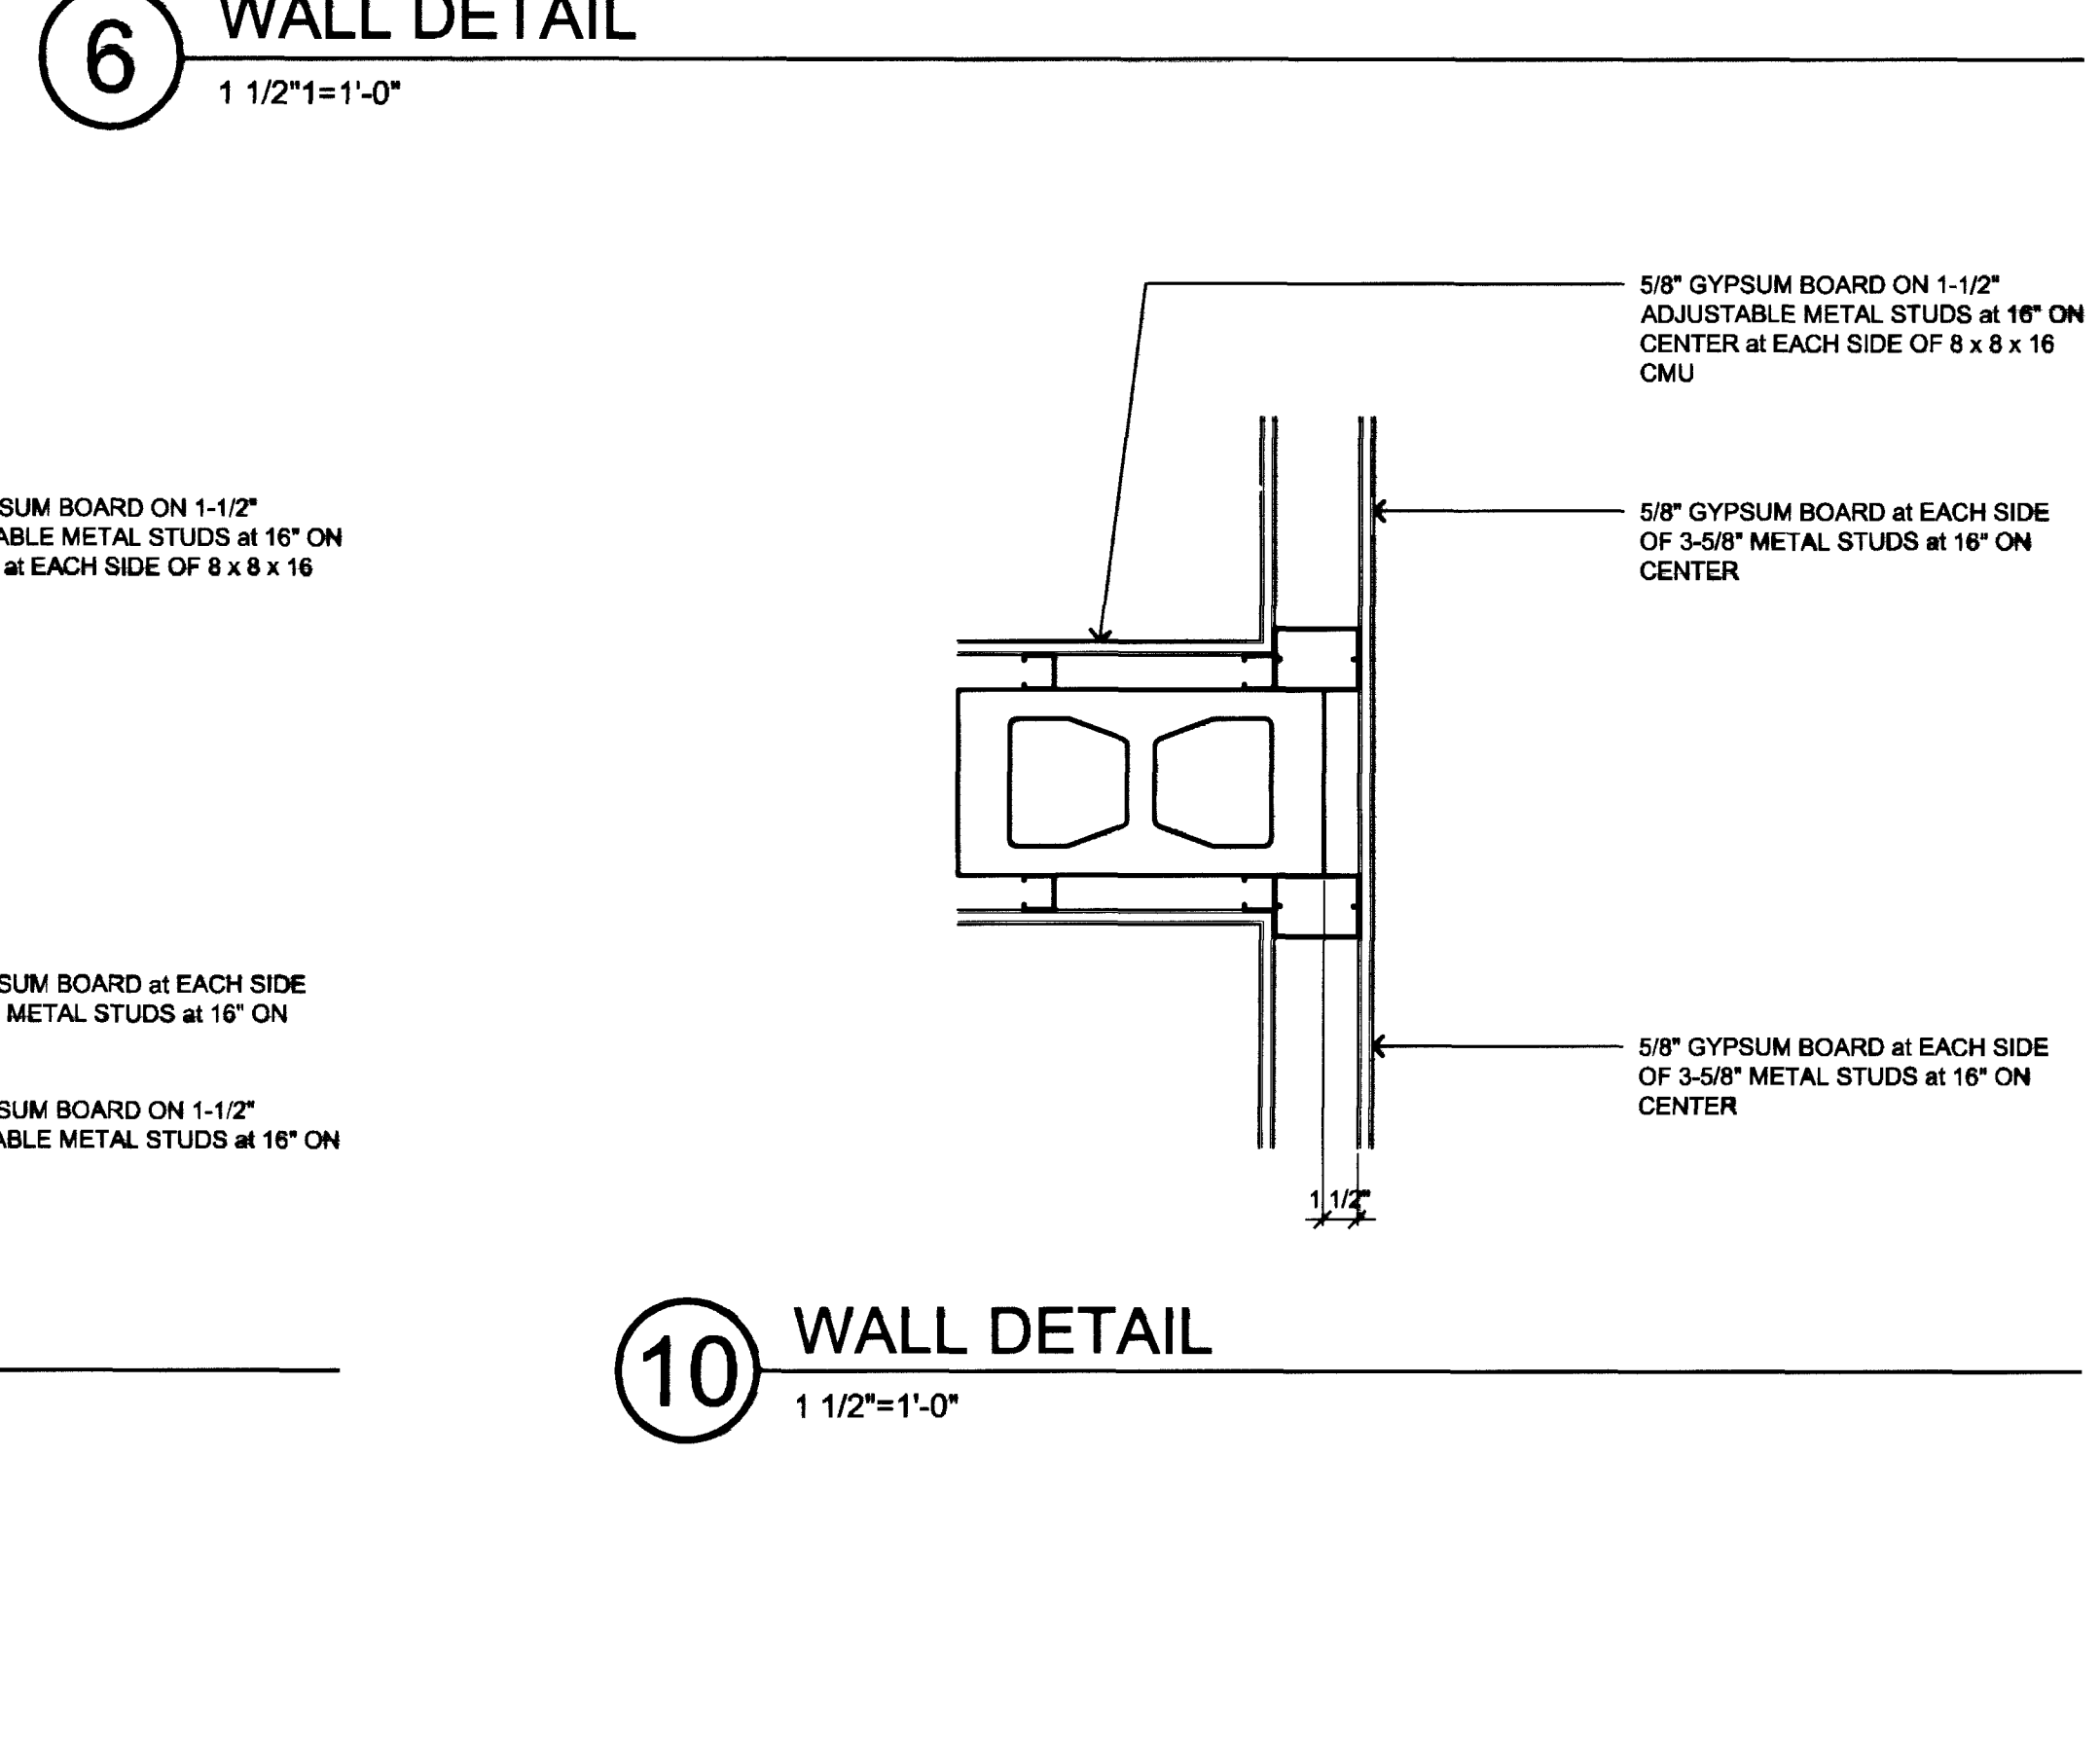


10 WALL DETAIL
1 1/2"=1'-0"

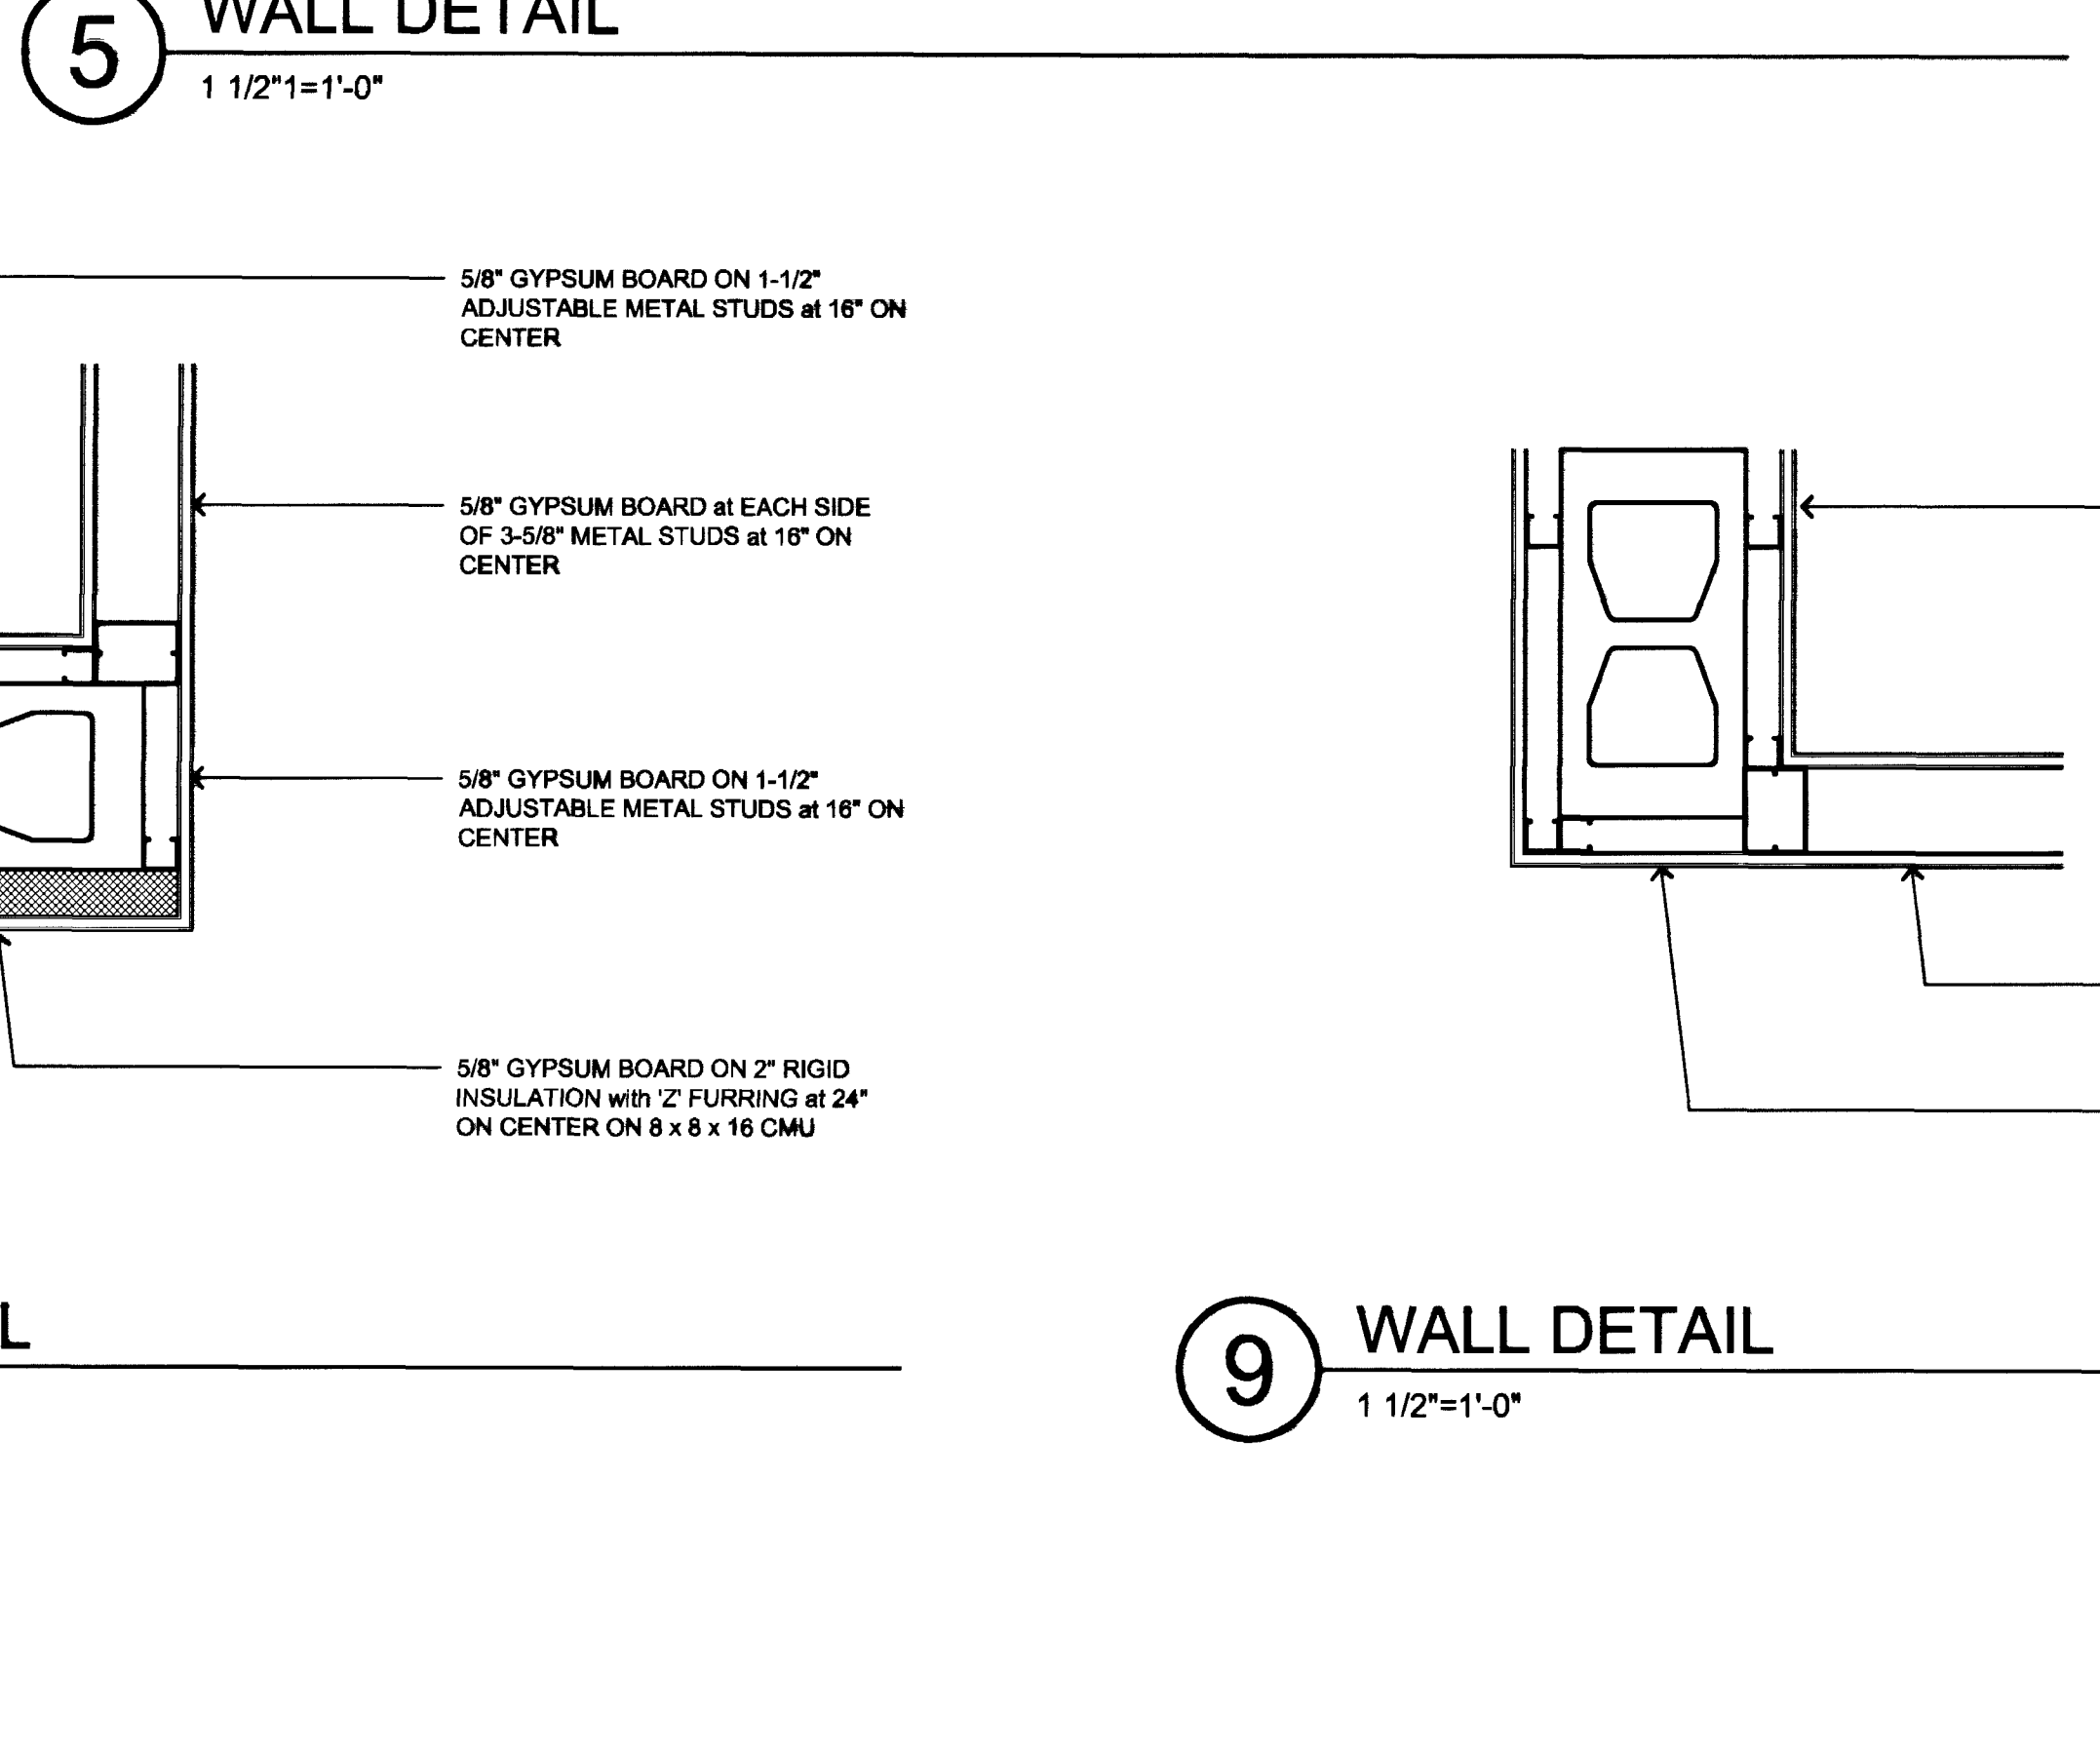


9 WALL DETAIL
1 1/2"=1'-0"

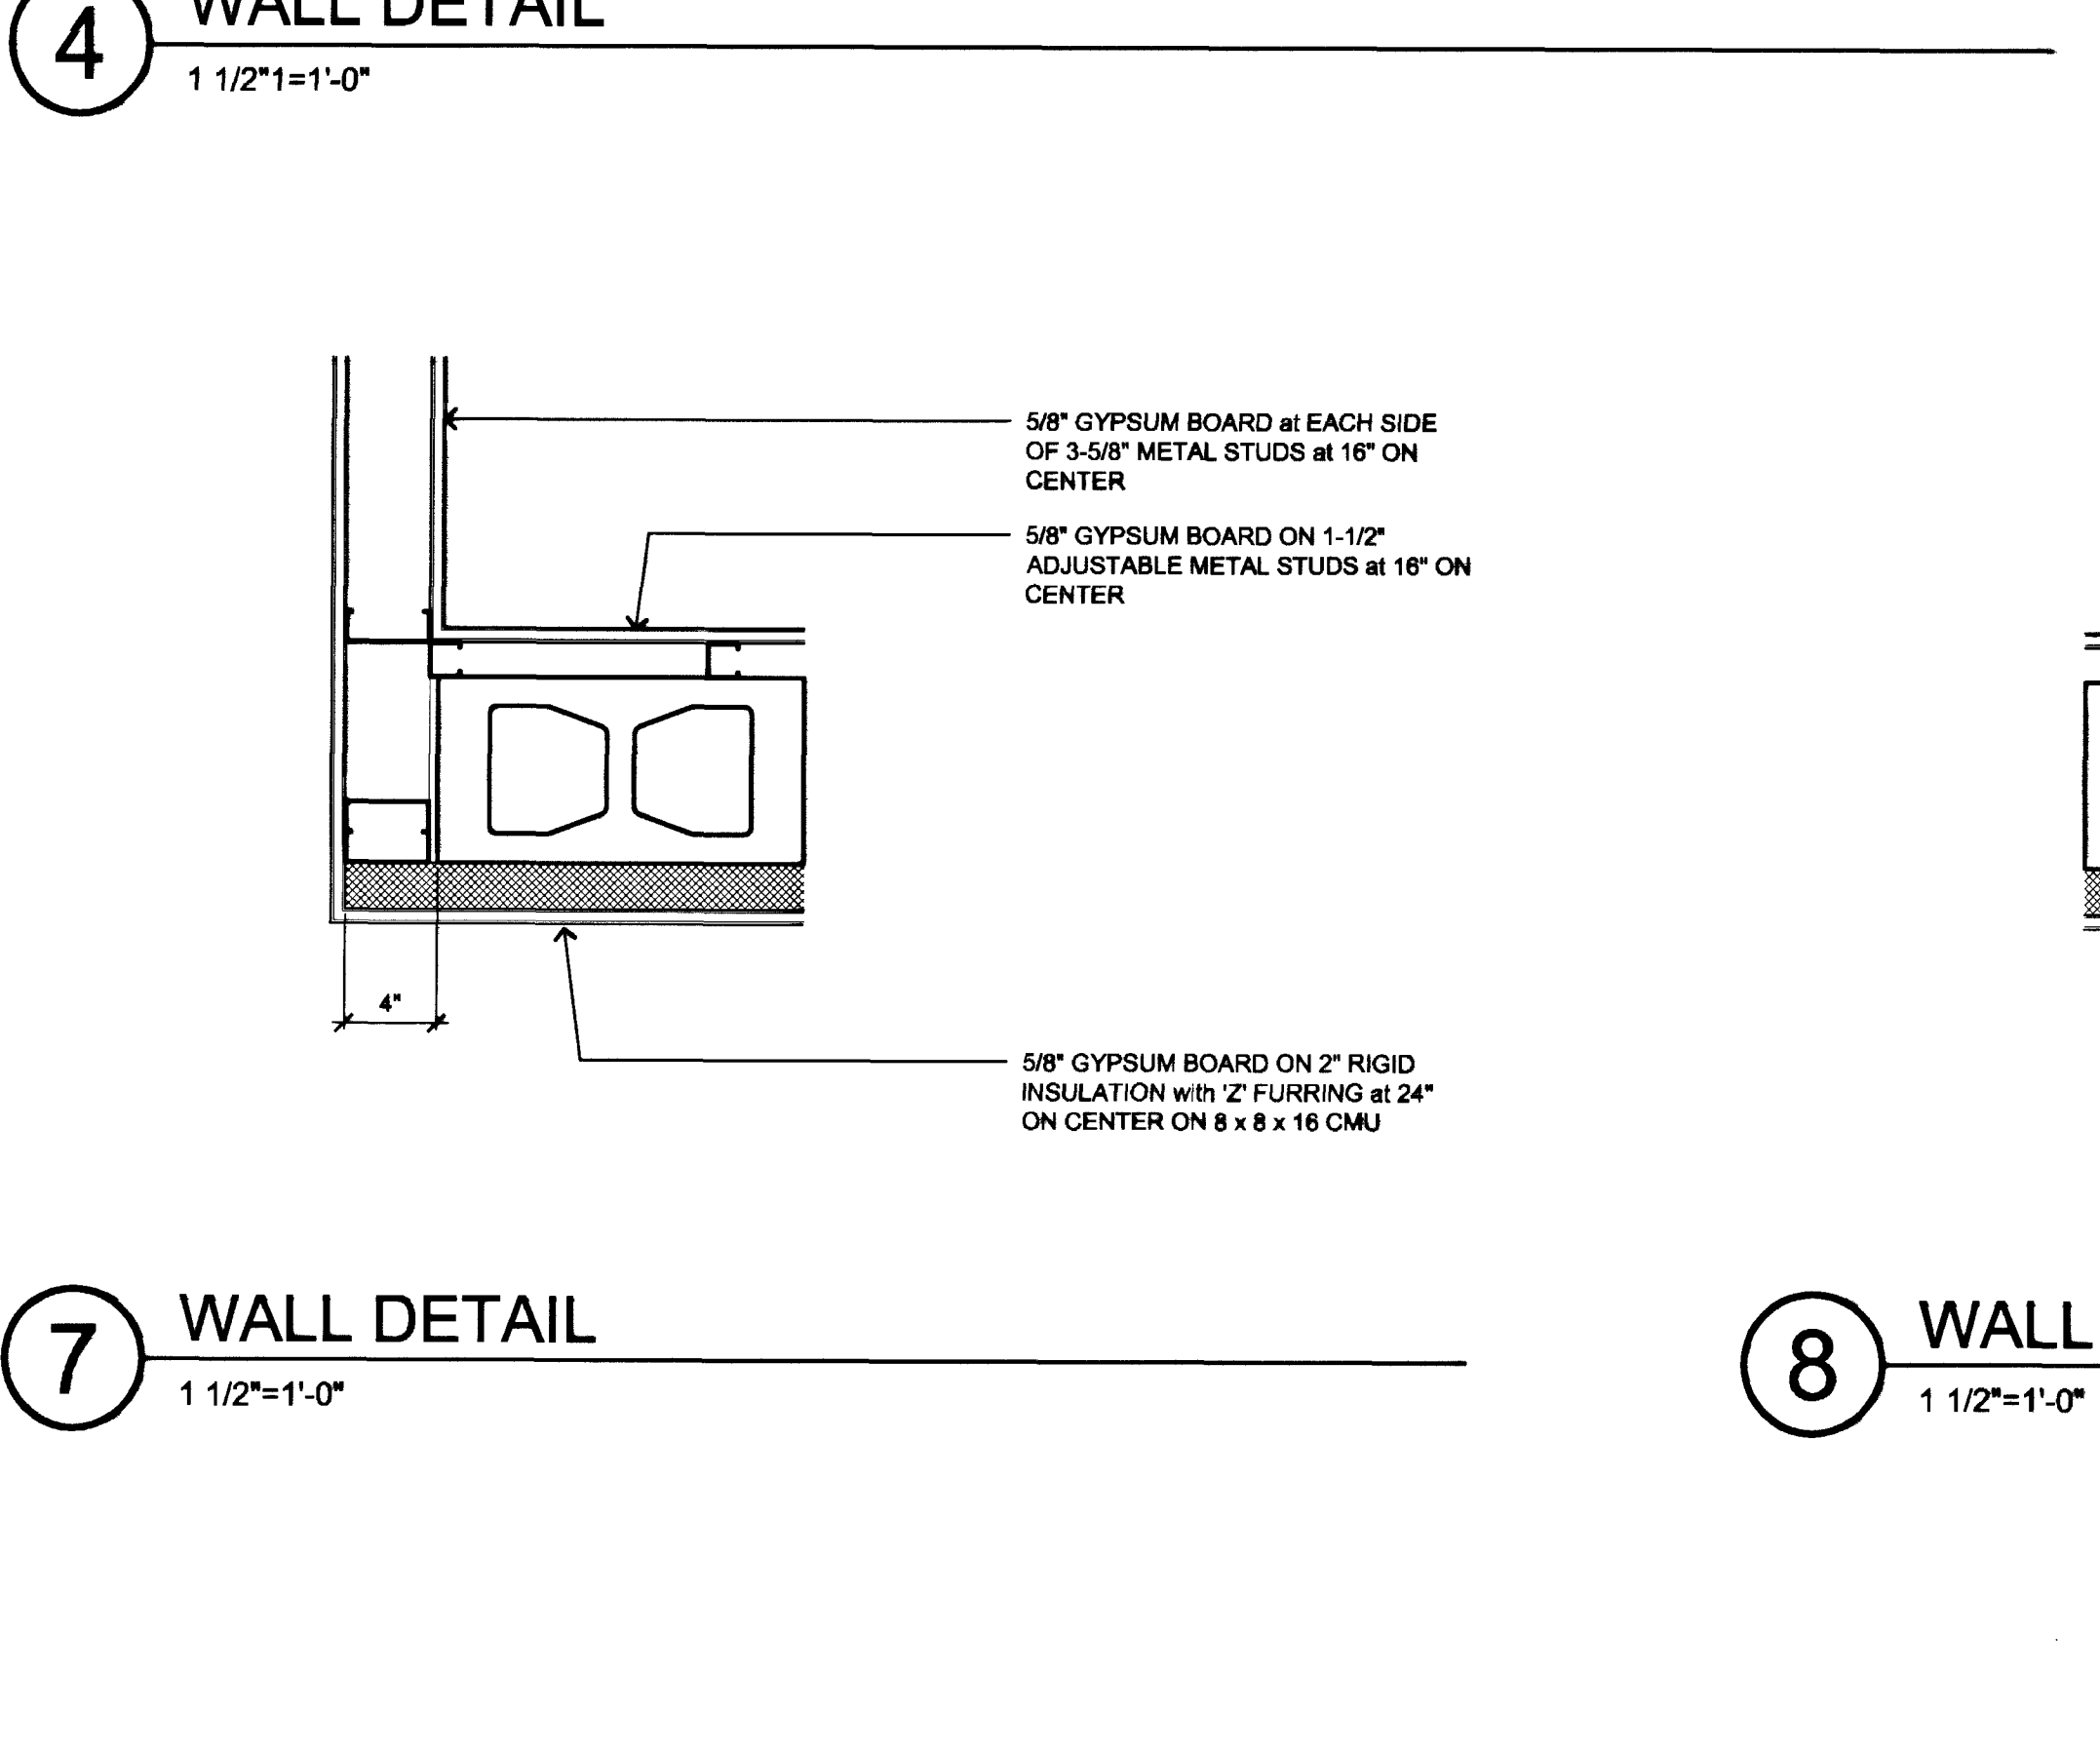

8 WALL DETAIL
1 1/2"=1'-0"

 

7 WALL DETAIL
1 1/2"=1'-0"

 

8 WALL DETAIL
1 1/2"=1'-0"



7 WALL DETAIL
1 1/2"=1'-0"