




1 WALL DETAIL
1 1/2"=1'-0"

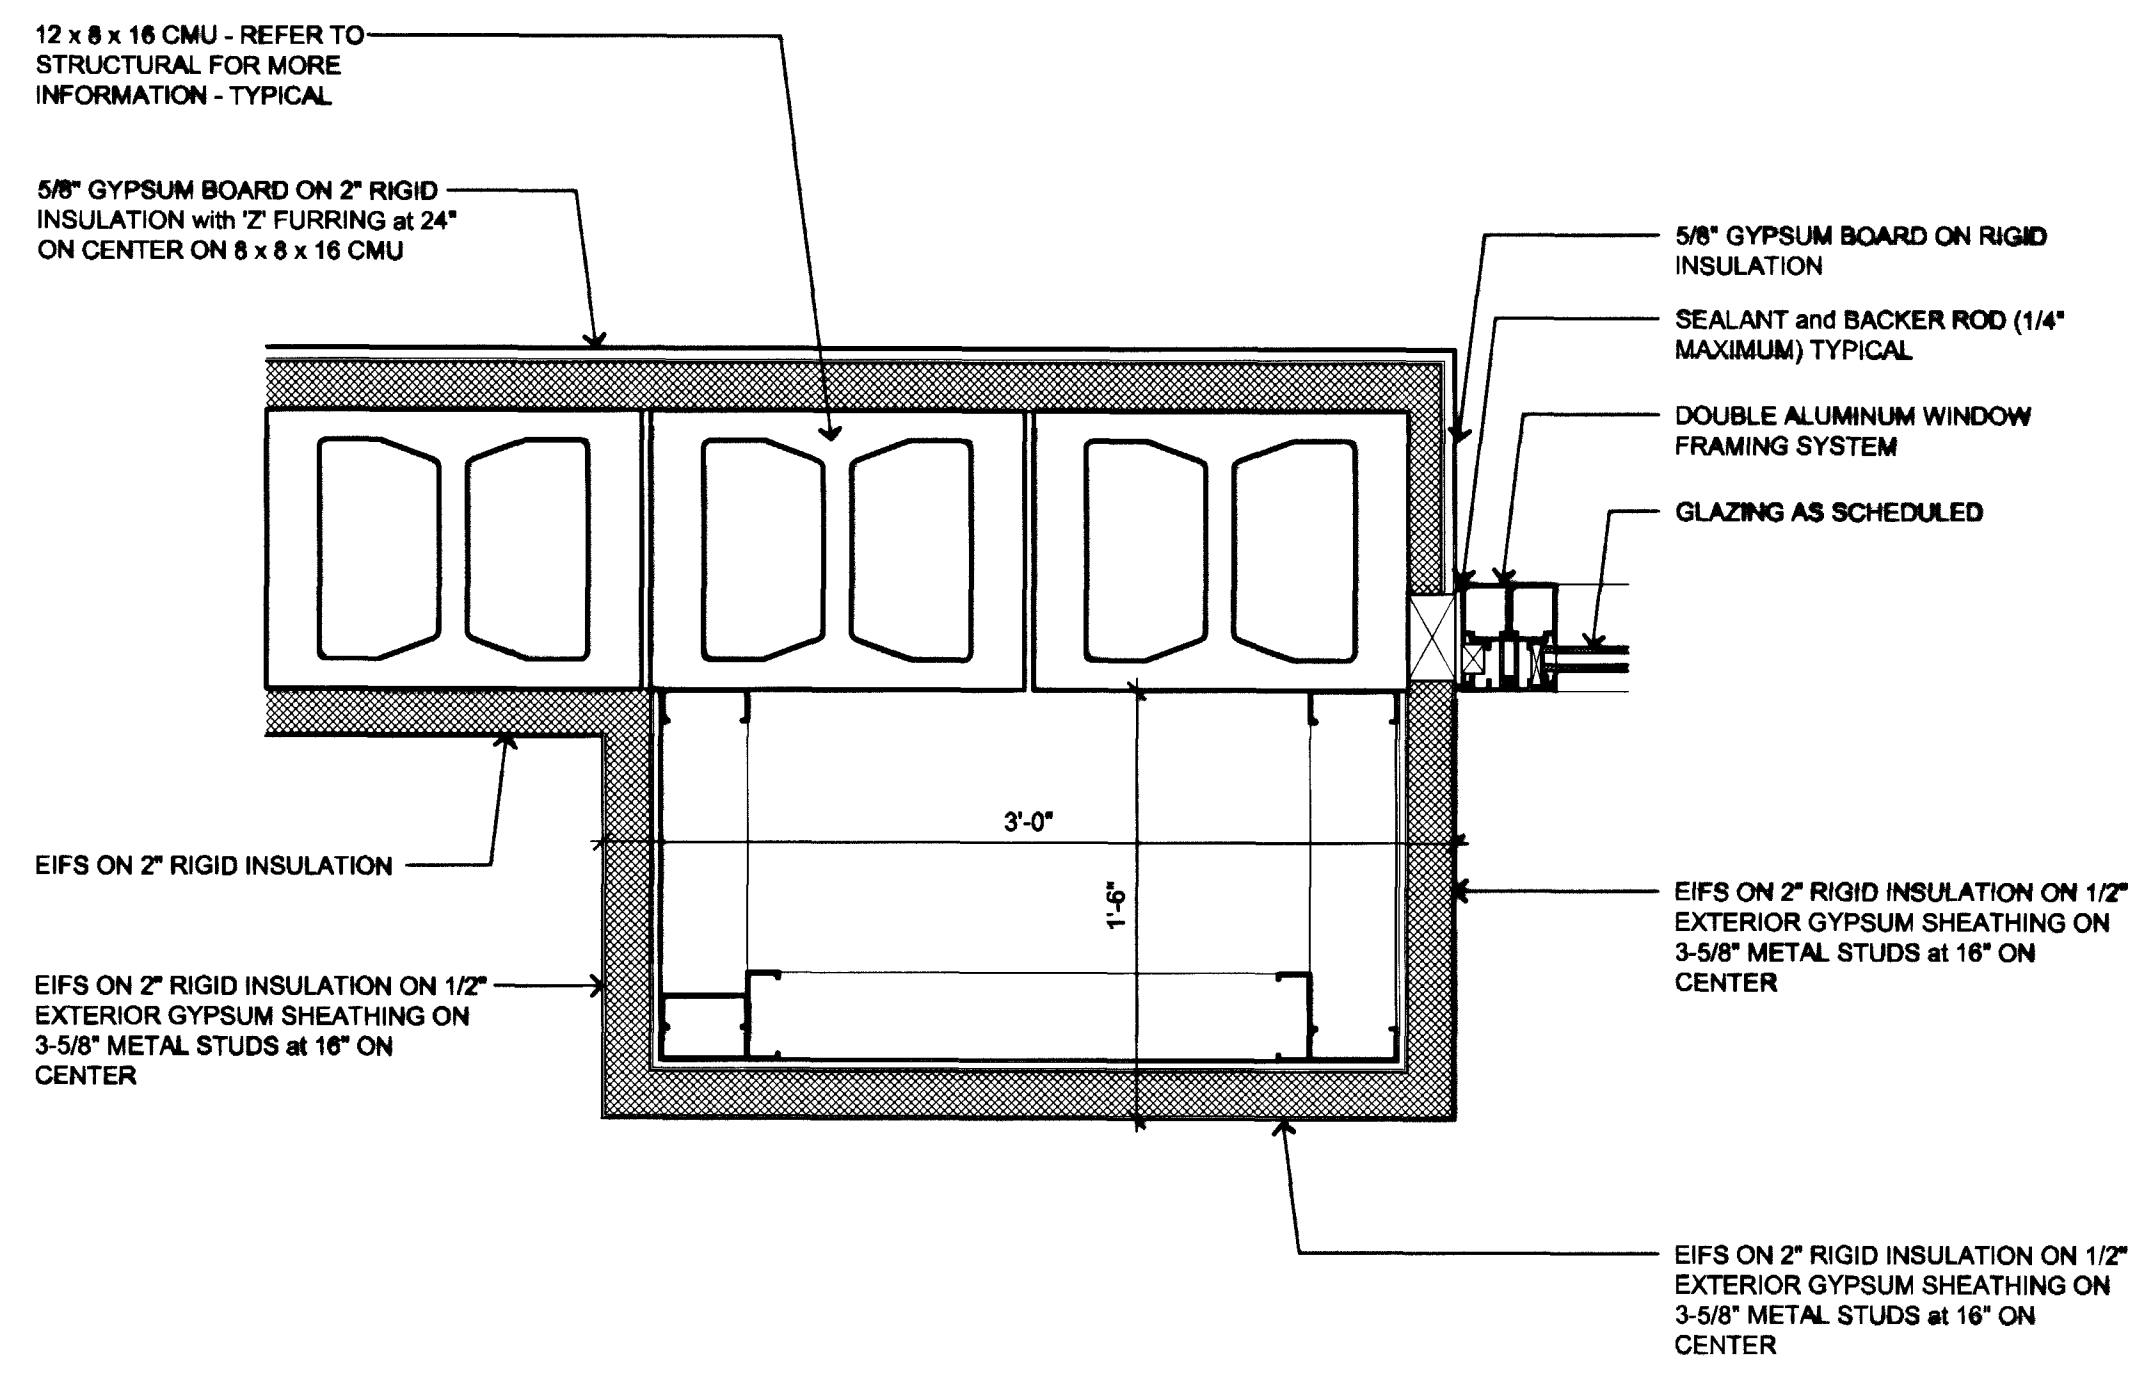


2 WALL DETAIL
1 1/2"=1'-0"

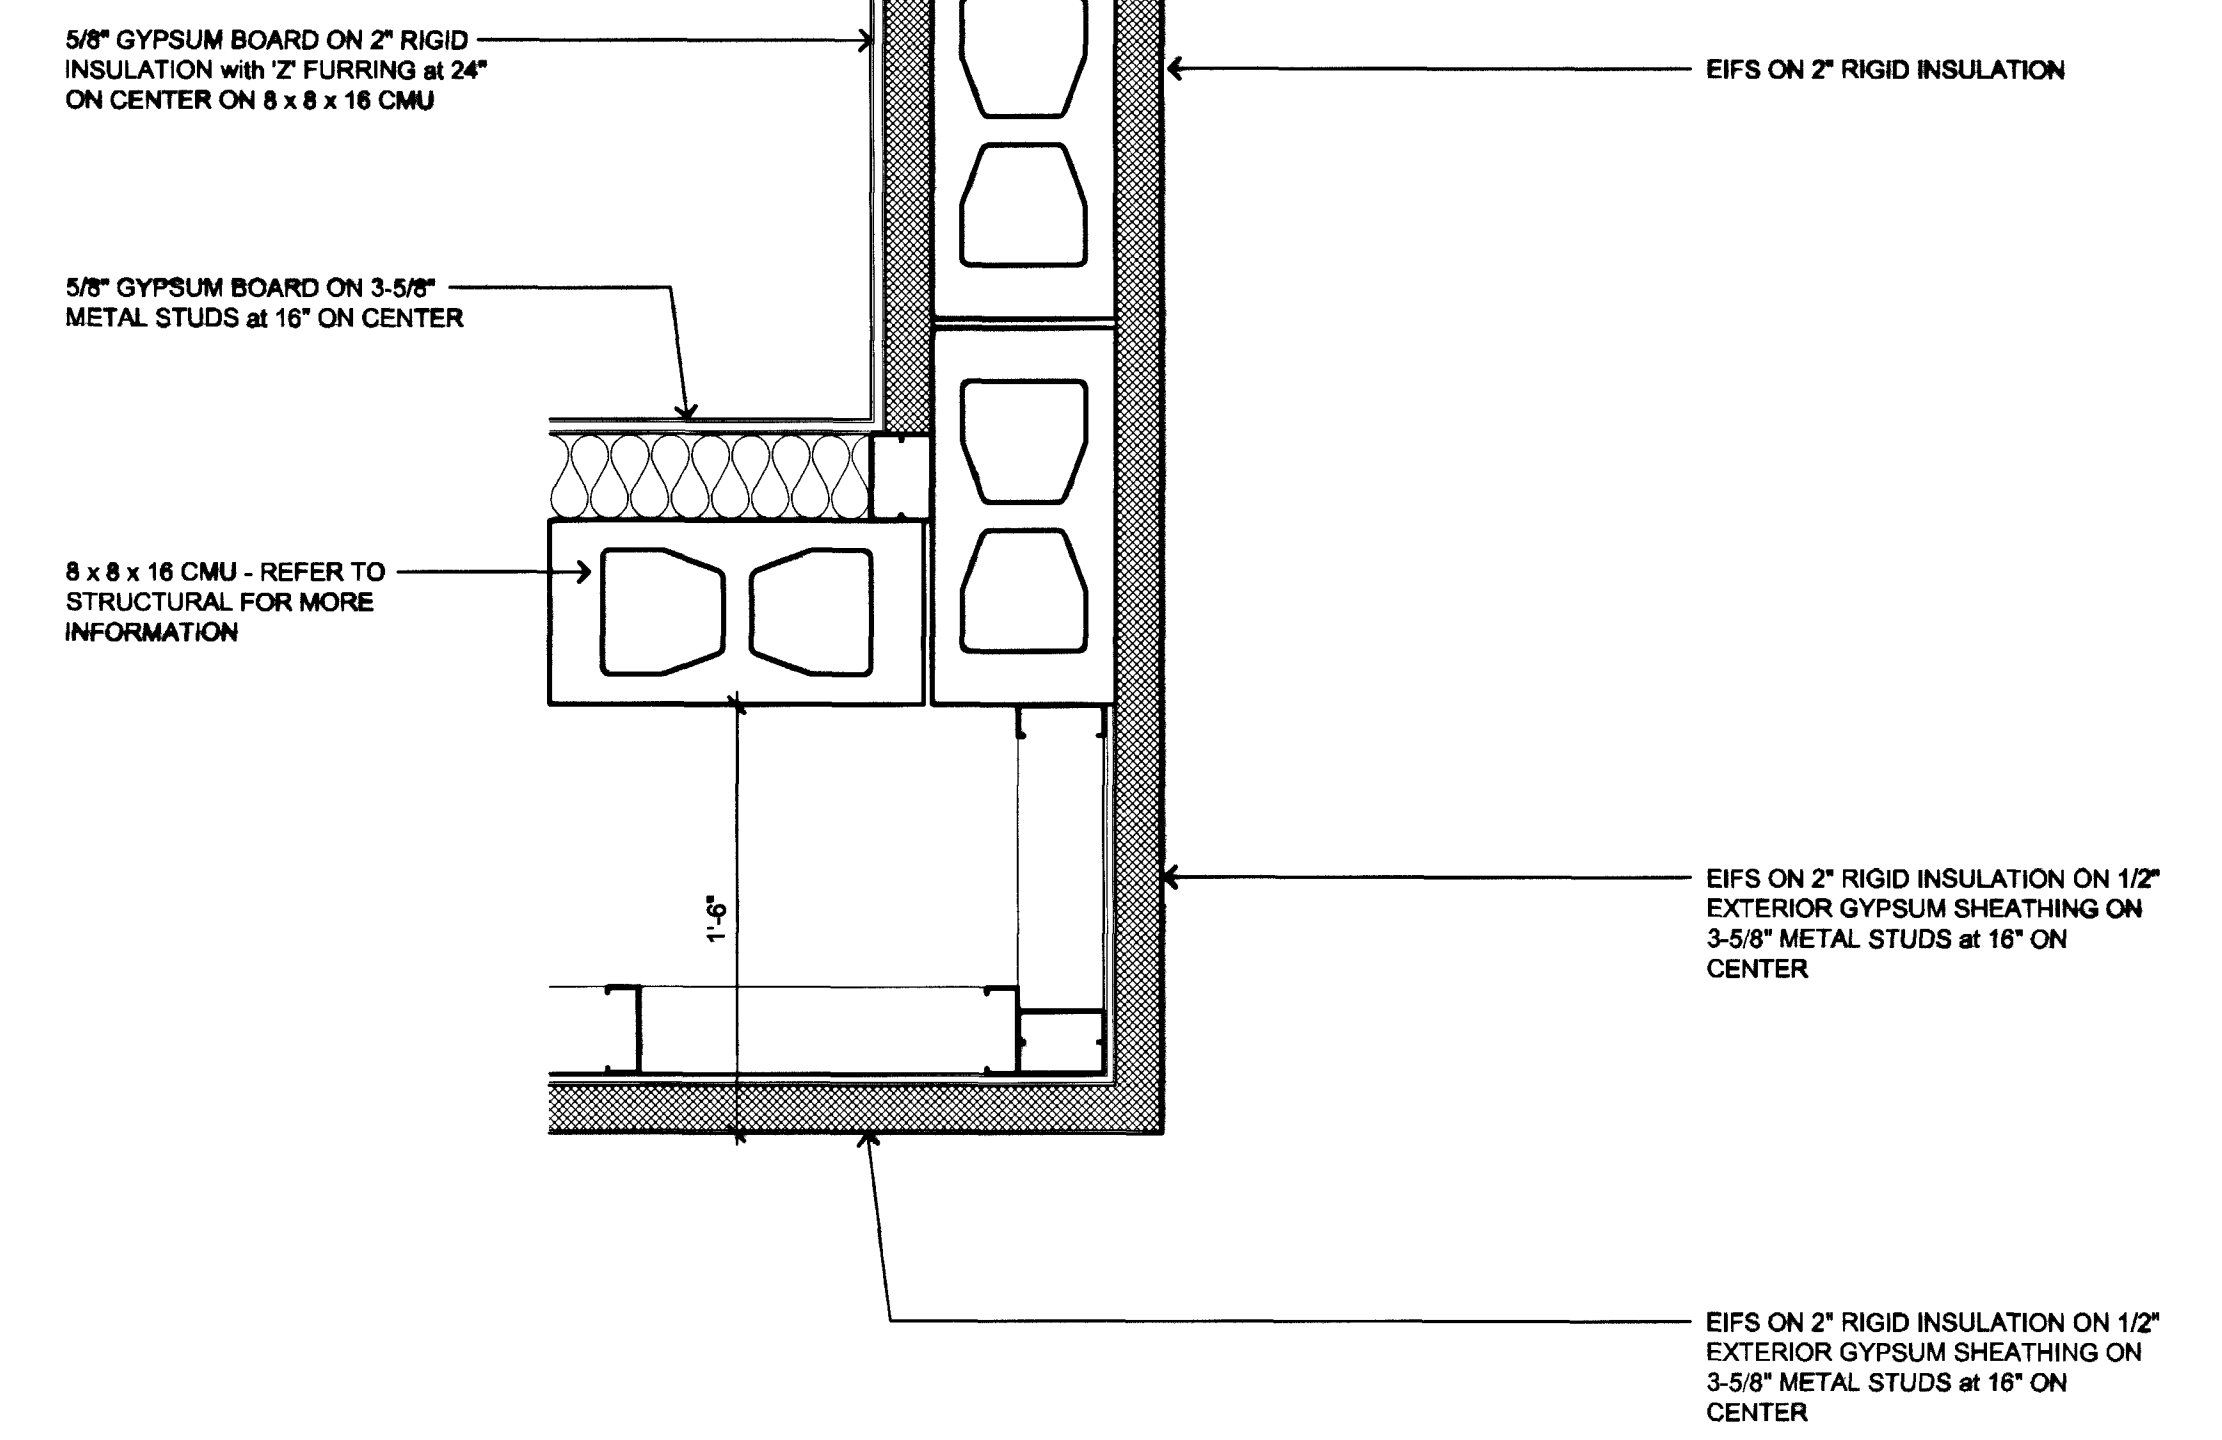


3 WALL DETAIL
1 1/2"=1'-0"

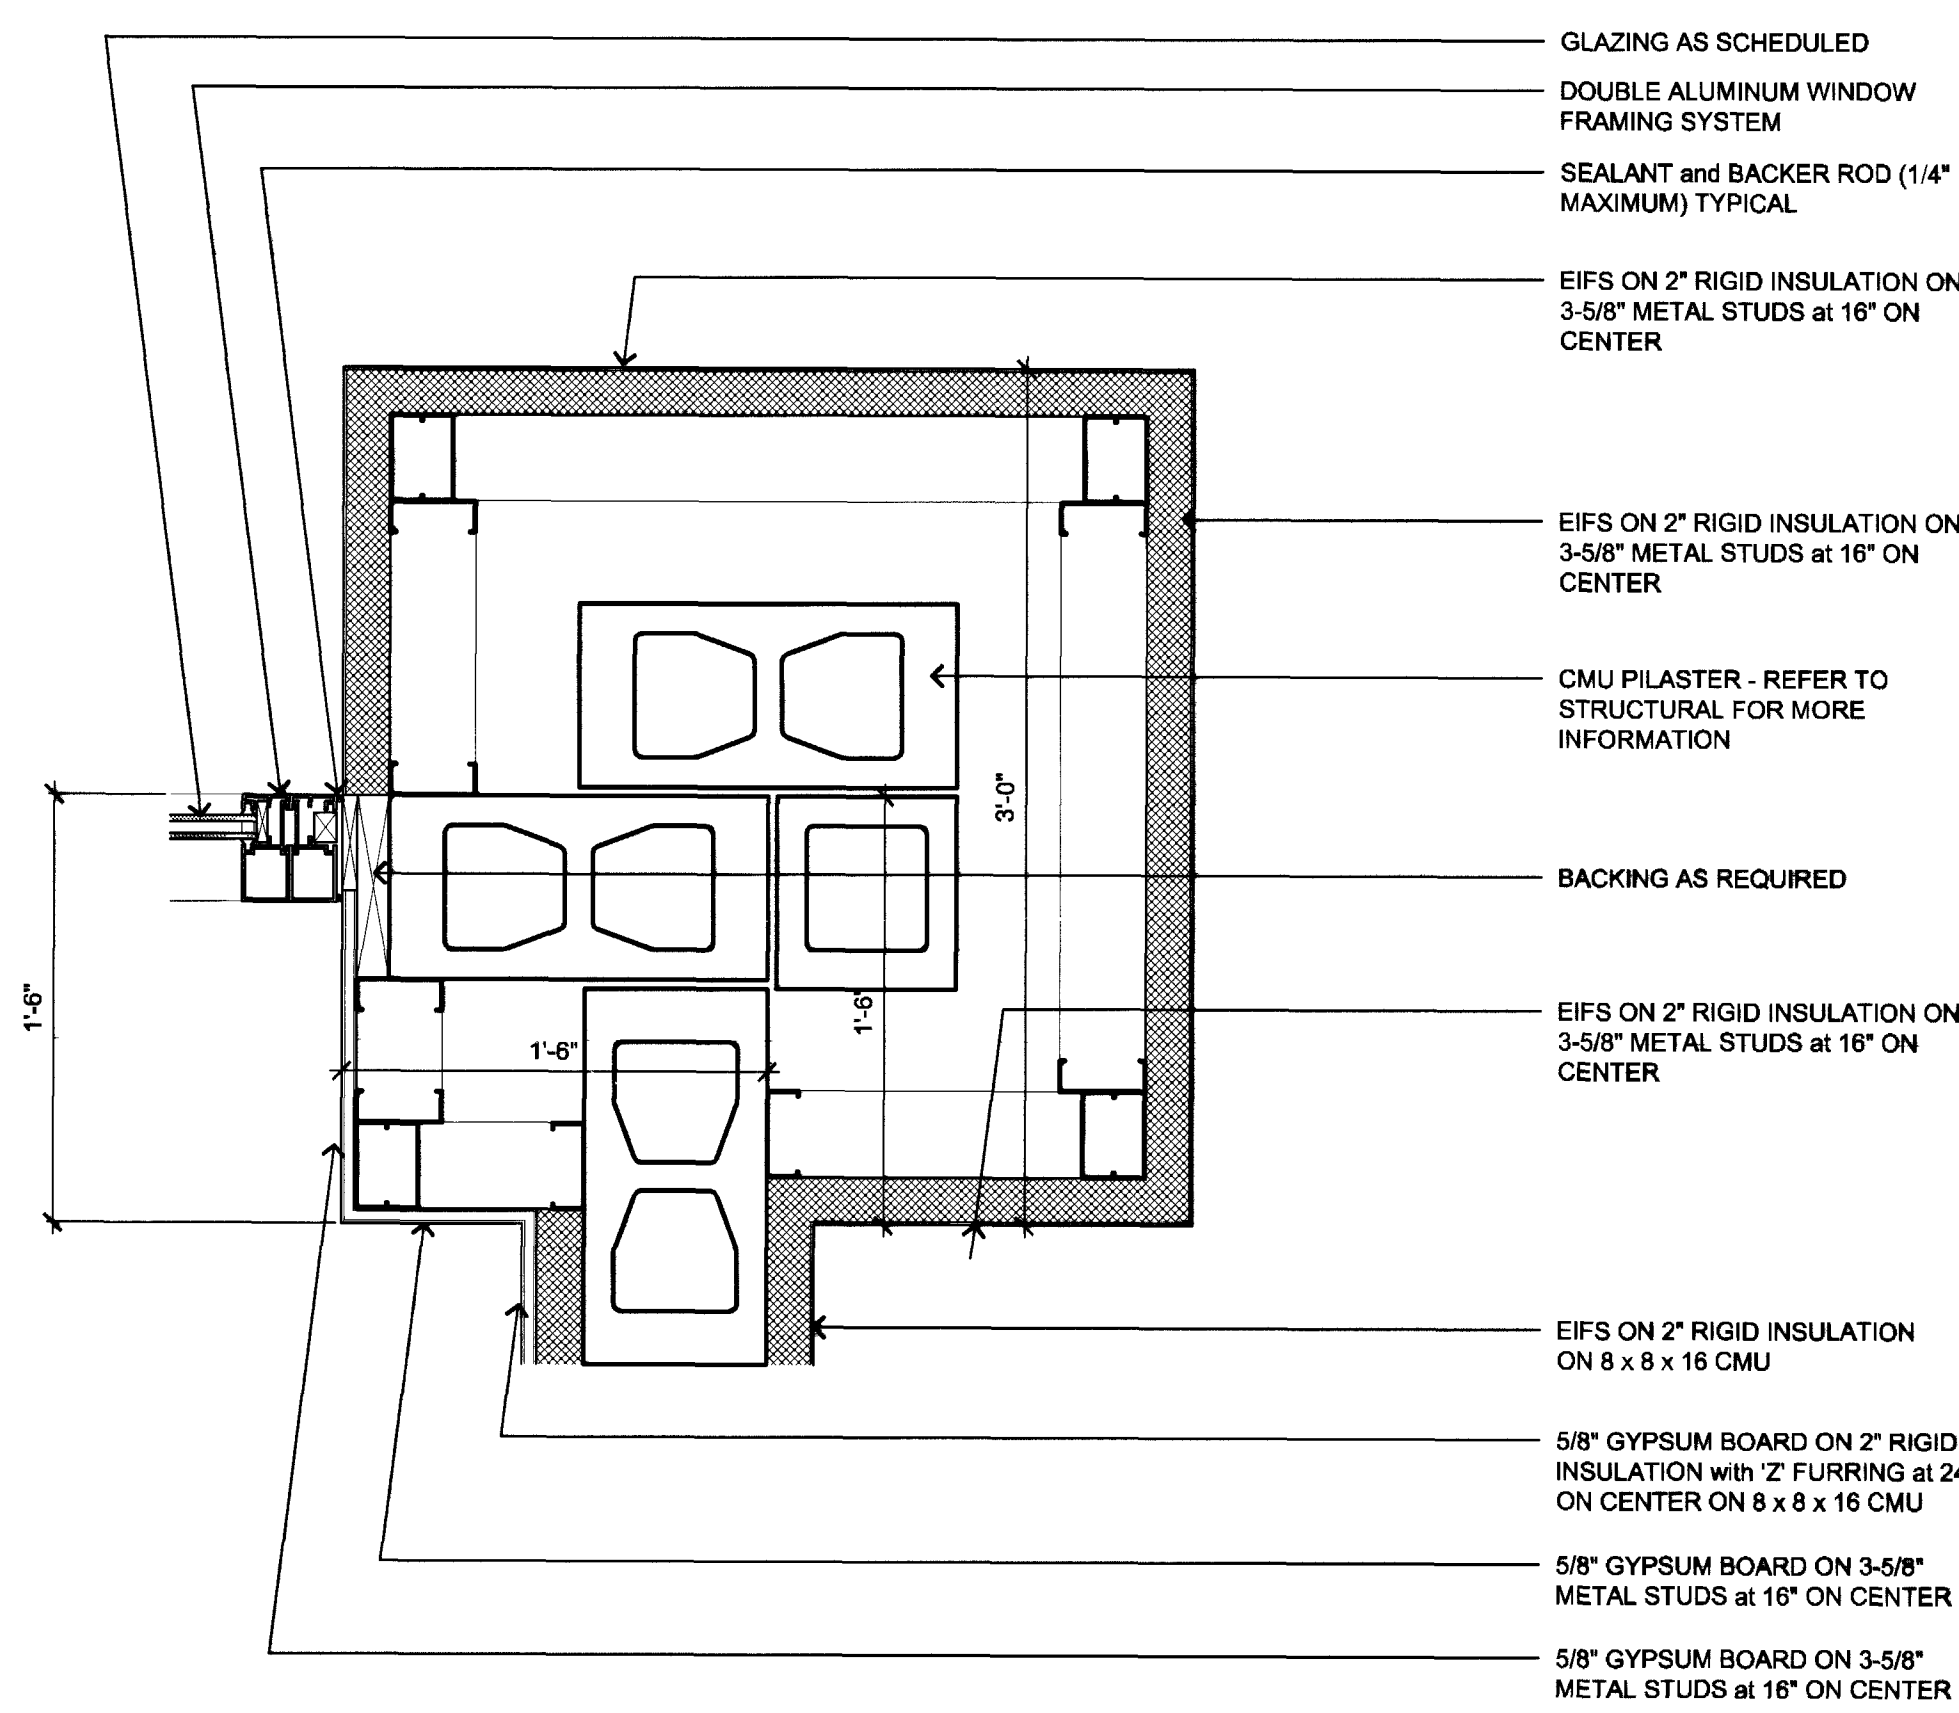

4 WALL DETAIL
1 1/2"=1'-0"

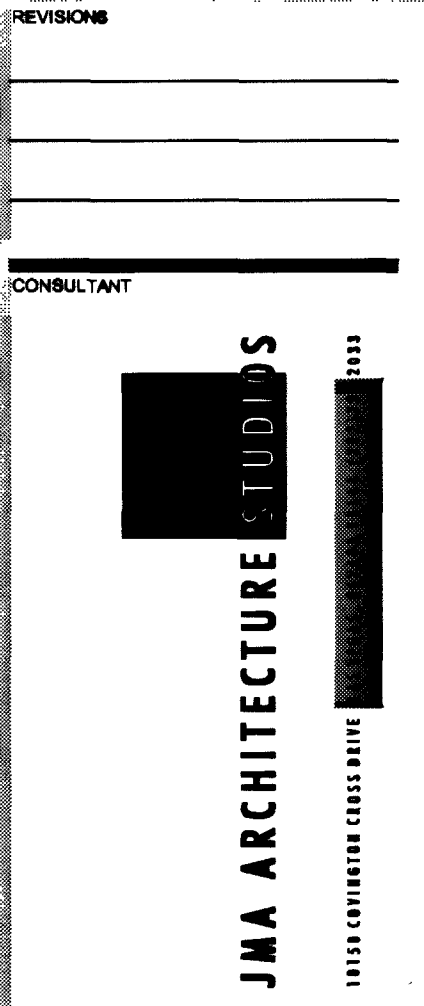

DEPARTMENT OF PUBLIC WORKS
East Las Vegas Community Center
Eastern and Stewart
Construction Documents

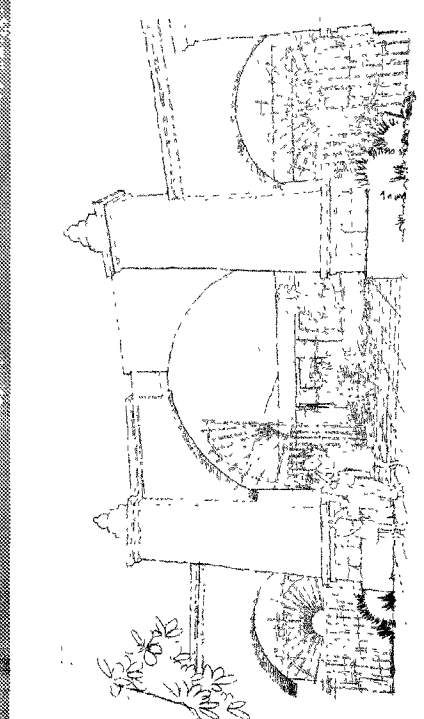

STAMP
RECORD DRAWING
This record drawing, issued May 22, 2001, has been prepared, in part, based upon information furnished by others.
While this information is believed to be reliable, JMA Architecture Studio, cannot assume its accuracy, and files its responsibility for the accuracy of the record drawing or for any errors or omissions which may have been incorporated into the record.
Those relying on this record drawing are advised to obtain independent verification of its accuracy before relying thereon.

OWNER: CITY OF LAS VEGAS
DEPARTMENT OF PUBLIC WORKS
ARCHITECTURAL SERVICES
400 EAST STEWART AVENUE
LAS VEGAS, NEVADA 89101
PHONE: (702) 258-8000
FAX: (702) 382-3028
WWW: (702) 388-6100
DESIGNER: M. Phillips
DATE: August 2, 2001
SCALE:
SHEET NO: 01-15301-22
DRAWING NO: 521-388
JOB NO:

A8.25