


SHEET NOTES


- 1 STORM DRAIN AND OVERFLOW STORM DRAIN PIPING DOWN TO BELOW GRADE. SEE CIVIL DRAWINGS FOR CONTINUATION.
- 2 REFER TO MECHANICAL PLANS FOR EXACT ROOF TOP A/C UNIT LOCATIONS AND REQUIREMENTS.
- 3 ROUTE 1" CONDENSATE DRAIN PIPE DOWN IN WALL WITH ELBOW TURNED DOWN ABOVE SERVICE SINK.
- 4 ROUTE CONDENSATE DRAIN PIPING UP HIGH AS POSSIBLE WITH-IN ROOF FRAMING. COORDINATE INSTALLATION WITH DUCTS AND FIRE SPRINKLER PIPES.
- 5 3/4" CONDENSATE DRAIN WITH RUNNING P-TRAP AND VENT. PROVIDE REMOVABLE END CAPS AT ALL CHANGE IN DIRECTION OF PIPING FOR CLEANOUTS.
- 6 4" STORM DRAIN AND OVERFLOW STORM DRAIN VERTICAL RAIN LEADERS FROM ABOVE.
- 7 3" COLD WATER BUILDING SUPPLY, SEE CIVIL DRAWINGS FOR CONTINUATION.
- 8 6" FIRE SPRINKLER BUILDING SUPPLY, SEE CIVIL DRAWINGS FOR CONTINUATION.
- 9 ROUTE 1-1/2" CONDENSATE DRAIN PIPE DOWN IN WALL WITH ELBOW TURNED DOWN ABOVE SERVICE SINK.
- 10 ROUTE 3/4" CONDENSATE DRAIN PIPE DOWN IN WALL AND DISCHARGE TO LANDSCAPING 12" ABOVE GRADE.
- 11 PROVIDE 3/4" CONDENSATE DRAIN PIPE WITH RUNNING P-TRAP AND AIR VENT ABOVE ROOF. ROUTE PIPING THRU ROOF. PROVIDE SHEET METAL RAINSKIRT AND SEAL PENETRATION WEATHERTIGHT. PROVIDE REMOVABLE END CAPS AT ALL CHANGES IN DIRECTION OF PIPING FOR A CLEANOUT.
- 12 FOR CONTINUATION, SEE SHEET P2.02.
- 13 ROUTE STORM DRAIN AND OVERFLOW STORM DRAIN PIPING UP HIGH AS POSSIBLE WITH-IN ROOF FRAMING. COORDINATE INSTALLATION WITH DUCTS AND FIRE SPRINKLER PIPES.
- 14 DELETED.
- 15 5" STORM DRAIN AND OVERFLOW STORM DRAIN VERTICAL RAIN LEADERS FROM ABOVE.
- 16 FOR CONTINUATION, SEE CIVIL DRAWINGS.
- 17 DELETED.
- 18 FIRE SPRINKLER RISER BY FIRE PROTECTION RISER.
- 19 3" SHUT OFF VALVE IN GRADE BOX WITH CAST IRON SCORRIATED COVER.
- 20 2" WASTE WITH WALL CLEANOUT, 1-1/2" VENT UP, 1/2" HOT AND COLD WATER TO SINK.
- 21 4" STORM DRAIN AND OVERFLOW STORM DRAIN PIPING DOWN IN COLUMN AND DISCHARGE 12" ABOVE FINISHED FLOOR.
- 22 3" COLD WATER TO PRESSURE REDUCING STATION. SEE DETAIL 4/P4.01.

GENERAL NOTES

1. ALL DRAINAGE PIPING 4" AND SMALLER SHALL BE SLOPED AT 1/4" PER FOOT.
2. ALL DRAINAGE PIPING 5" AND LARGER SHALL BE SLOPED AT 1/8" PER FOOT.
3. ALL CONDENSATE DRAINAGE (CD) PIPING SHALL BE SLOPED AT 1/8" PER FOOT.
4. ALL STORM DRAIN (SD) AND OVERFLOW STORM DRAIN (OSD) PIPING SHALL BE SLOPED AT 1/8" PER FOOT.
5. NO PLUMBING PIPING SHALL BE INSTALL IN CONCRETE OR MASONRY WALLS UNLESS A PIPE CHASE IS PROVIDED.

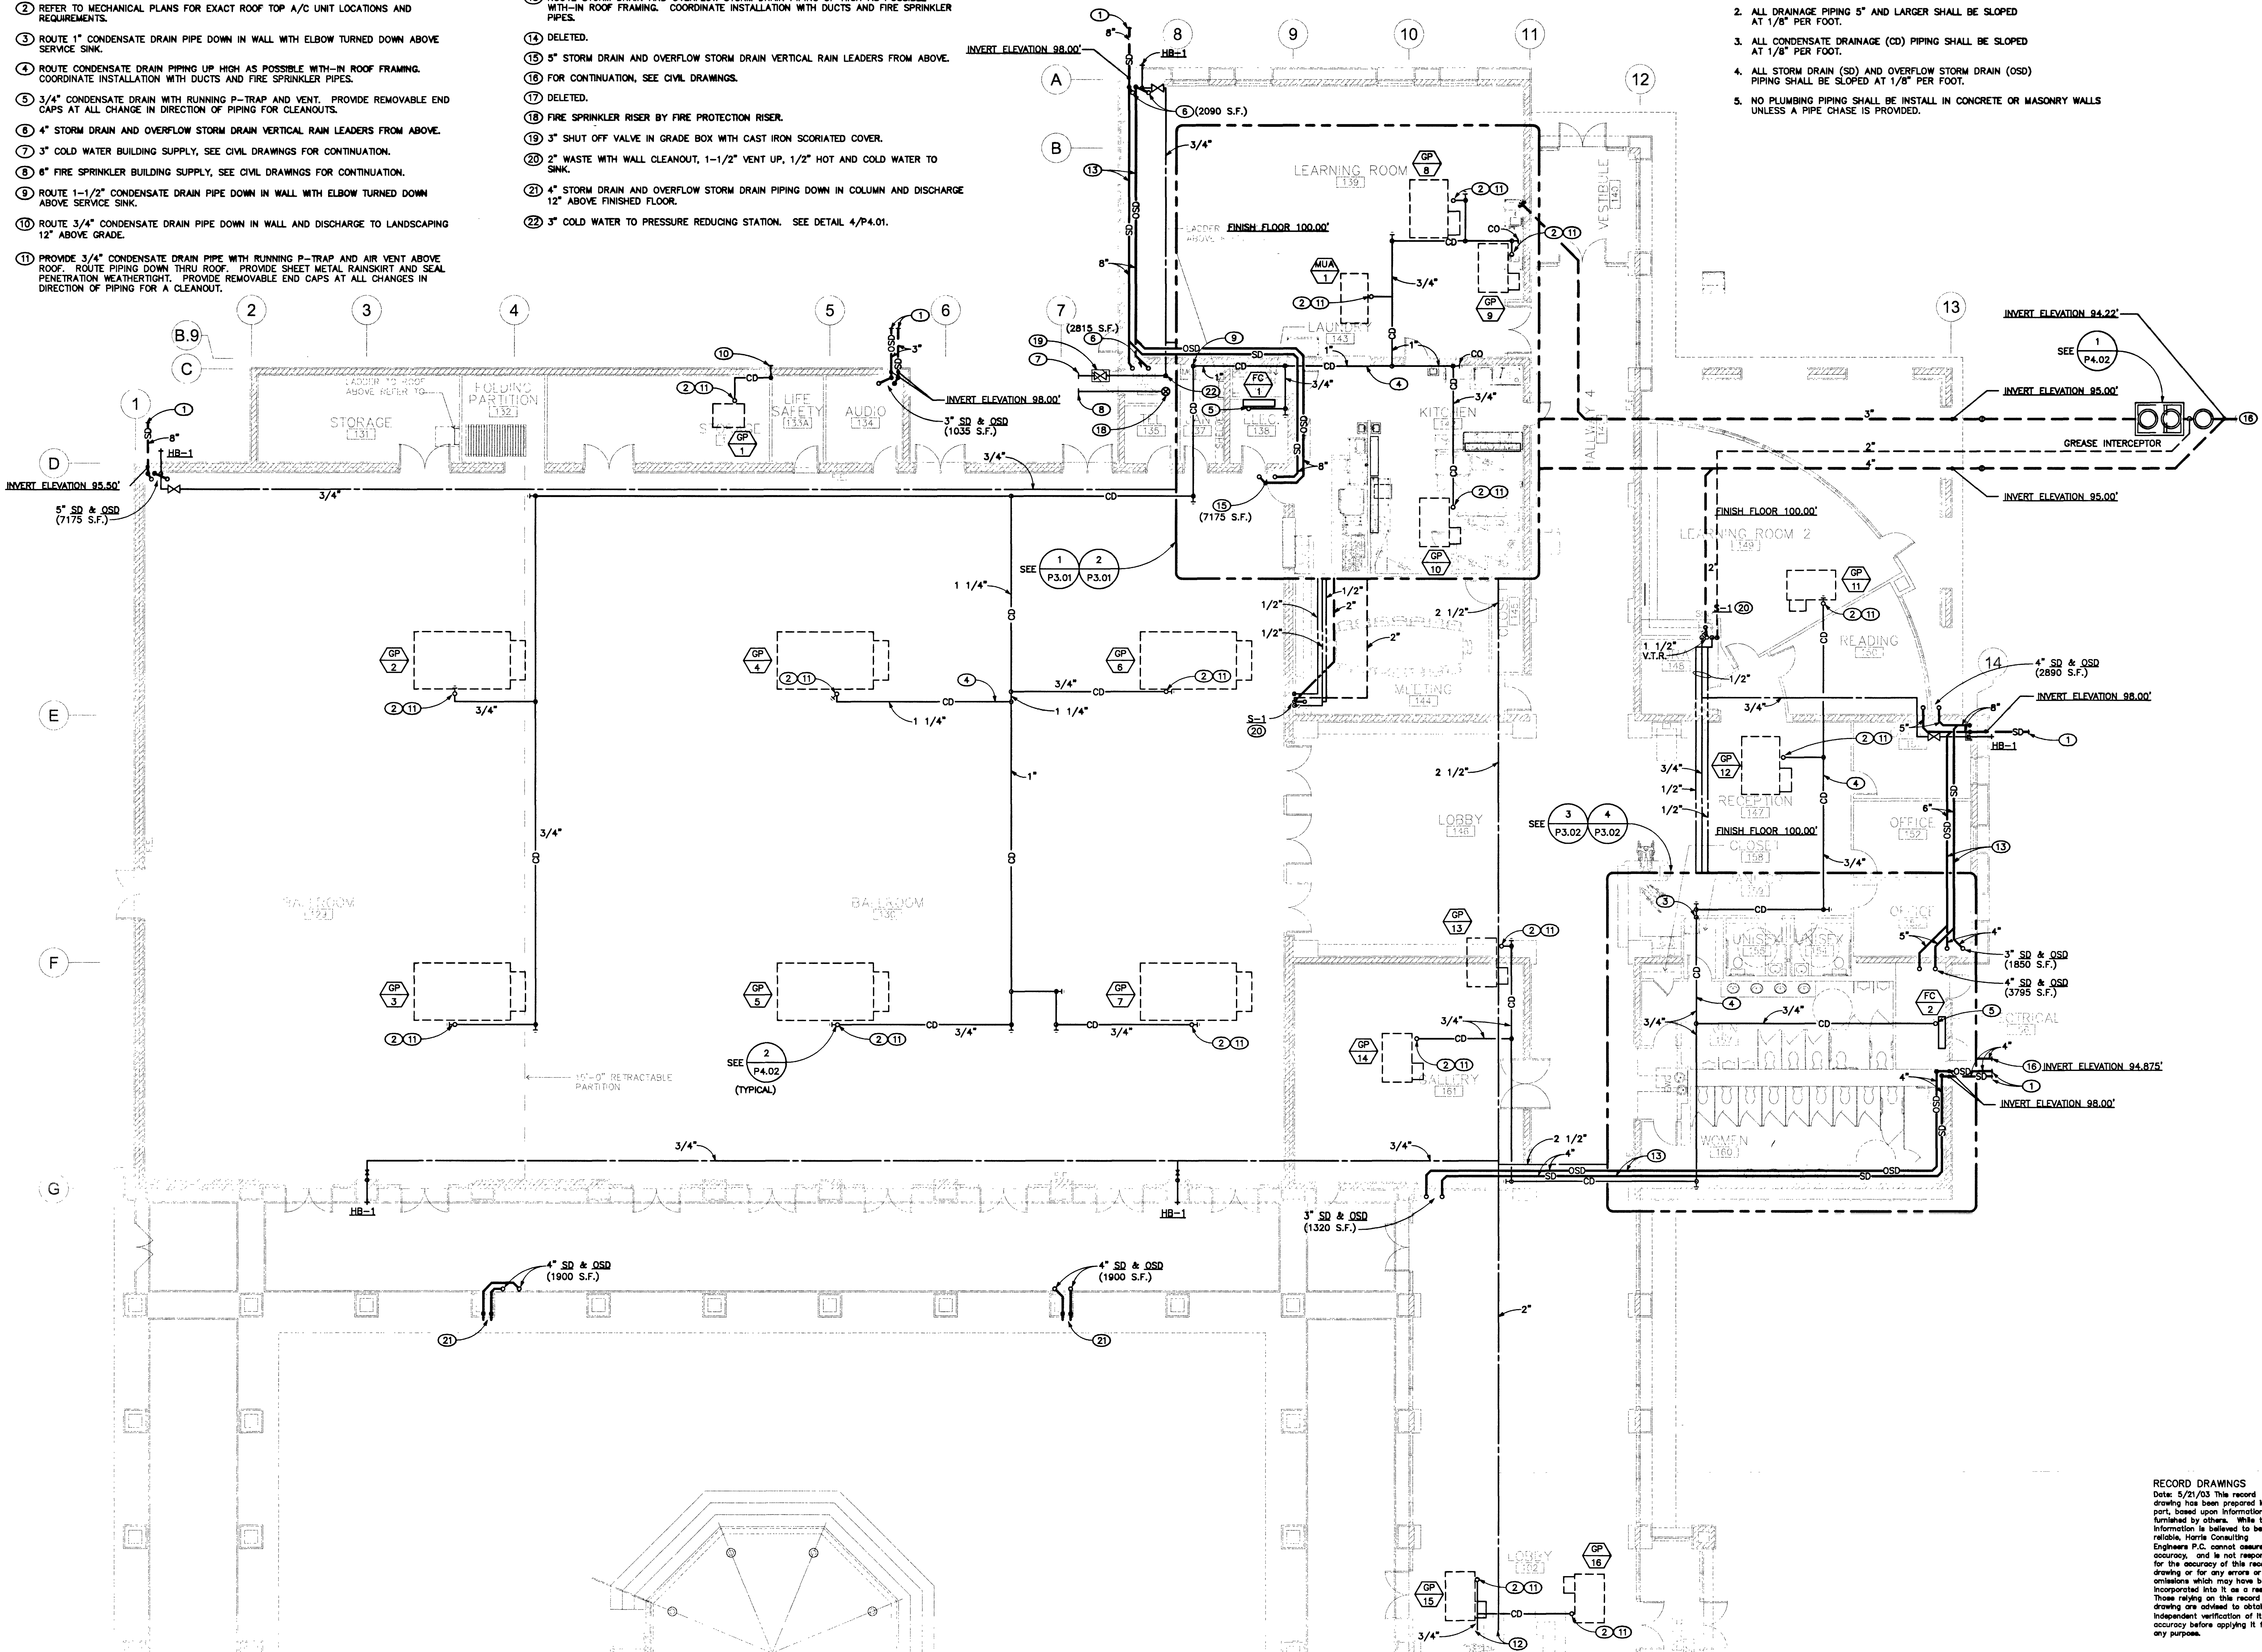

55493 **PARTIAL PLUMBING PLAN**
SCALE: 1/8" = 1' - 0"

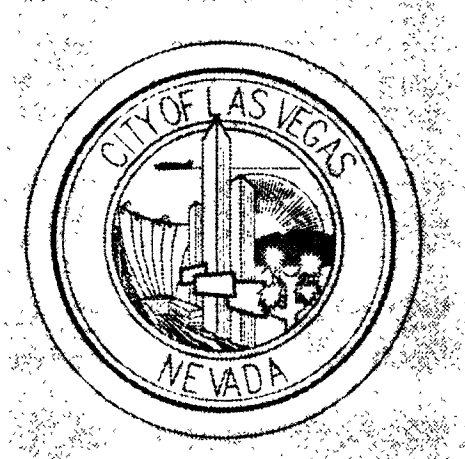

REVISIONS
CONSULTANT
JMA ARCHITECTURE STUDIOS
1100 CENTENNIAL CENTER DRIVE, SUITE 100, LAS VEGAS, NV 89101
TEL: 702.368.9222 FAX: 702.368.9222

DEPARTMENT OF PUBLIC WORKS
East Las Vegas Community Center
Eastern and Stewart

HARRIS
ARCHITECTS
PROJECT NO. 20206.30
DESIGNED BY: A. DRIBLES
DRAWN BY: A. DRIBLES

OWNER: CITY OF LAS VEGAS
DEPARTMENT OF PUBLIC WORKS
ARCHITECTURAL SERVICES

RECORD DRAWINGS
Date: 5/21/03 This record drawing has been prepared in part, based upon information furnished by others. While this information is believed to be reliable, Harris Consulting Engineers P.C. cannot assume its accuracy, and is not responsible for the accuracy of this record drawing or for any errors or omissions which may have been incorporated into it as a result. Those relying on this record drawing are advised to obtain independent verification of its accuracy before applying it for any purpose.

FILE NO.	A.D.
DATE	August 2, 2001
SCALE	1/8"=1'-0"
ISSUE NO.	01.15301.22
CITY DRAWING NO.	521-268
DATE	

P2.01