




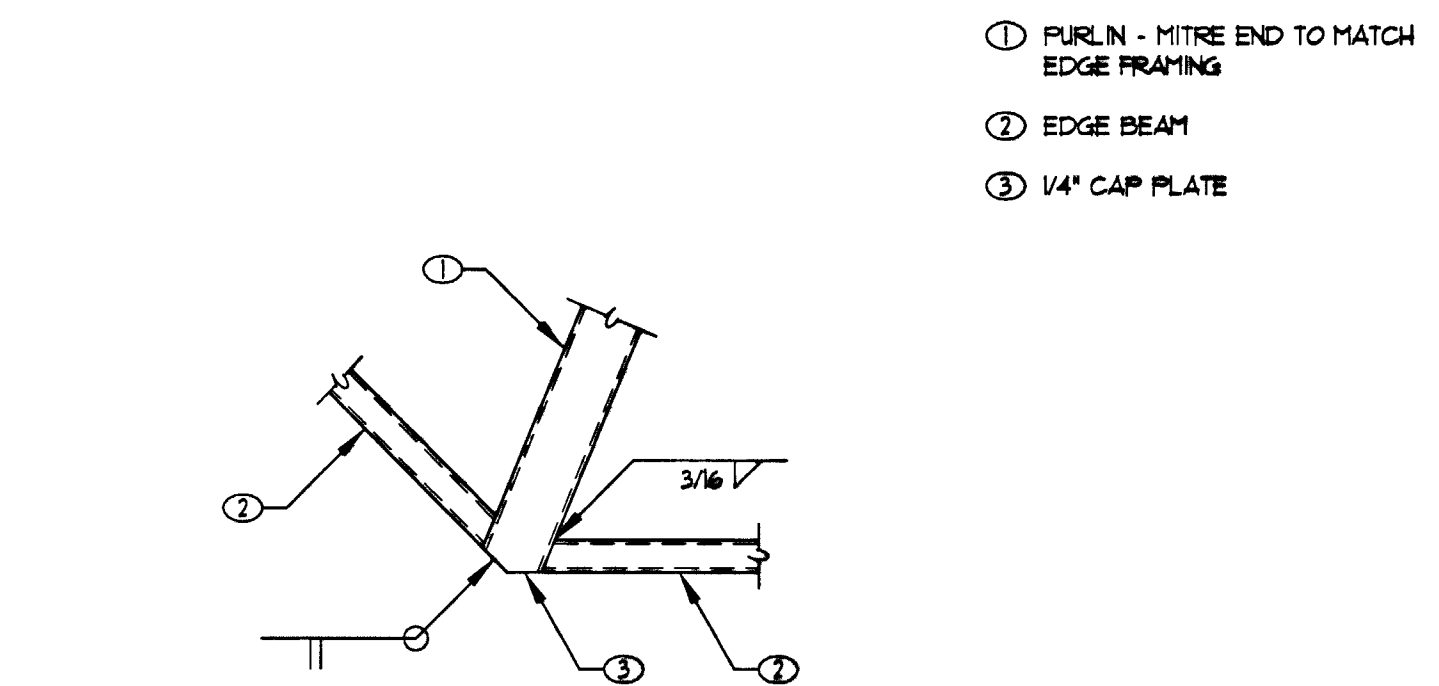


214 BANDSTAND FRAMING
24-20432 NO SCALE

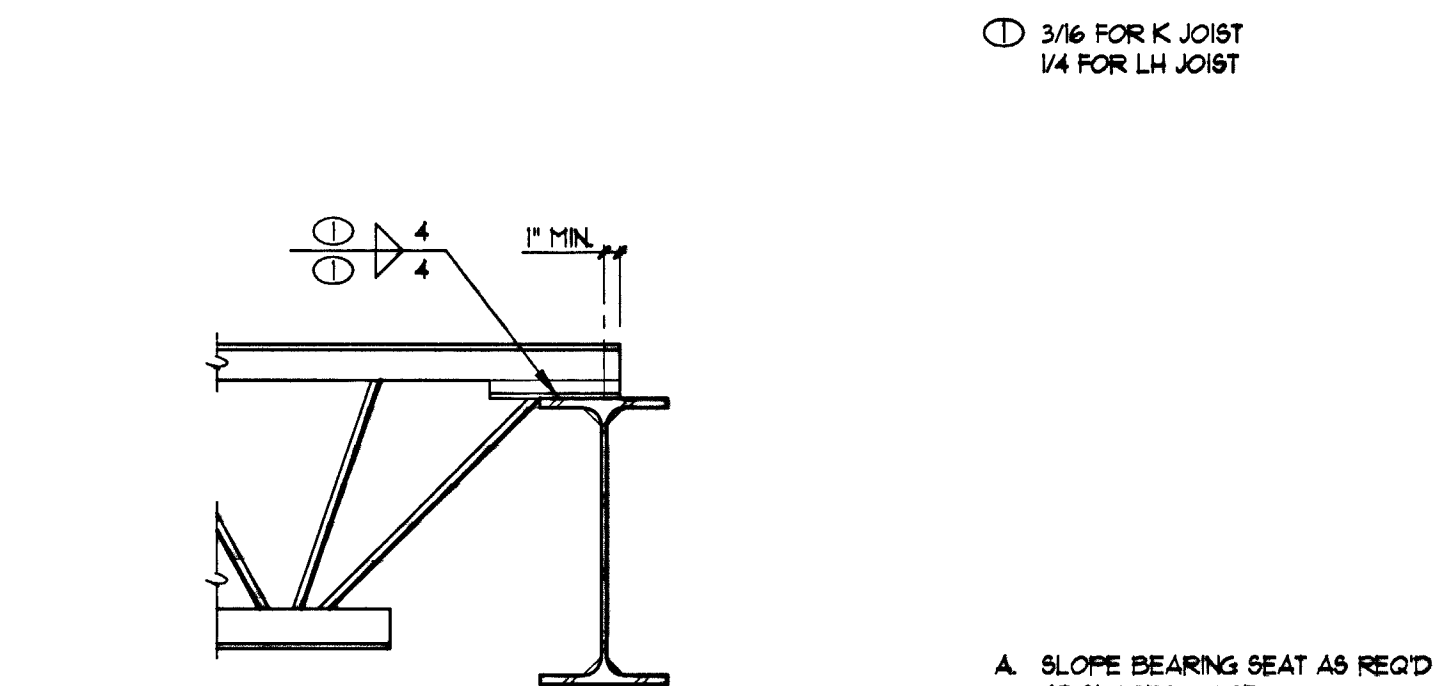


210 STEEL PURLIN AT STEEL BEAM
26-20432 NO SCALE

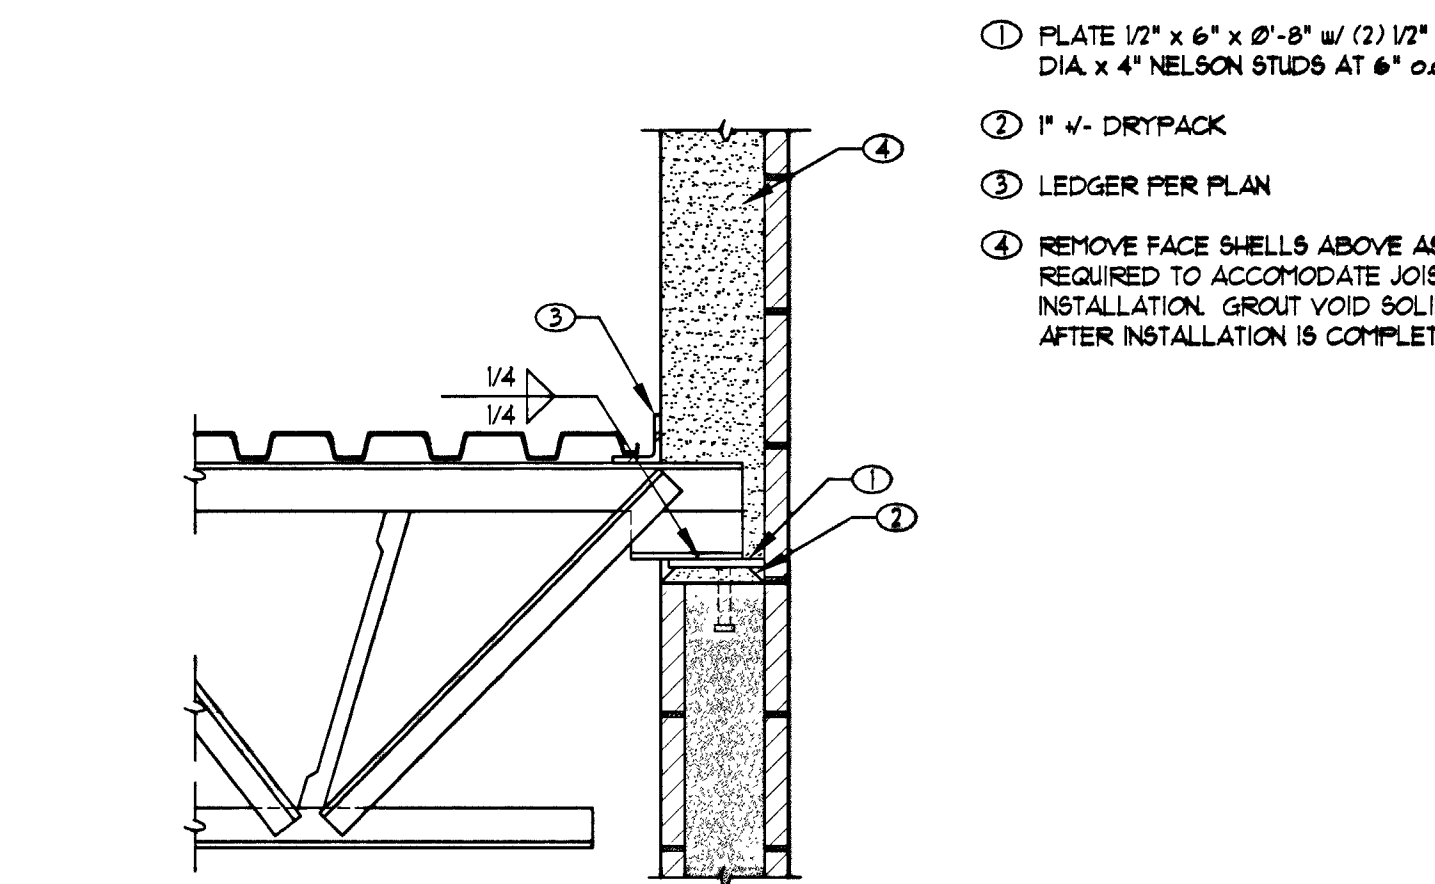


205 STEEL JOIST AT MASONRY WALL
31-01-01 NO SCALE

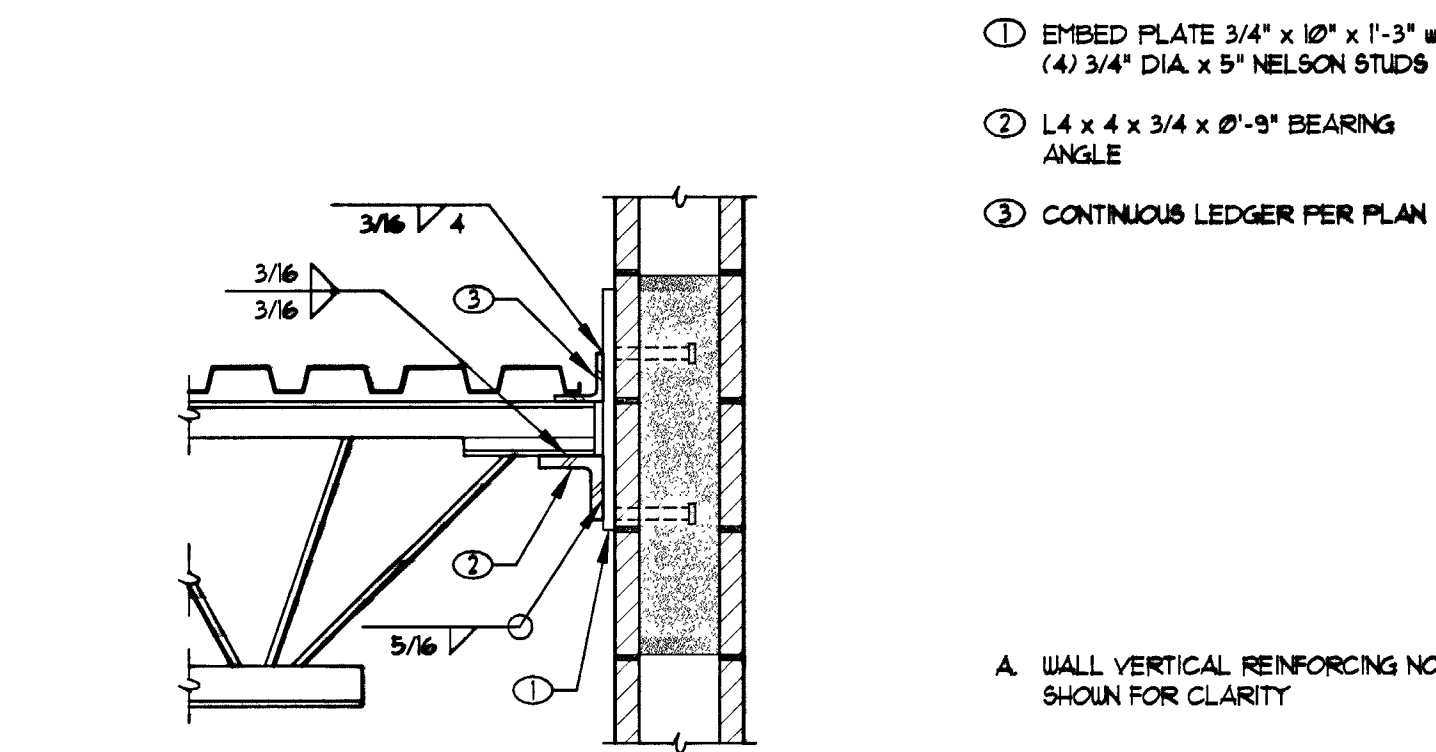


201 STEEL JOIST AT MASONRY WALL
31-01-01 NO SCALE

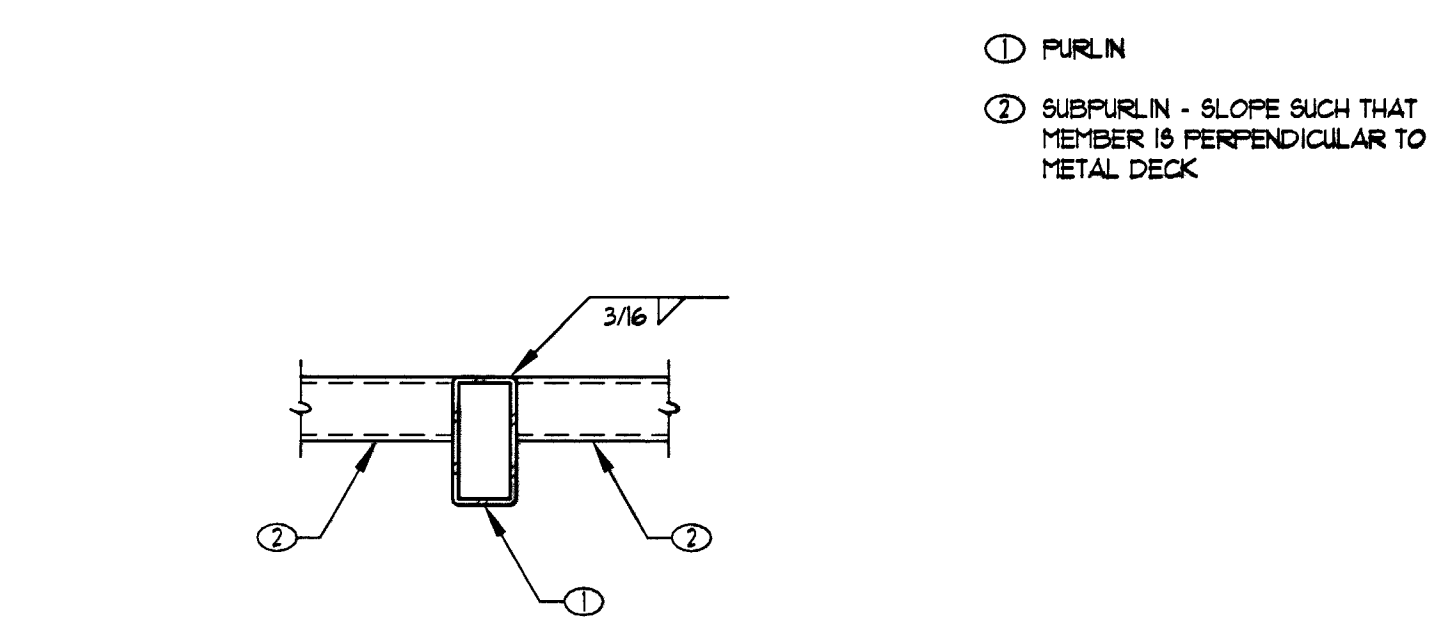


215 BANDSTAND FRAMING
26-20432 NO SCALE

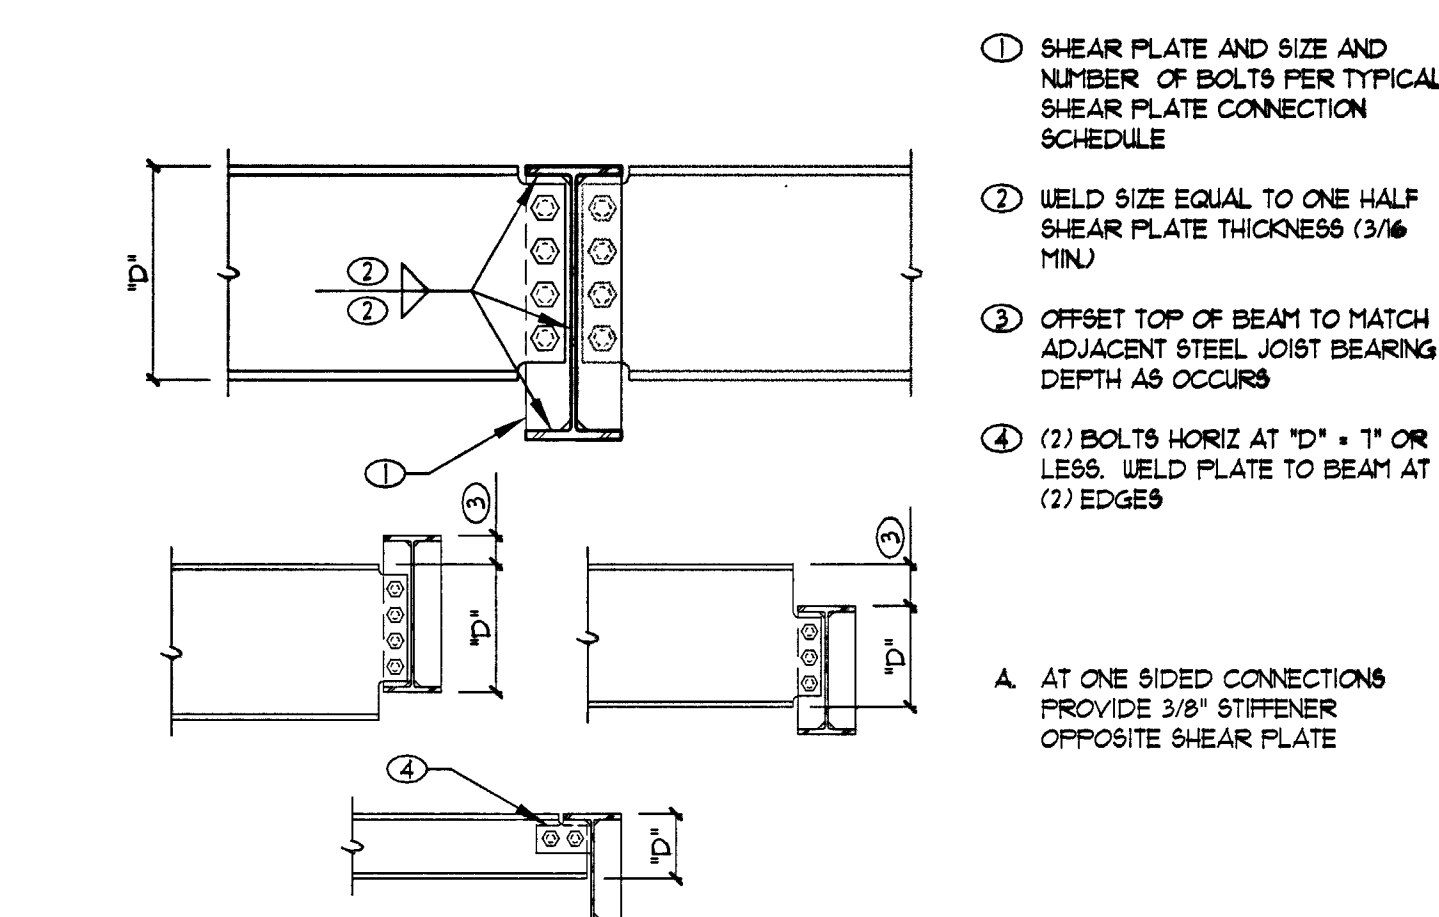


211 STEEL BEAM TO BEAM SHEAR PLATE CONNECTION
31-01-02 NO SCALE

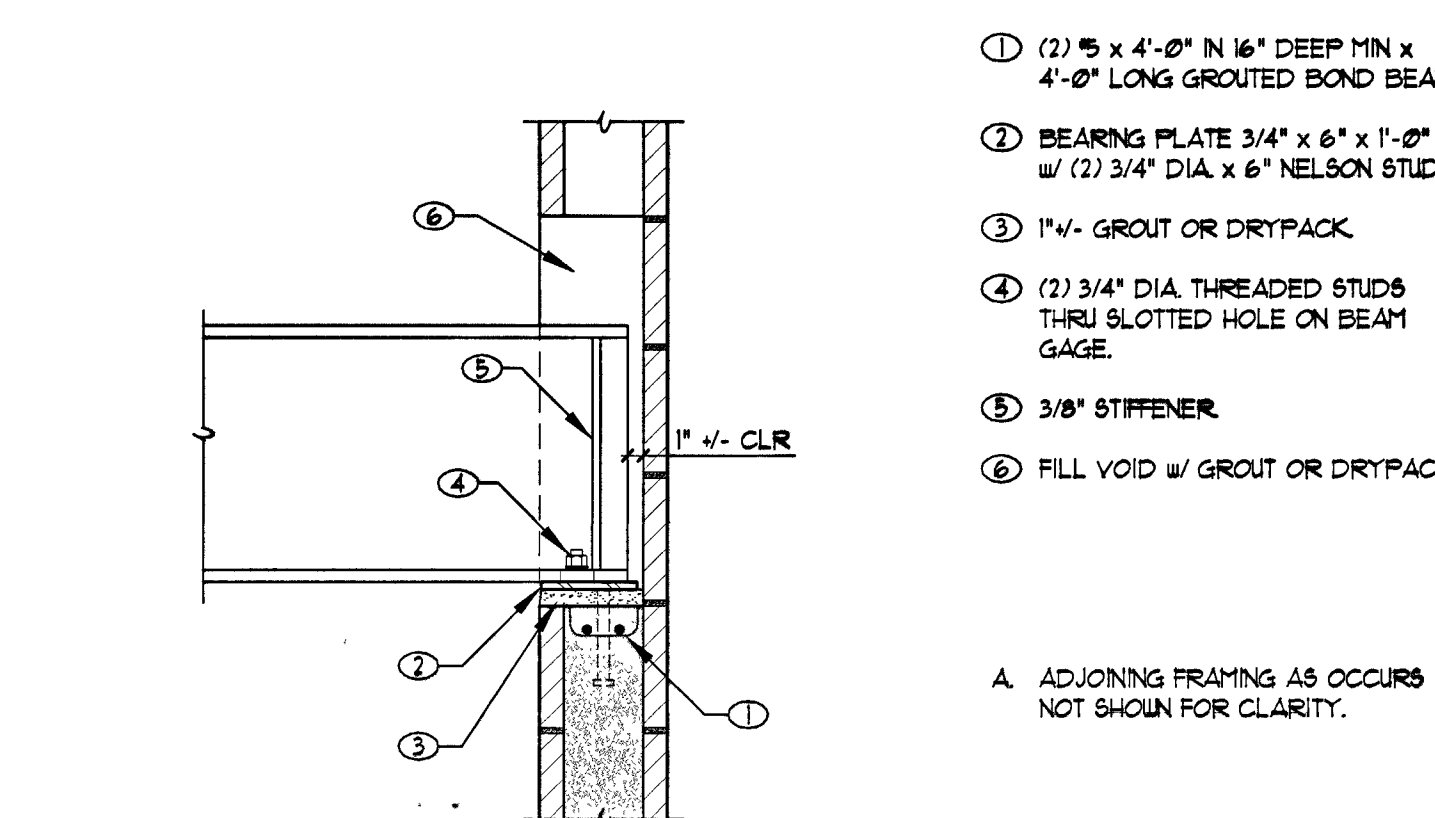


206 STEEL BEAM AT MASONRY WALL
31-01-01 NO SCALE

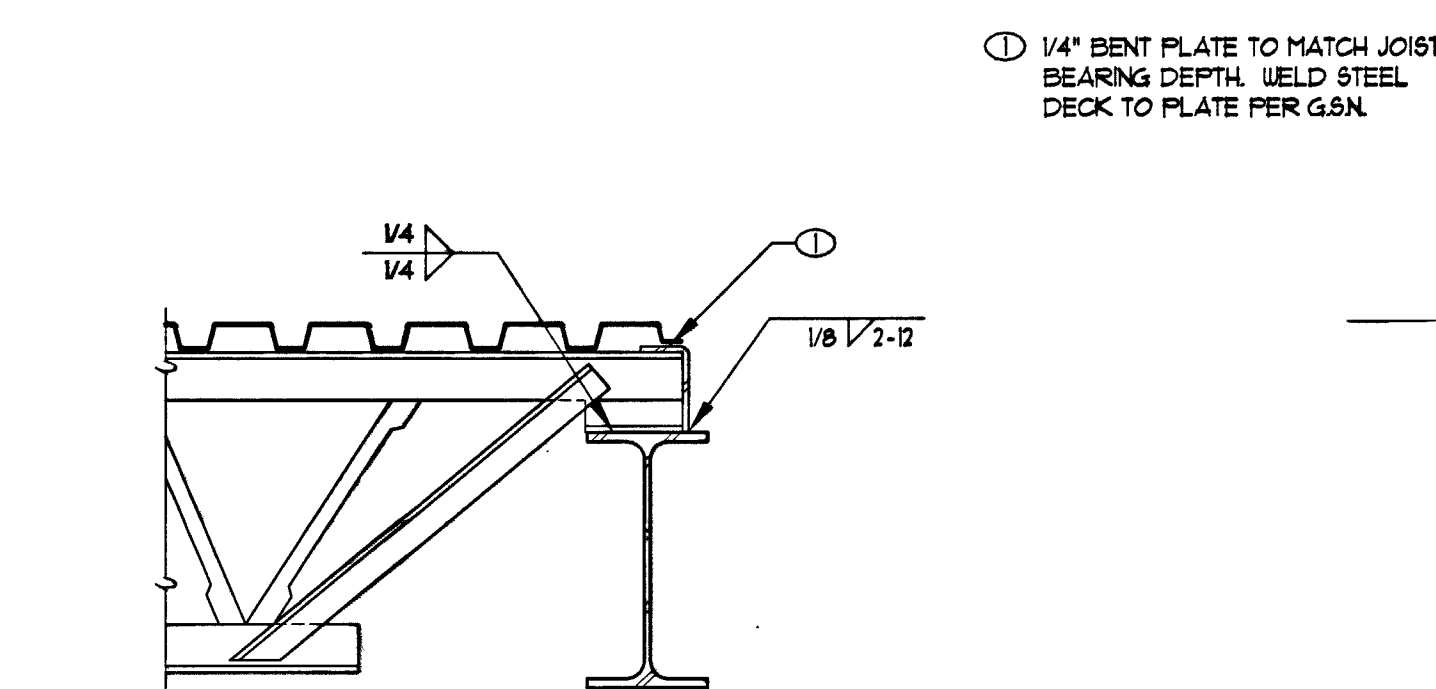


202 STEEL JOIST AT STEEL BEAM
31-01-02 NO SCALE

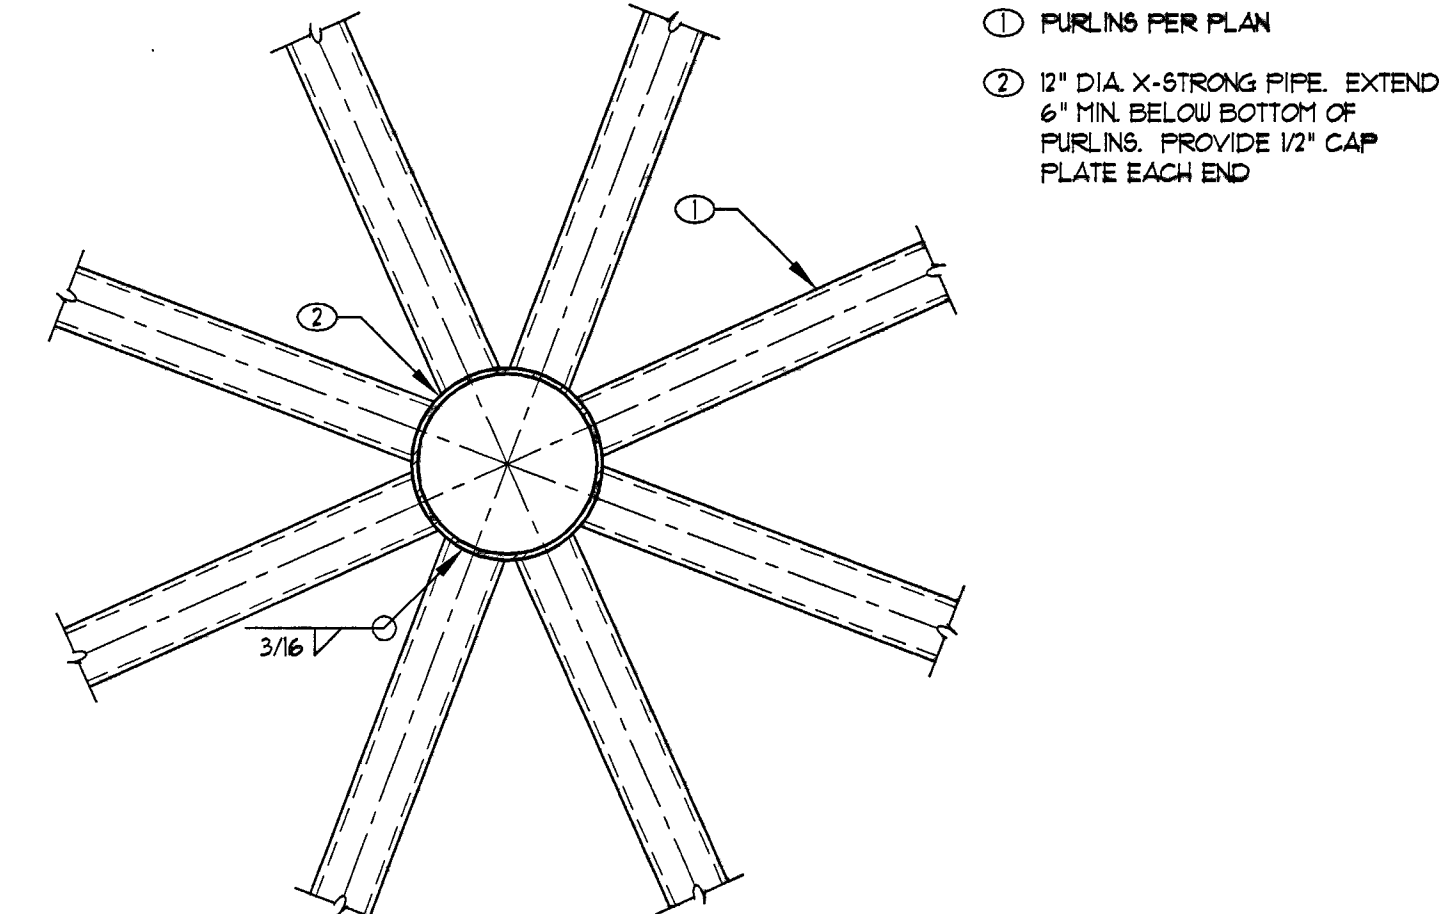


216 FRAMING AT BANDSTAND PEAK
26-20432 NO SCALE

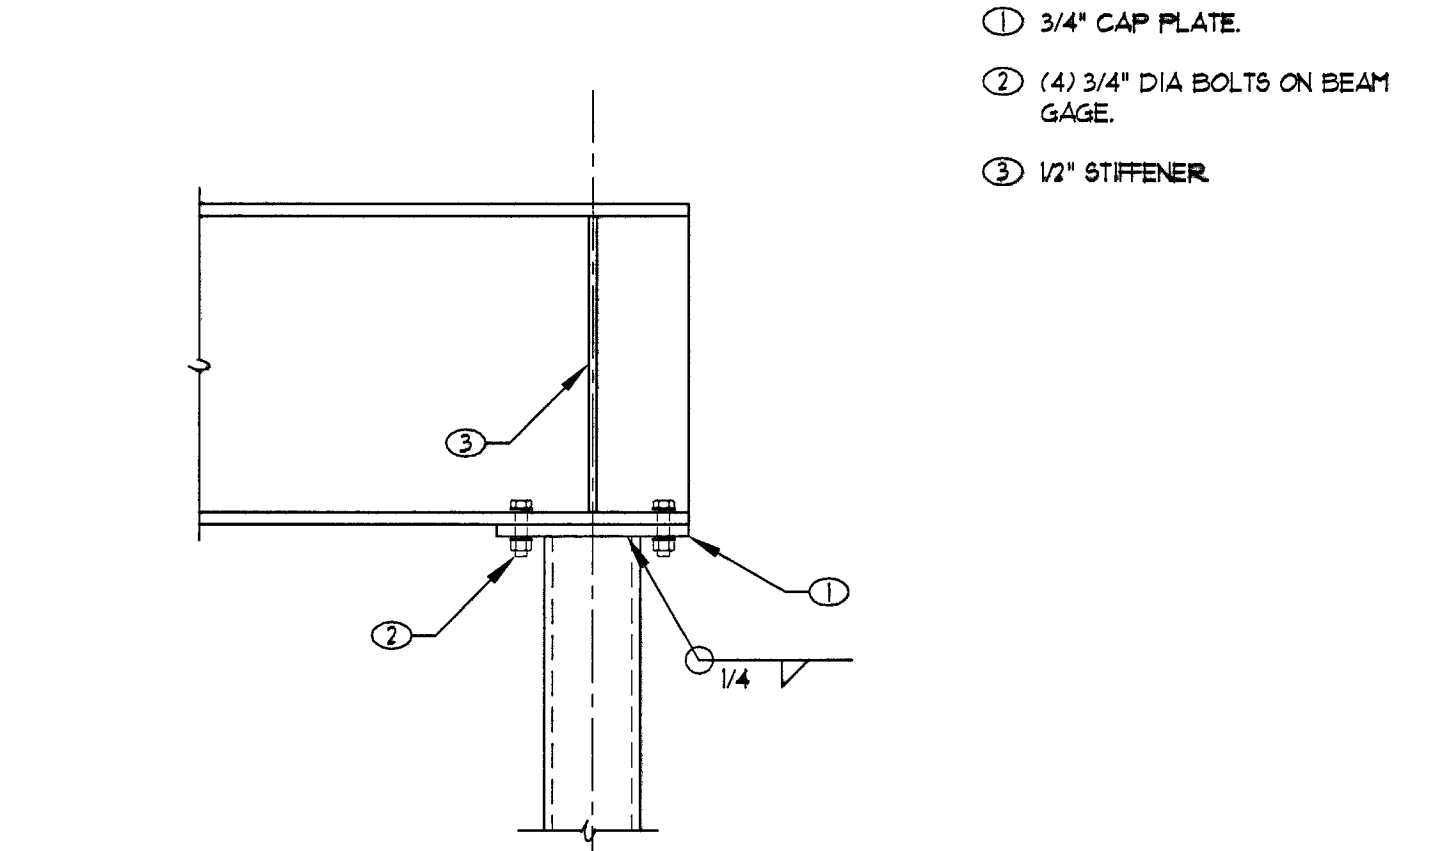


212 STEEL BEAM AT STEEL COLUMN
31-01-01 NO SCALE

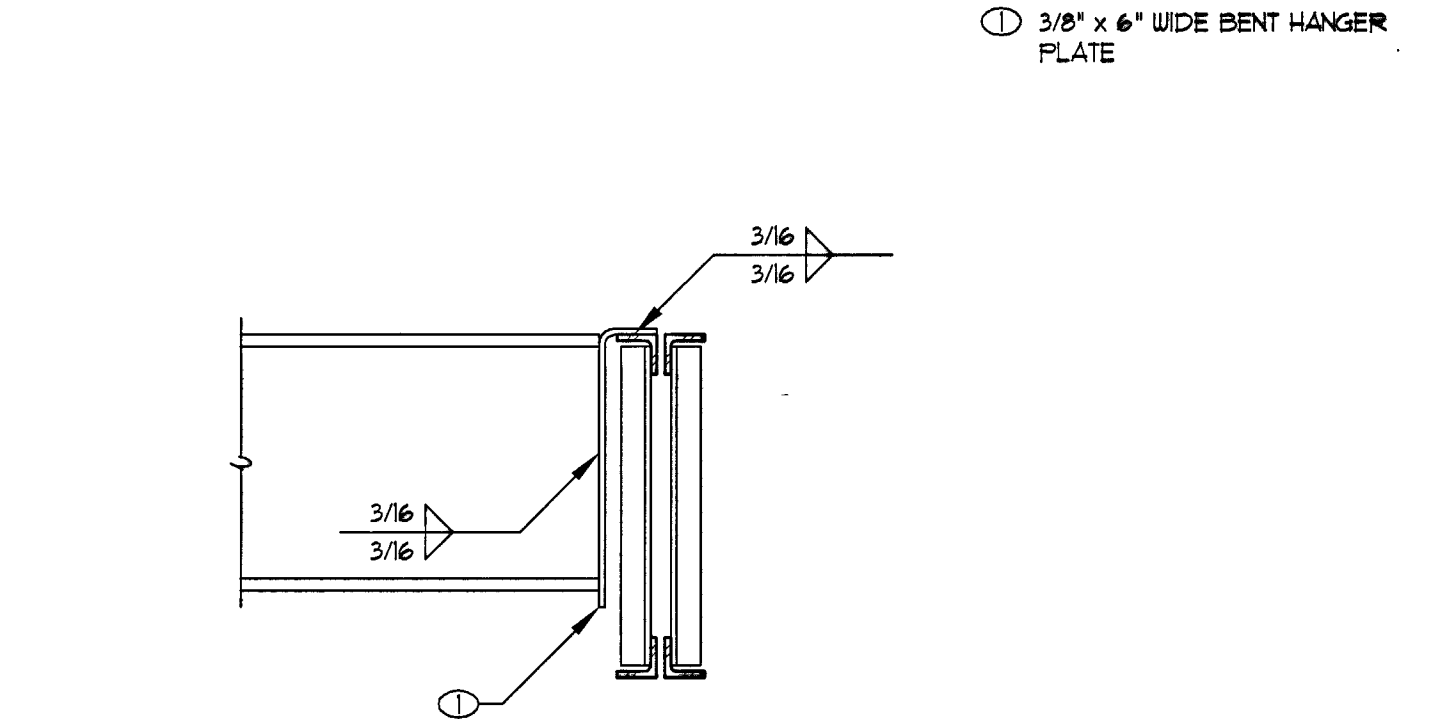


207 STEEL BEAM AT STEEL JOIST GIRDER
201-10432 NO SCALE

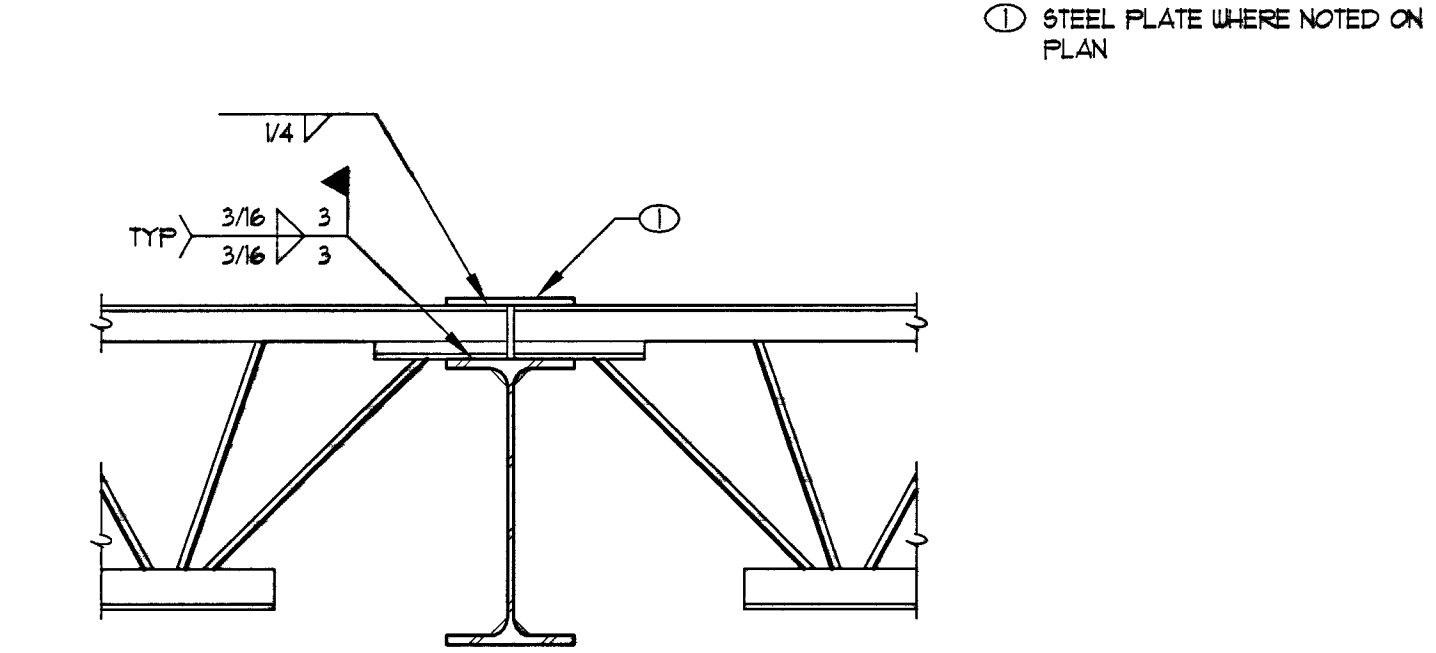


203 STEEL JOIST AT STEEL BEAM
31-01-02 NO SCALE

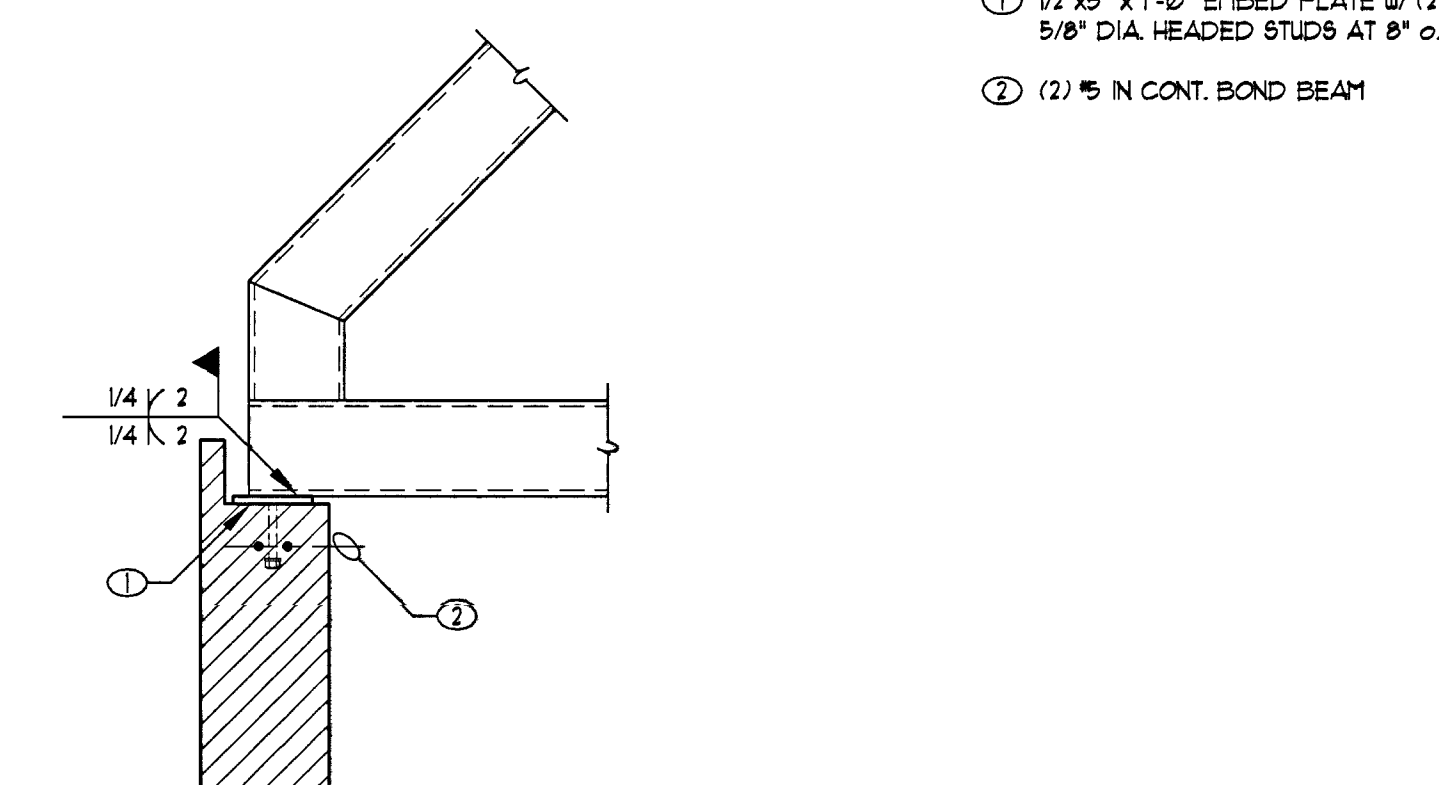


217 TRUSS TO WALL CONNECTION
21-20432 NO SCALE

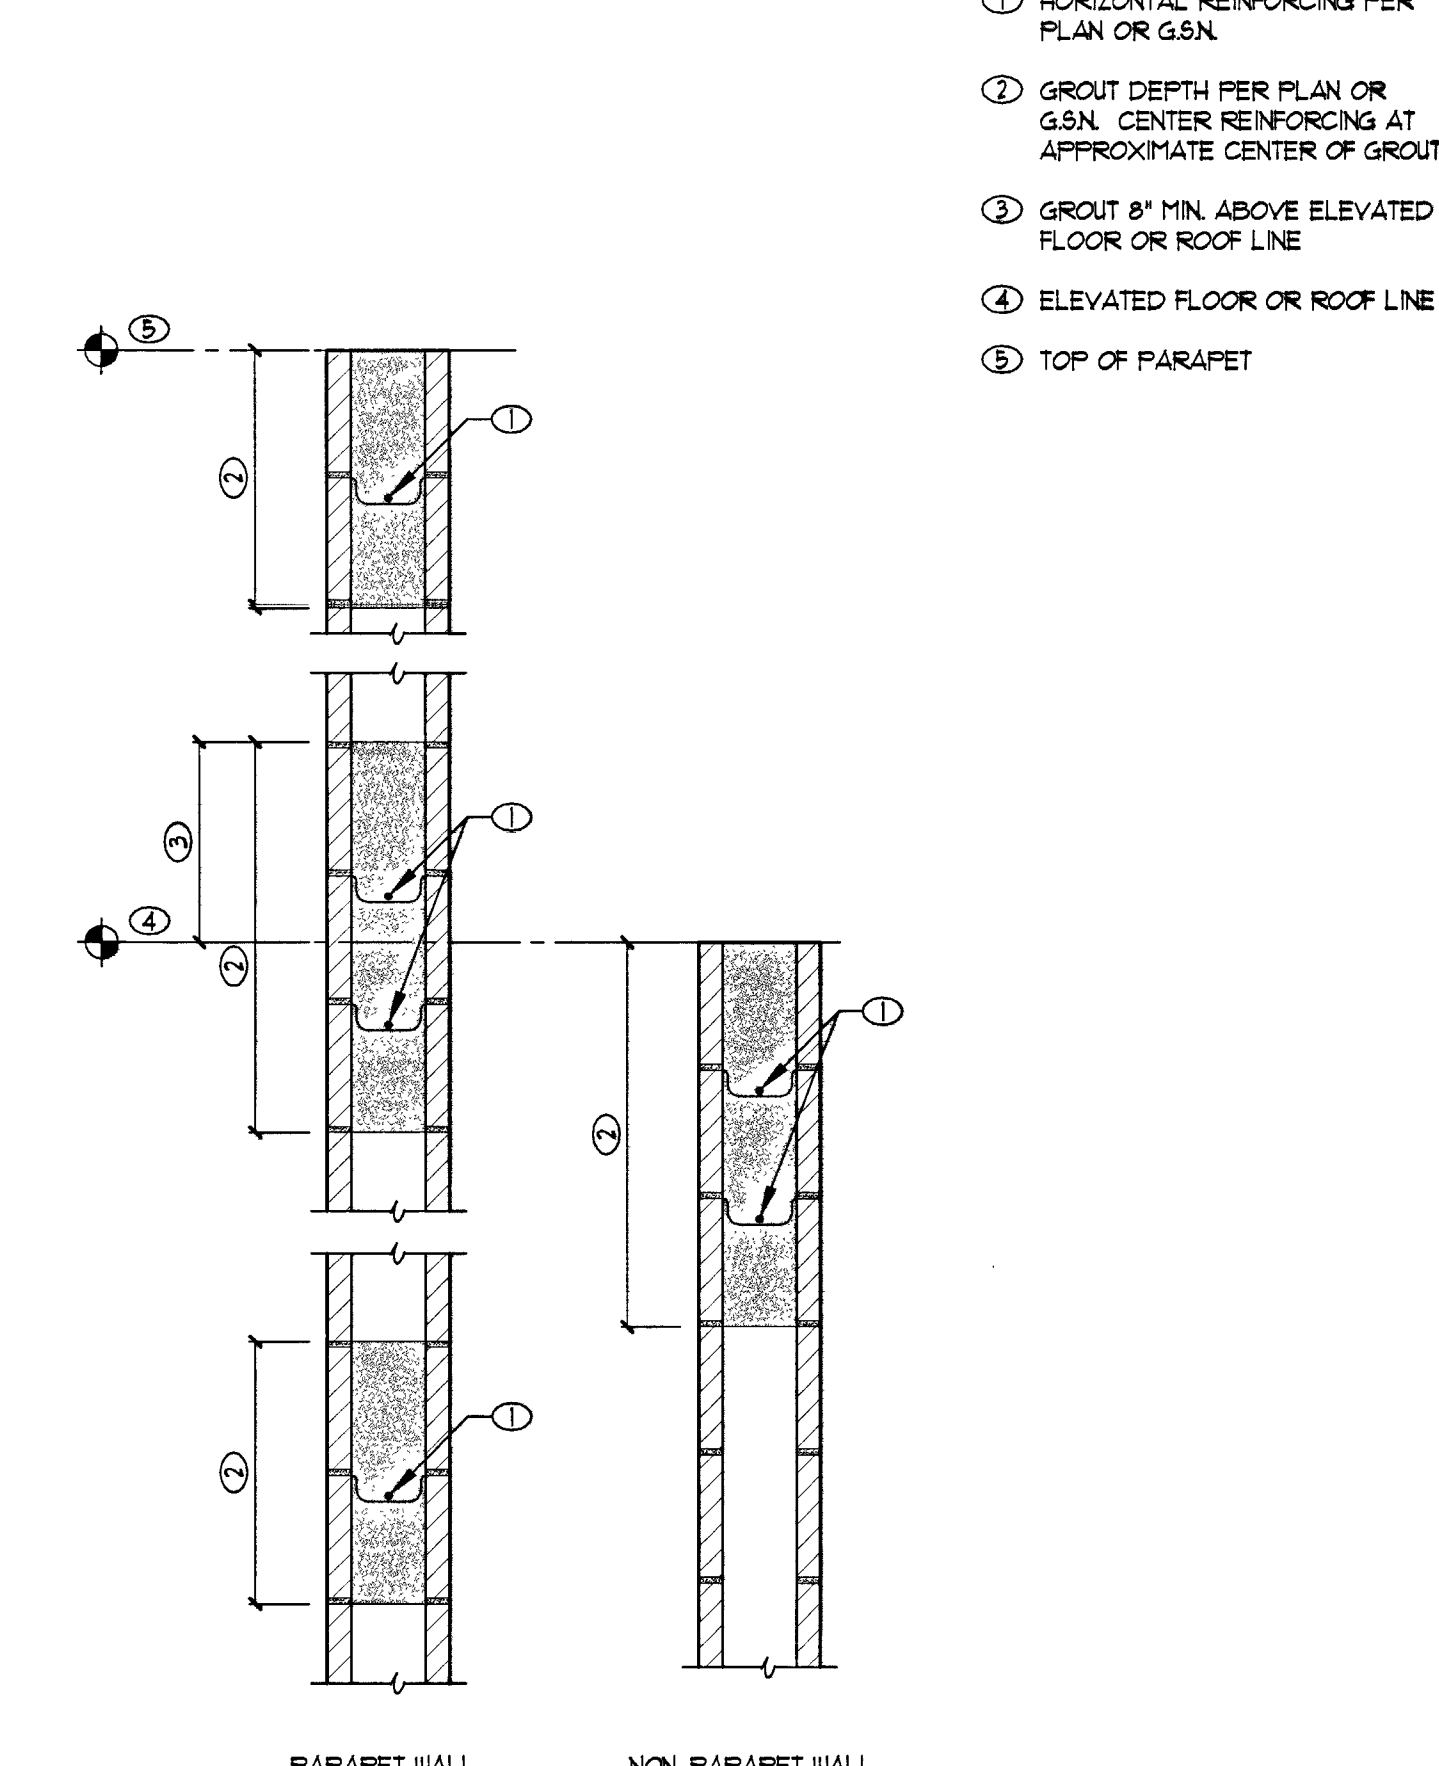


213 TYPICAL HORIZONTAL REINFORCING
21-01-01 NO SCALE

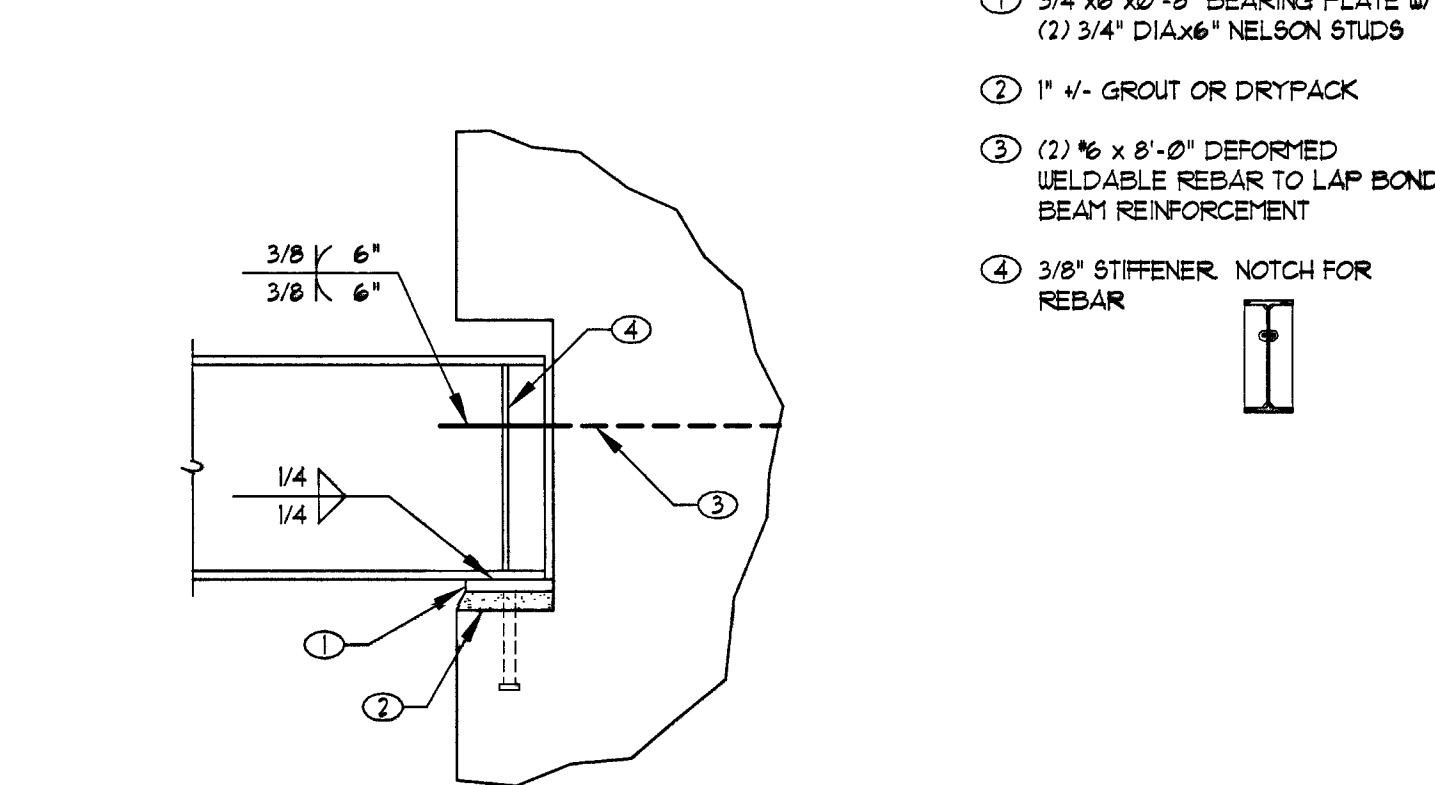


208 STEEL BEAM DRAG CONNECTION AT MASONRY WALL
31-01-06 NO SCALE

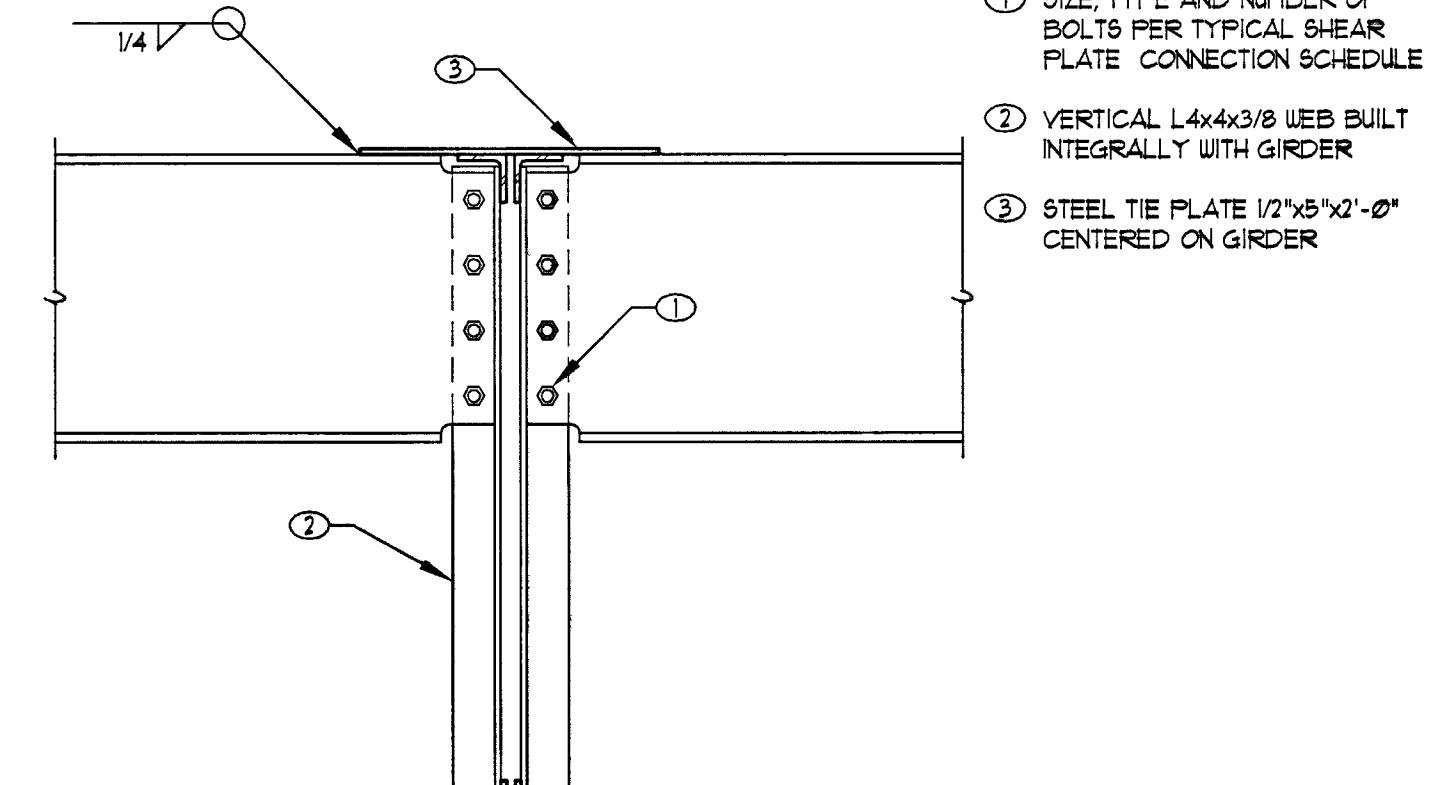

204 STEEL BEAM DRAG CONNECTION AT STEEL JOIST GIRDER
31-01-05 NO SCALE

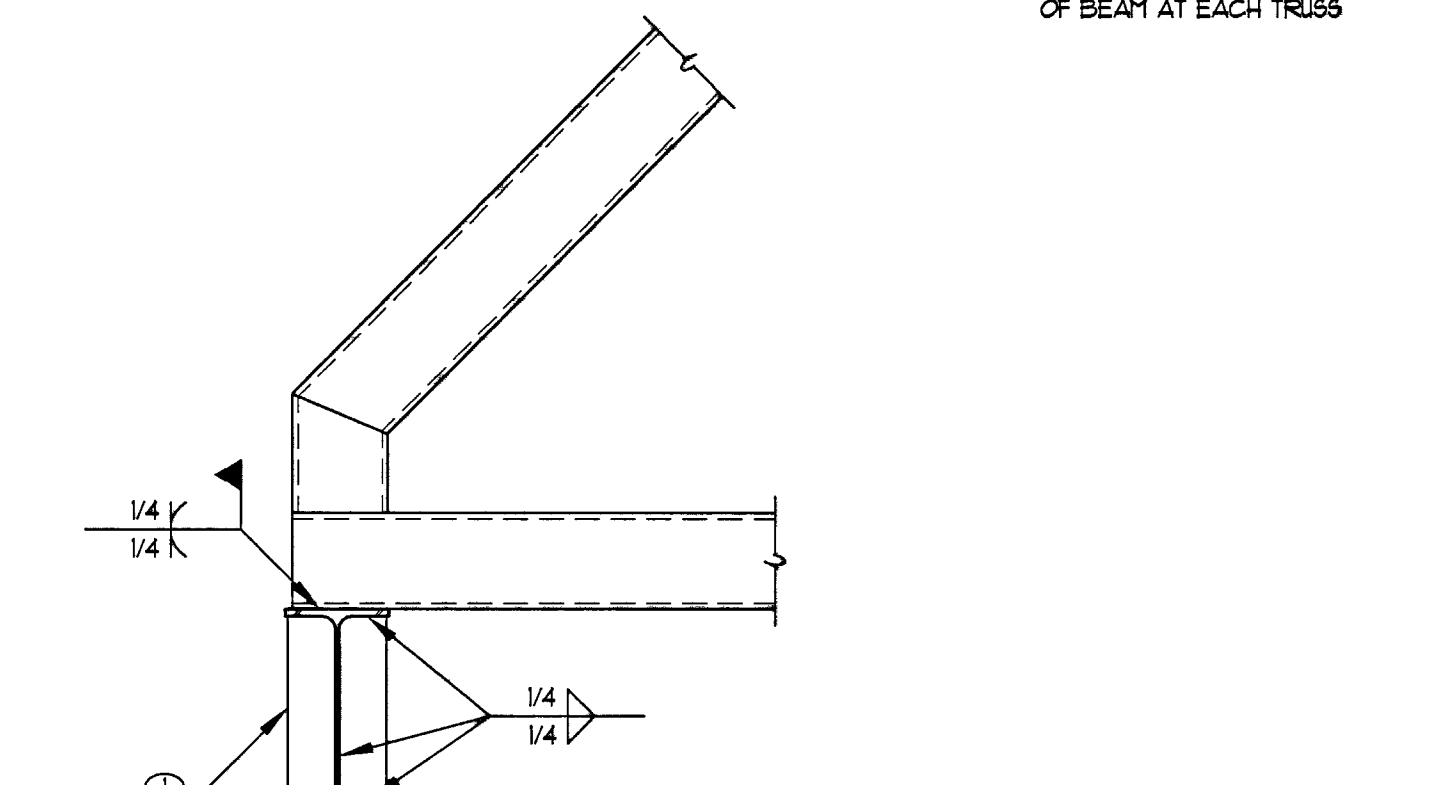

218 TRUSS TO BEAM CONNECTION
28-20432 NO SCALE

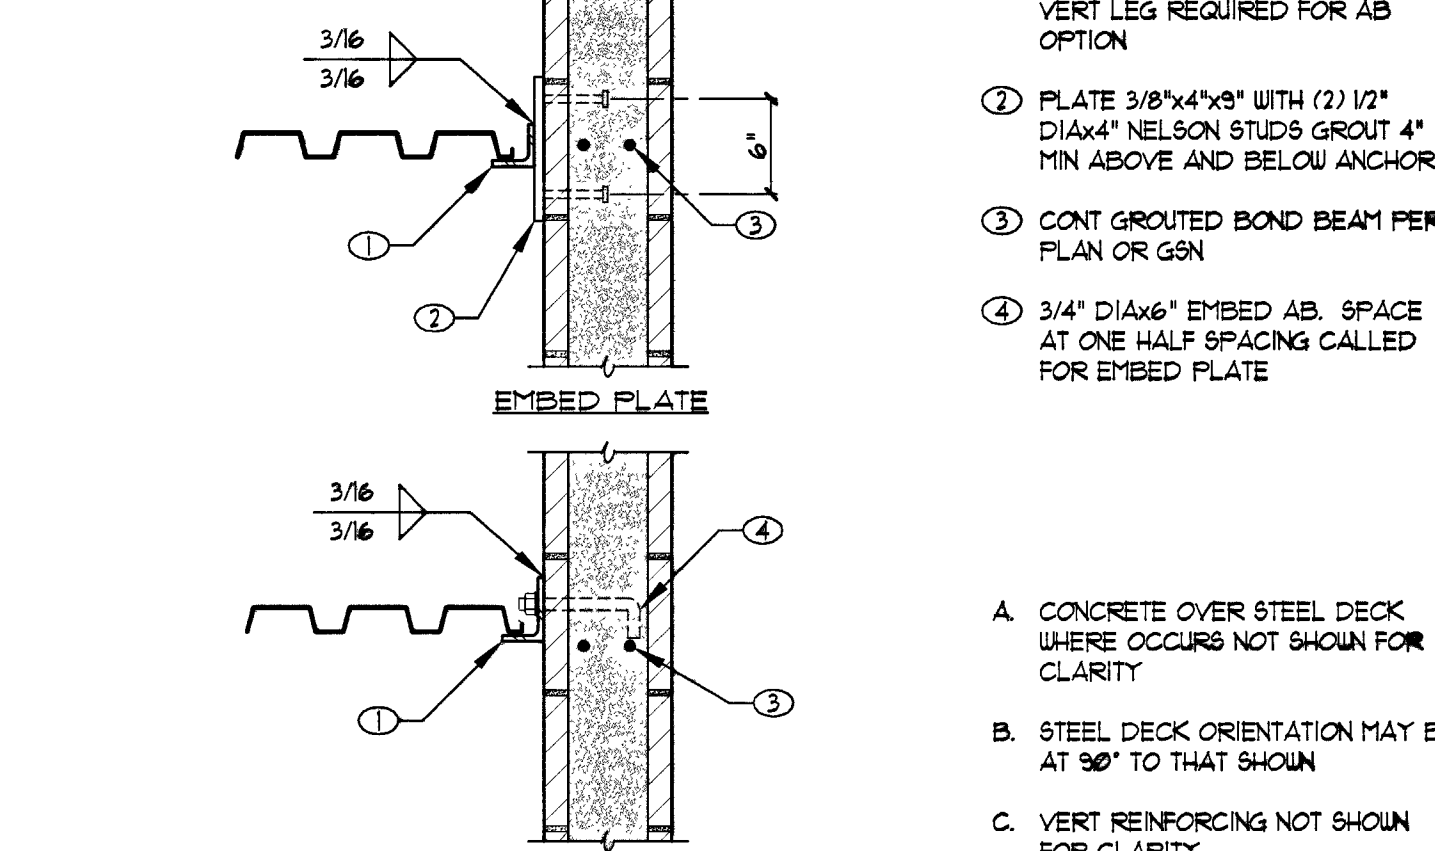

209 STEEL DECK AT MASONRY WALL
31-01-01 NO SCALE



200 STEEL JOIST AT STEEL BEAM
31-01-02 NO SCALE

RECORD DRAWING
May 20, 2003

WRIGHT
STRUCTURAL ENGINEERS, INC.
7310 Smoke Ranch Road, Suite P, Las Vegas, NV 89128
(702) 231-6600 Fax (702) 231-1144 www.wrightengineers.com



CITY OF LAS VEGAS
DEPARTMENT OF PUBLIC WORKS
ARCHITECTURAL SERVICES

OWNER: CITY OF LAS VEGAS
400 EAST STEWART AVENUE
LAS VEGAS, NEVADA 89101
PHONE: (702) 229-0339
FAX: (702) 229-3339
TDD: (702) 229-8104

DATE: August 2, 2001
SCALE: 1/4" = 1'-0"
NO. 01:13301.22
REV. 01:13301.22
FRAMING DETAILS

S4.1

East Las Vegas Community Center
Eastern and Stewart

JMA ARCHITECTURE STUDIOS
JMA ARCHITECTURE STUDIOS
11111 EASTERN AVENUE, SUITE 100
LAS VEGAS, NEVADA 89123