


P INTERIOR ELEVATION
3/16"=1'-0"



REVISIONS
CONSULTANT
JMA ARCHITECTURE STUDIOS
INTERIOR ARCHITECTURE

DEPARTMENT OF PUBLIC WORKS
East Las Vegas Community Center
Eastern and Stewart
Construction Documents

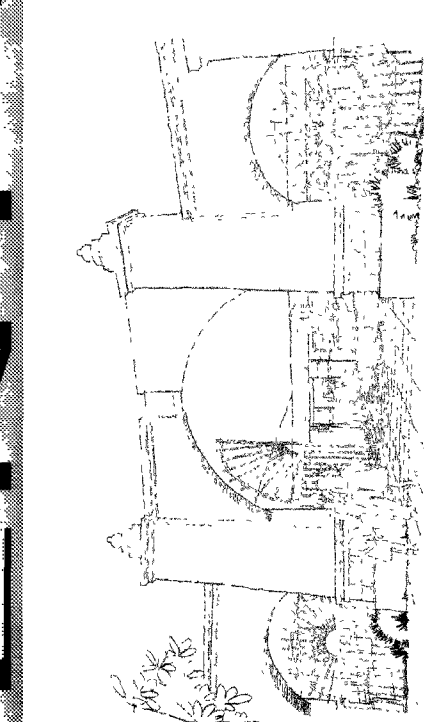

RECORD DRAWING
This record drawing, issued May 2, 2001, has been prepared, in part, based upon information furnished to JMA.
While the information is believed to be reliable, JMA Architecture Studio, cannot assume its accuracy, and shall not be responsible for the accuracy of the record drawing or for any action or inaction which may have been necessitated by its use.
Those relying on this record drawing are advised to obtain independent verification of its accuracy before relying on the information.

OWNER: CITY OF LAS VEGAS
DEPARTMENT OF PUBLIC WORKS
ARCHITECTURAL SERVICES
400 EAST STEWART AVENUE
LAS VEGAS, NEVADA 89101
PHONE: (702) 228-6234
FAX: (702) 388-3238
TDD: (702) 388-9108
DRAWN: N. Niccum
DATE: August 2, 2001
SCALE:
SHEET NO: 01.15301.22
DIVISION NO: 521-268

A9.15