

DEPARTMENT OF PUBLIC WORKS

OFFICE OF ARCHITECTURAL SERVICES



Mayor:
OSCAR B. GOODMAN

City Council:
GARY REESE
(Mayor Pro-Tem)
MICHAEL J. McDONALD
LARRY BROWN
LYNETTE B. McDONALD
LAWRENCE WEEKLY
MICHAEL MACK

City Manager:
VIRGINIA VALENTINE

Director of Public Works:
RICHARD D. GOECKE

Deputy Director of Public Works:
K. JOHN MCNELLIS, P.E.


LEISURE SERVICES DEPARTMENT

EAST LAS VEGAS COMMUNITY / SENIOR CENTER

APPROVED BY: _____ DATE: _____

K. John McNellis, P.E.
Deputy Director of Public Works
City of Las Vegas, Nevada

DEPARTMENT OF PUBLIC WORKS




REVISIONS

CONSULTANT

JMA ARCHITECTURE STUDIOS

East Las Vegas Community Center
Eastern and Stewart
Construction Documents

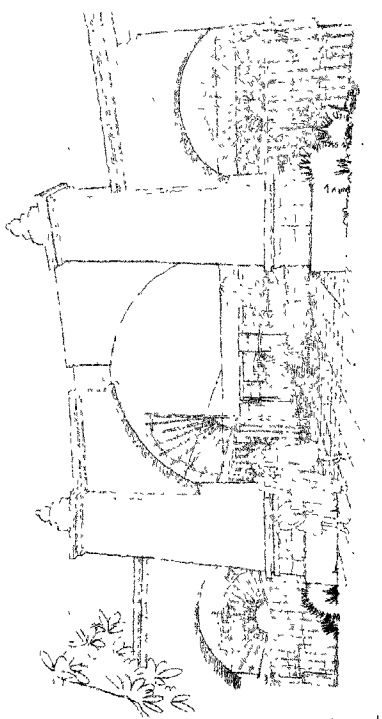

STAMP

RECORD DRAWING

The record drawing, dated May 12, 2001, has been prepared, in part, based upon information furnished by owner.

While this information is believed to be reliable, JMA Architecture Studios, cannot assume its accuracy, and there is no responsibility for the accuracy of the record drawing or for any errors or omissions which may have been incorporated into the record.

Those relying on this record drawing are advised to obtain independent verification of its accuracy before relying on the same.

OWNER: CITY OF LAS VEGAS
DEPARTMENT OF PUBLIC WORKS
ARCHITECTURAL SERVICES

400 EAST STEWART AVENUE
LAS VEGAS, NEVADA 89101
PHONE: (702) 258-8038
FAX: (702) 258-8039
TDD: (702) 388-8108

DRWN: M. Phillips

DATE: August 2, 2001

SCALE:

DIS NO: 01.15301.22

CU Dwg NO: 021-268

SHR NO:

A0.00

DRAWINGS AND INSTRUMENTS OF SERVICE ARE THE PROPERTY OF THE DESIGN PROFESSIONAL WHOSE STAMP OF CERTIFICATION APPEARS ON THE DRAWINGS AND SPECIFICATIONS RETAINED BY THE CLIENT. NO REPRODUCTION, IN WHOLE OR IN PART, WITHOUT WRITTEN CONSENT IS EXPRESSLY PROHIBITED. COPIES OF THE DRAWINGS AND SPECIFICATIONS RETAINED BY THE CLIENT MAY BE UTILIZED ONLY FOR DISCUSSING THE PROJECT FOR WHICH THEY WERE PREPARED AND NOT FOR THE CONSTRUCTION OF THE PROJECT.