


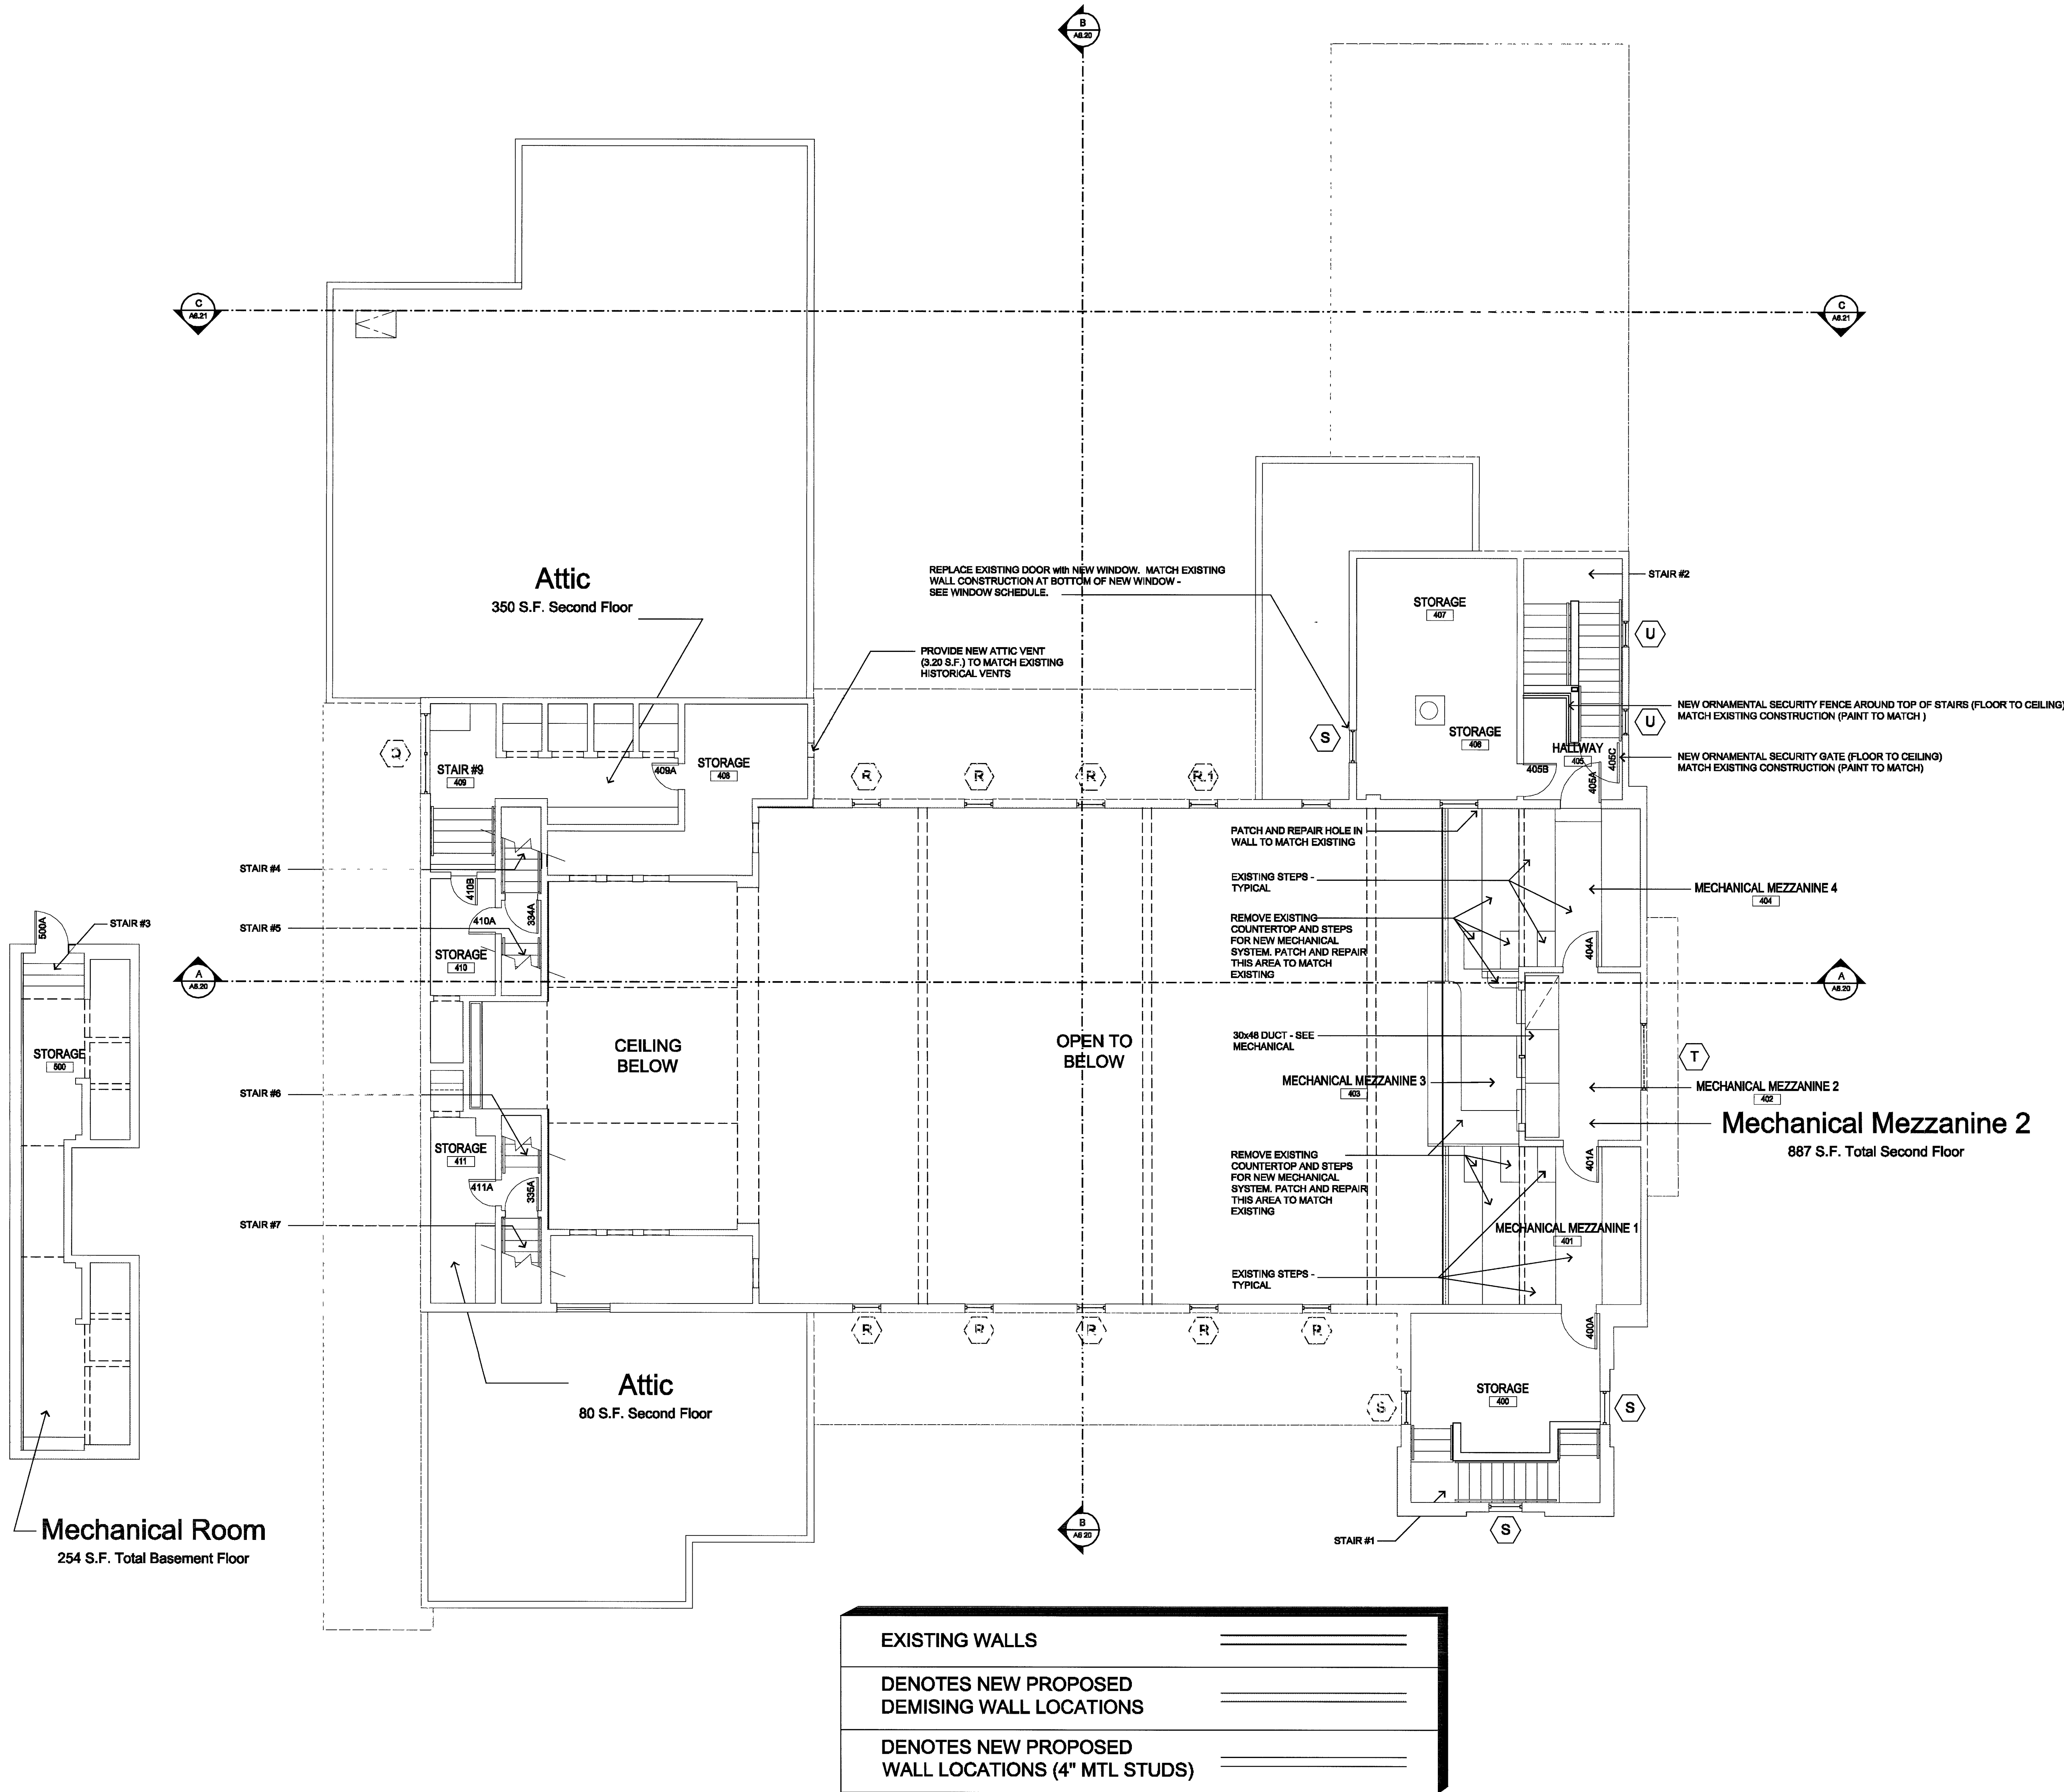

95863
BUILDING 3 - SECOND FLOOR PLAN
3/16"=1'-0"

PROJECT

8/24/04 Plan Check (Arch.)
7/14/04 Plan Check (Arch.)
8/27/04 Plan Check (Arch.)

CONSULTANT

JMA ARCHITECTURE STUDIOS
16158 E. 18TH AVE. #205
DENVER, CO 80202
TEL: (303) 733-8811
FAX: (303) 733-8812
WWW.JMA-ARCH.COM

RECORD DRAWING

The record drawing issued December 28, 2004 has been prepared in part based upon information furnished by others.

While this information is believed to be reliable, JMA Architecture Studios cannot assume its accuracy and thus is not responsible for the accuracy of the record drawing in the event of any errors or omissions which may have been incorporated into the record.

Those relying on this record document are advised to obtain independent verification of its accuracy before applying it for any purpose.

DOWNTOWN SENIOR SERVICES CENTER
NEIGHBORHOOD SERVICES
CITY OF LAS VEGAS

BID SET

OWNER: CITY OF LAS VEGAS
DEPARTMENT OF PUBLIC WORKS
ARCHITECTURAL SERVICES

400 EAST STEWART AVENUE
LAS VEGAS, NEVADA 89101
PHONE: (702) 330-6333
FAX: (702) 362-3232
TDD: (702) 366-9108

OWNER B. Bullock
DATE September 8, 2004
SCALE 3/16" = 1'-0"
REV 04.18.04.01
CU DWG NO 821-287
REV Second Floor Plan

BUILDING 3

A2.13