




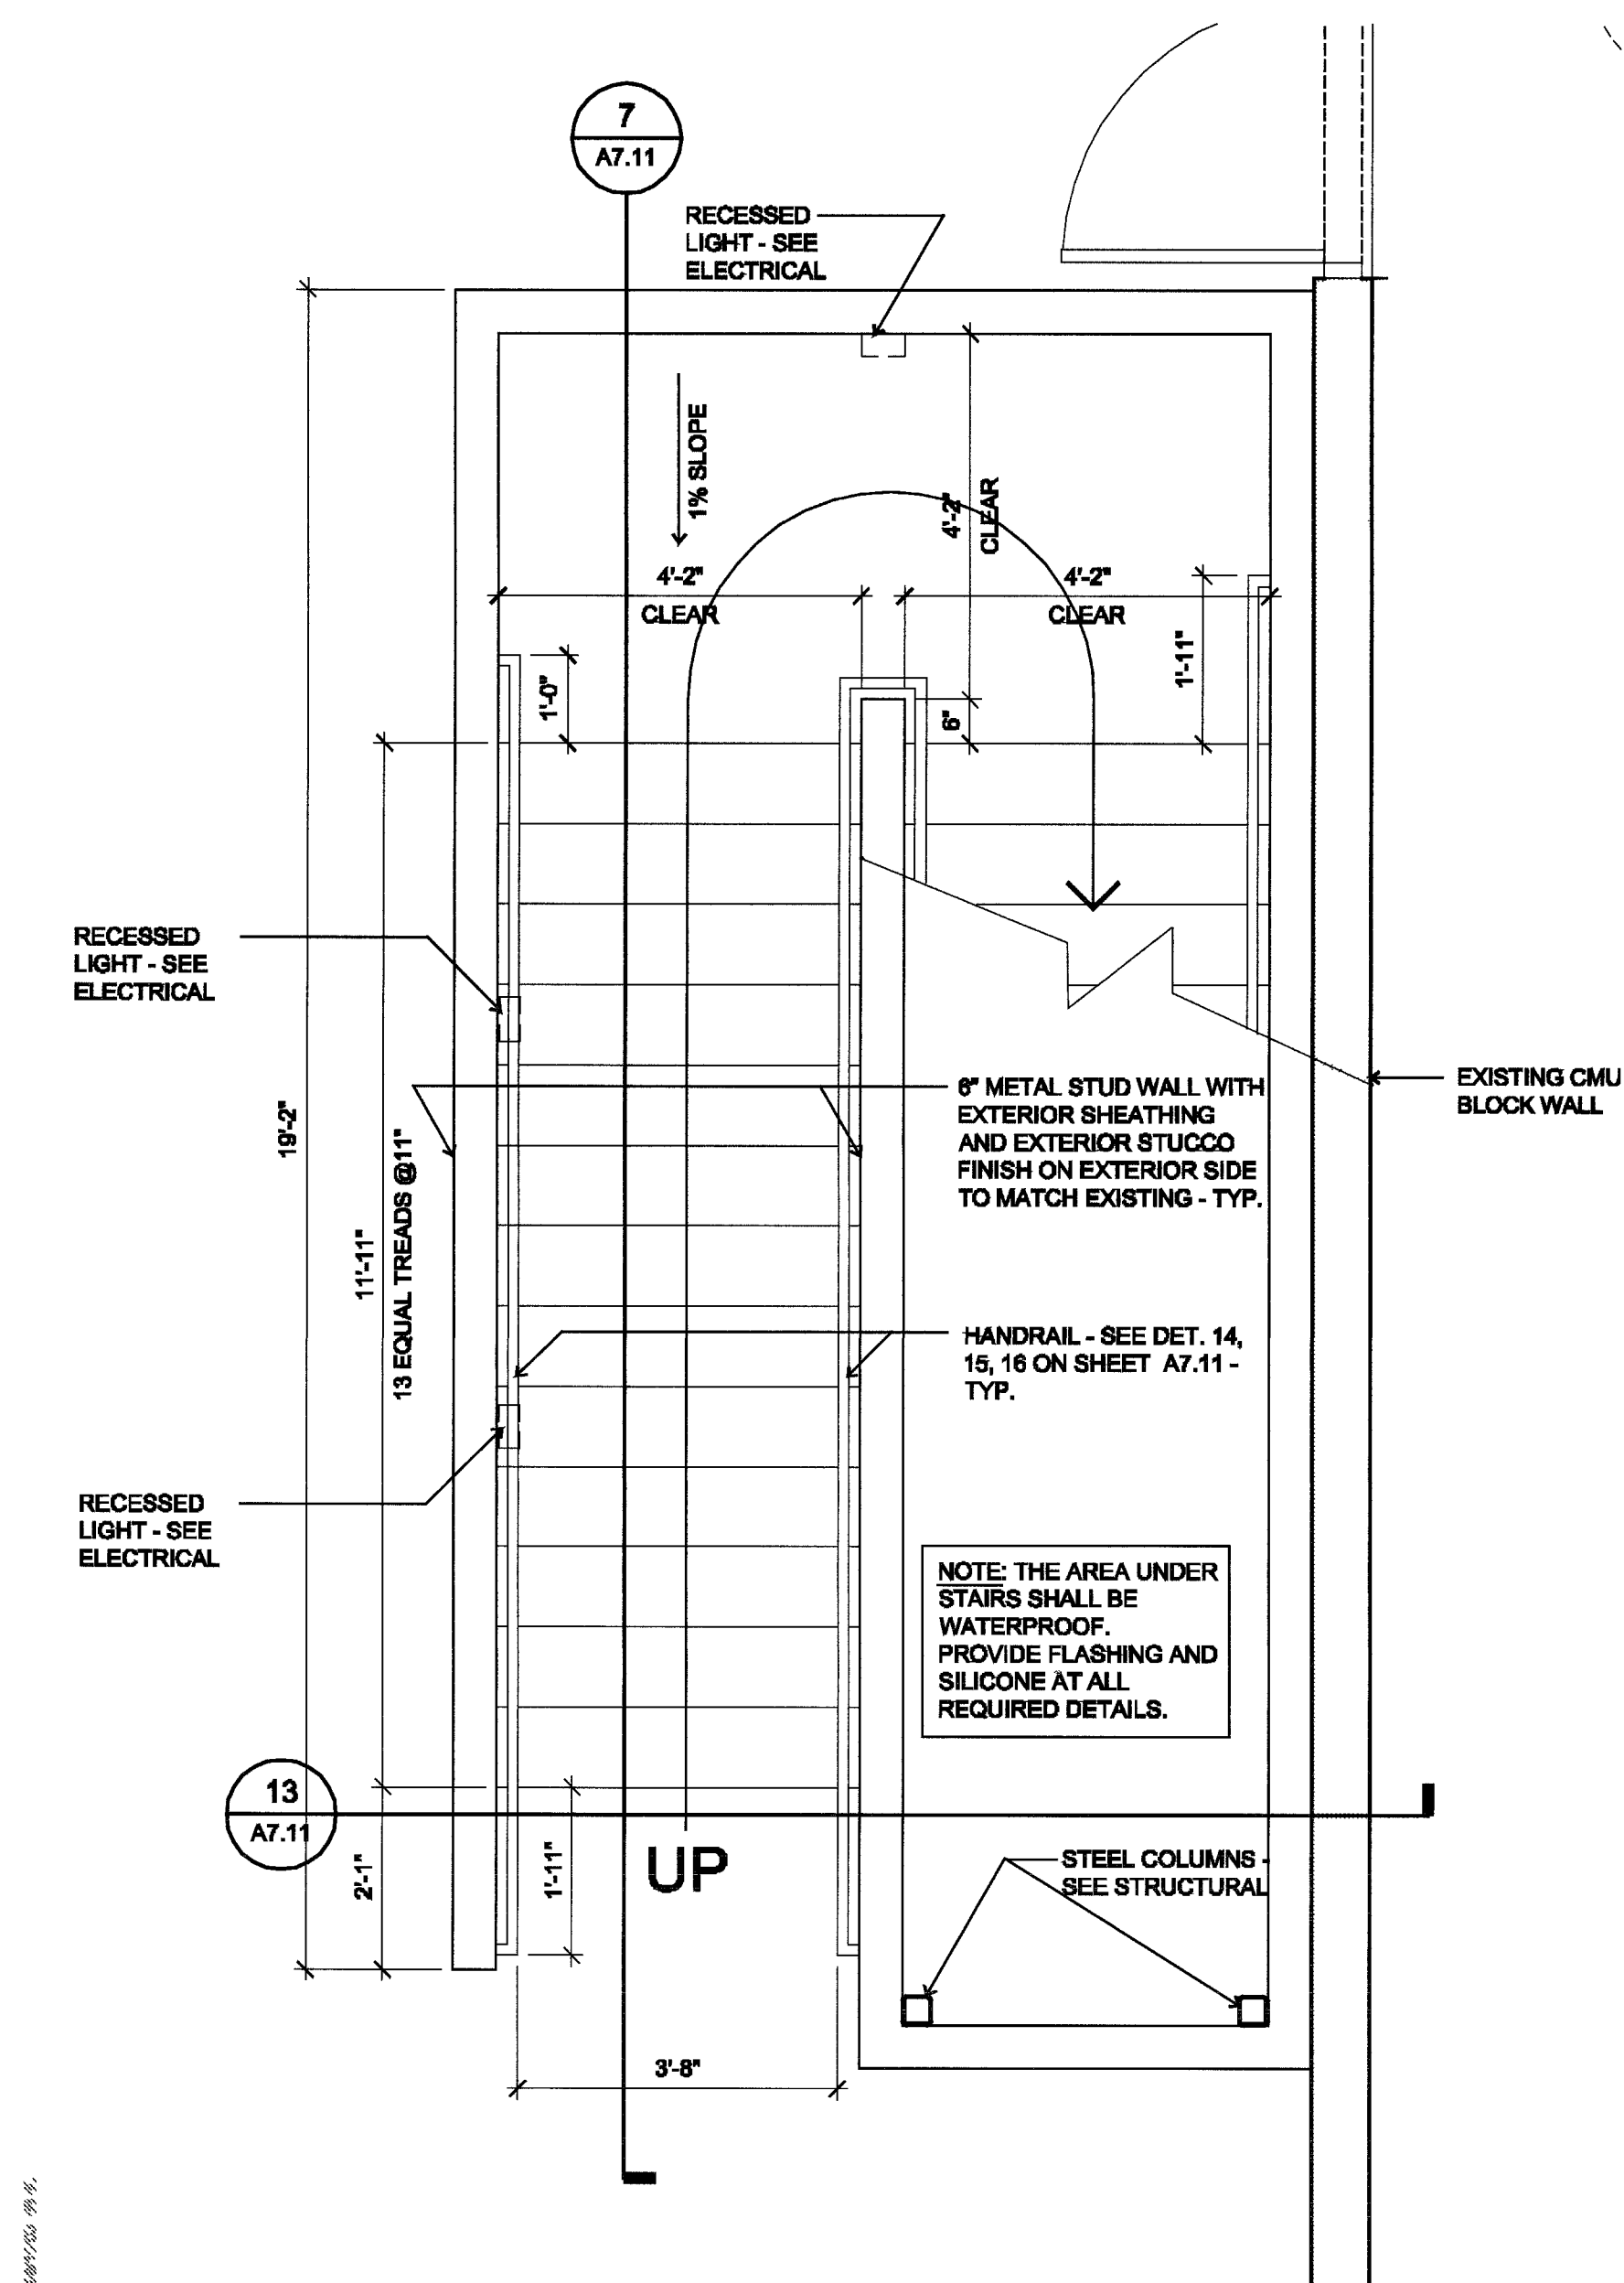


5 ENLARGED STAIR PLAN AT FIRST FLOOR
1/2"=1'-0"

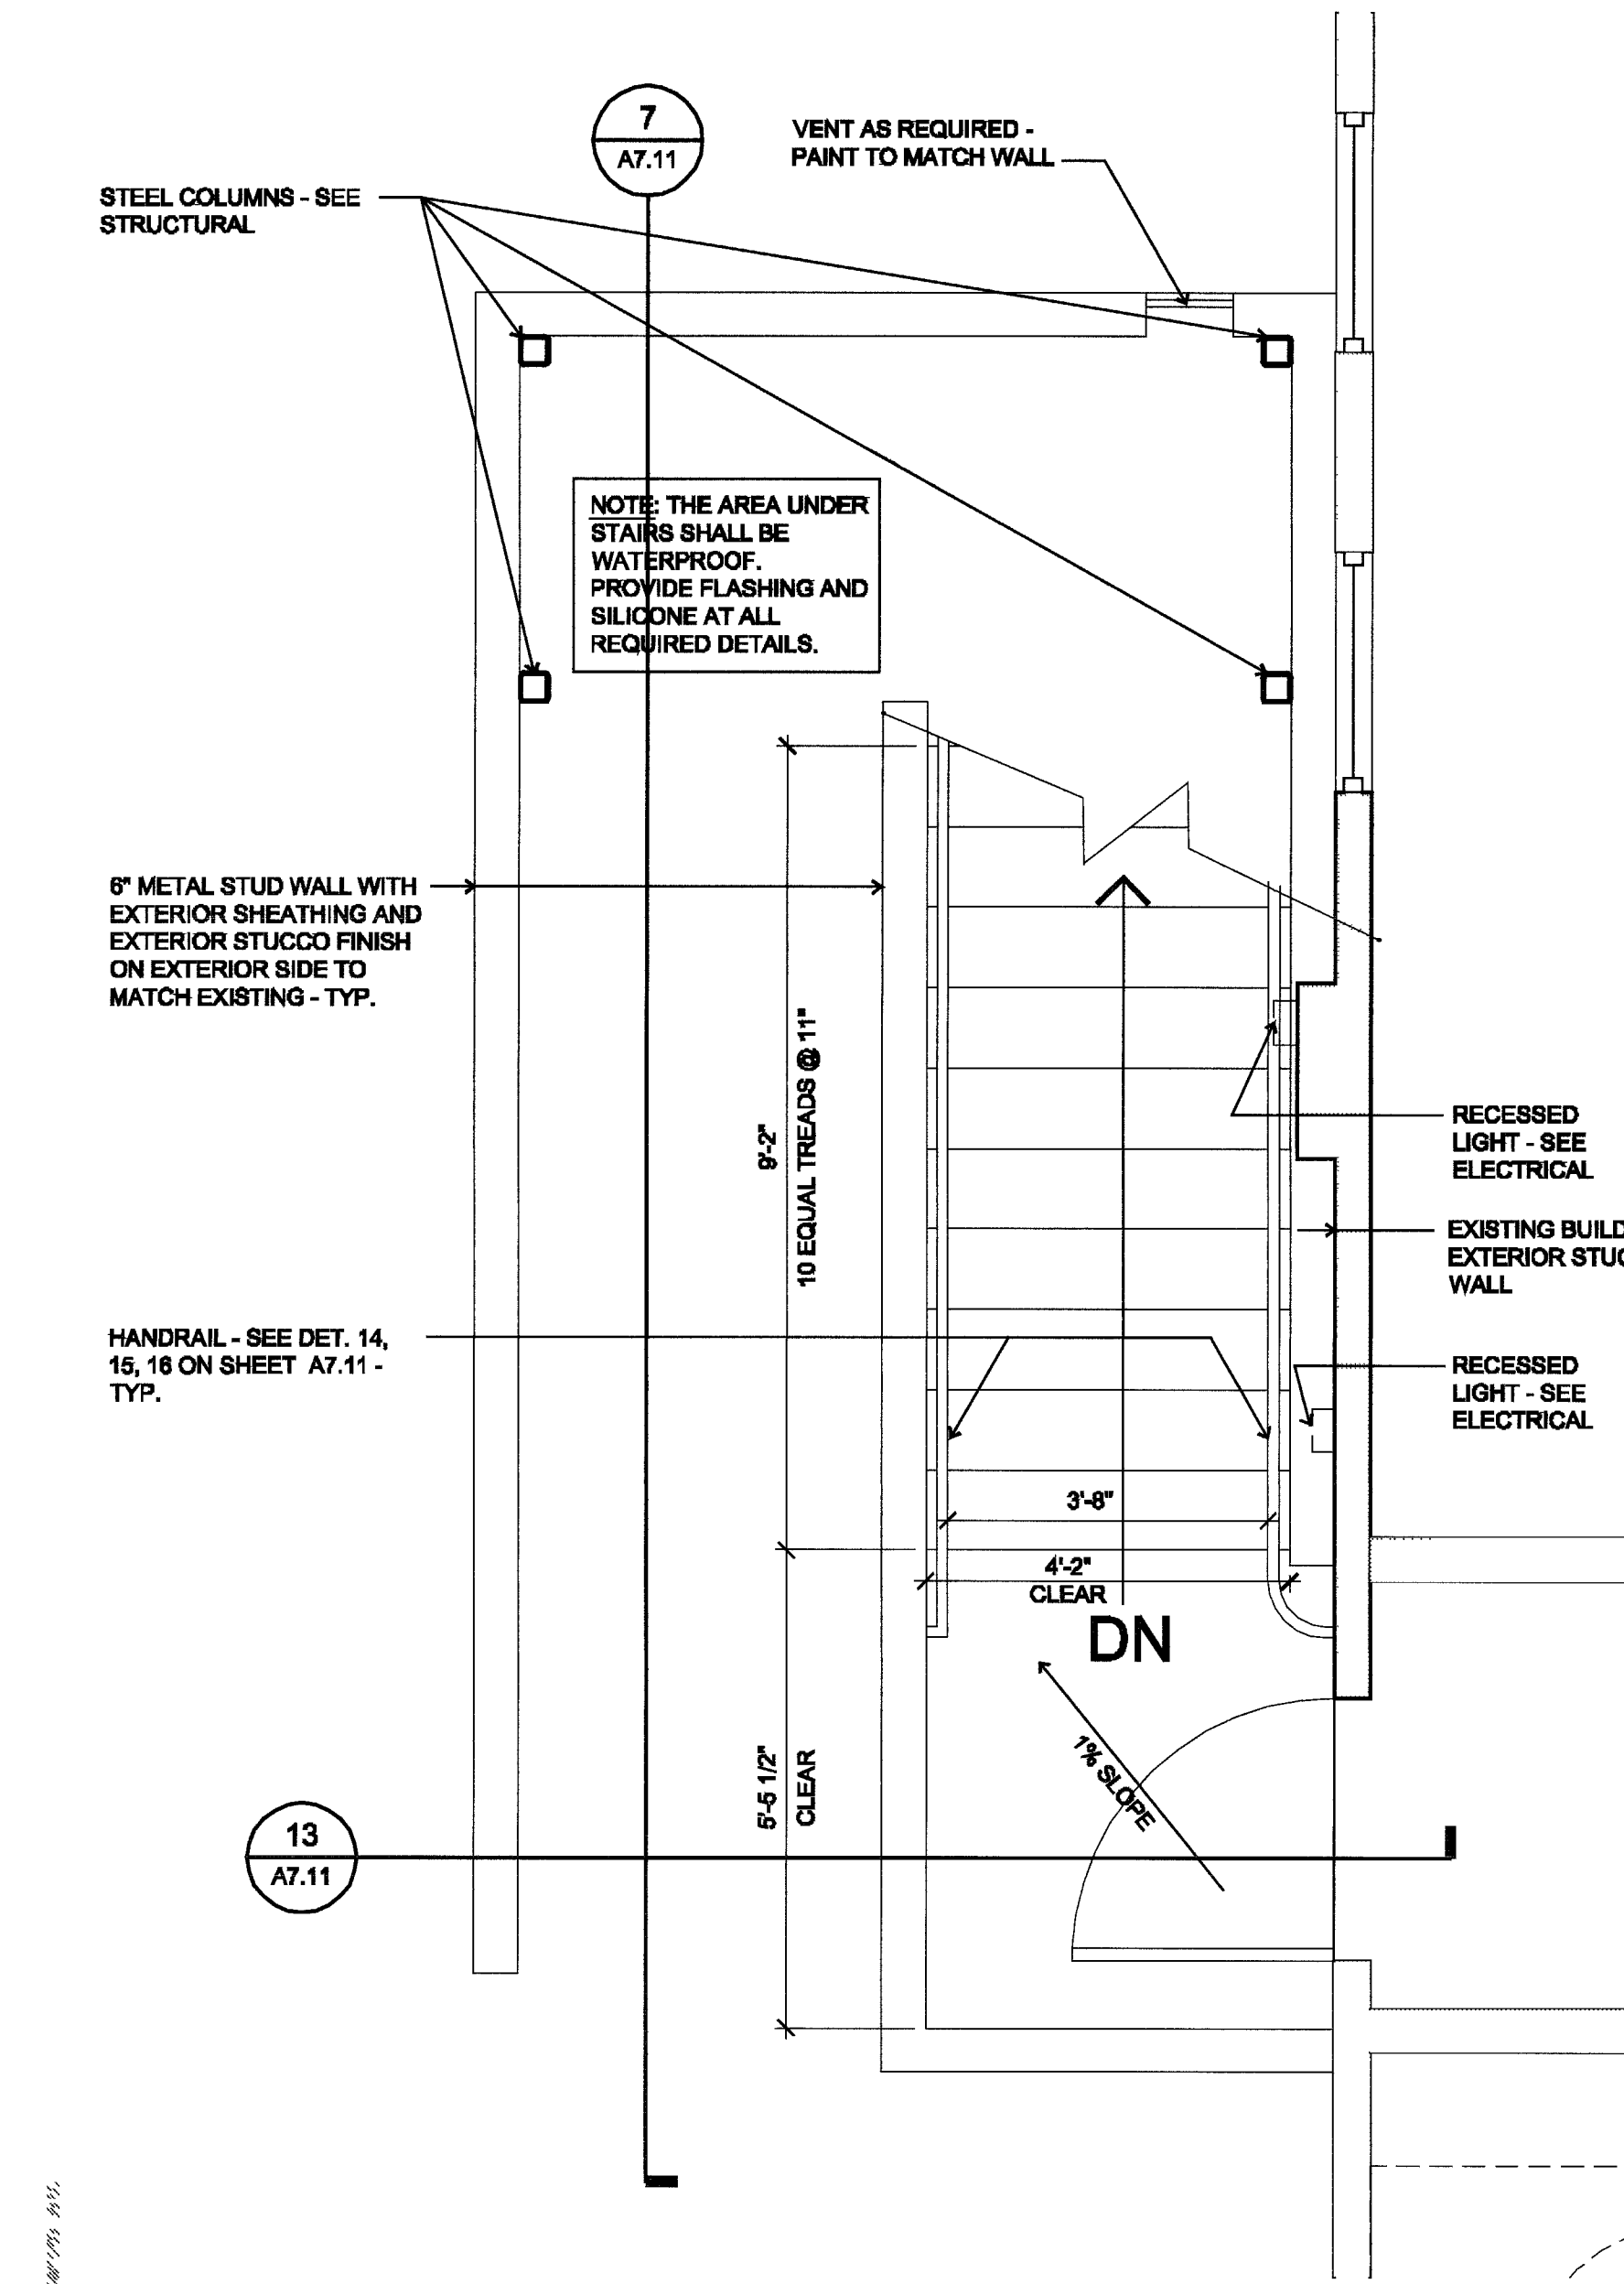


6 ENLARGED STAIR PLAN AT SECOND FLOOR
1/2"=1'-0"

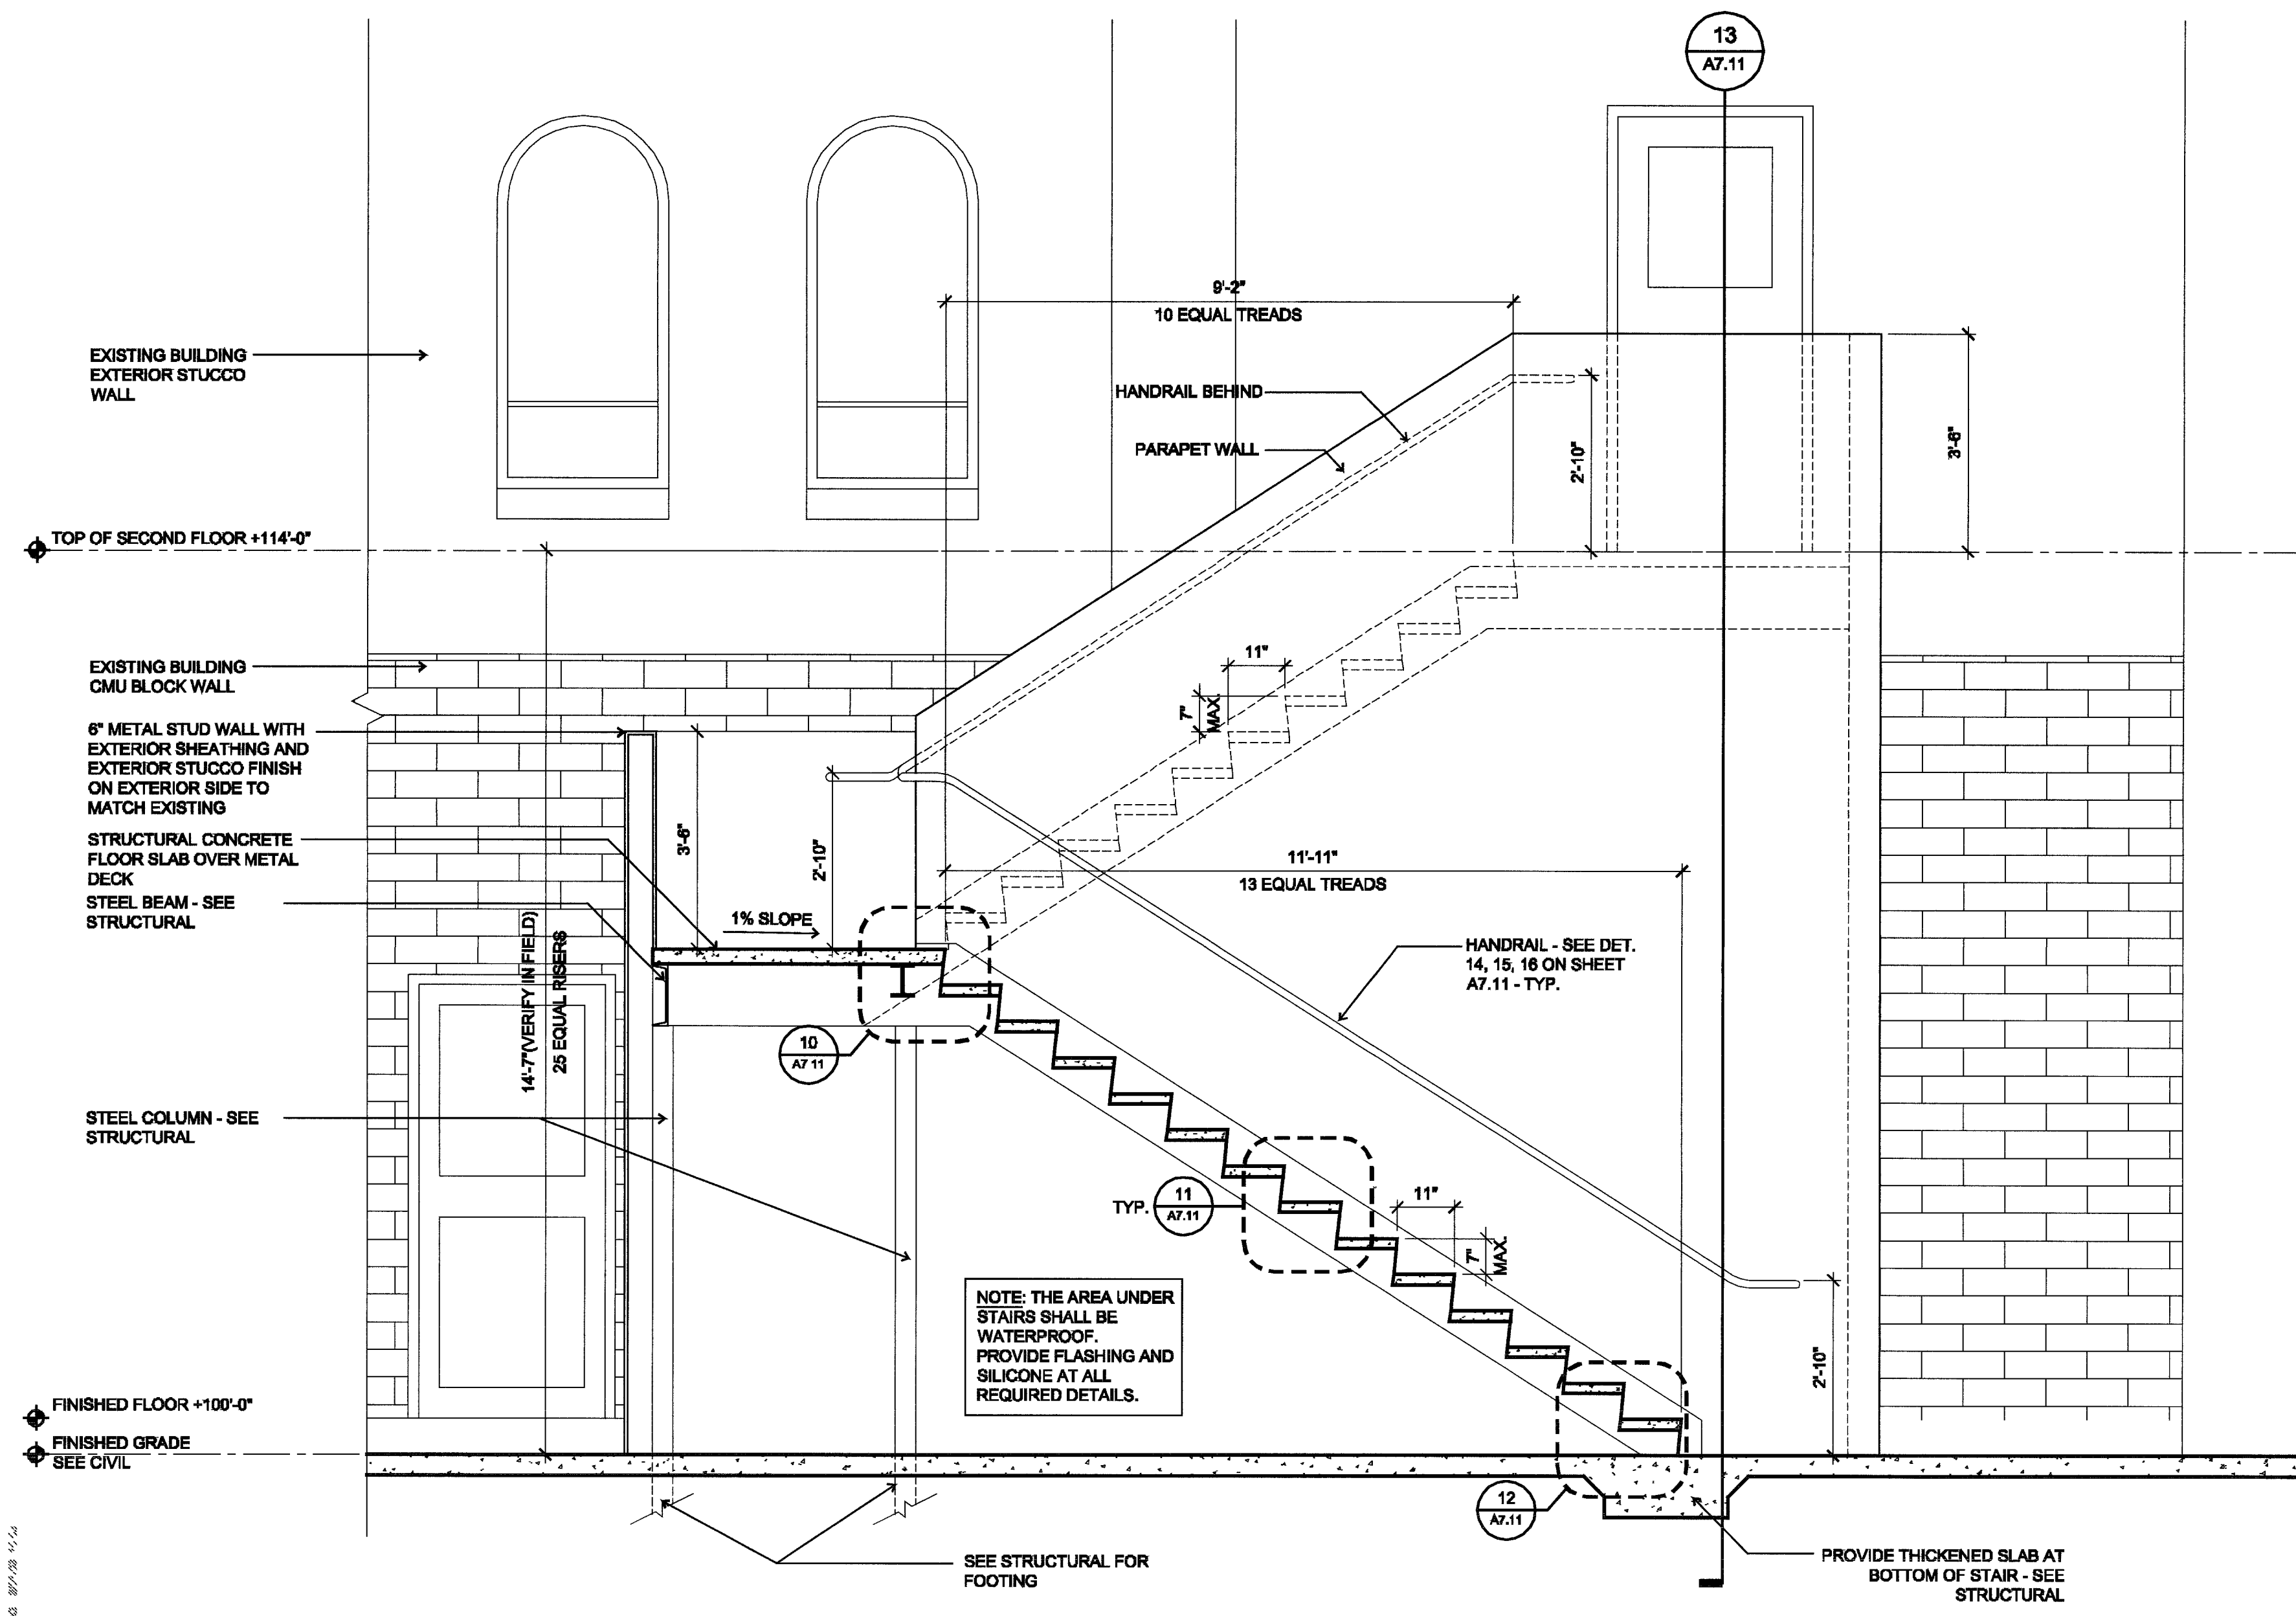


7 EXTERIOR STAIR SECTION
1/2"=1'-0"

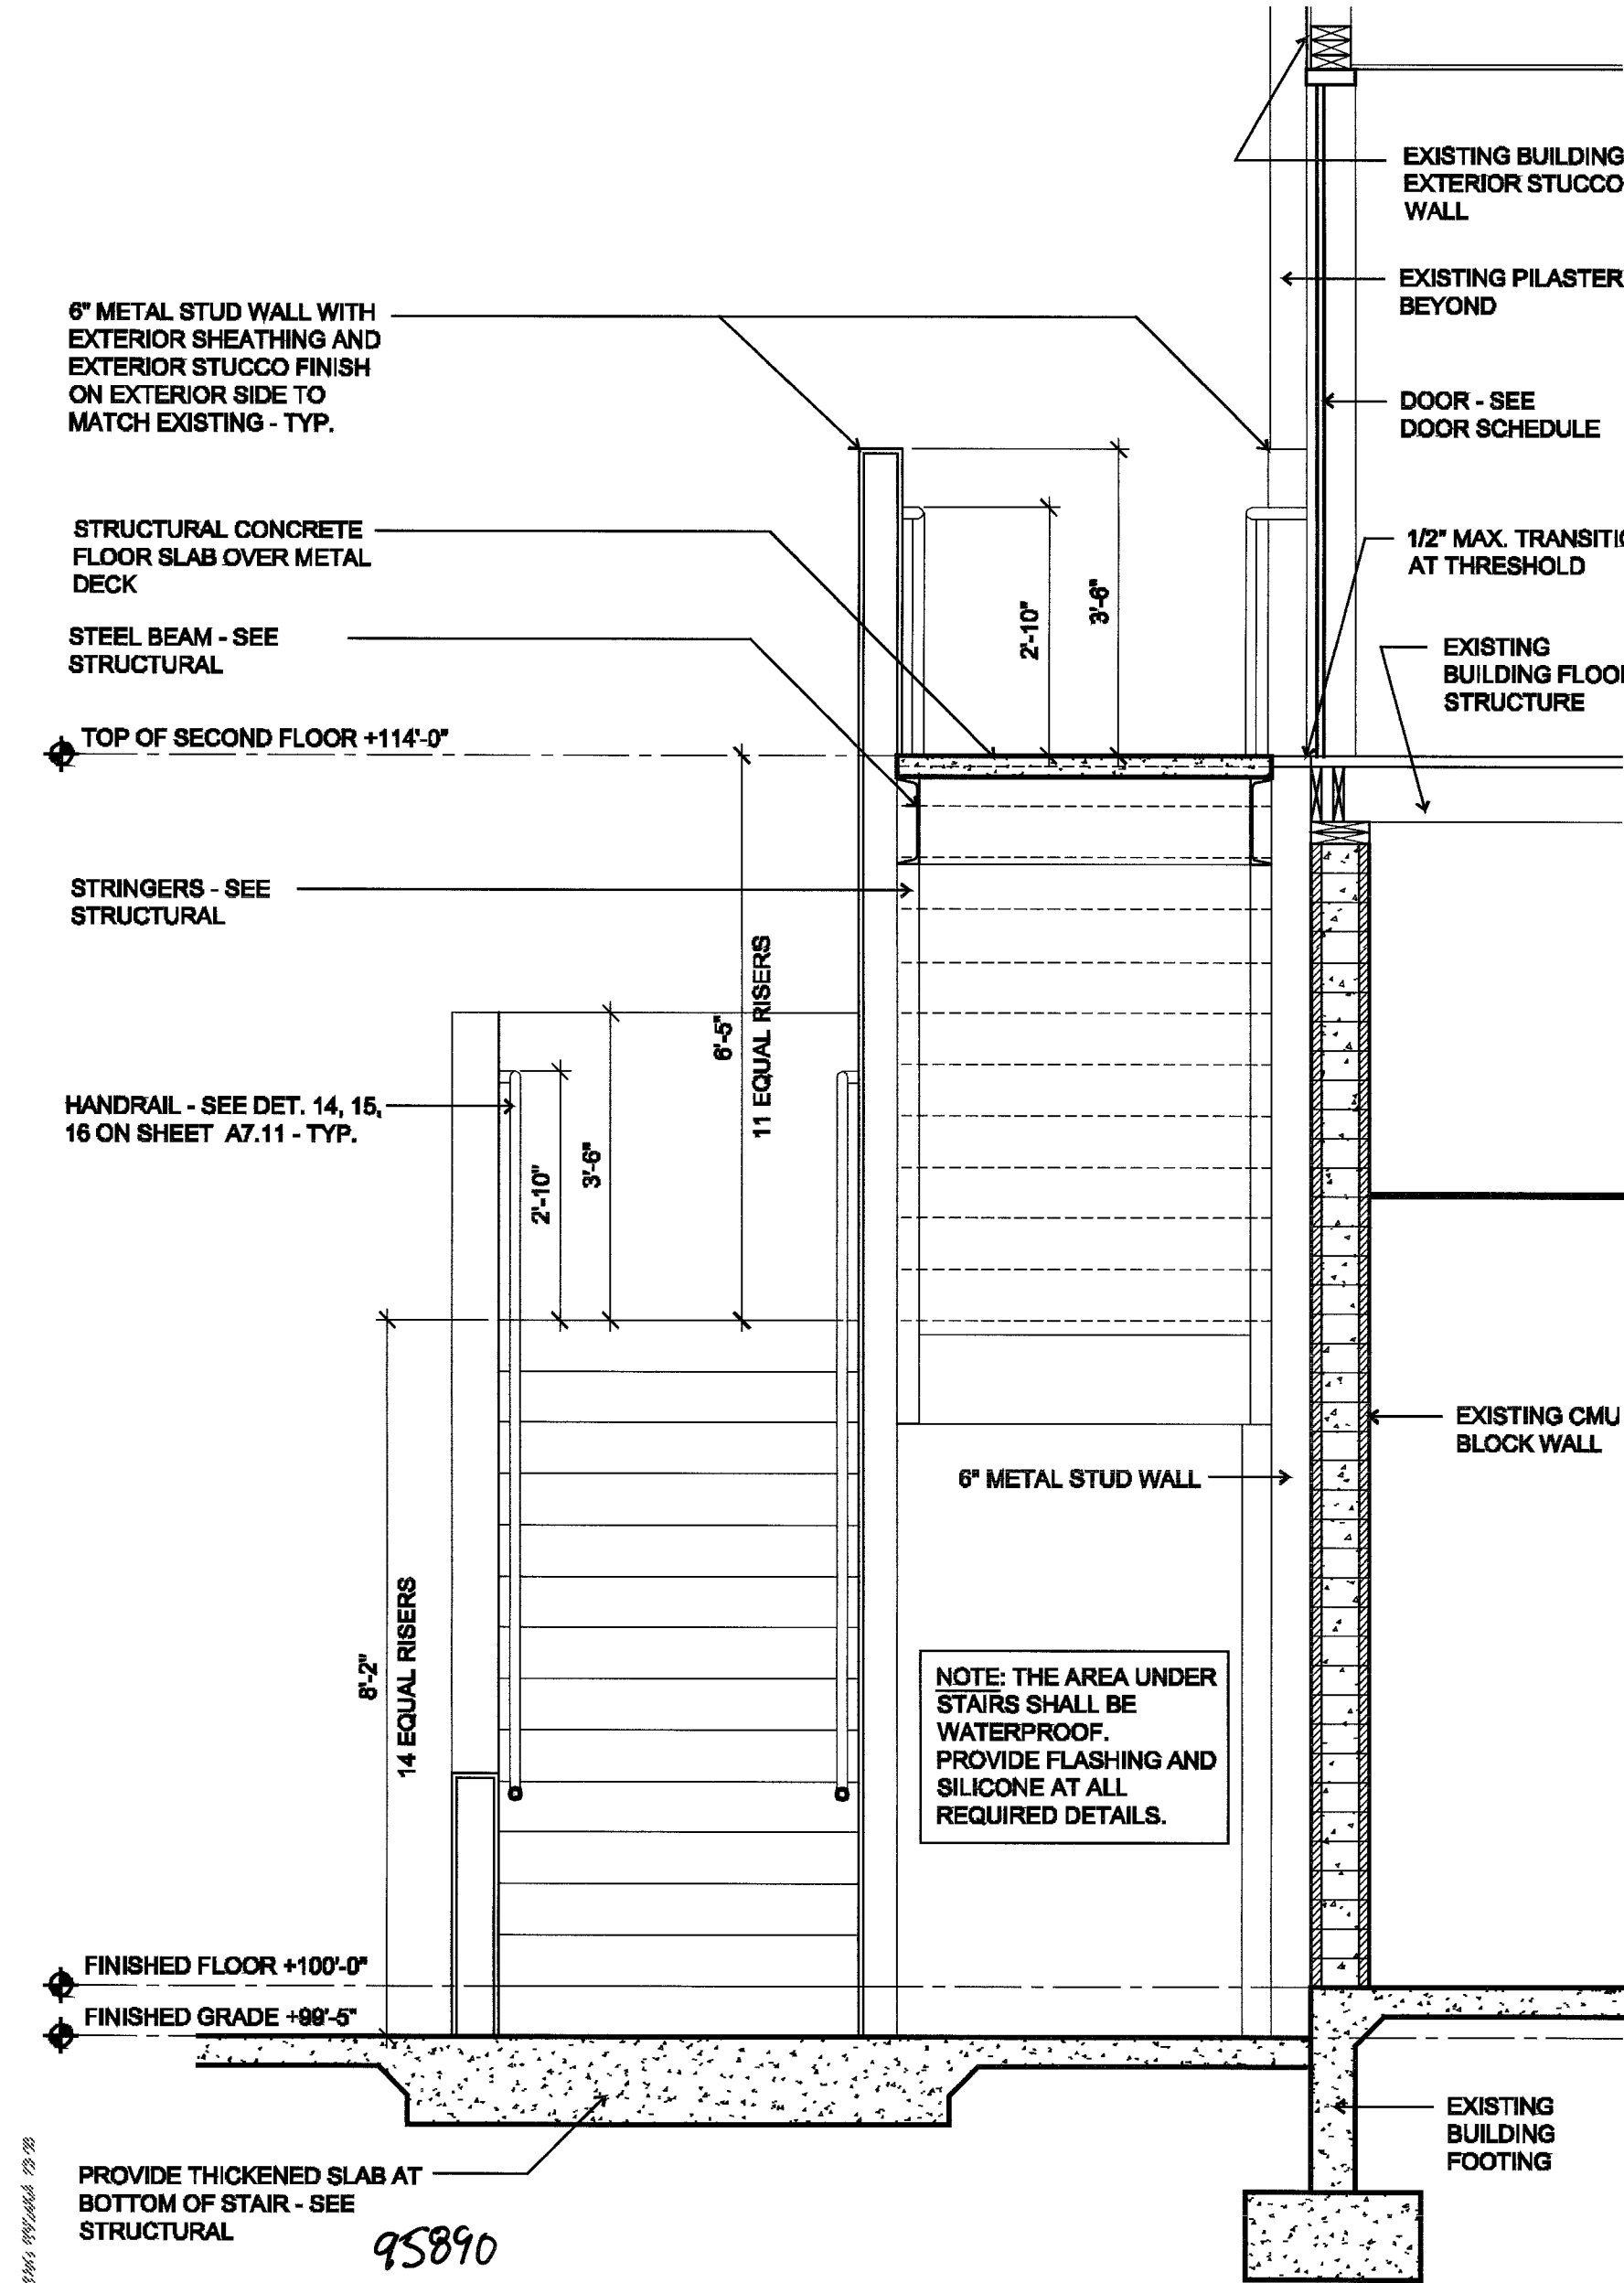


13 EXTERIOR STAIR SECTION
1/2"=1'-0"

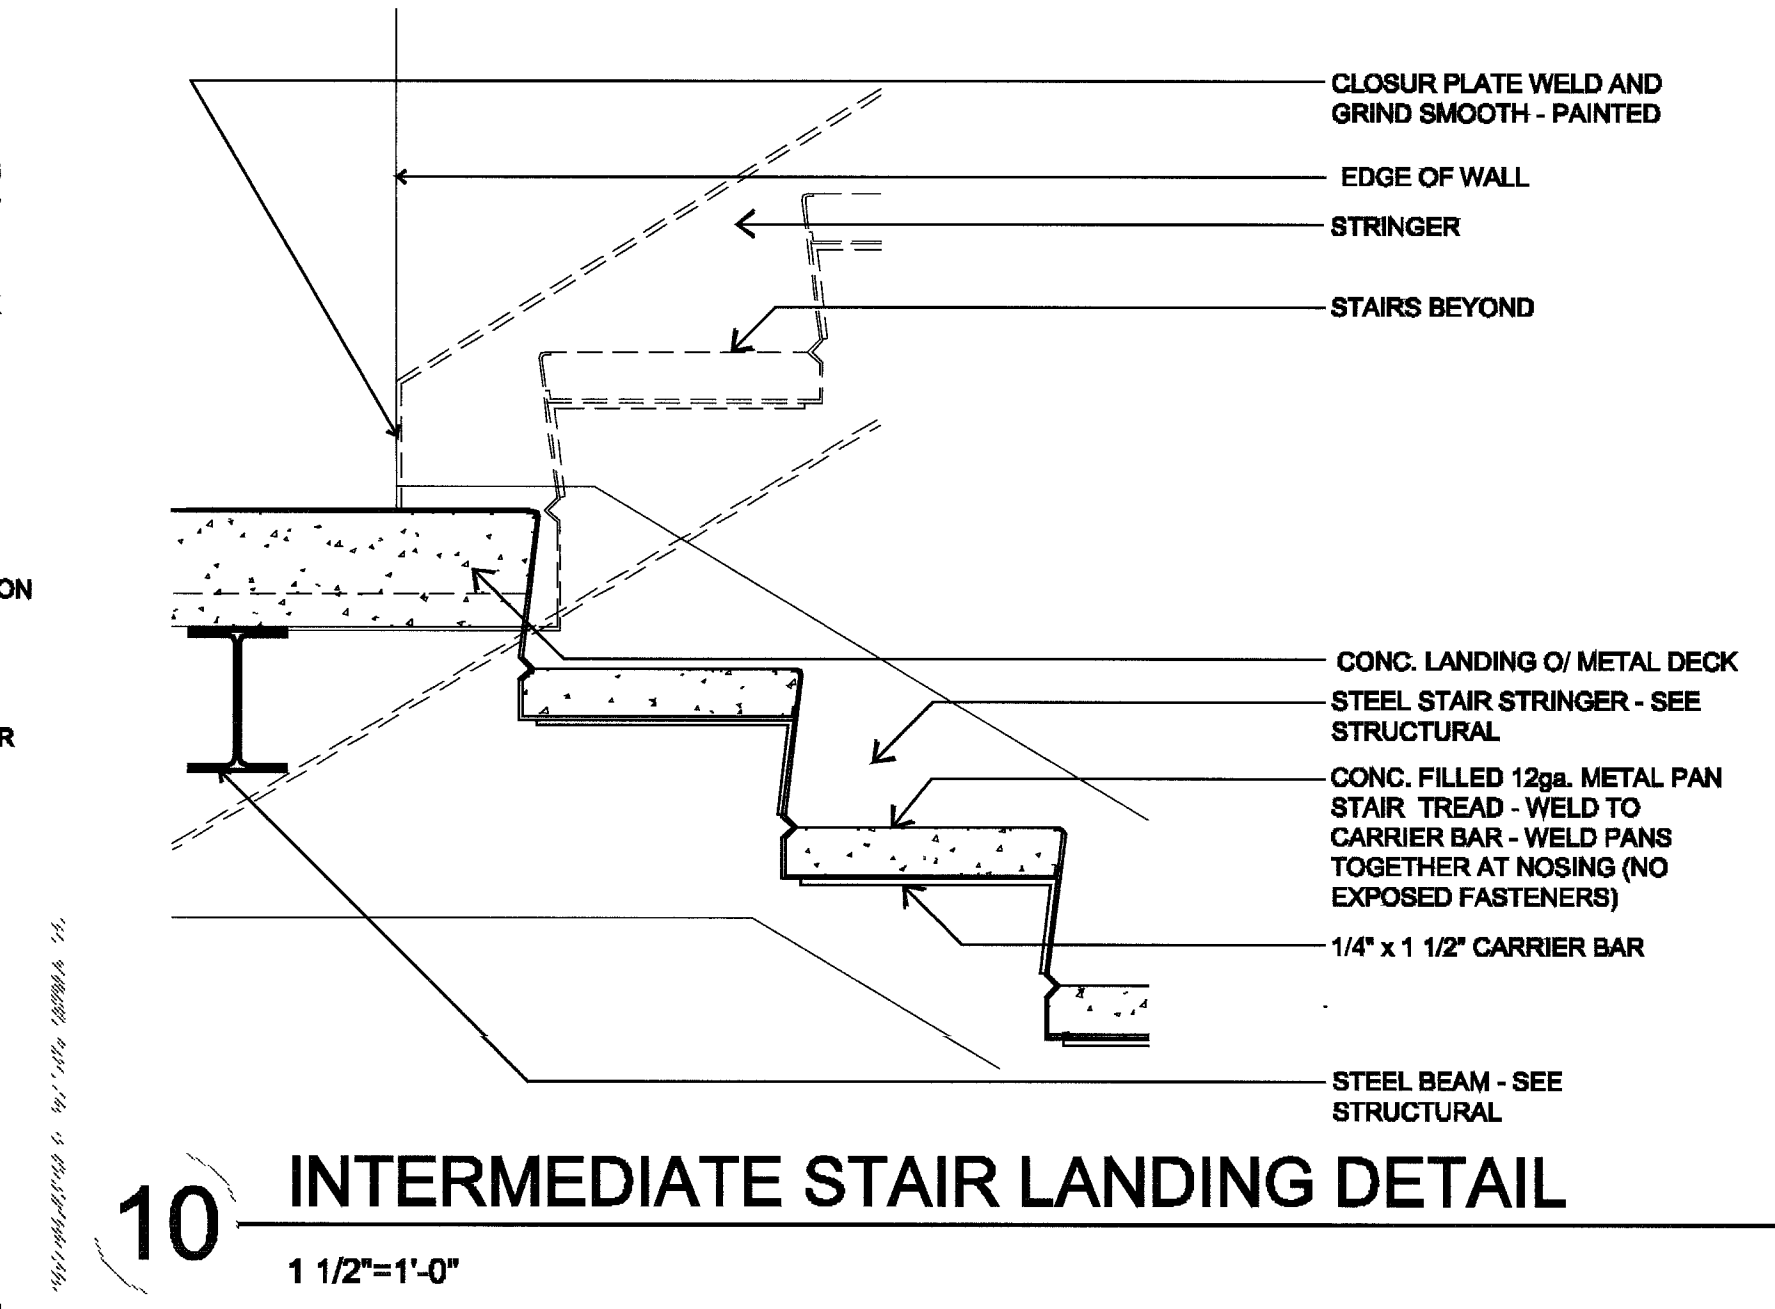


10 INTERMEDIATE STAIR LANDING DETAIL
1 1/2"=1'-0"

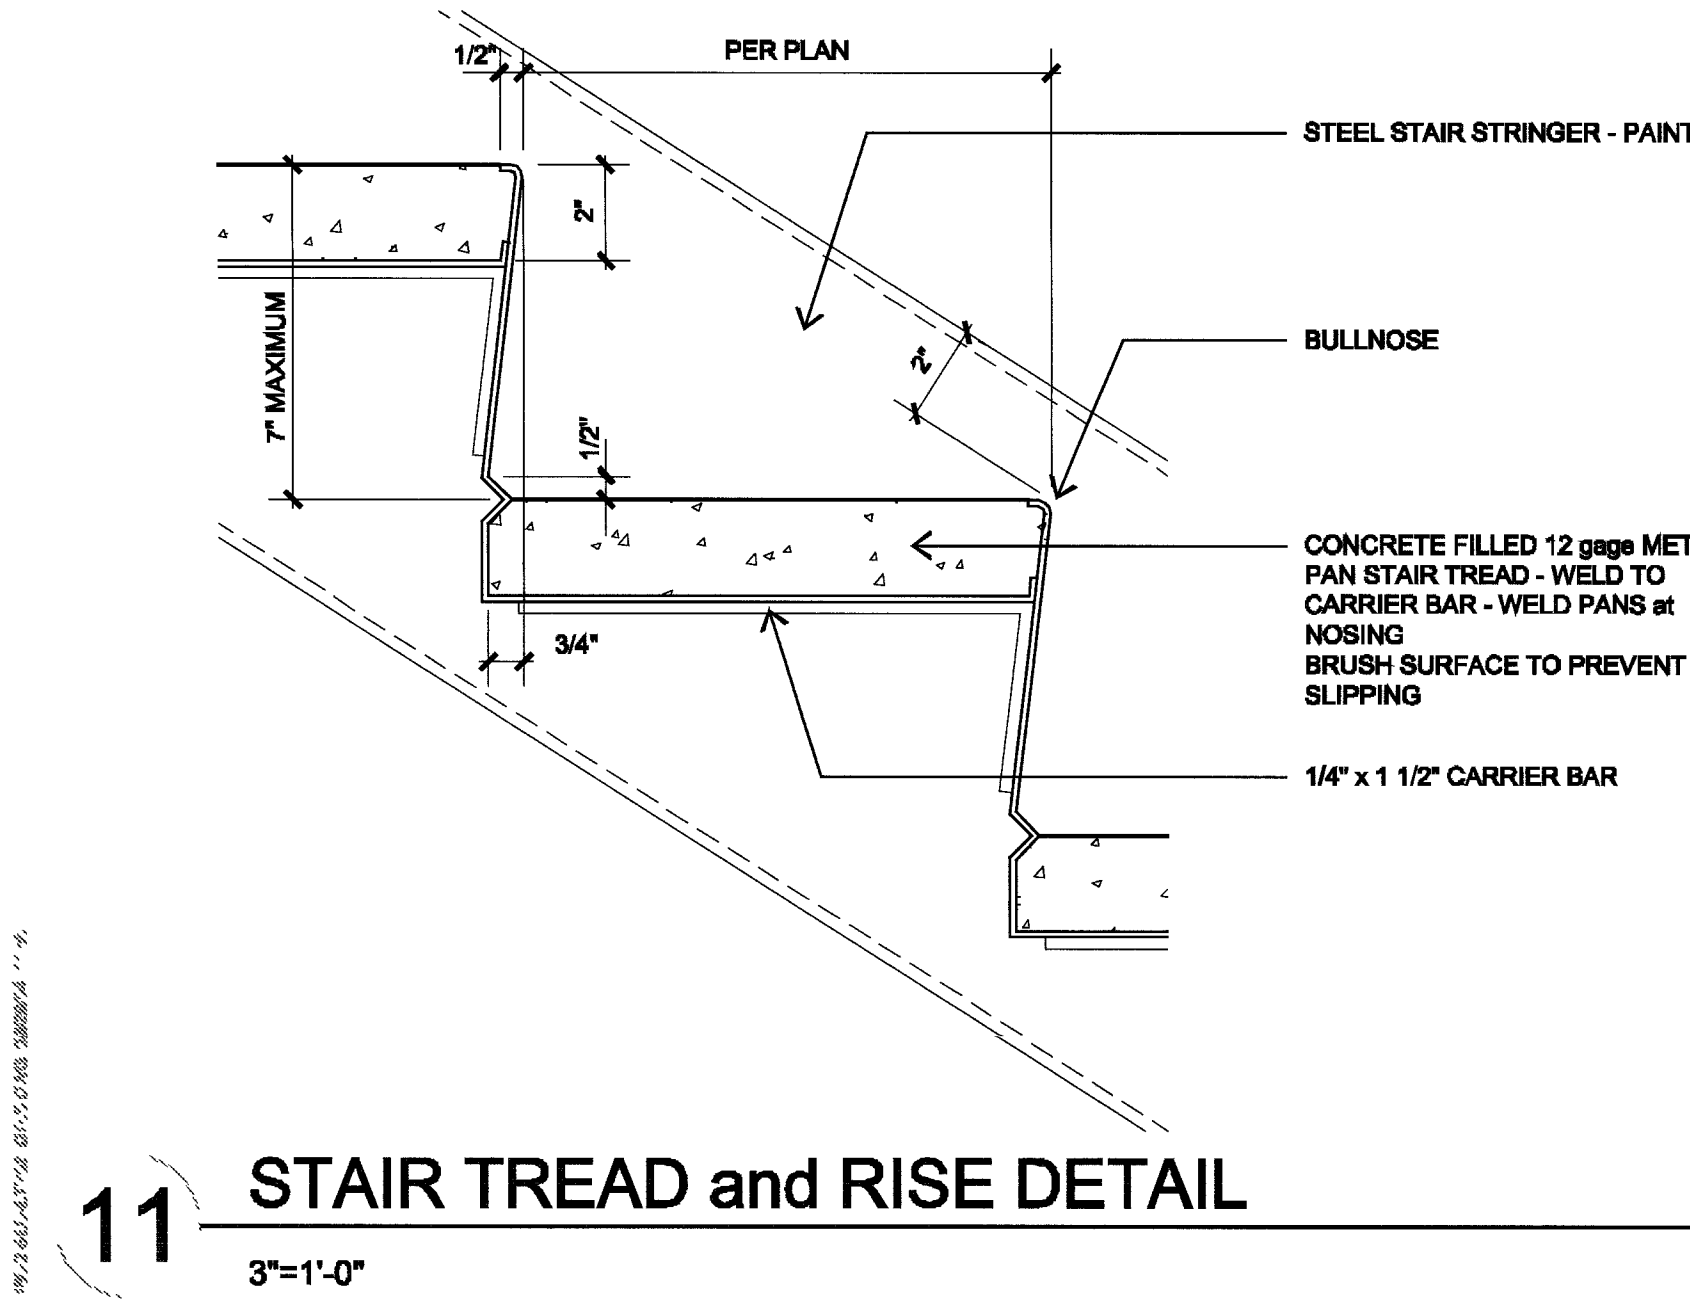


11 STAIR TREAD and RISE DETAIL
3"=1'-0"

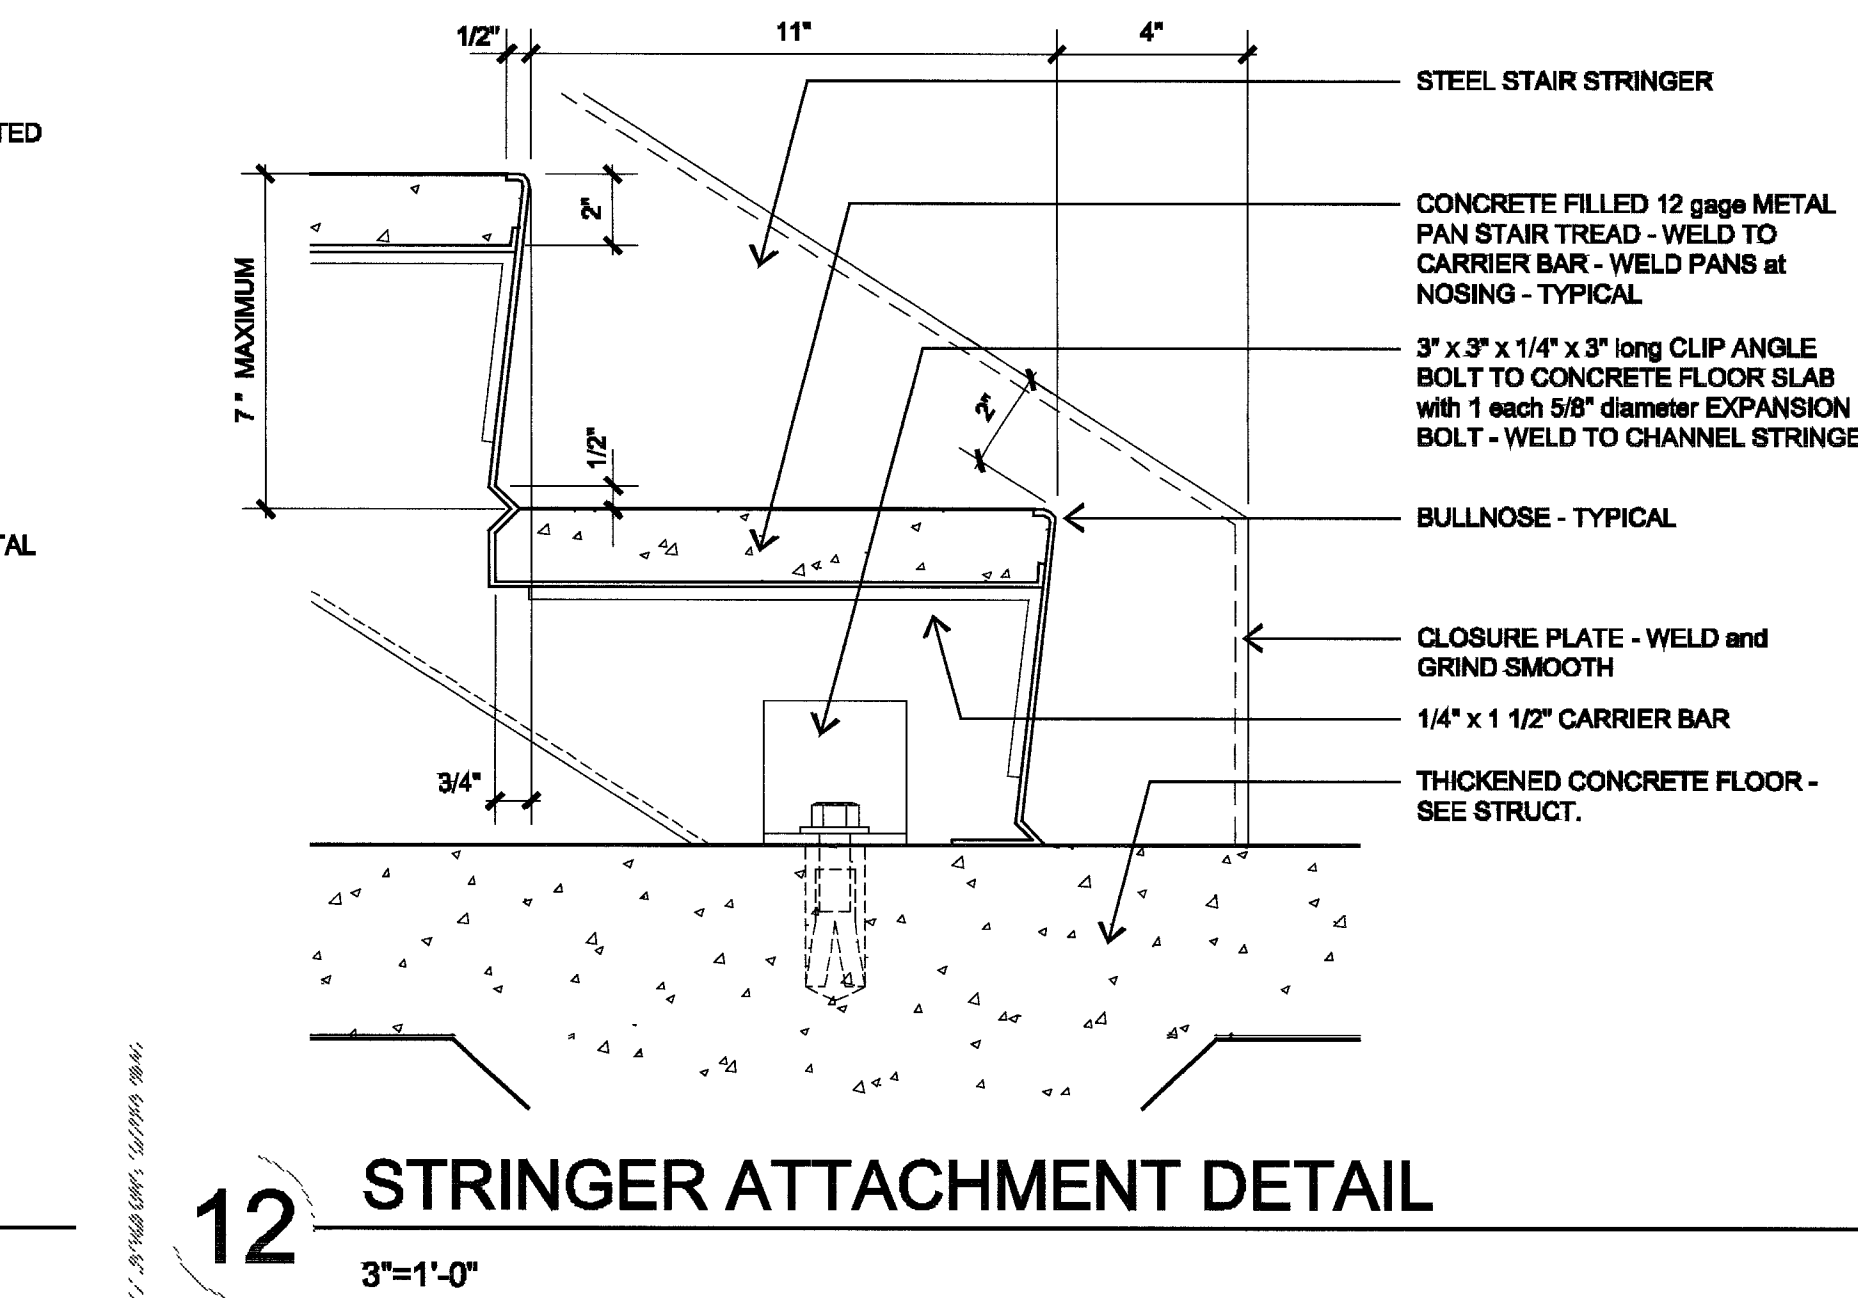


12 STRINGER ATTACHMENT DETAIL
3"=1'-0"

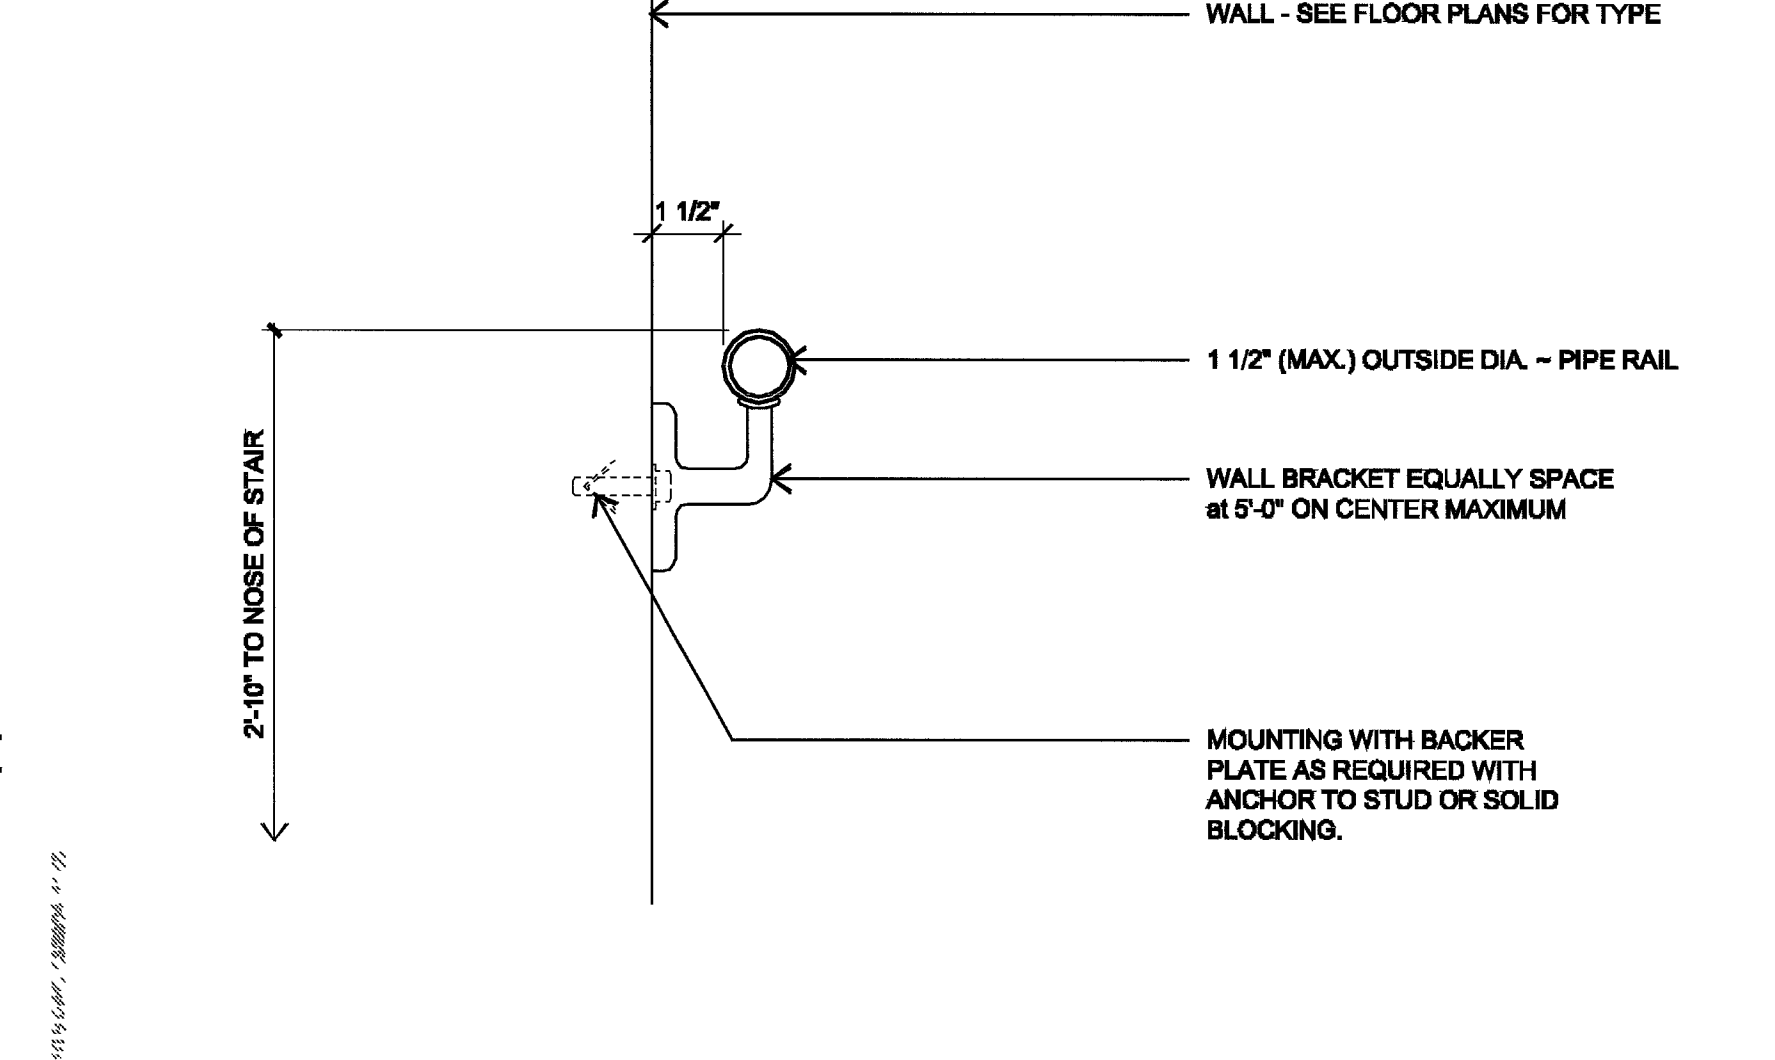

14 DETAIL at HANDRAIL SUPPORT
3"=1'-0"

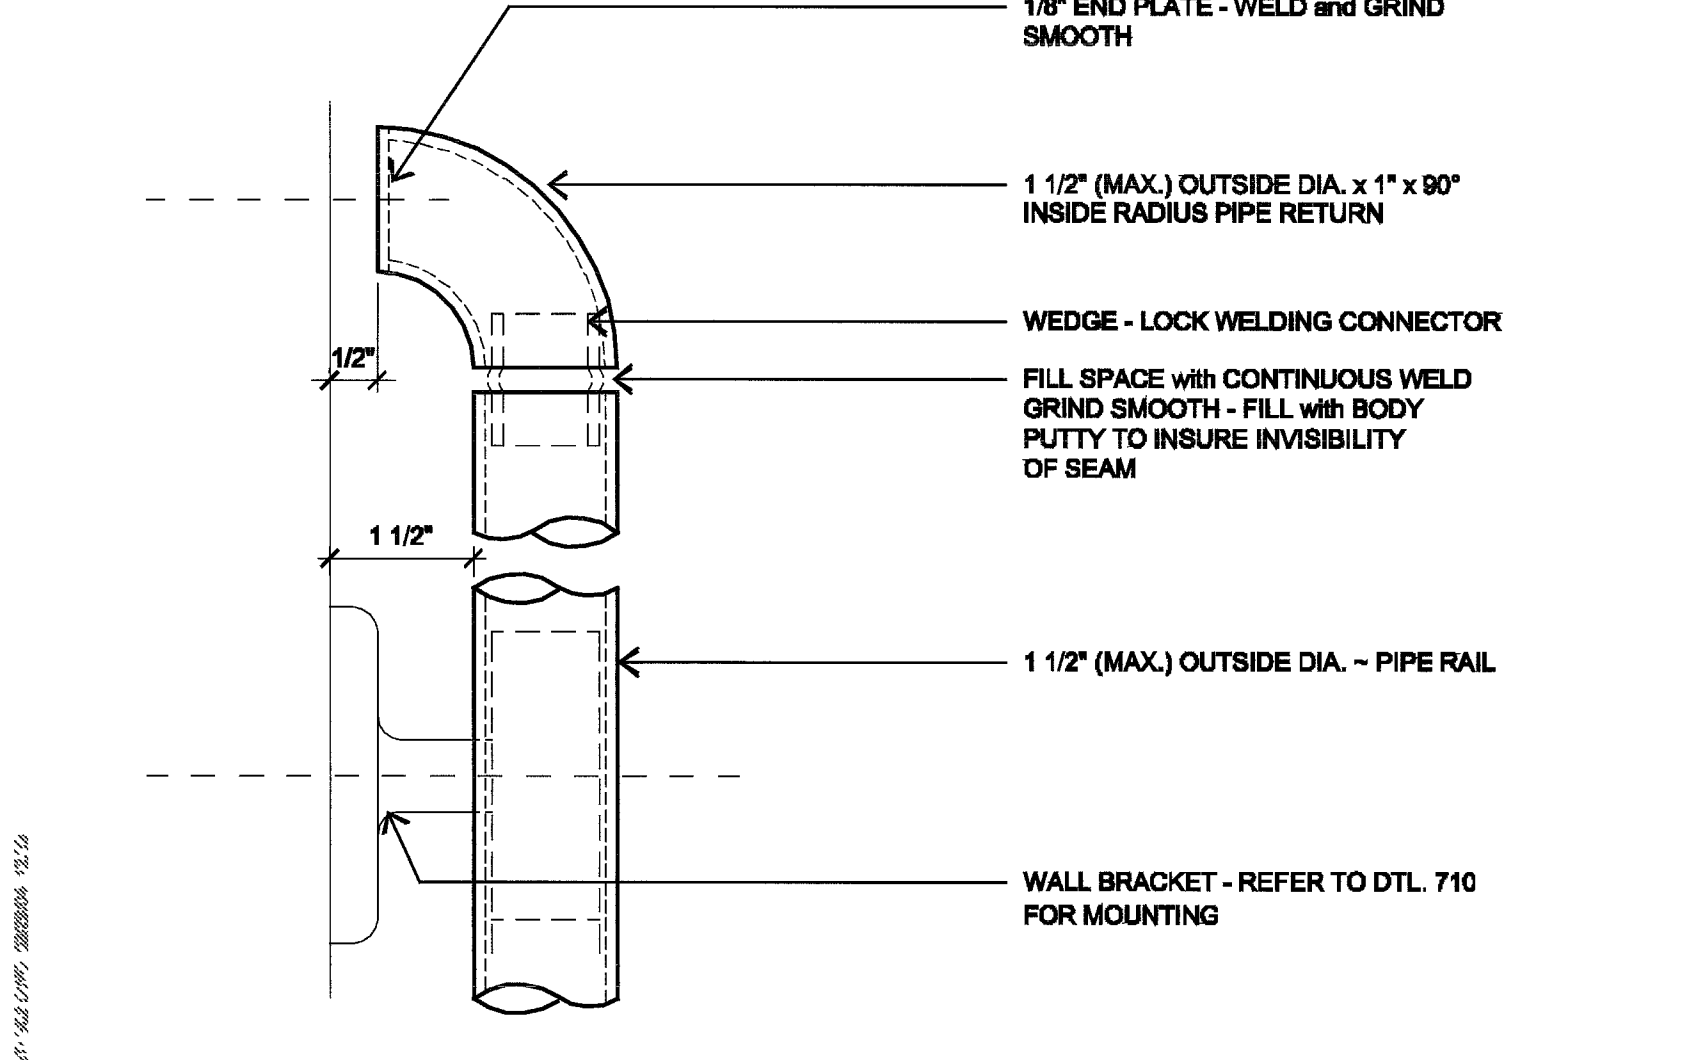

15 HANDRAIL END DETAIL
Half Scale

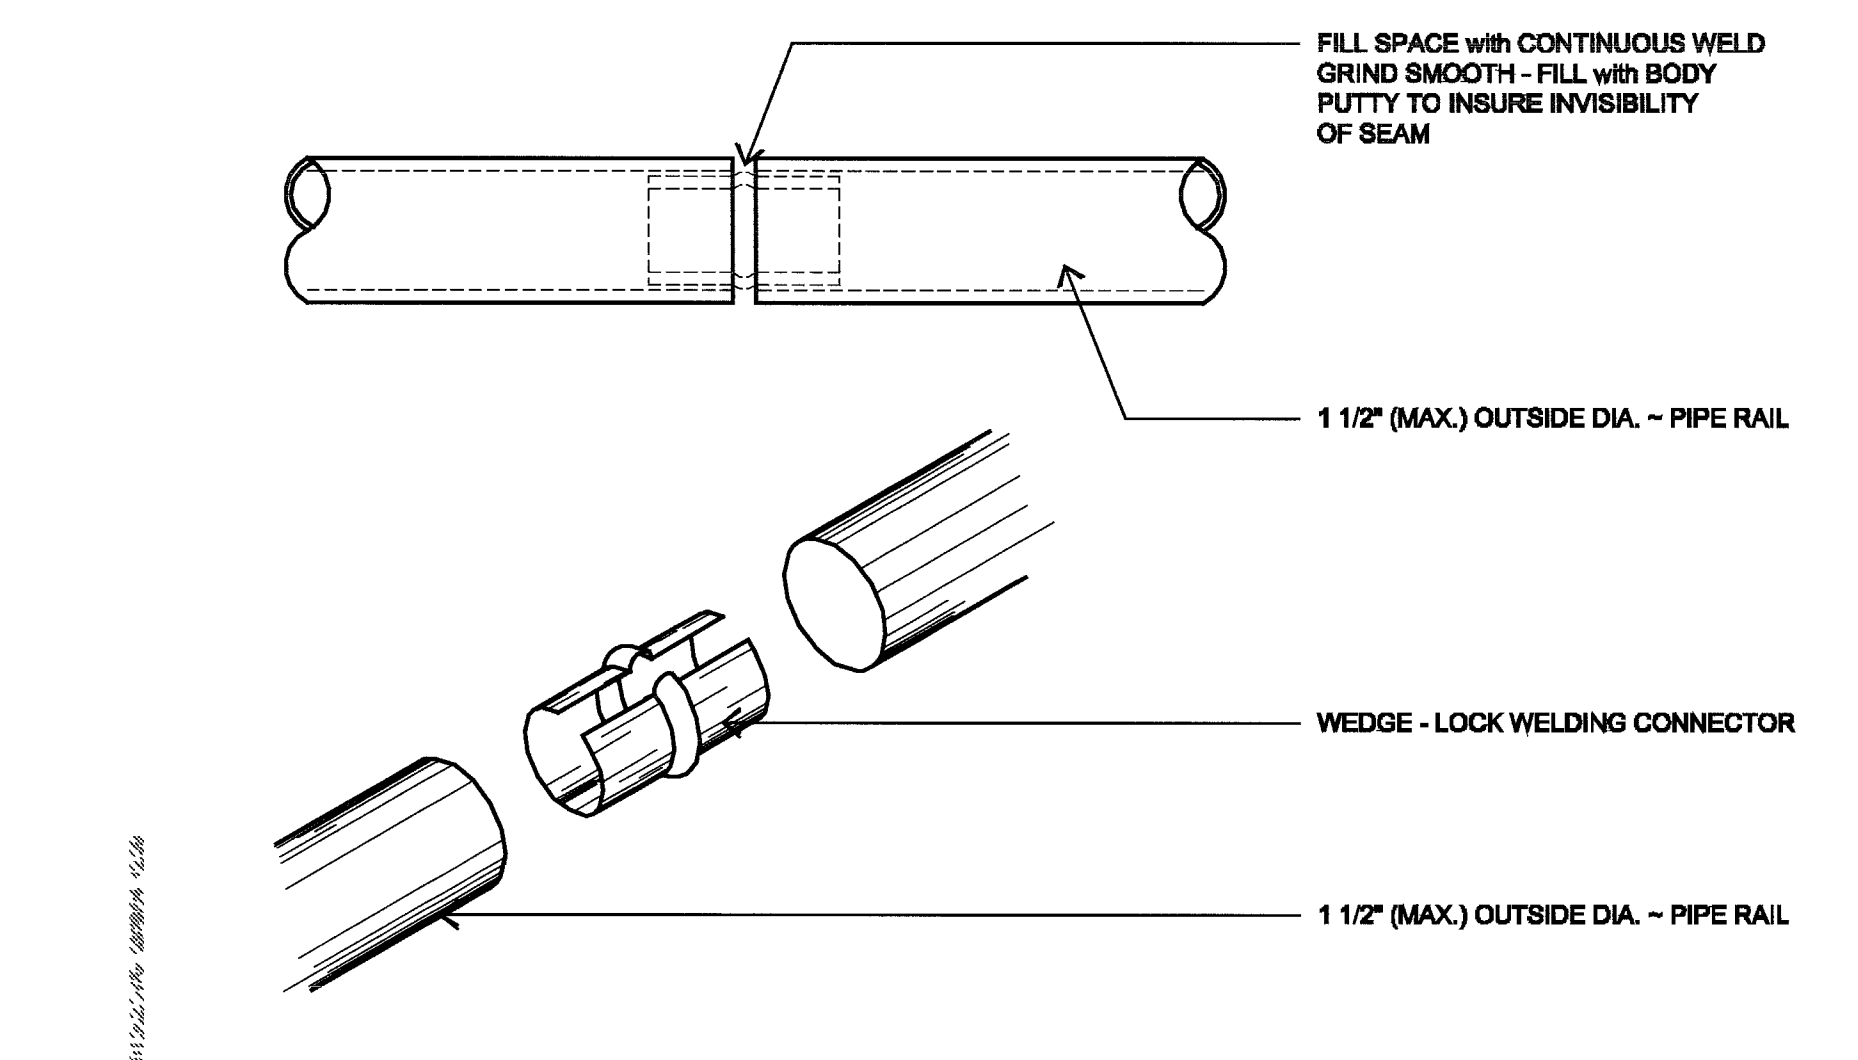

16 PIPE RAIL CONNECTION
Half Scale

JMA ARCHITECTURE STUDIOS

10155 COUNTRY CLUB BLVD. SUITE 100
DOWNTOWN SENIOR SERVICES CENTER
NEIGHBORHOOD SERVICES

RECORD DRAWING

This record drawing shall be used for the construction of the project. It is the responsibility of the contractor to verify the accuracy of the information shown on this drawing. The architect shall not be responsible for the accuracy of the information shown on this drawing. The architect shall not be responsible for the accuracy of the information shown on this drawing.

BUILDING 2

DOWNTOWN SENIOR SERVICES CENTER

NEIGHBORHOOD SERVICES

OWNER: CITY OF LAS VEGAS
DEPARTMENT OF PUBLIC WORKS
ARCHITECTURAL SERVICES

4500 EAST STEPHAN AVENUE
LAS VEGAS, NEVADA 89103
PHONE: (702) 228-6300
FAX: (702) 228-6300
TDD: (702) 228-6300

DESIGN: S. Bailey

DATE: September 8, 2004

SCALE: See Details

REV NO: 04.1534.01

REV NO: 521-287

REV NO: 521-287

A7.11