


100% JMA ARCHITECTURE STUDIOS

A

95802

BUILDING 3 - FIRST FLOOR FURNITURE PLAN (NO WORK THIS SHEET)

3/16"=1'-0"

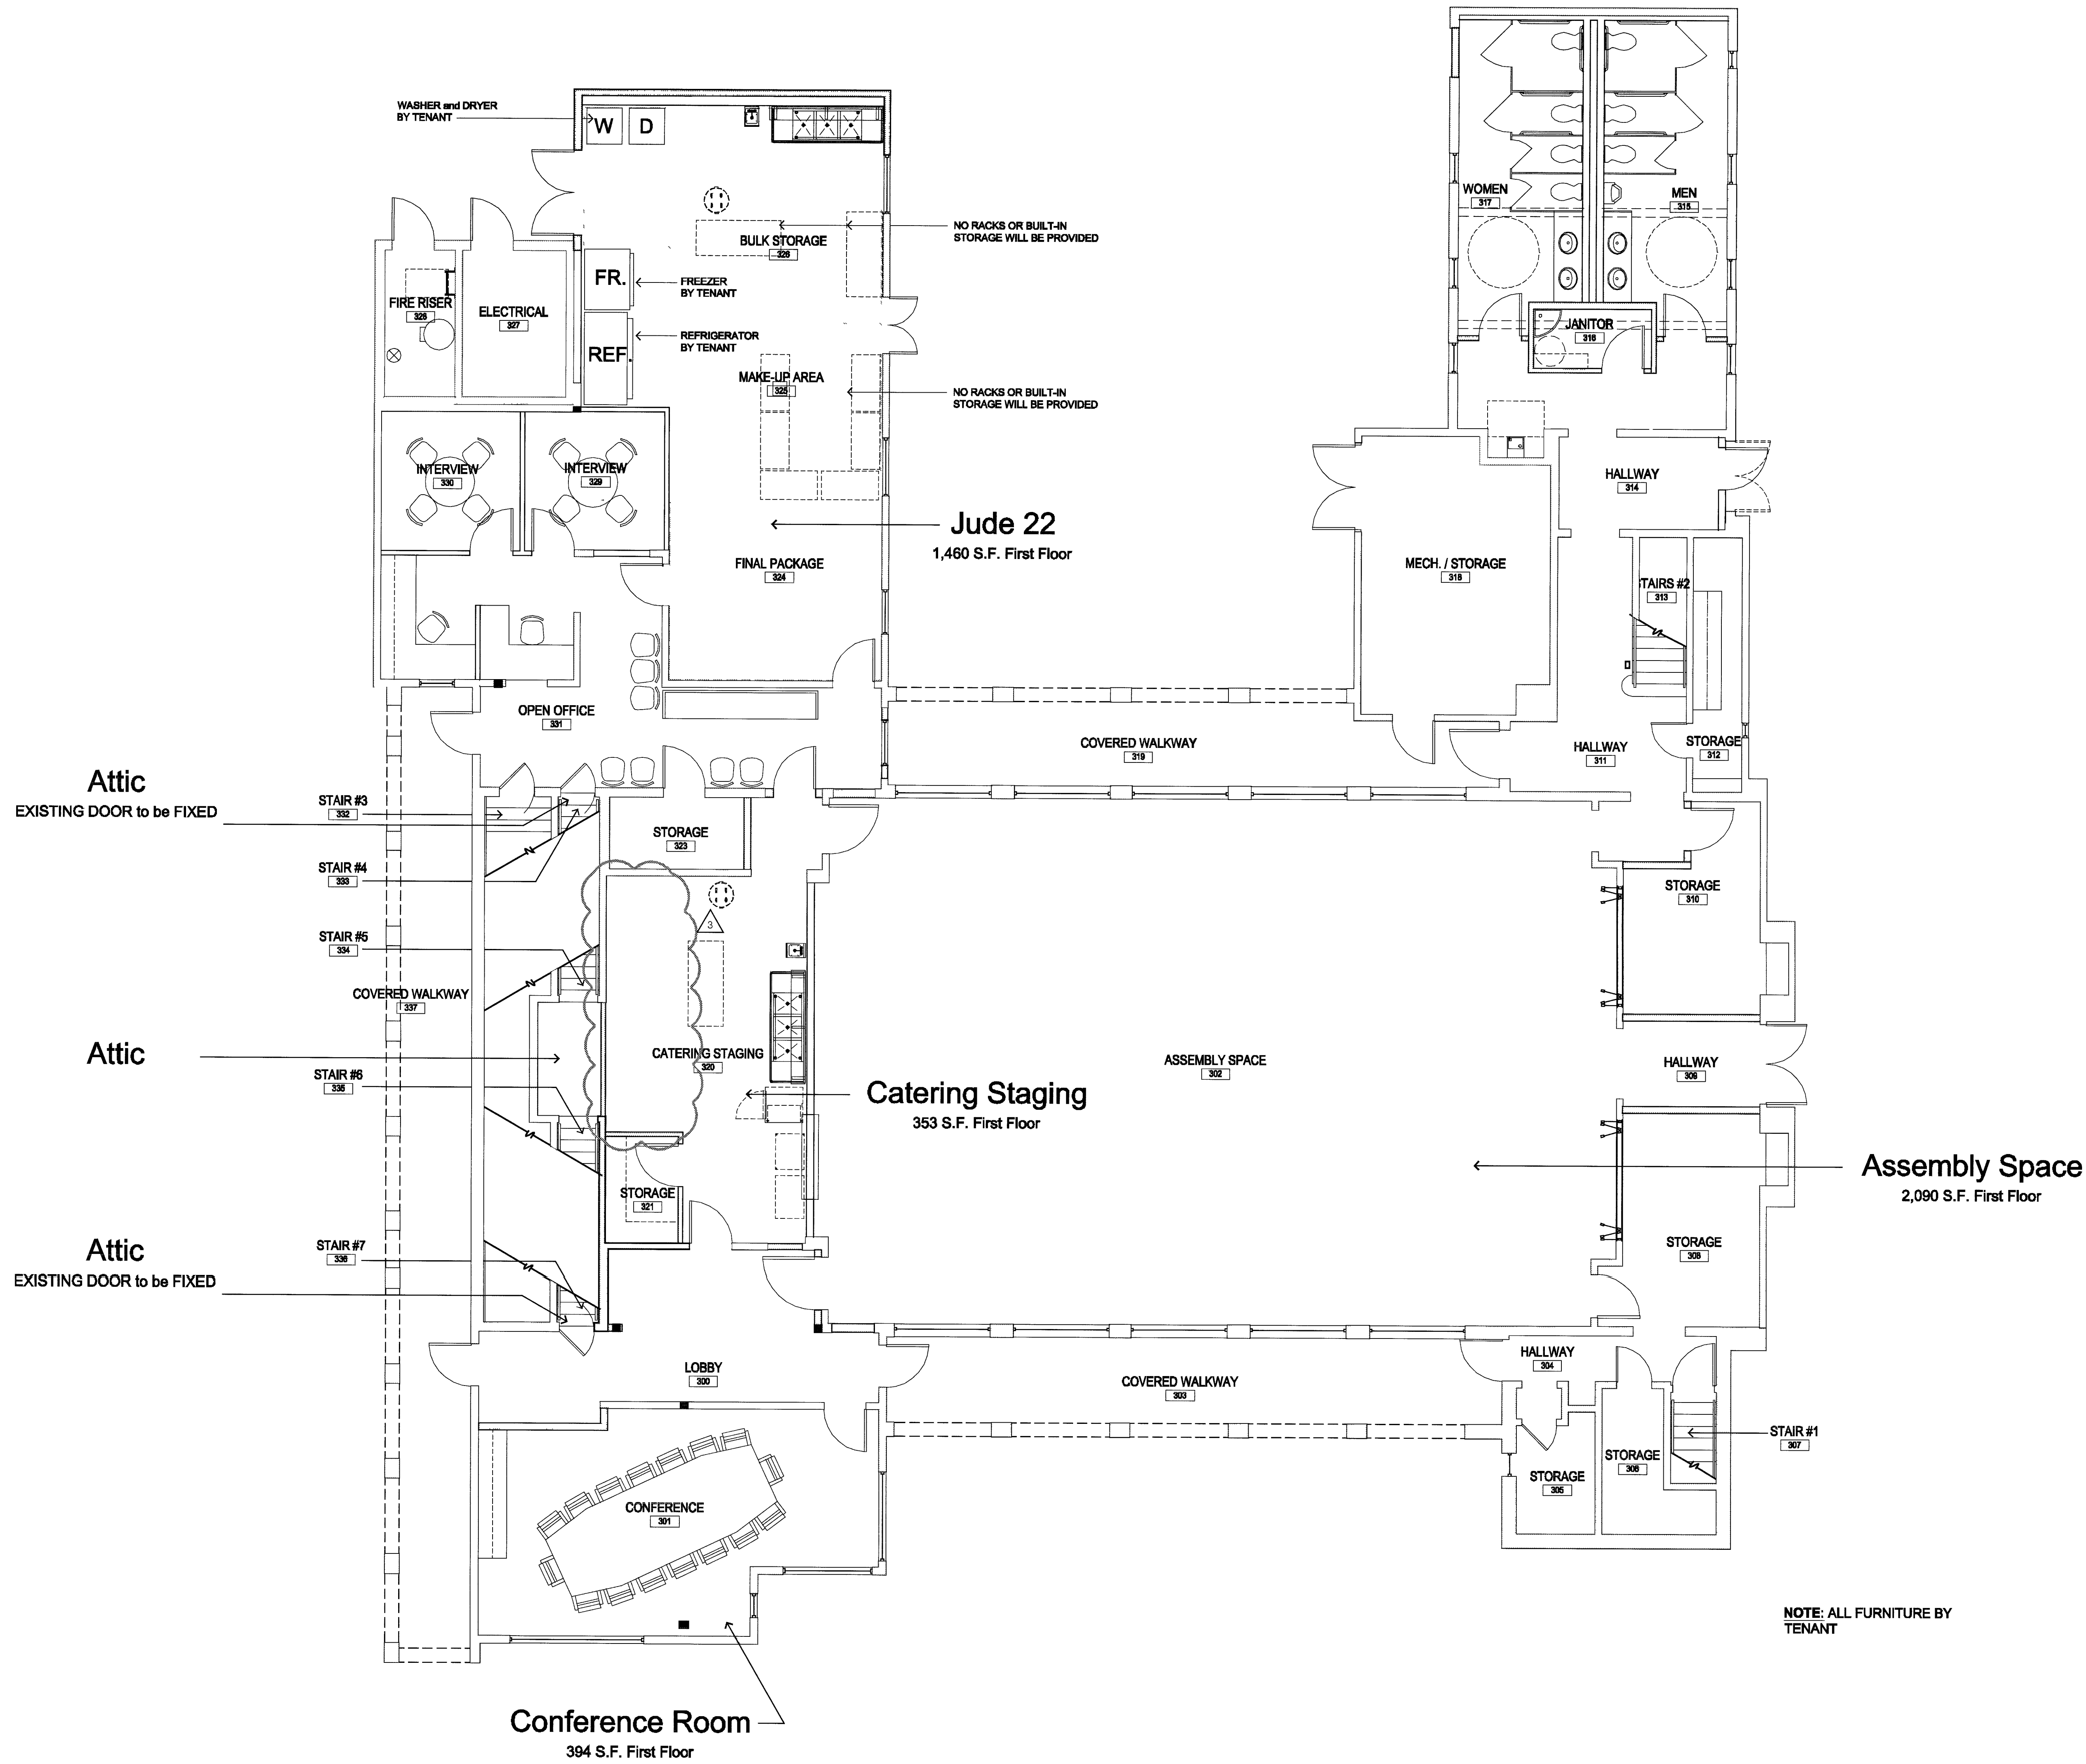

NOTE: ALL FURNITURE BY
TENANT

7/14/04 Plan Check (Arch.)

CONSULTANT

JMA ARCHITECTURE STUDIOS

18138 COTTONWOOD BLVD SUITE 200

RECORD DRAWING

This record drawing dated December 20, 2023, has been prepared in part based upon information furnished by others. While this information is believed to be reliable, JMA Architecture Studios cannot assume its accuracy, and thus is not responsible for the accuracy of this record drawing or for any errors or omissions which may have been incorporated into it as a result. Those relying on this record drawing are advised to obtain independent verification of its accuracy before applying it for any purpose.

CITY OF LAS VEGAS
DOWNTOWN SENIOR SERVICES CENTER
NEIGHBORHOOD SERVICES

BID SET

OWNER: CITY OF LAS VEGAS
DEPARTMENT OF PUBLIC WORKS
ARCHITECTURAL SERVICES

400 EAST STEWART AVENUE
LAS VEGAS, NEVADA 89101
PHONE: (702) 228-8200
FAX: (702) 228-8200
TDD: (702) 386-9108

OWNER: S. Balmer

DATE: September 8, 2004

SCALE: 3/16" = 1'-0"

DESIGN NO: 04.15541.01

CITY OF LAS VEGAS: 521-287

First Floor Furniture Plan

95802

A9.32