


10/2/2004 10:00 AM 10/2/2004 10:00 AM

95904
BUILDING 2 - FIRST FLOOR SIGNAGE PLAN
3/16"=1'-0"

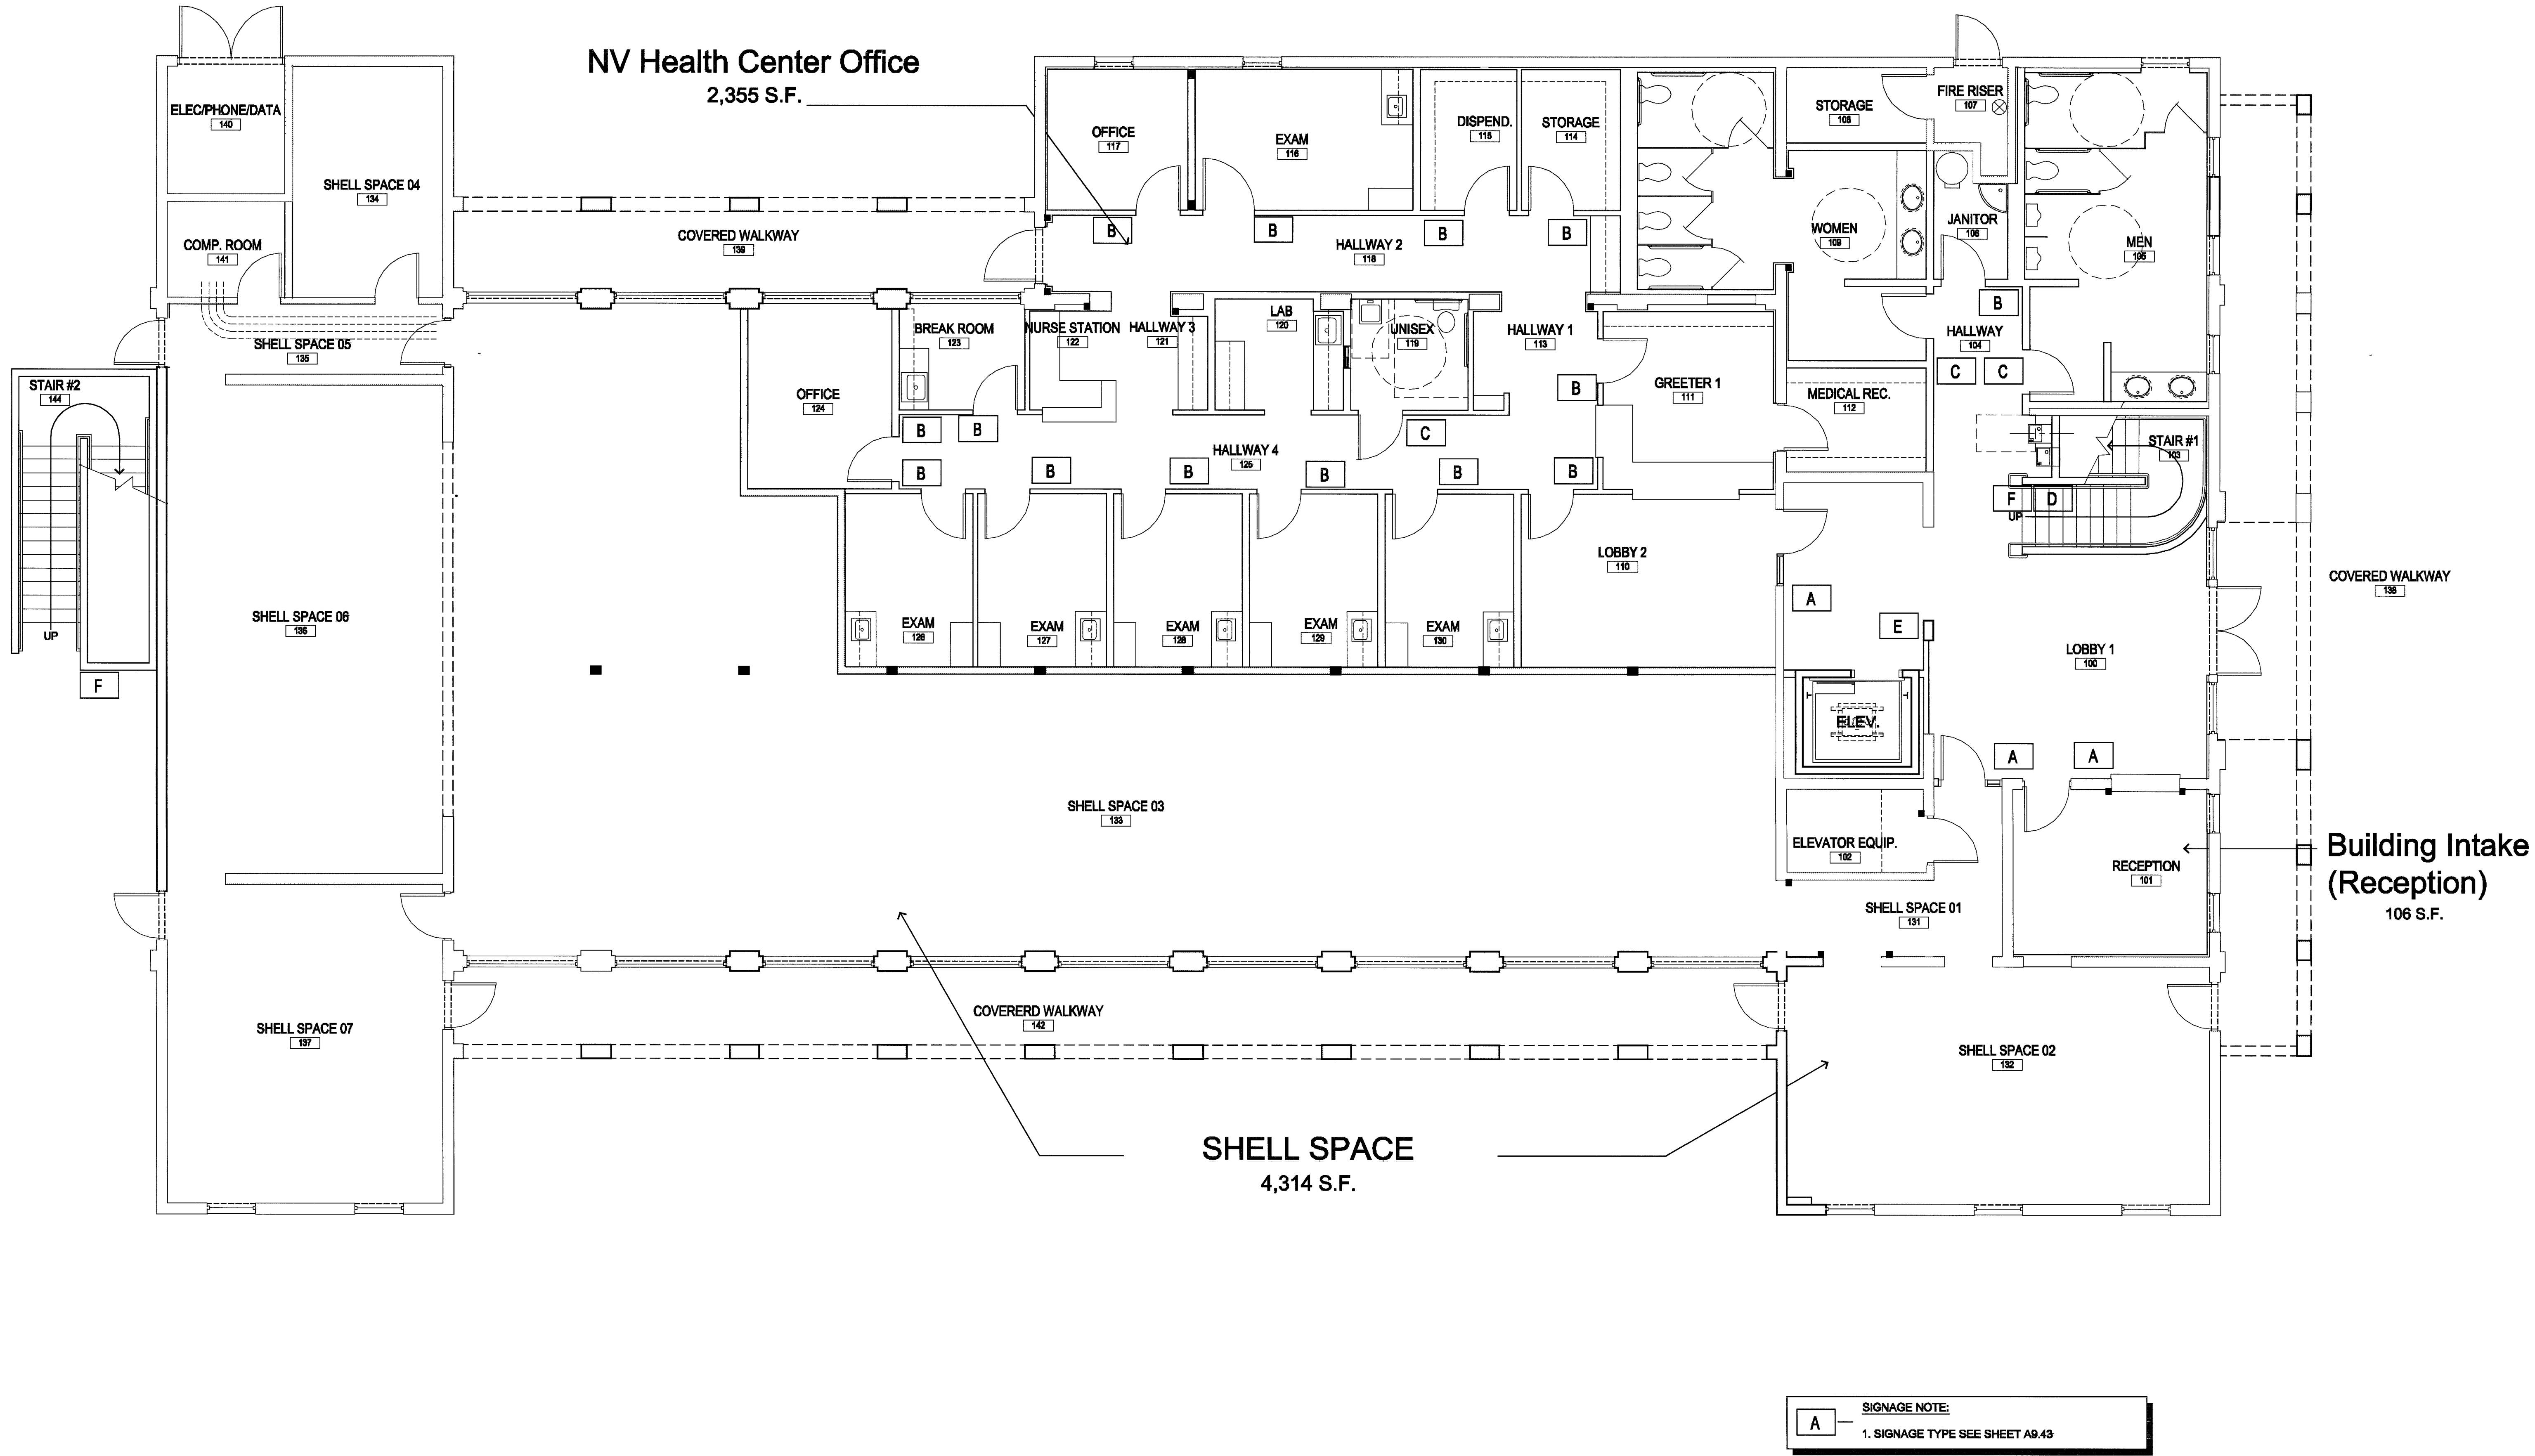

REVISIONS

CONSULTANT

JMA ARCHITECTURE STUDIOS

RECORD DRAWING

THE RECORD DRAWING IS THE FINAL DRAWING FOR THE PROJECT. IT IS THE RESPONSIBILITY OF THE CLIENT TO OBTAIN ALL NECESSARY PERMITS AND APPROVALS FOR THE PROJECT. THE CLIENT MAY BE CHARGED FOR THE COST OF ANY CHANGES TO THE PROJECT. THE CLIENT MAY BE CHARGED FOR THE COST OF ANY CHANGES TO THE PROJECT. THE CLIENT MAY BE CHARGED FOR THE COST OF ANY CHANGES TO THE PROJECT.

OWNER: CITY OF LAS VEGAS
DEPARTMENT OF PUBLIC WORKS
ARCHITECTURAL SERVICES

400 EAST STEWART AVENUE
LAS VEGAS, NEVADA 89101
PHONE: (702) 226-6229
FAX: (702) 386-3232
TDD: (702) 386-9108

DRAWN: B. Bullock

DATE: September 8, 2004

SCALE: 3/16"=1'-0"

DESIGN: 04.1634.01

CITY DRAW NO: 521-287

PROJECT: First Floor Signage Plan

BUILDING 2

A9.40