




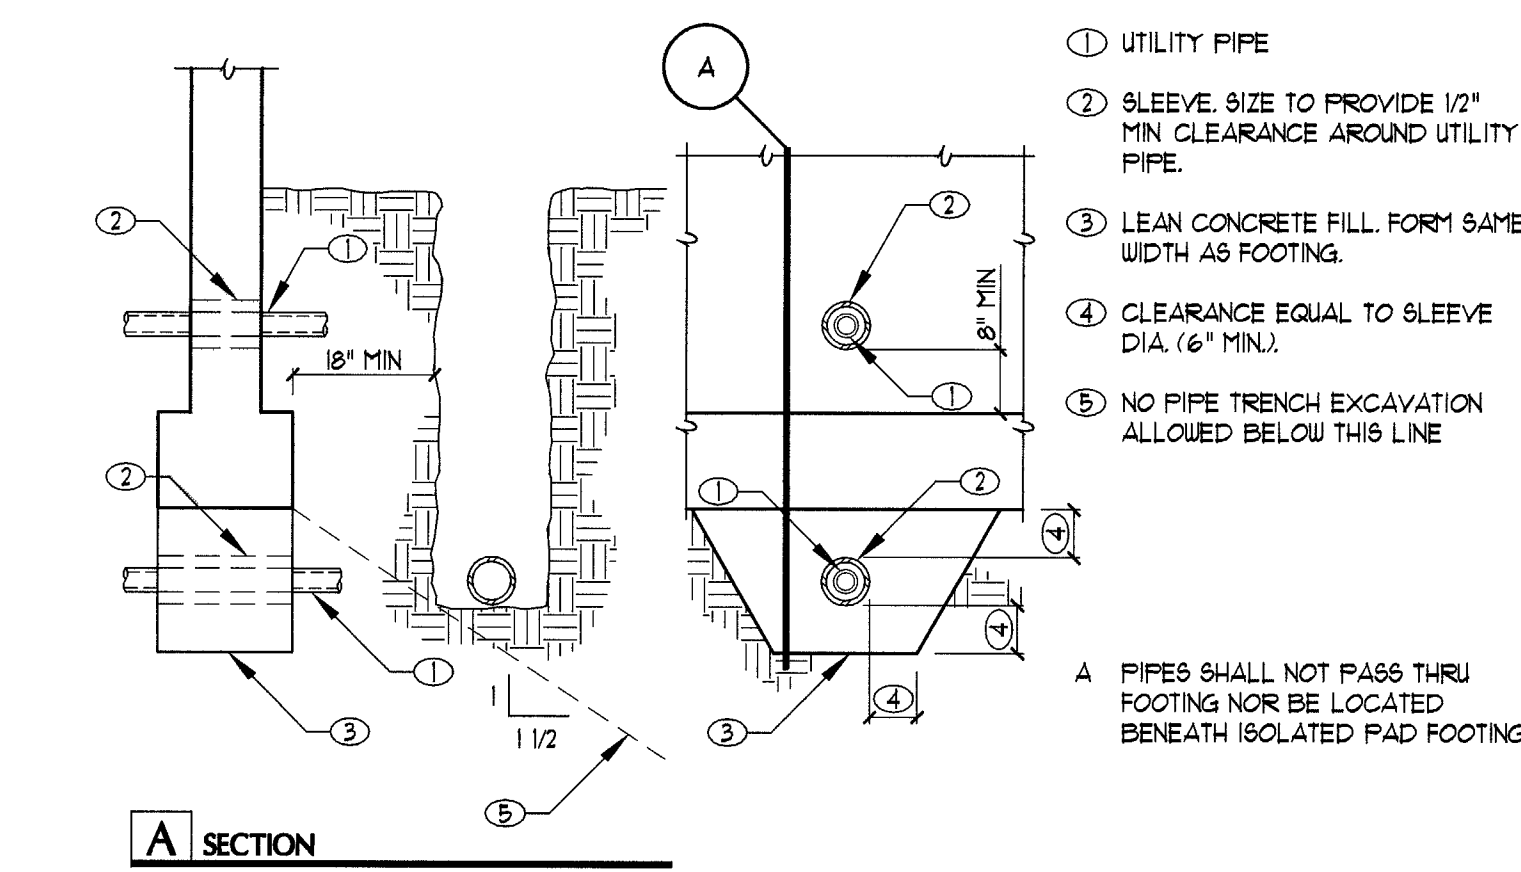


16 UTILITY PIPES AT FOOTING
16-01 03070 NO SCALE

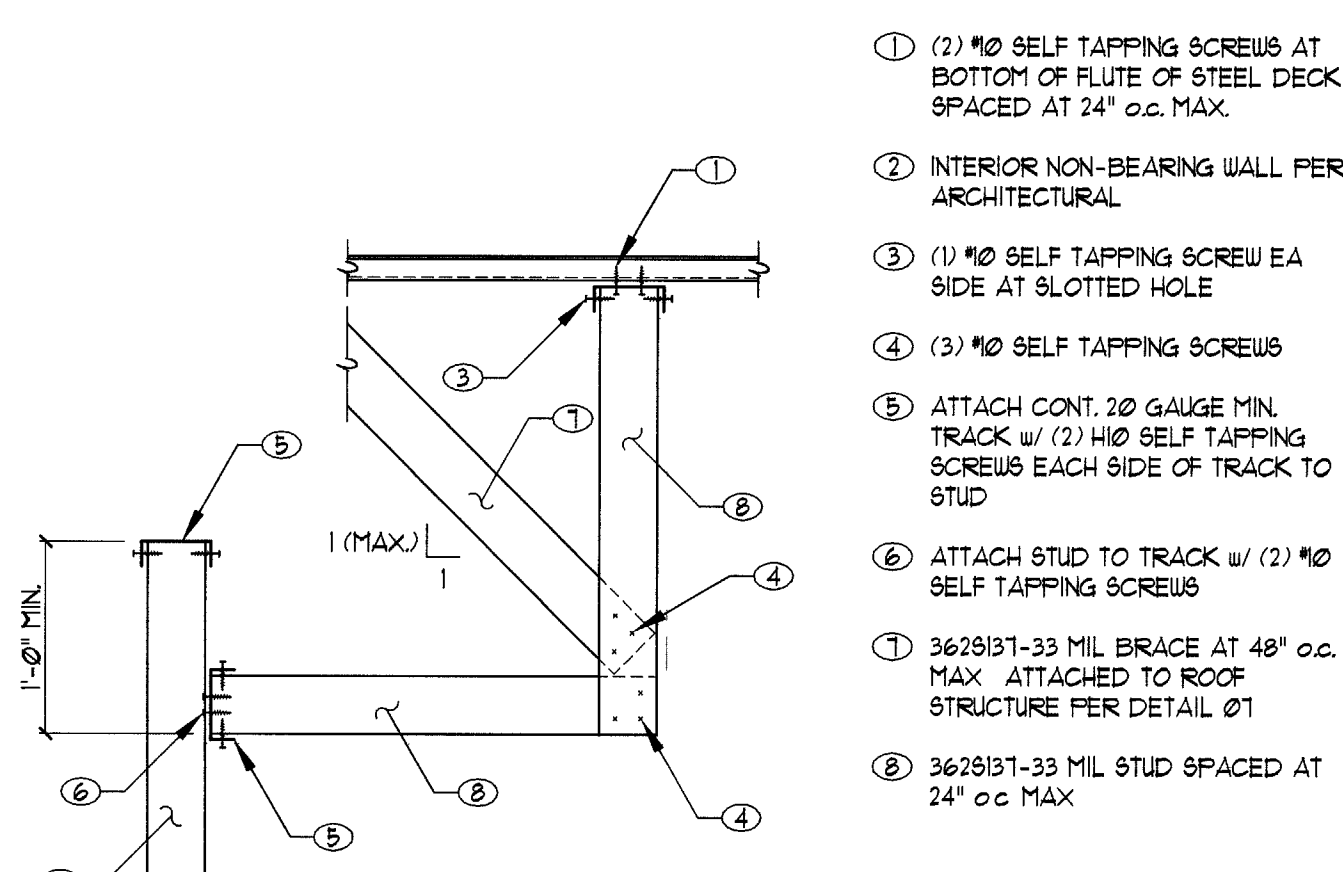

13 TYPICAL STEEL STUD SOFFIT
13-01 03060 NO SCALE

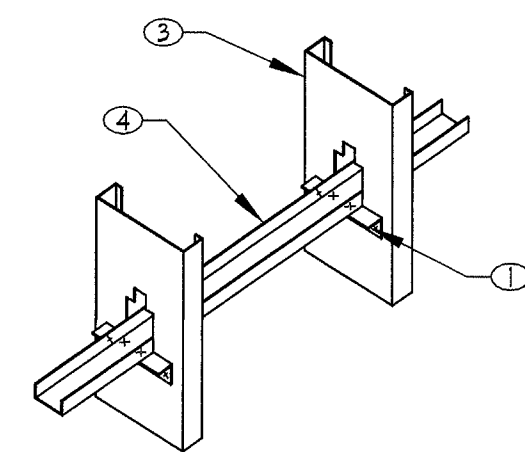


B COLD ROLLED LATERAL BRACING

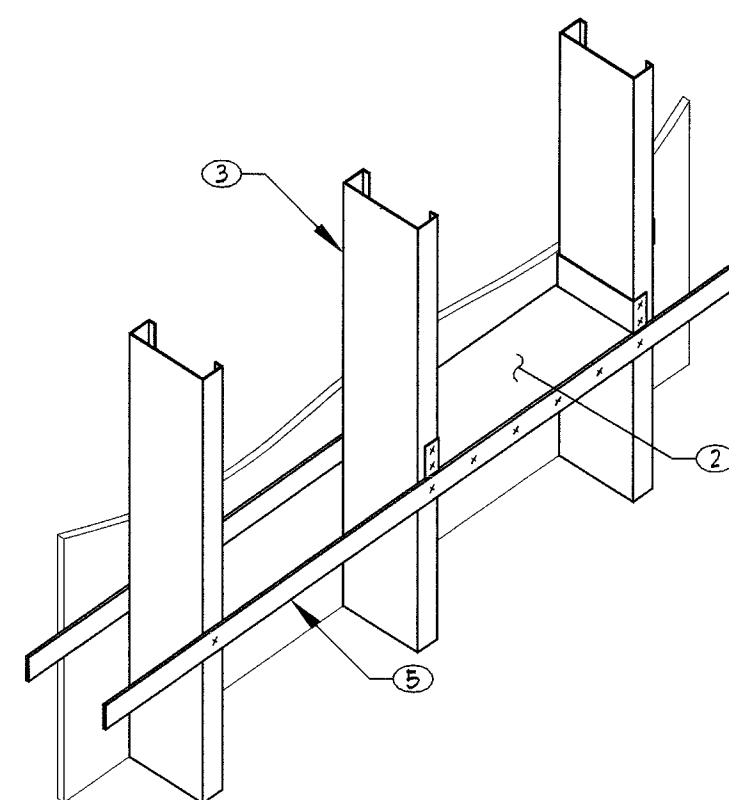


A FLAT STRAP LATERAL BRACING

14 LATERAL BRACING
14-01 03050 NO SCALE

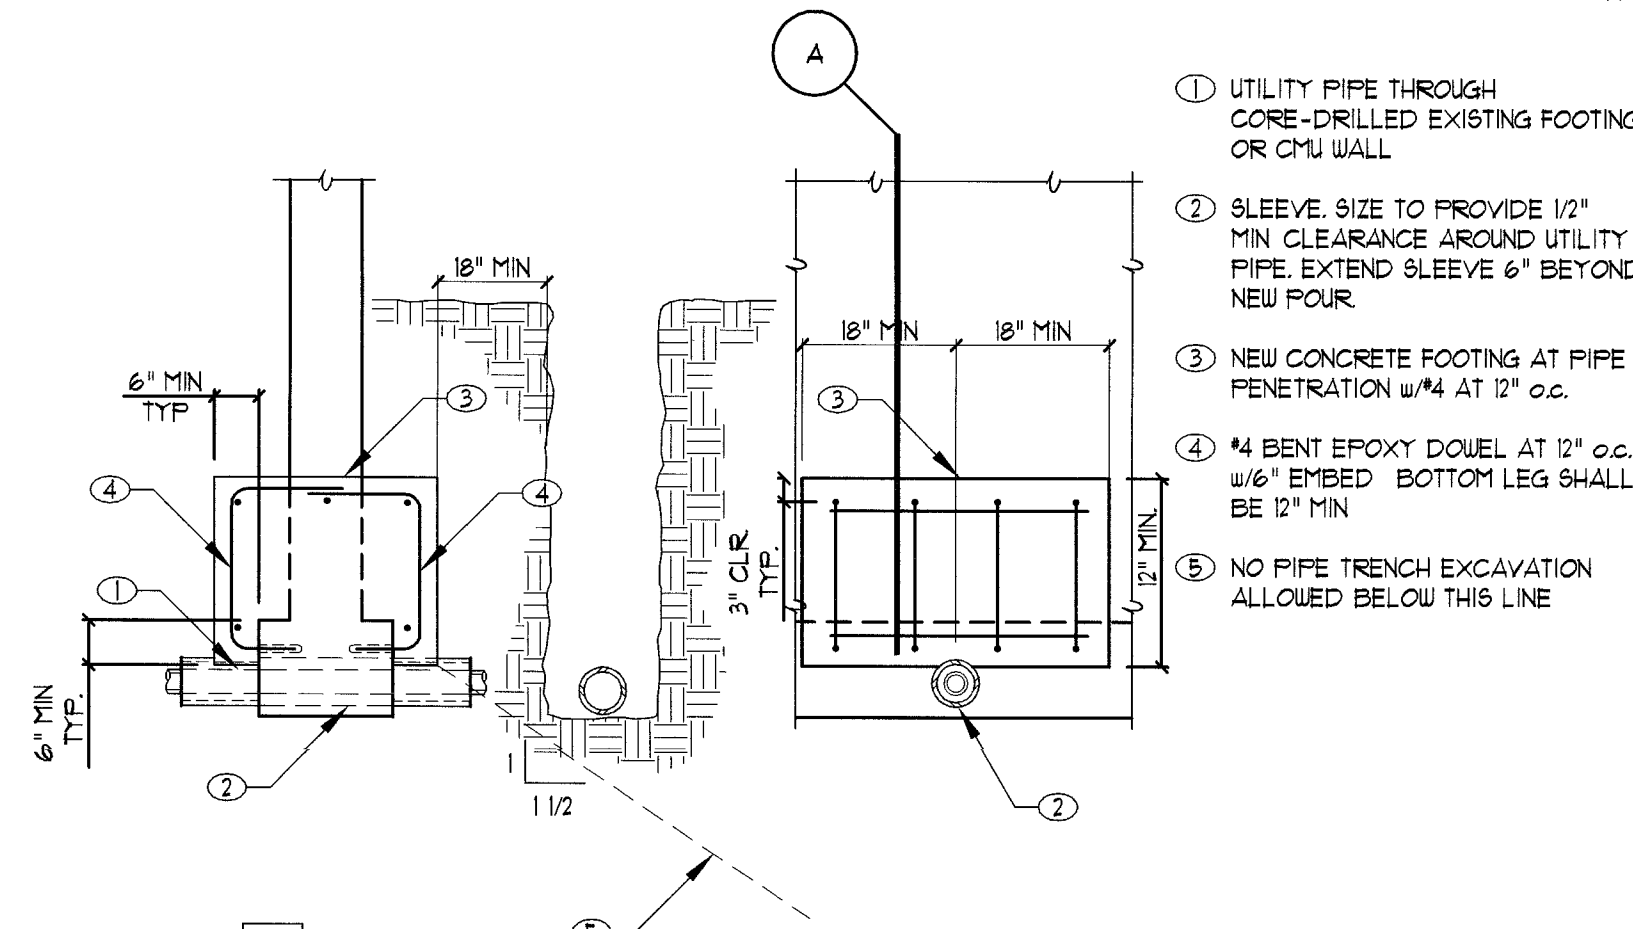

15 UTILITY PIPES THROUGH FOOTING
15-01 03050 NO SCALE

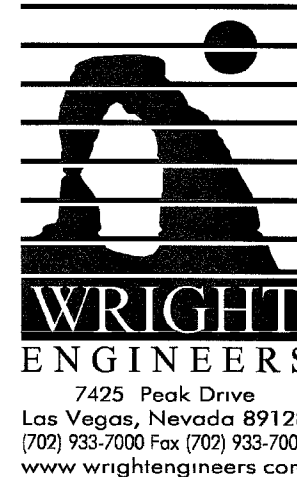

7425 Peak Drive
Las Vegas, Nevada 89128
(702) 933-7000 fax (702) 933-7001
www.wrightengineers.com

REVISIONS		PLANCHCK -
1	06/24/04	STRUCTL REV
2	02/10/04	PLANCHCK
3	3/31/05	STRUCTL
		REVISIONS

JMA ARCHITECTURE STUDIOS

10155 COTTONWOOD DRIVE LAS VEGAS, NEVADA 89144 (702) 731 2033

CITY OF LAS VEGAS
DOWNTOWN SENIOR SERVICES CENTER
NEIGHBORHOOD SERVICES

RECORD DRAWINGS

OWNER: CITY OF LAS VEGAS
DEPARTMENT OF PUBLIC WORKS
ARCHITECTURAL SERVICES

400 EAST STEWART AVENUE
LAS VEGAS, NEVADA 89101
PHONE: (702) 226-6535
FAX: (702) 382-2232
TDD: (702) 386-9108

DRAWN: VAC / BCG

FILE: 0070234940

DATE: MAY 10, 2004

SCALE: NO SCALE

REV NO: 04.153410

CLD DWG NO: 521-287

STANDARD DETAILS

REV NO: S0.3