


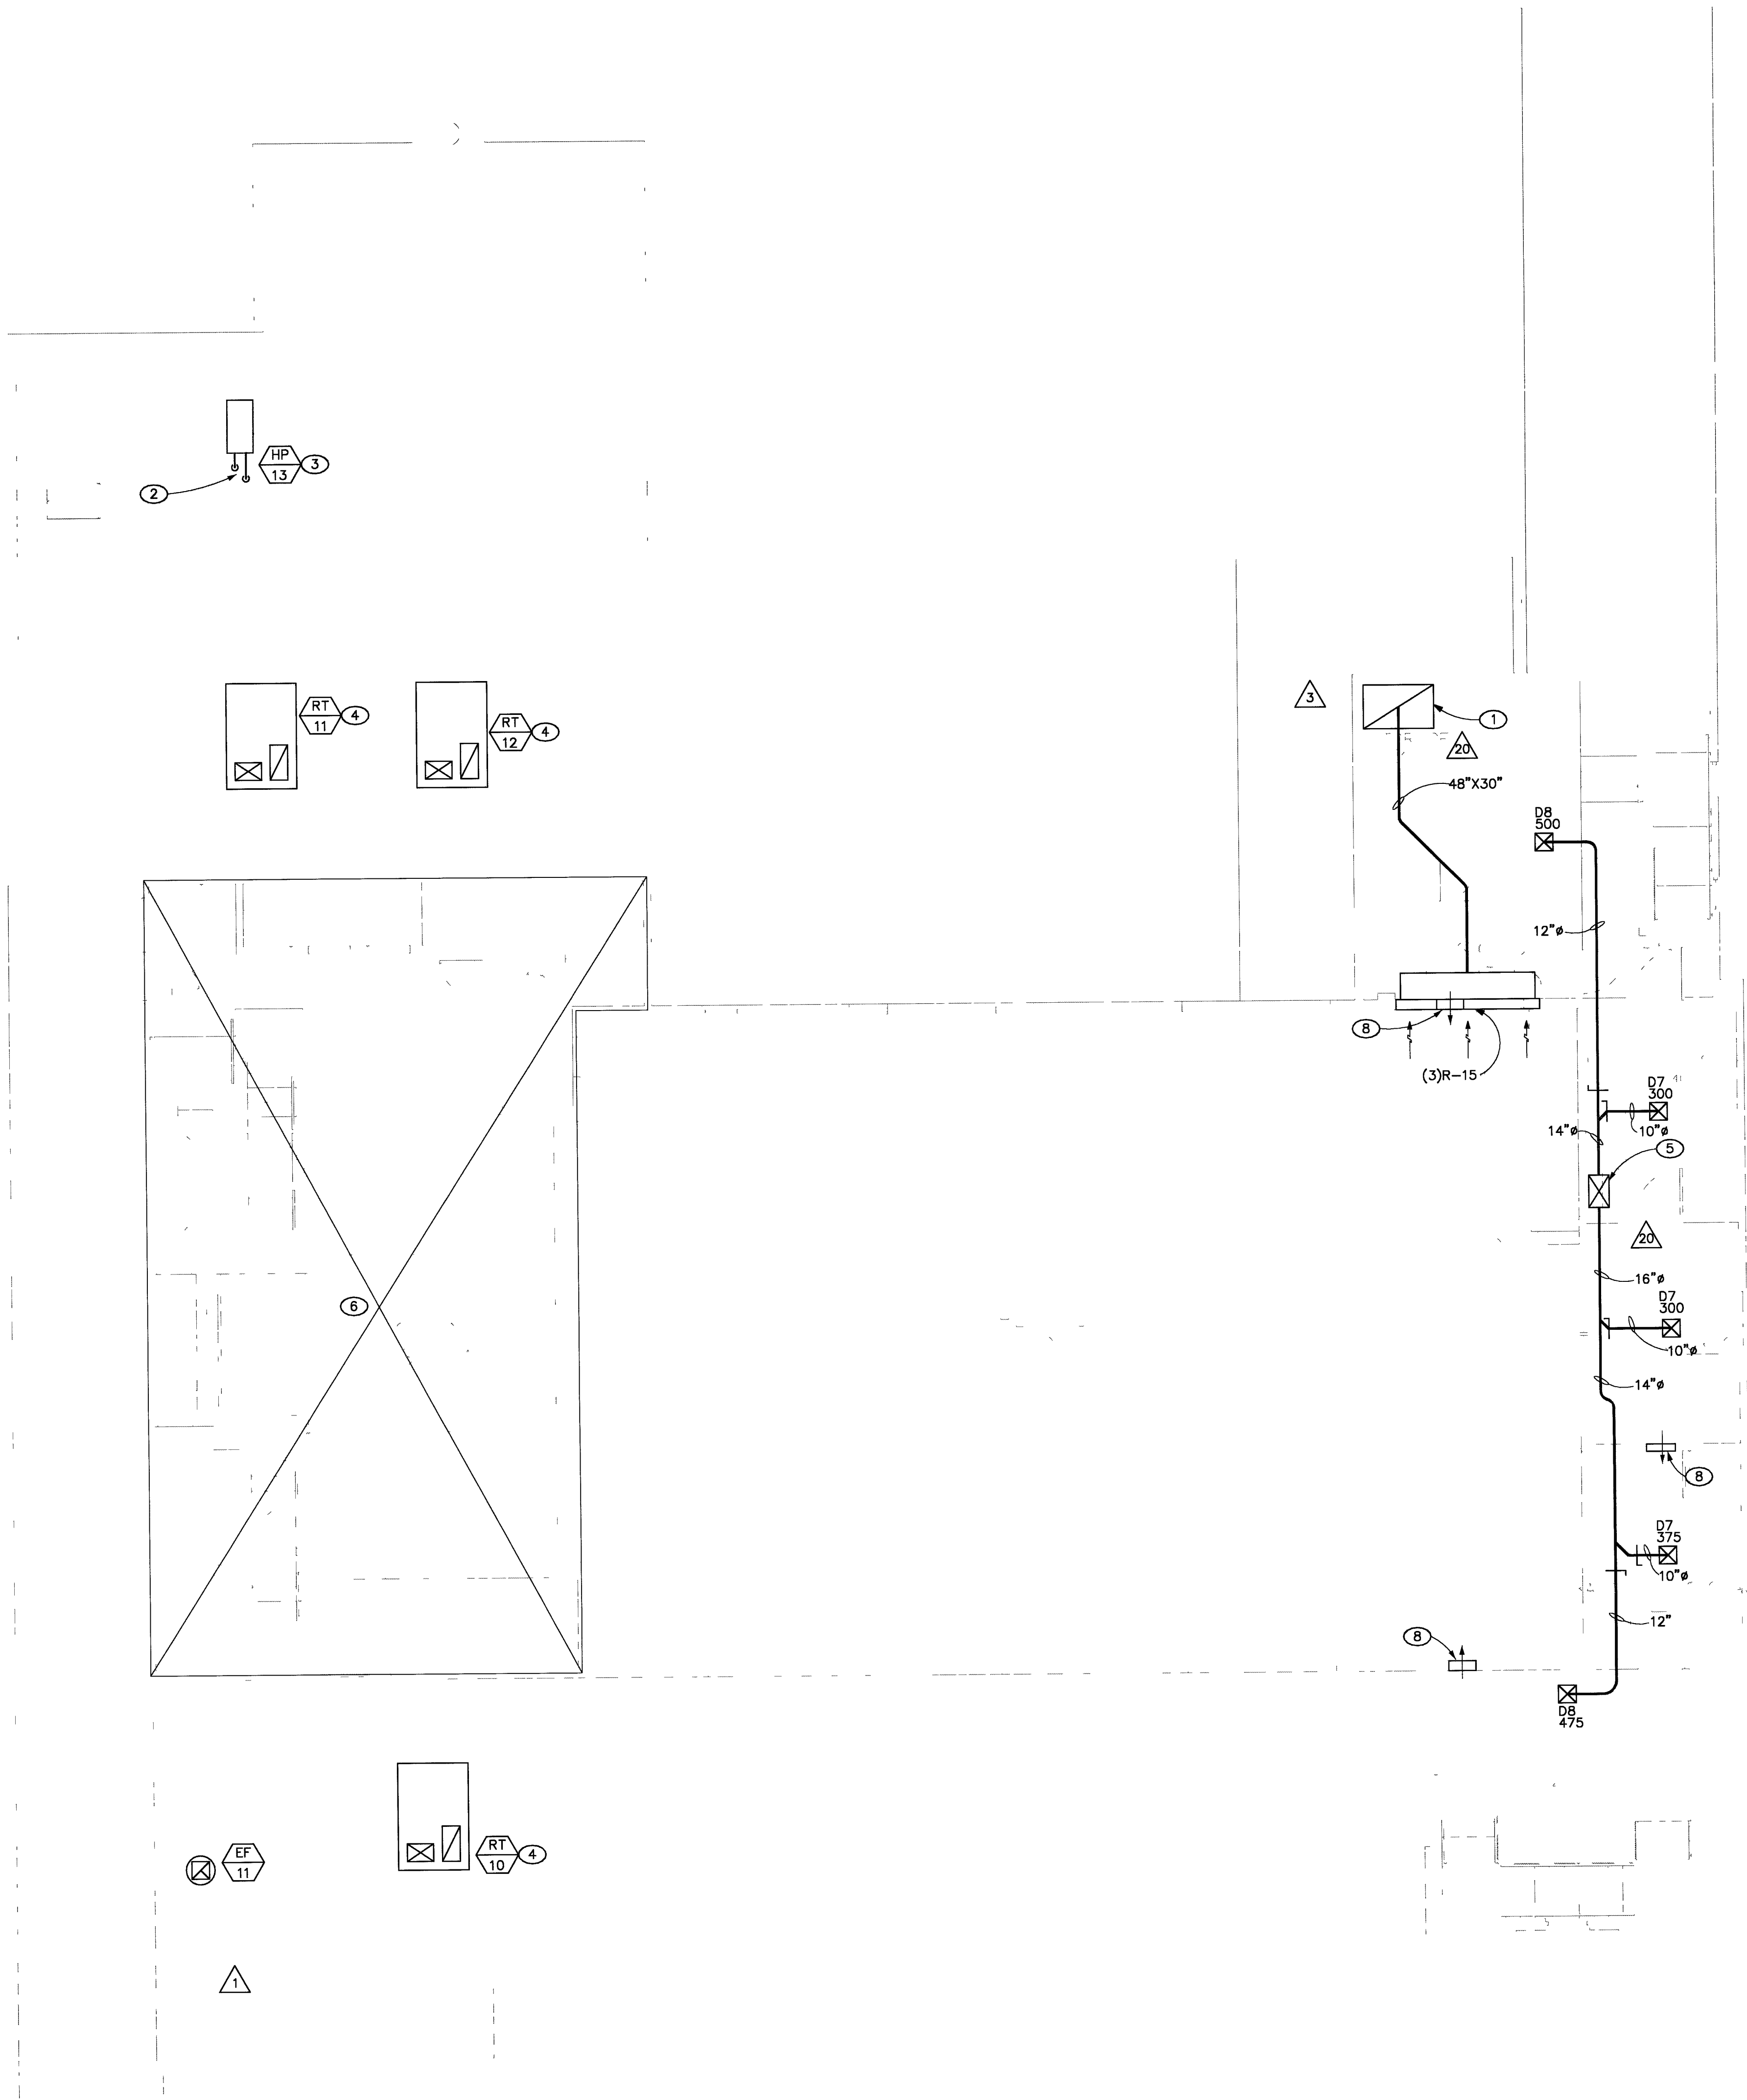

MECHANICAL PLAN BUILDING III LEVEL 2
SCALE: 3/16"=1'-0"

GENERAL NOTES

1. PRIOR TO SUBMITTING BID, CONTRACTOR SHALL VISIT SITE TO DETERMINE THE EXTENT OF HVAC DEMOLITION WORK TO OBSERVE THE EXISTING PHYSICAL CONDITIONS AFFECTING INSTALLATION OF NEW SYSTEMS AND TO UNDERSTAND THE SPACE LIMITATIONS IMPOSED ON THE PROPOSED NEW WORK.
2. ALL EXISTING EQUIPMENT/UNITS, DUCTWORK, PIPING, CONTROLS, ETC. SERVING THIS BUILDING SHALL BE REMOVED AND NOT REUSED.
3. PROVIDE A COMPLETE SYSTEM OF SUPPLY, RETURN AND EXHAUST DUCT DISTRIBUTION. DUCTWORK SHALL BE GALVANIZED STEEL (NOT A FLEX DUCT INSTALLATION).
4. THE MECHANICAL CONTRACTOR SHALL VERIFY LOCATION OF ROOF MOUNTED EQUIPMENT WITH ARCHITECT AND STRUCTURAL ENGINEER PRIOR TO BEGINNING OF WORK. MECHANICAL CONTRACTOR SHALL SUBMIT SHOP DRAWINGS TO STRUCTURAL ENGINEER FOR APPROVAL SHOWING METHOD OF MOUNTING AND ATTACHMENT.
5. PRIOR TO BEGINNING WORK, THE MECHANICAL CONTRACTOR SHALL COORDINATE LOCATION AND ROUTING OF HVAC EQUIPMENT WITH OTHER TRADES.
6. THE MECHANICAL CONTRACTOR SHALL VERIFY LOCATION OF ROOF AND WALL PENETRATIONS WITH ARCHITECT AND STRUCTURAL ENGINEER PRIOR TO BEGINNING WORK. MECHANICAL CONTRACTOR SHALL SUBMIT SHOP DRAWINGS TO THE STRUCTURAL ENGINEER FOR APPROVAL SHOWING METHOD OF MOUNTING AND ATTACHMENT.
7. MECHANICAL CONTRACTOR SHALL COORDINATE AIR DEVICES WITH ARCHITECT PRIOR TO BEGINNING WORK. COORDINATE BORDER AND FRAME STYLE OF AIR DEVICES WITH ARCHITECTURAL REFLECTED CEILING PLAN PRIOR TO ORDERING.
8. VERIFY LOCATION OF THERMOSTATS WITH THE ARCHITECT PRIOR TO ROUGH-IN. THERMOSTATS SHALL BE MOUNTED IN ACCORDANCE WITH A.D.A. STANDARDS. VERIFY TYPE OF LOCKING COVER WITH ARCHITECT. THERMOSTATS INSTALLED IN PUBLIC AREAS SHALL HAVE CLEAR PLASTIC LOCKING COVERS. PROVIDE INSULATED SUBBASE FOR THERMOSTATS MOUNTED ON BUILDING EXTERIOR WALL.
9. DUE TO SPACE CONSTRAINTS, MECHANICAL CONTRACTOR SHALL CLOSELY COORDINATE ROUTING OF DUCTWORK AND PIPING WITH STRUCTURAL FRAMING PLANS AND OTHER TRADES. CHANGES REQUIRED DUE TO CONTRACTOR'S FAILURE TO COORDINATE SPACE AND ROUTING REQUIREMENTS SHALL BE DONE AT NO ADDITIONAL COST TO THE OWNER.
10. DUCT AND PLENUM SIZES SHOWN ARE THE NET DIMENSION INSIDE THE LINER.
11. SEE PLUMBING PLANS FOR SIZES AND ROUTING OF CONDENSATE DRAINS.
12. ACCESS DOORS / PANELS ARE REQUIRED FOR EQUIPMENT, VALVES, DAMPERS, ETC. INSTALLED ABOVE INACCESSIBLE CEILINGS. COORDINATE EXACT LOCATION OF ACCESS DOORS / PANELS WITH ARCHITECT PRIOR TO INSTALLATION. MAINTAIN REQUIRED CLEARANCES FOR DOORS / PANELS.
13. SEE ARCHITECTURAL DRAWINGS FOR FIRESTOPPING DETAILS / REQUIREMENTS.
14. SEE HVAC SPECIFICATIONS FOR VIBRATION ISOLATION / SEISMIC RESTRAINT REQUIREMENTS.
15. NO SERVICEABLE EQUIPMENT SHALL BE INSTALLED OVER 18" ABOVE CEILINGS.
16. SEE BOOK SPECIFICATION SECTION 15050 REGARDING THE REQUIREMENT FOR COORDINATION DRAWINGS. OBTAIN APPROVAL FOR SUBMITTED COORDINATION DRAWINGS PRIOR TO PURCHASE AND/OR FABRICATION OF DUCT SYSTEMS.
17. ANY DUCT SYSTEM PENETRATING FIRE WALLS OR FIRE BARRIERS SHALL HAVE FIRE DAMPERS OR BE OF 26 GAUGE CONSTRUCTION MINIMUM. IF THE DUCT SYSTEM IS TO BE 26 GAUGE, THE ENTIRE DUCT SYSTEM, NOT JUST THE PENETRATING DUCTS SHALL BE 26 GAUGE MINIMUM. (PROVIDE HEAVIER DUCT GAUGE WHEN REQUIRED BY SMACNA DUCT CONSTRUCTION STANDARDS).

SHEET NOTES

- ① 30"x48" R.A. DUCT DOWN.
- ② CUSTOM PIPE BOX EQUAL TO CUSTOM CURB INC. WITH LINED COVER AND BOX. REFRIGERANT PIPING, CONTROL CONDUIT AND POWER CONDUIT SHALL HORIZONTALLY ENTER/EXIT BOX. SUBMIT SHOP DRAWING OF PROPOSED INSTALLATION FOR APPROVAL.
- ③ MOUNT ON LOW ROOF ON CURBED EQUIPMENT PLATFORM EQUAL TO CUSTOM CURB, INC. SECURE EQUIPMENT TO PLATFORM. SUBMIT SHOP DRAWING OF PROPOSED INSTALLATION FOR APPROVAL.
- ④ UNIT MOUNTED ON ROOF CURB ON EXISTING LOW ROOF. PROVIDE FLEX CONNECTION ON SUPPLY AND RETURN DUCT CONNECTIONS TO UNIT.
- ⑤ 16"x20" SUPPLY AIR DUCT DOWN.
- ⑥ SEE ARCHITECTURAL DRAWINGS. THIS AREA TO BE SEALED OFF. NO HVAC WORK INCLUDED.
- ⑦ RG-1 BOTH SIDES OF WALL WITH TOP APPROXIMATELY 2" BELOW CEILING.
- ⑧ RG-2 BOTH SIDES OF WALL WITH TOP APPROXIMATELY 2" BELOW CEILING.

RECORD DRAWINGS
Date 01/28/08 This record drawing has been prepared in part, based upon information furnished by others. While this information is believed to be reliable, Harris Consulting Engineers LLC cannot assure it's accuracy, and is not responsible for the accuracy of this record drawing or for any errors or omissions which may have been incorporated into it as a result. Those relying on this record drawing are advised to obtain independent verification of it's accuracy before applying it for any purpose.

PROJECT NO. 23154.30	DESIGNED BY: S. SAGON
CHECKED BY: R.S. HARRIS	DRAWN BY: C. SADLER
PM: J. HEAL	

REVISIONS

5-21-04

PLAN CHECK

6-23-04

PLAN CHECK

7-14-04

PLAN CHECK

01-25-06

RECORD DRAWING

CONSISTENT

JMA ARCHITECTURE STUDIOS

10155 CONVENT ROAD SUITE 1000
LAS VEGAS, NEVADA 89144 (702) 731-1000

CITY OF LAS VEGAS
DOWNTOWN SENIOR SERVICES CENTER
NEIGHBORHOOD SERVICES

RECORD SET

OWNER: CITY OF LAS VEGAS
DEPARTMENT OF PUBLIC WORKS
ARCHITECTURAL SERVICES

200 EAST STEWART AVENUE
LAS VEGAS, NEVADA 89101
PHONE: (702) 328-4834
FAX: (702) 328-3232
TDD: (702) 328-9109

DRAWN: MB

FILE: M2.04.DWG

DATE: September 8, 2004

SCALE: 3/16"=1'-0"

REV NO: 04B34101

CLV Dwg NO: 521-281

PROJECT NO: MECHANICAL PLAN LEVEL 2

PROJECT NO. 23154.30
DESIGNED BY: S. SAGON
CHECKED BY: R.S. HARRIS
DRAWN BY: C. SADLER
PM: J. HEAL

95956

M2.04