
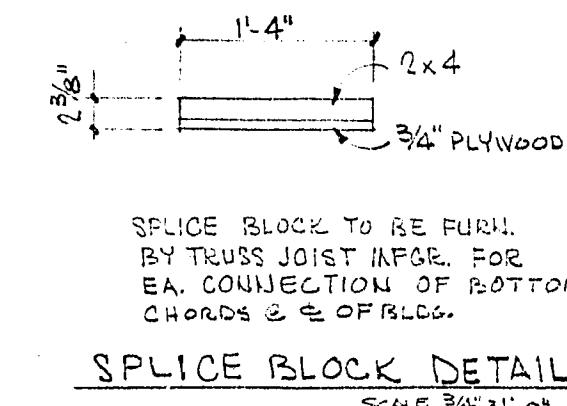
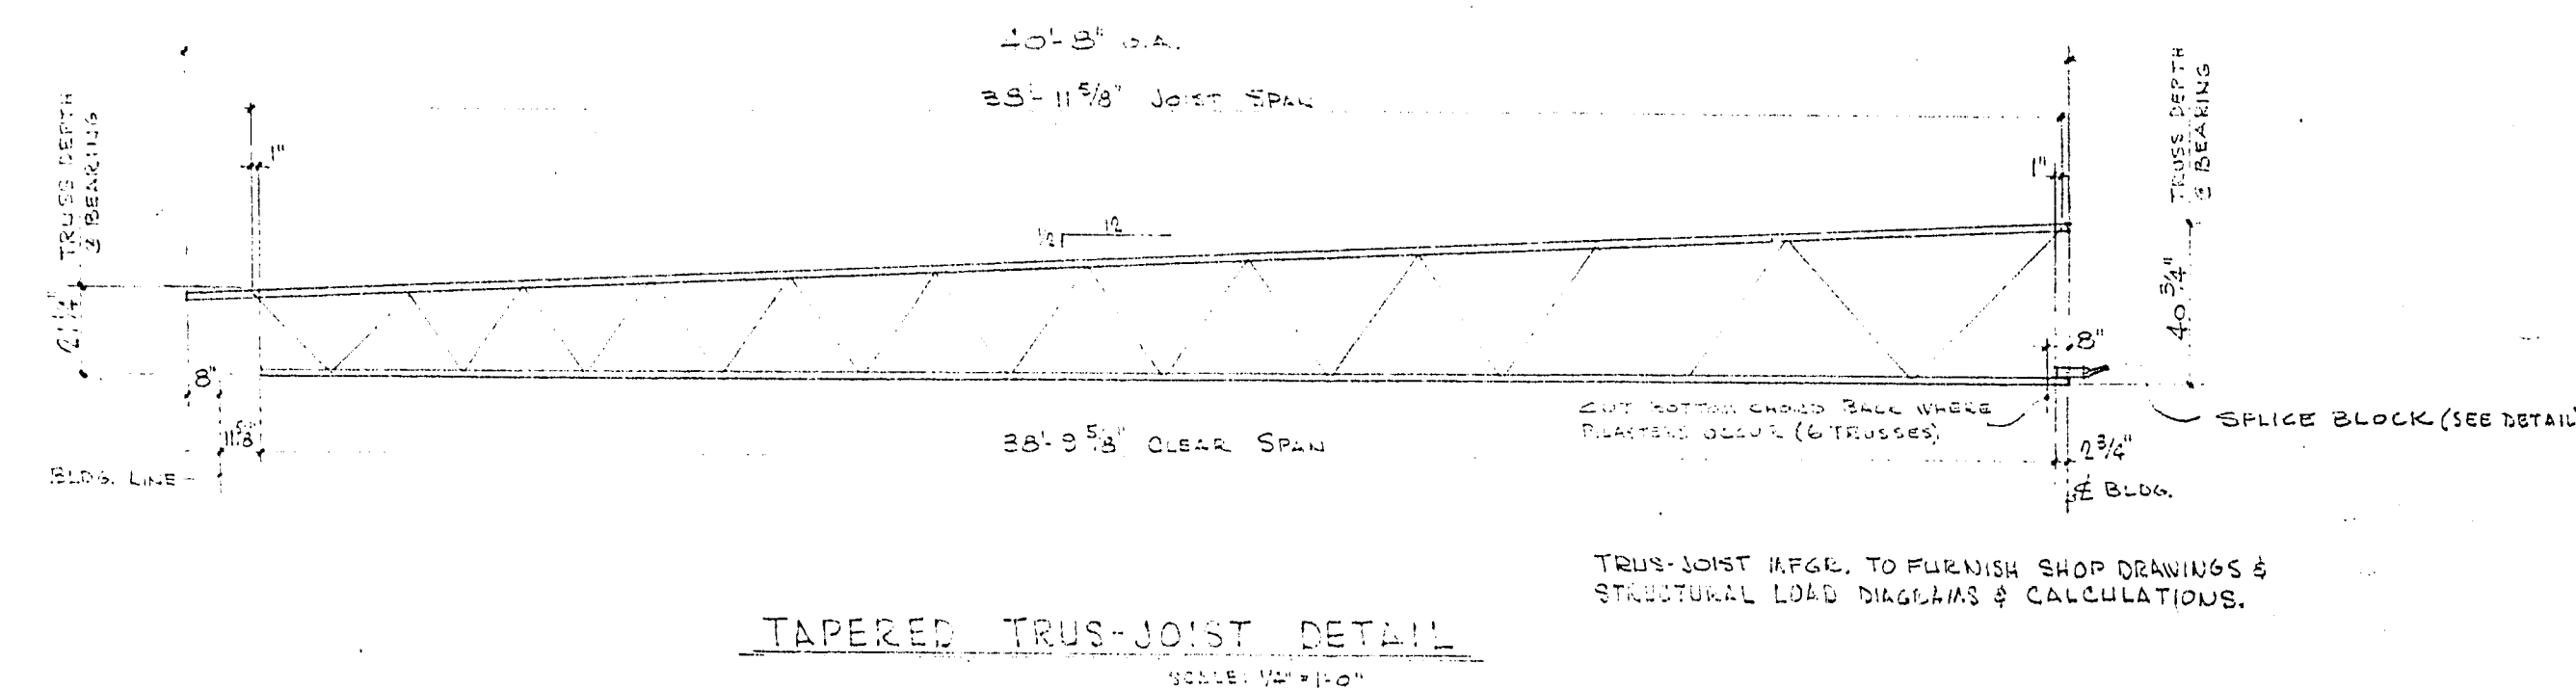


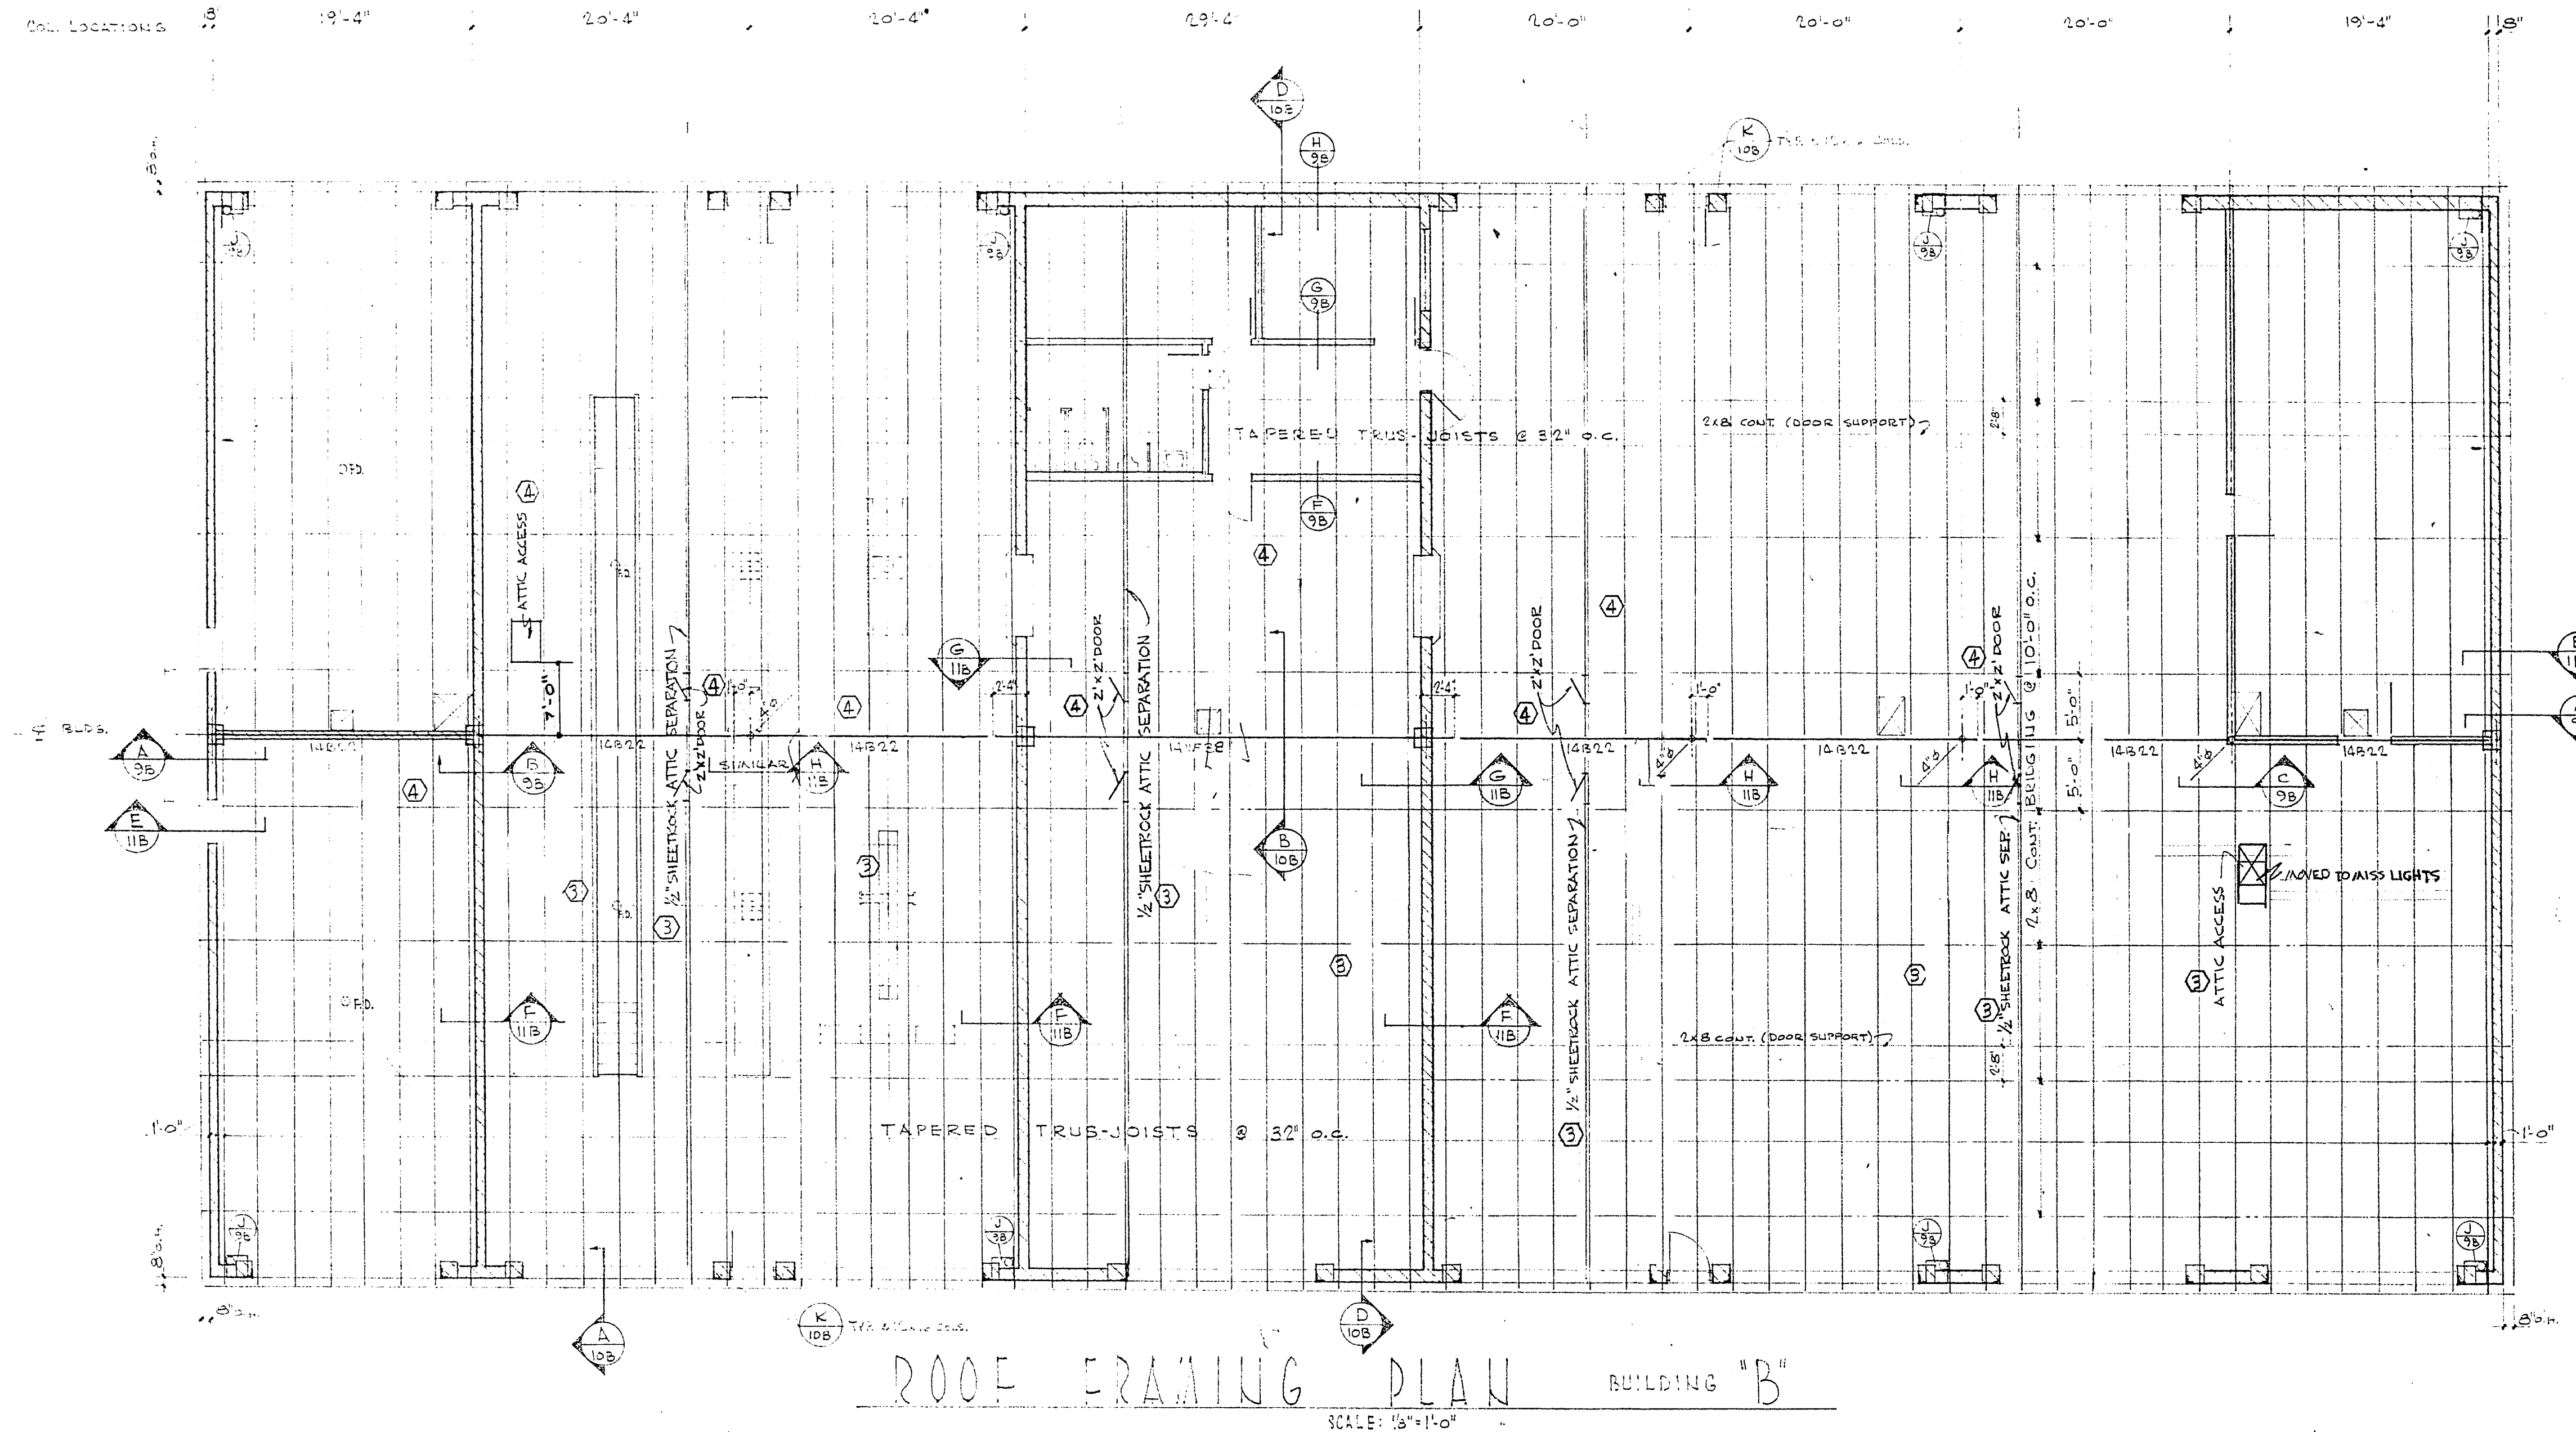

- ③ SEE SHEET 8 A FOR CONST. DETAILS - ACCESS PANELS - ATTIC SEPARATION - 2x2 DOORS
 ④

AS BUILT

REVISIONS	
1	5/6/66
2	26 MAY 66
3	ADD ATTIC SEP. & ACCESS PANELS 11-2-66
4	REVISE REVISION ③ 11-3-66
5	
6	
7	
8	
DATE 3-15-66	
DRAWN BY AKP	
CHECKED BY	
SHEET TITLE ROOF FRAMING PLAN BUILDING "B" JOB TITLE CITY YARD FACILITIES FOR THE CITY OF LAS VEGAS, NEVADA Jack T. Borchert 217 GARCES AVE. 385-1464 LAS VEGAS, NEVADA	
JOB 6510 SHEET 8B OF 30 TOTAL AS BUILT DRAWING AS SUBMITTED BY CONTRACTOR	