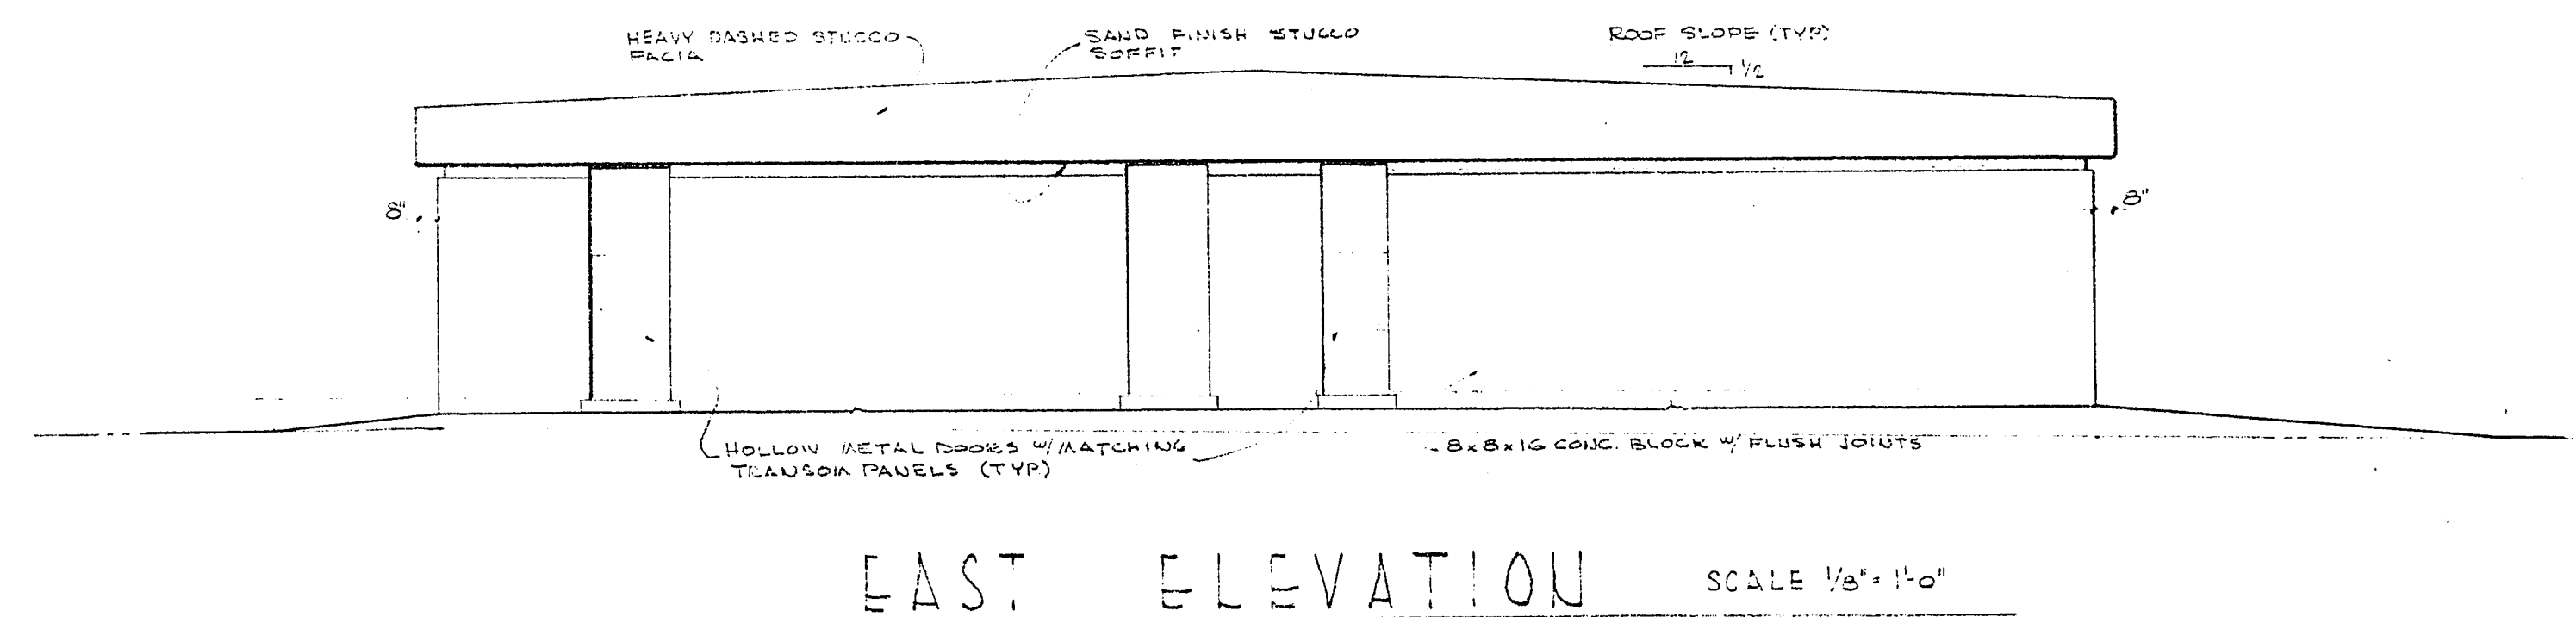
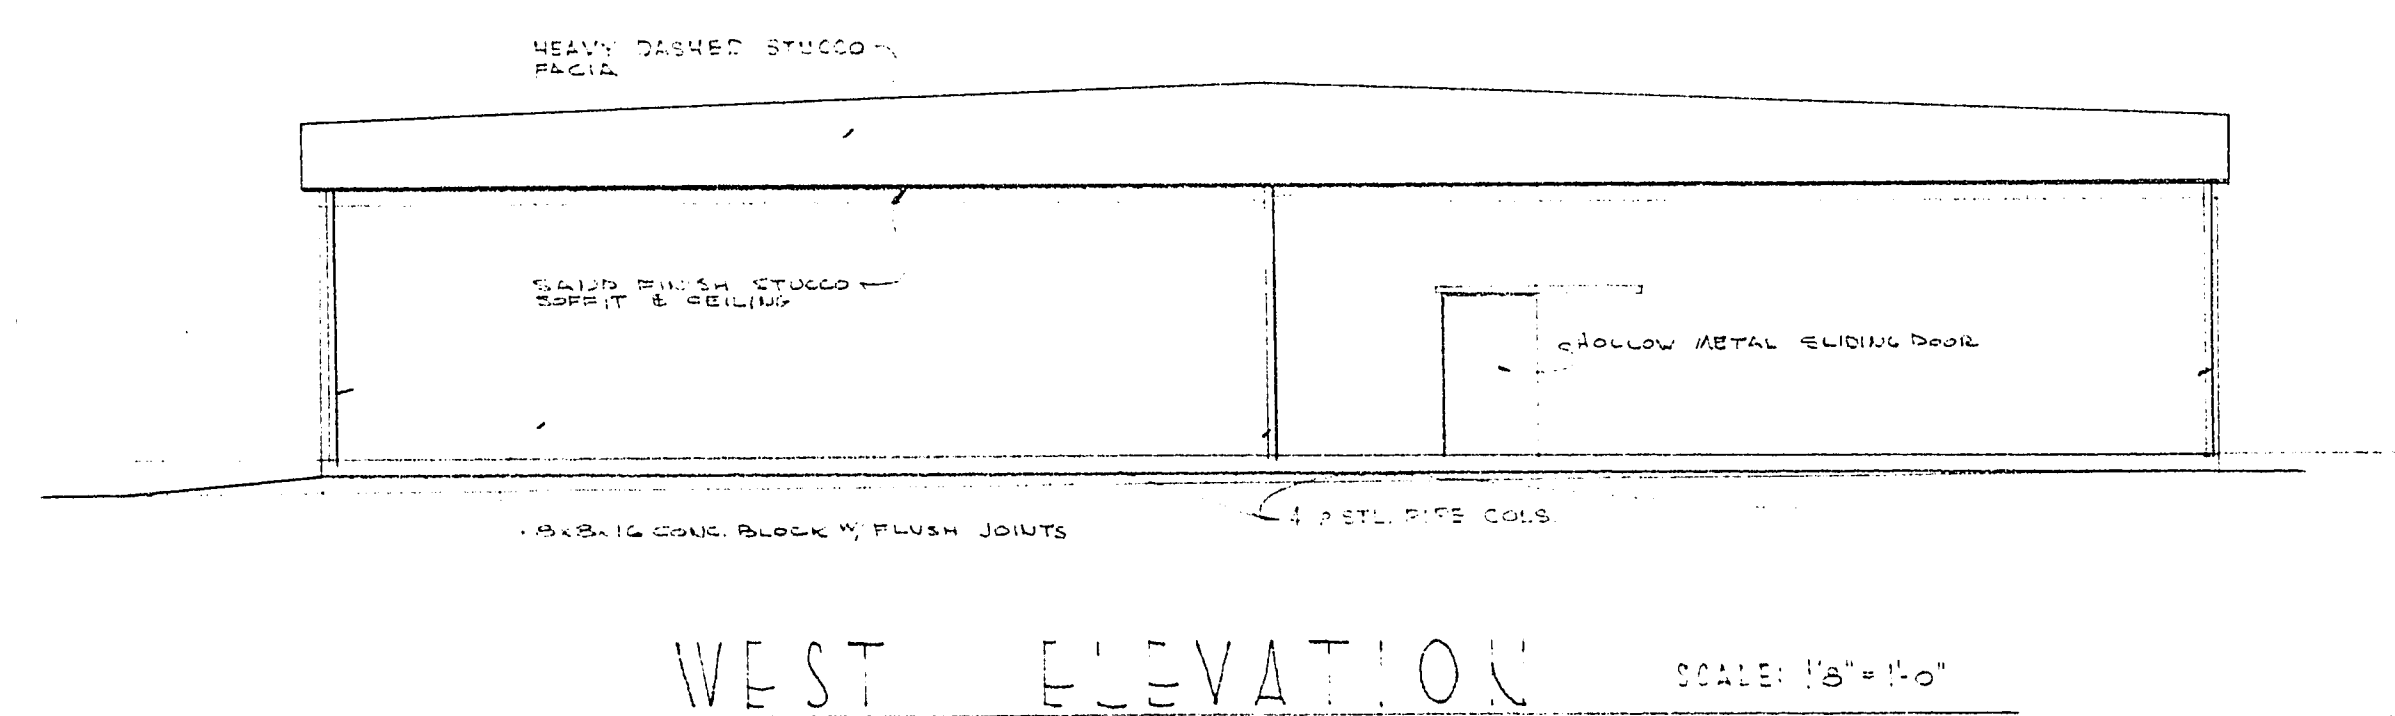
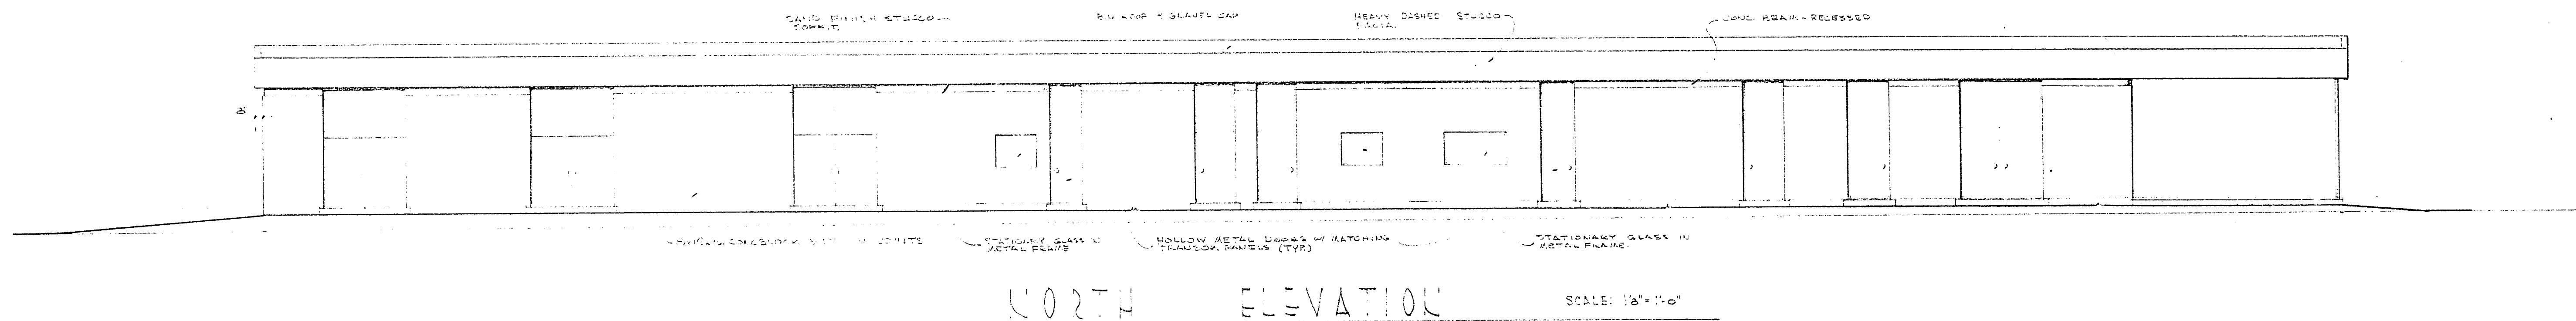


AS BUILT

REVISIONS	
1	
2	
3	
4	
5	
6	
7	
8	
DATE	3-15-66
DRAWN BY	AKP
CHECKED BY	
SHEET TITLE EXTERIOR ELEVATIONS BUILDING "A"	
JOB 6510	
SHEET 4A	
OF 36 TOTAL	
JACK T. Belcher A.I.A. LAS VEGAS, NEVADA 217 GARCES AVE. CITY YARD FACILITIES FOR THE CITY OF LAS VEGAS, NEVADA	