



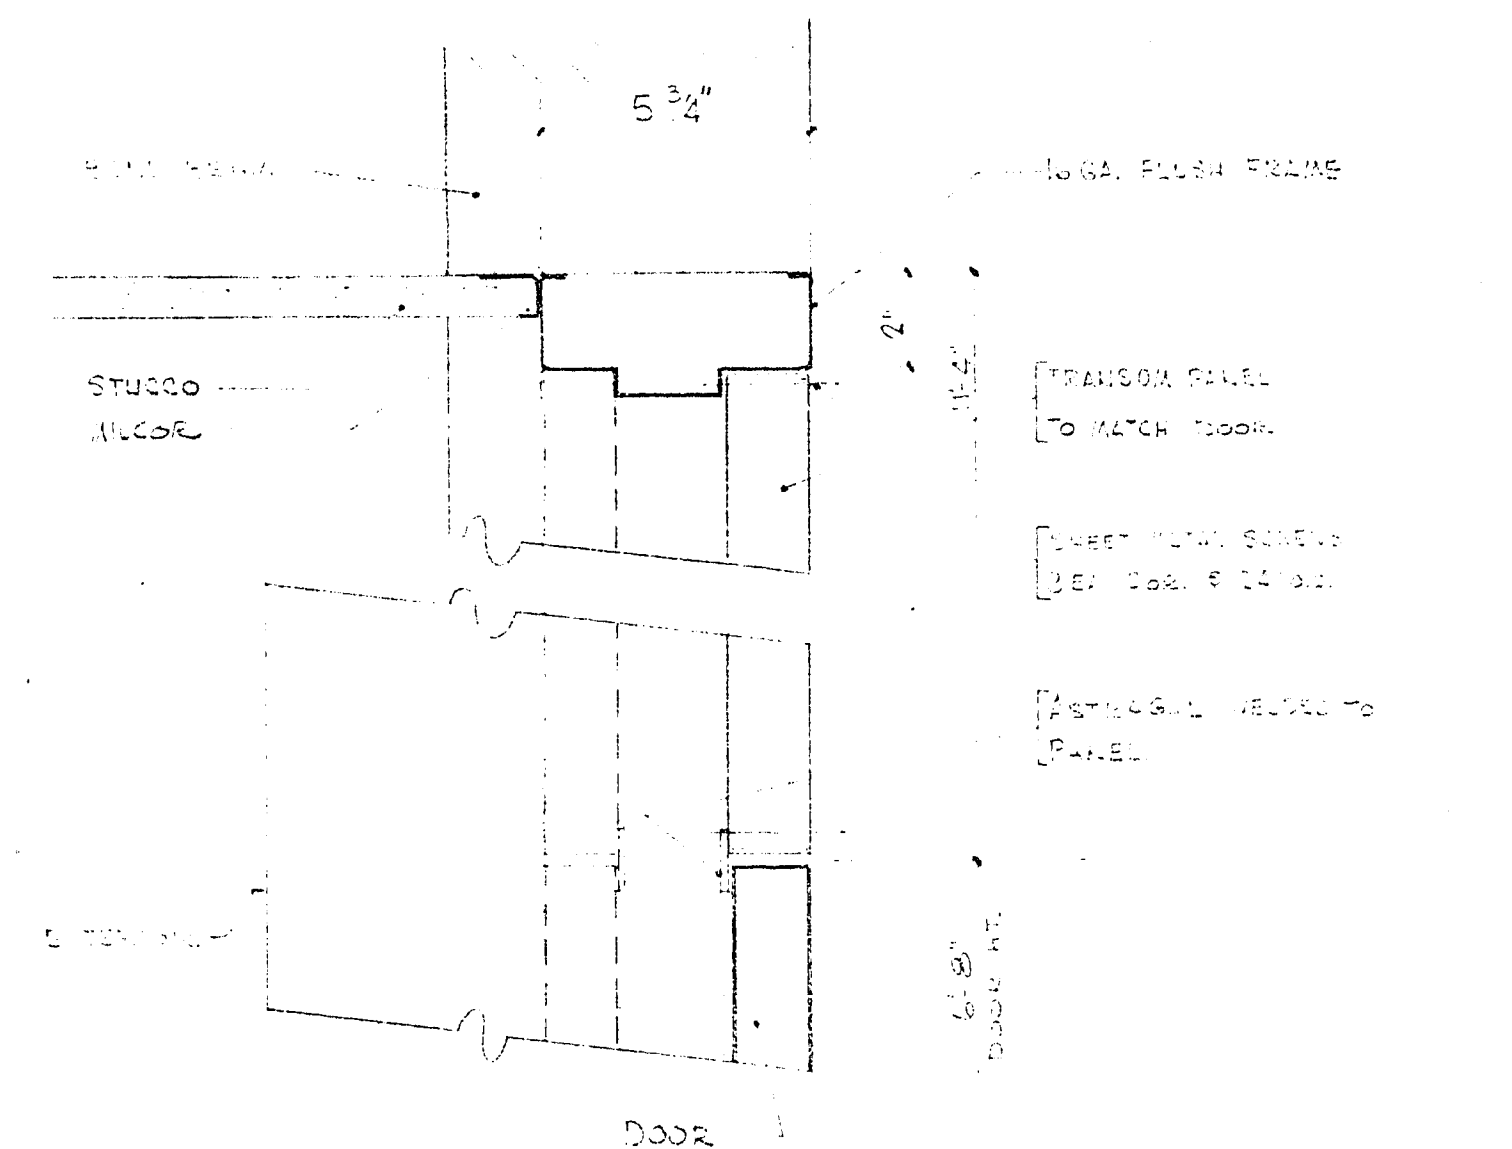


HEAD
DETAIL A
SCALE: 3/4"=1'-0"

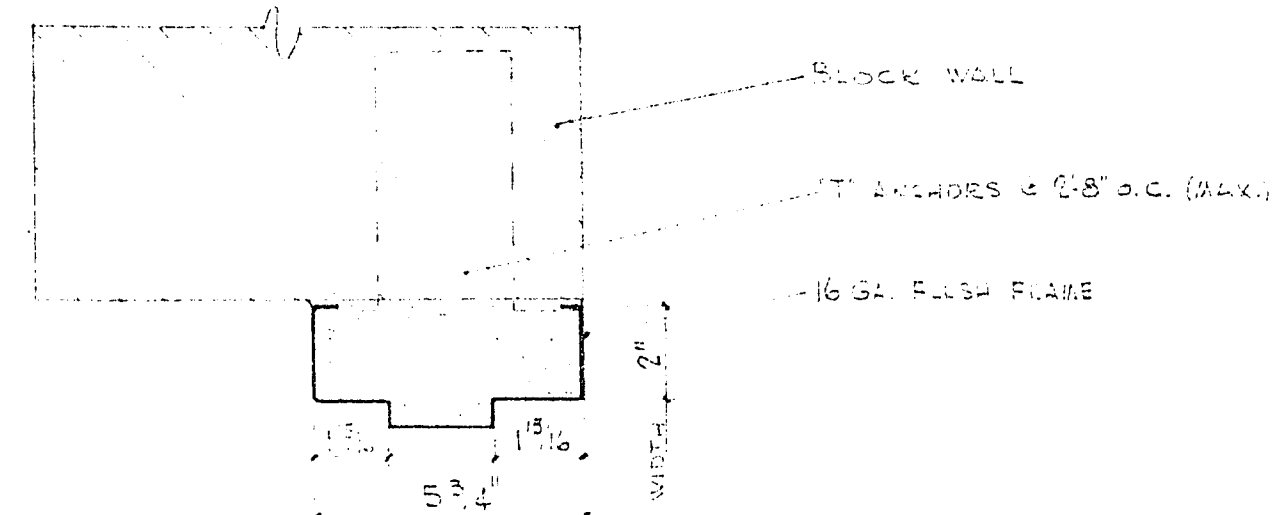


JAMB
DETAIL B
SCALE: 3/4"=1'-0"


NOTE: DOORS SWINGING
OUT ARE INDICATED
BY DOTTED LINE.

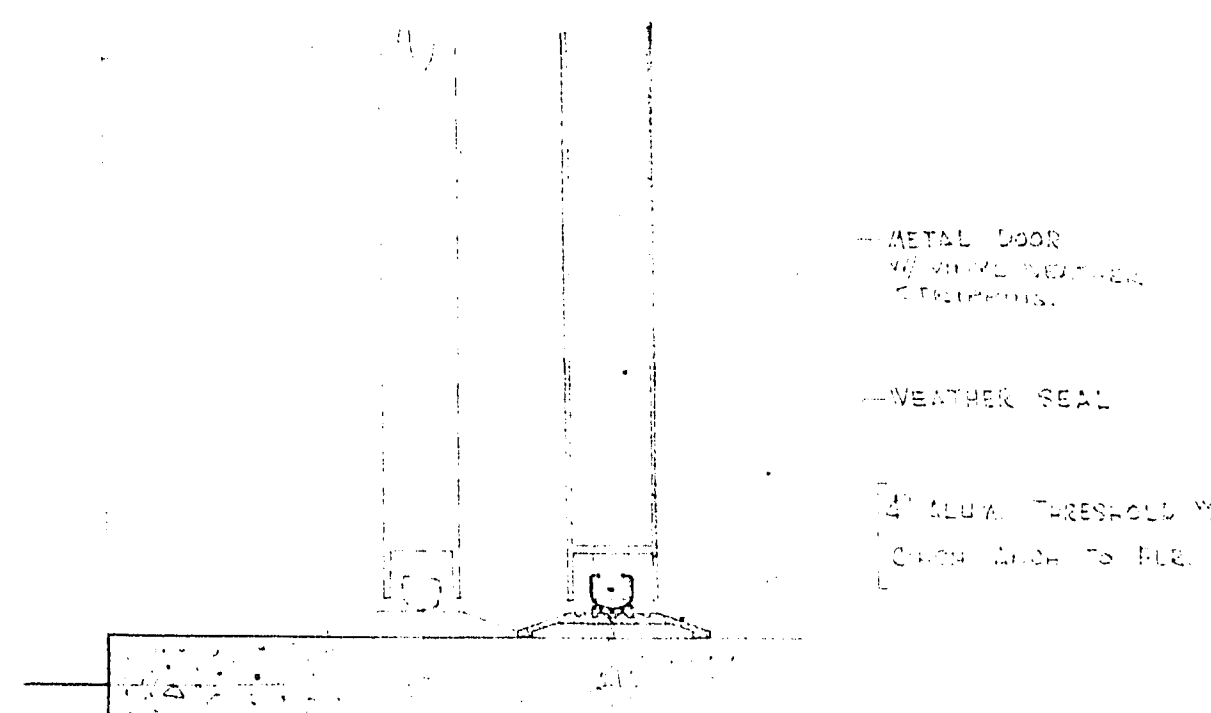


DETAIL C
SCALE: 3/4"=1'-0"

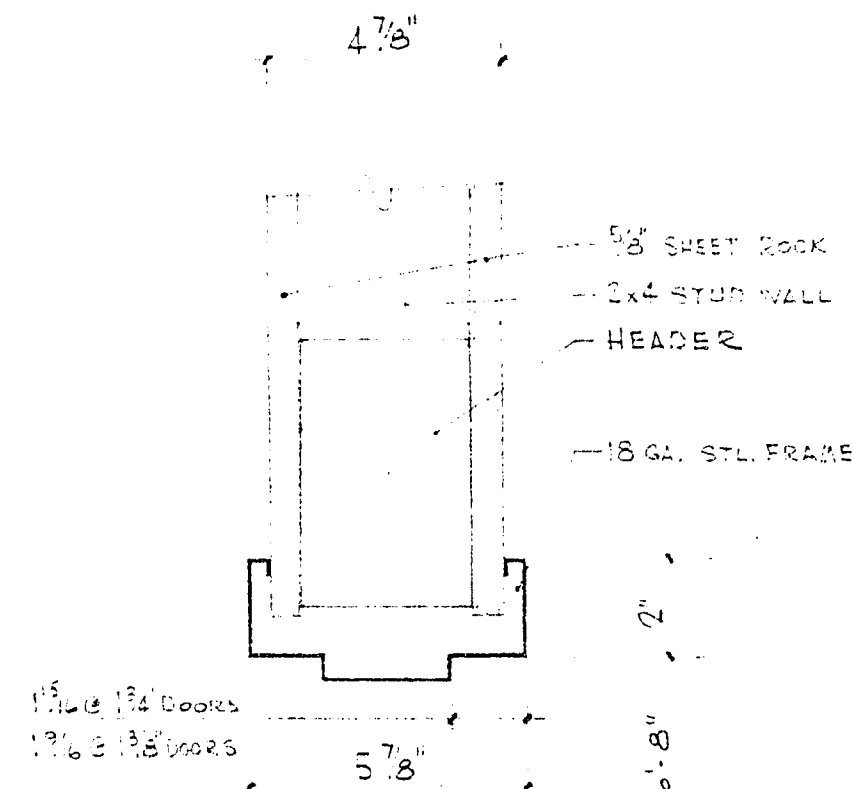


HEAD
DETAIL D
SCALE: 3/4"=1'-0"

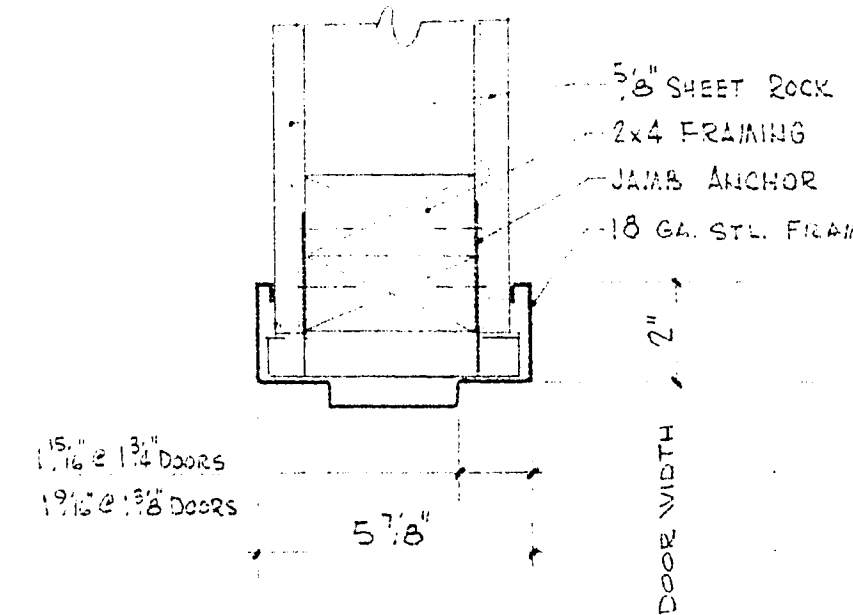


JAMB
DETAIL E
SCALE: 3/4"=1'-0"

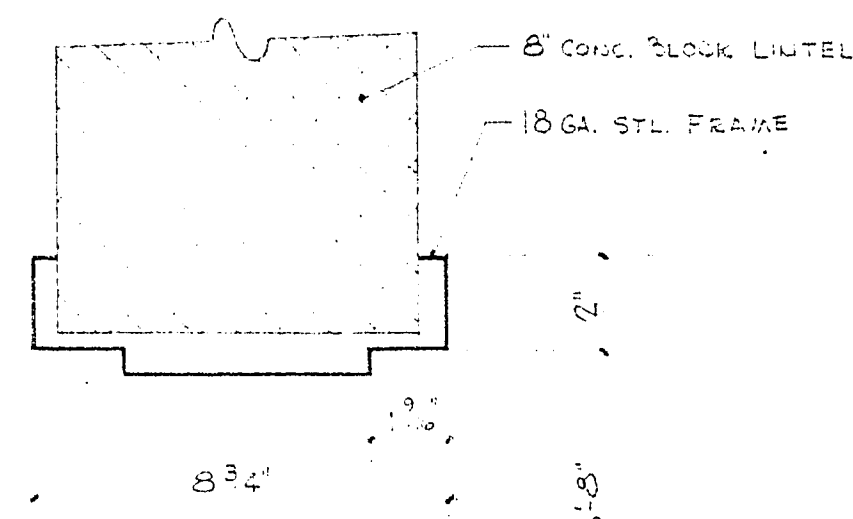



HEAD
DETAIL F
SCALE: 3/4"=1'-0"

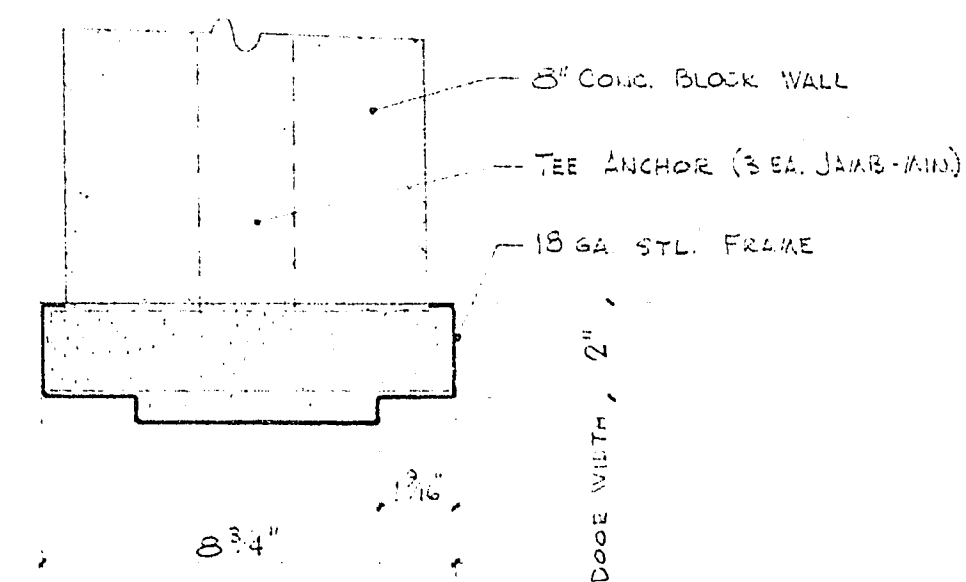


JAMB
DETAIL G
SCALE: 3/4"=1'-0"

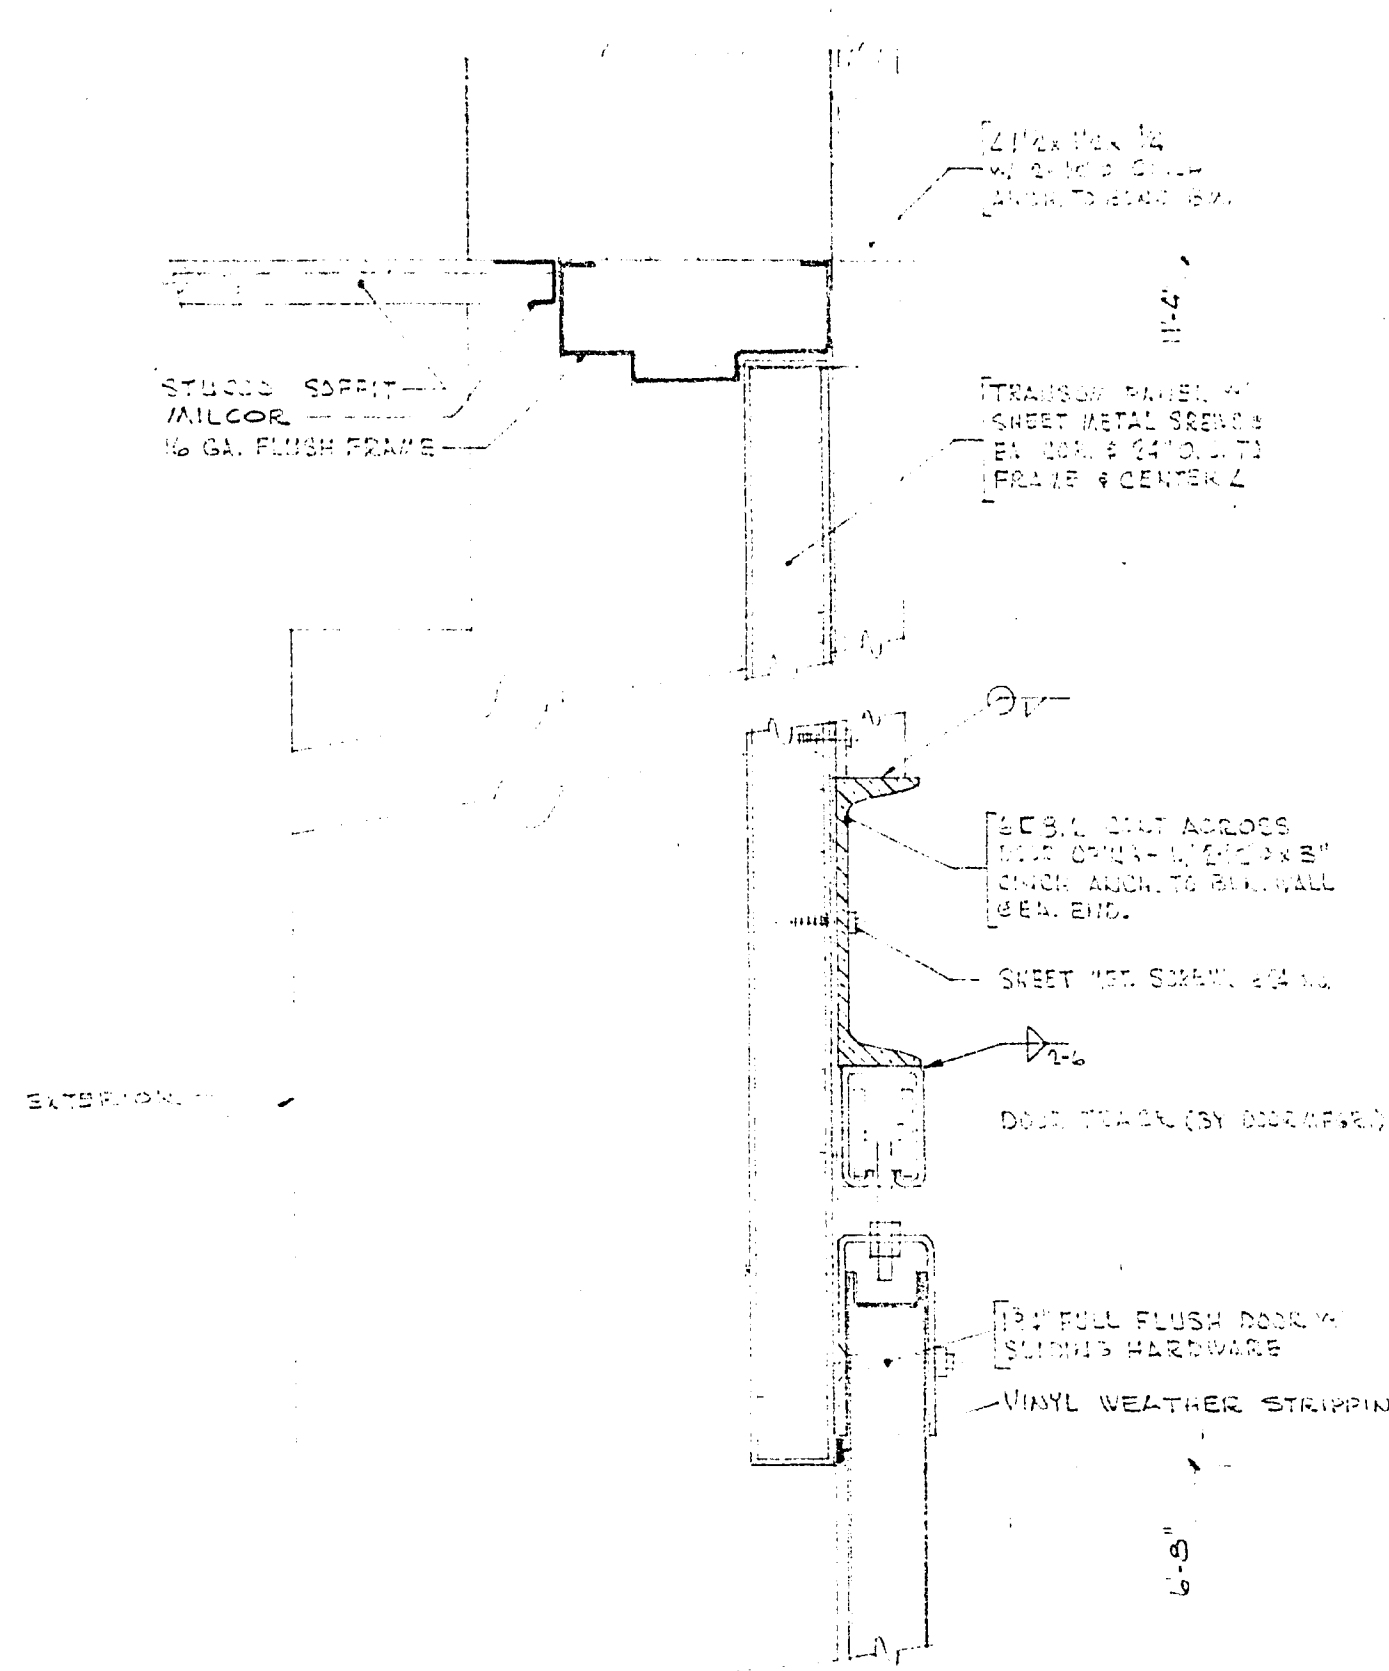


HEAD
DETAIL H
SCALE: 3/4"=1'-0"

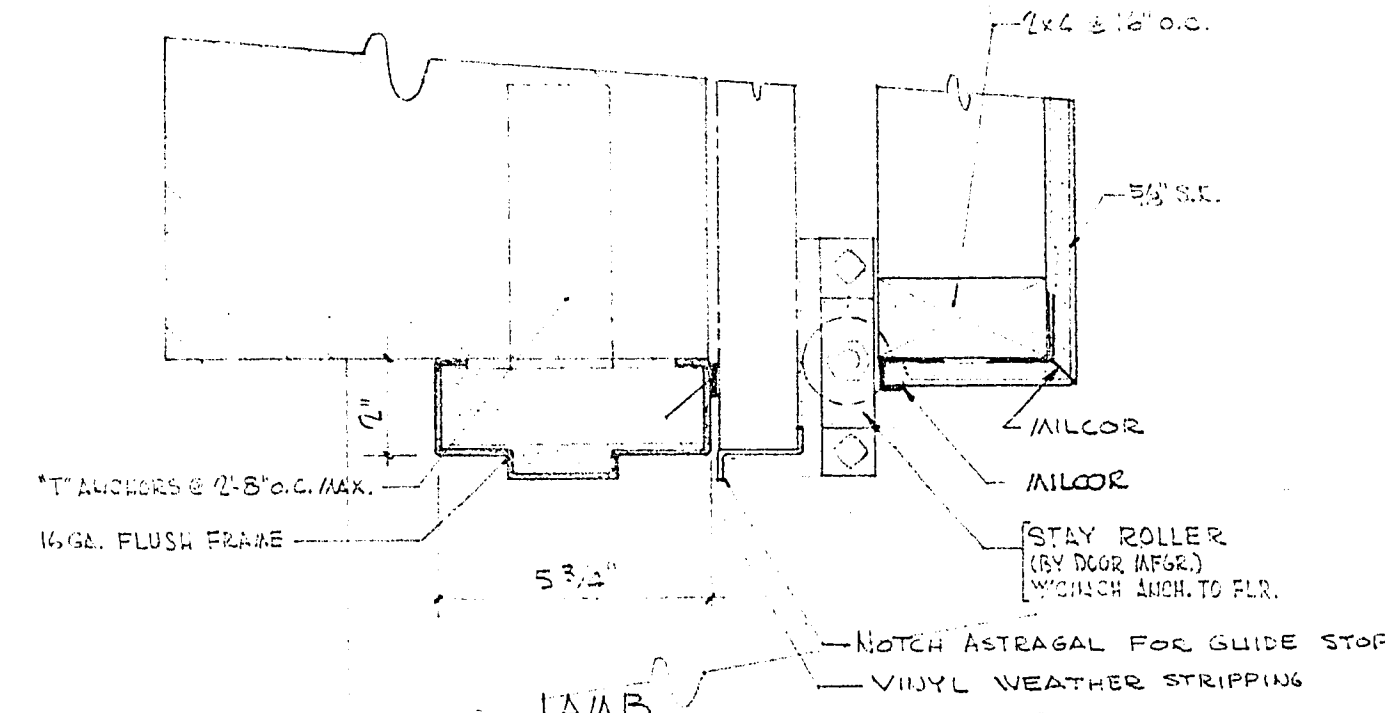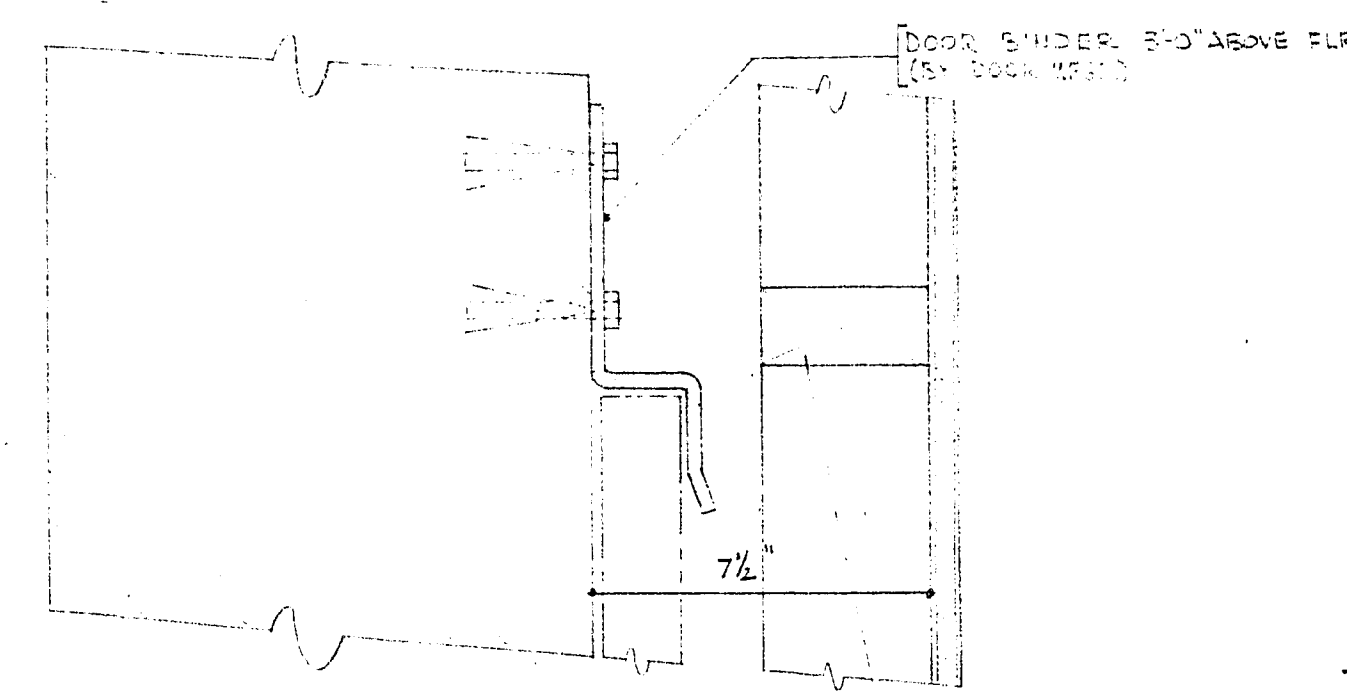

JAMB
DETAIL I
SCALE: 3/4"=1'-0"

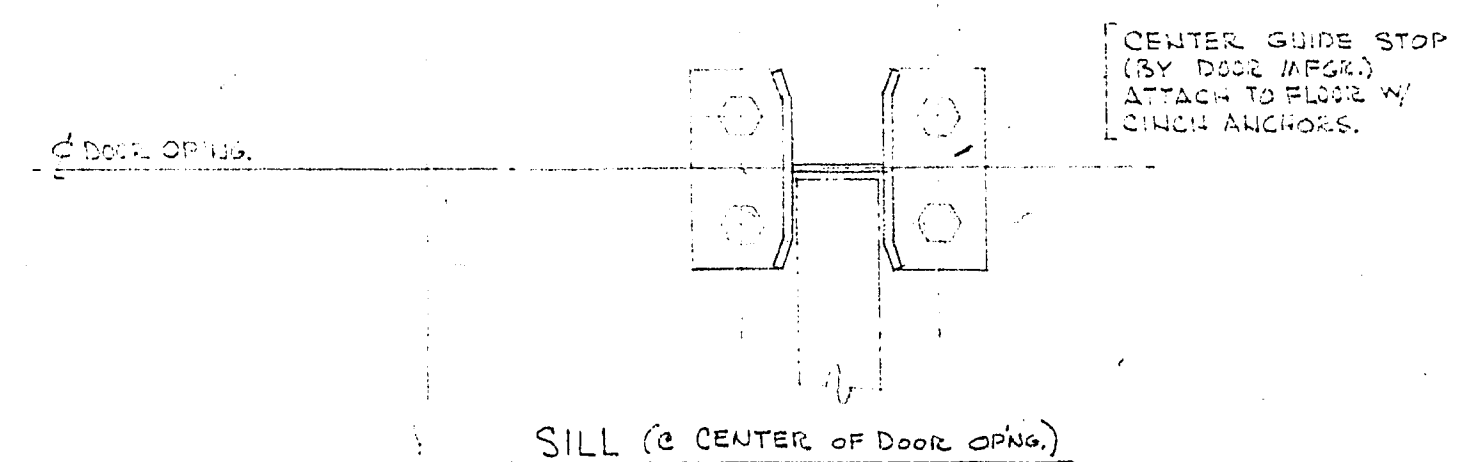


SILL @ CENTER OF DOOR OPENING
DETAIL J
SCALE: 3/4"=1'-0"

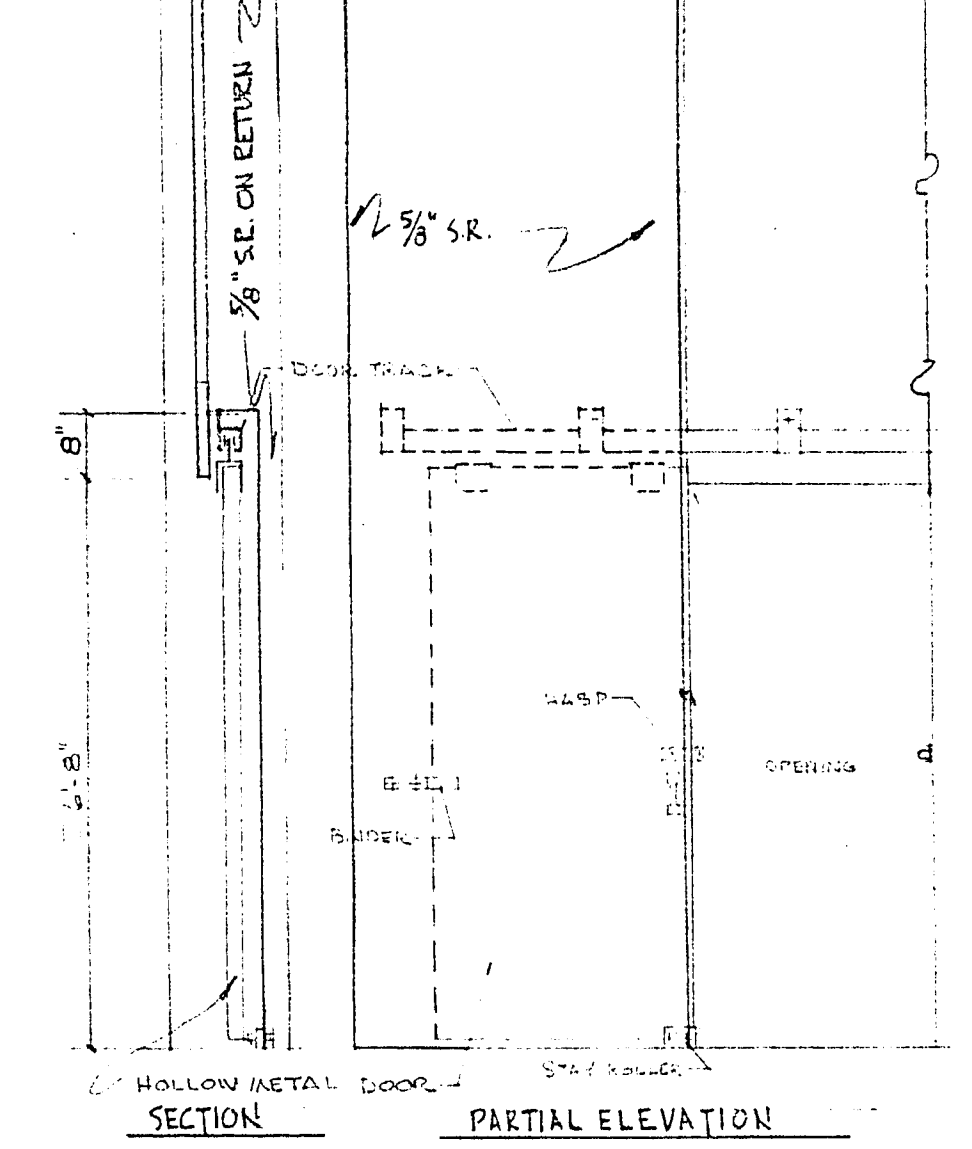


SECTION
DETAIL K
NO SCALE

EAST PORTION SIMILAR -
FRAME AROUND RAINPIPE
AS REQ.

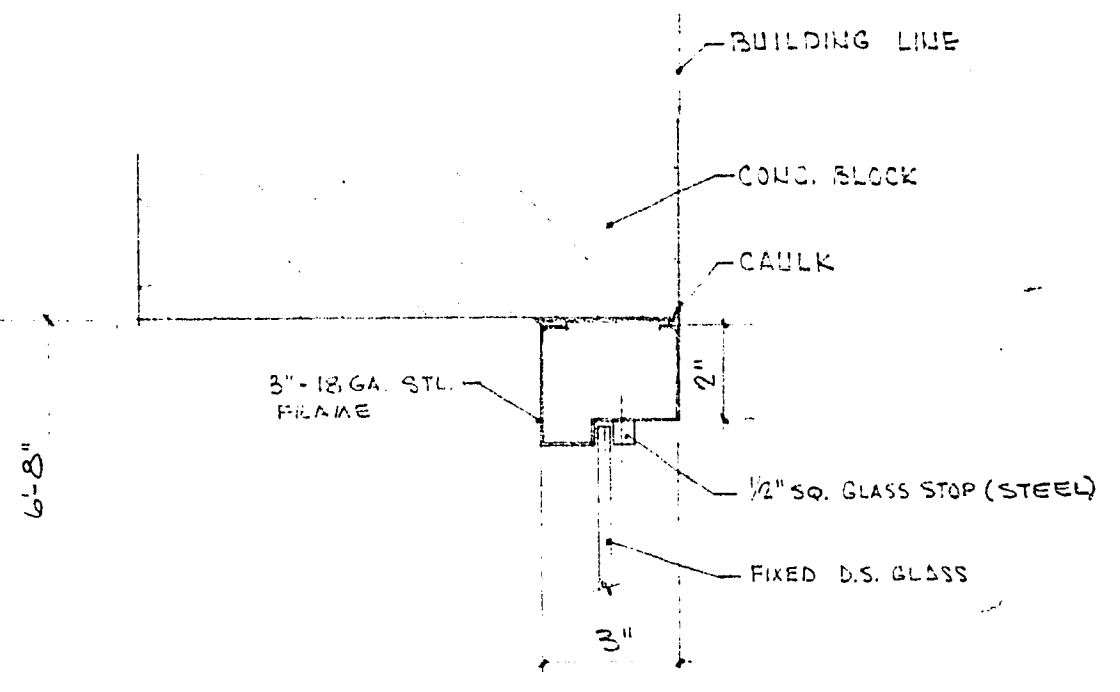

HEAD
DETAIL L
SCALE: 3/4"=1'-0"

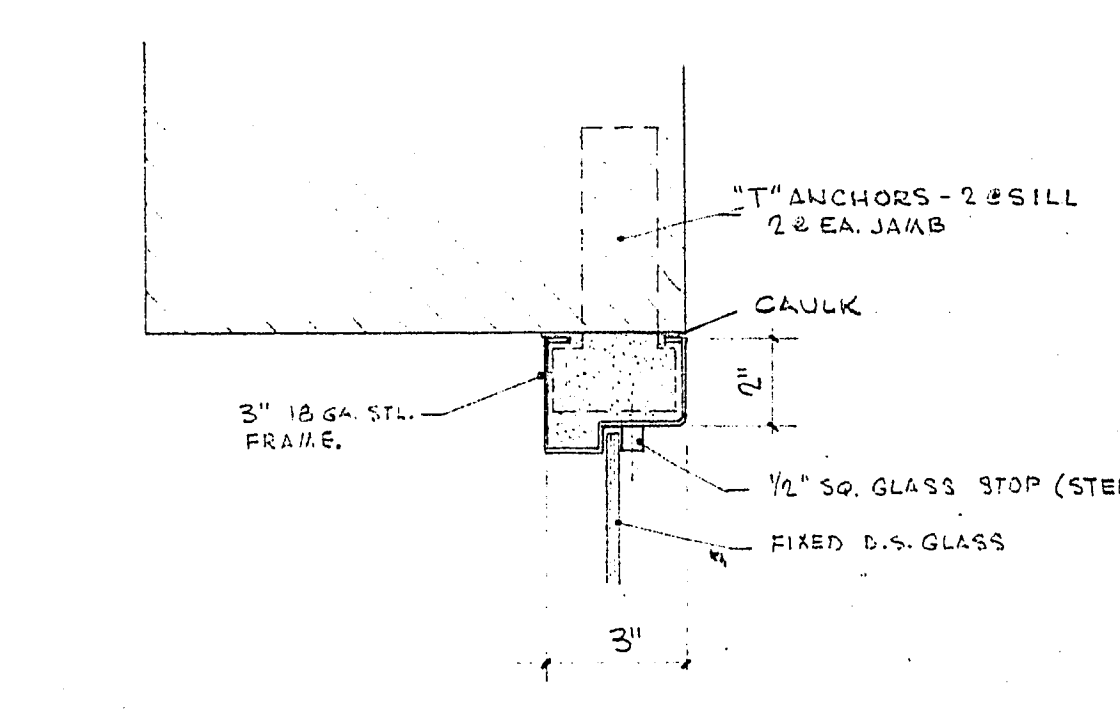

JAMB
(SILL SIMILAR)
DETAIL M
SCALE: 3/4"=1'-0"

AS BUILT

REVISIONS	
1	SUPPLEMENTAL 1 DOOR INFO. ADDED FROM
2	
3	
4	
5	
6	
7	
8	
DATE 3-15-66	
DRAWN BY AKP	
CHECKED BY	
SHEET TITLE DOOR & WINDOW DETAILS BUILDING "A"	
JOB TITLE CITY YARD FACILITIES FOR THE CITY OF LAS VEGAS, NEVADA	
JOB 6510	
SHEET 6A	
OF 30 TOTAL	