



REVISIONS	
1	11 APRIL 66
2	5/16/66
3	25 MAY 66
4	2 JUNE 66
5	
6	
7	
8	
DATE	
3-15-66	
DRAWN BY	
A. K. P.	
CHECKED BY	

JACK T. BELCHER
 CIVIL ENGINEER
 217 GARCES AVE.
 LAS VEGAS, NEVADA
 FOUNDATION PLAN
 BUILDING "B"
 CITY YARD FACILITIES FOR THE CITY OF LAS VEGAS, NEVADA

JOB
6510
 SHEET
2B
 OF 30 TOTAL

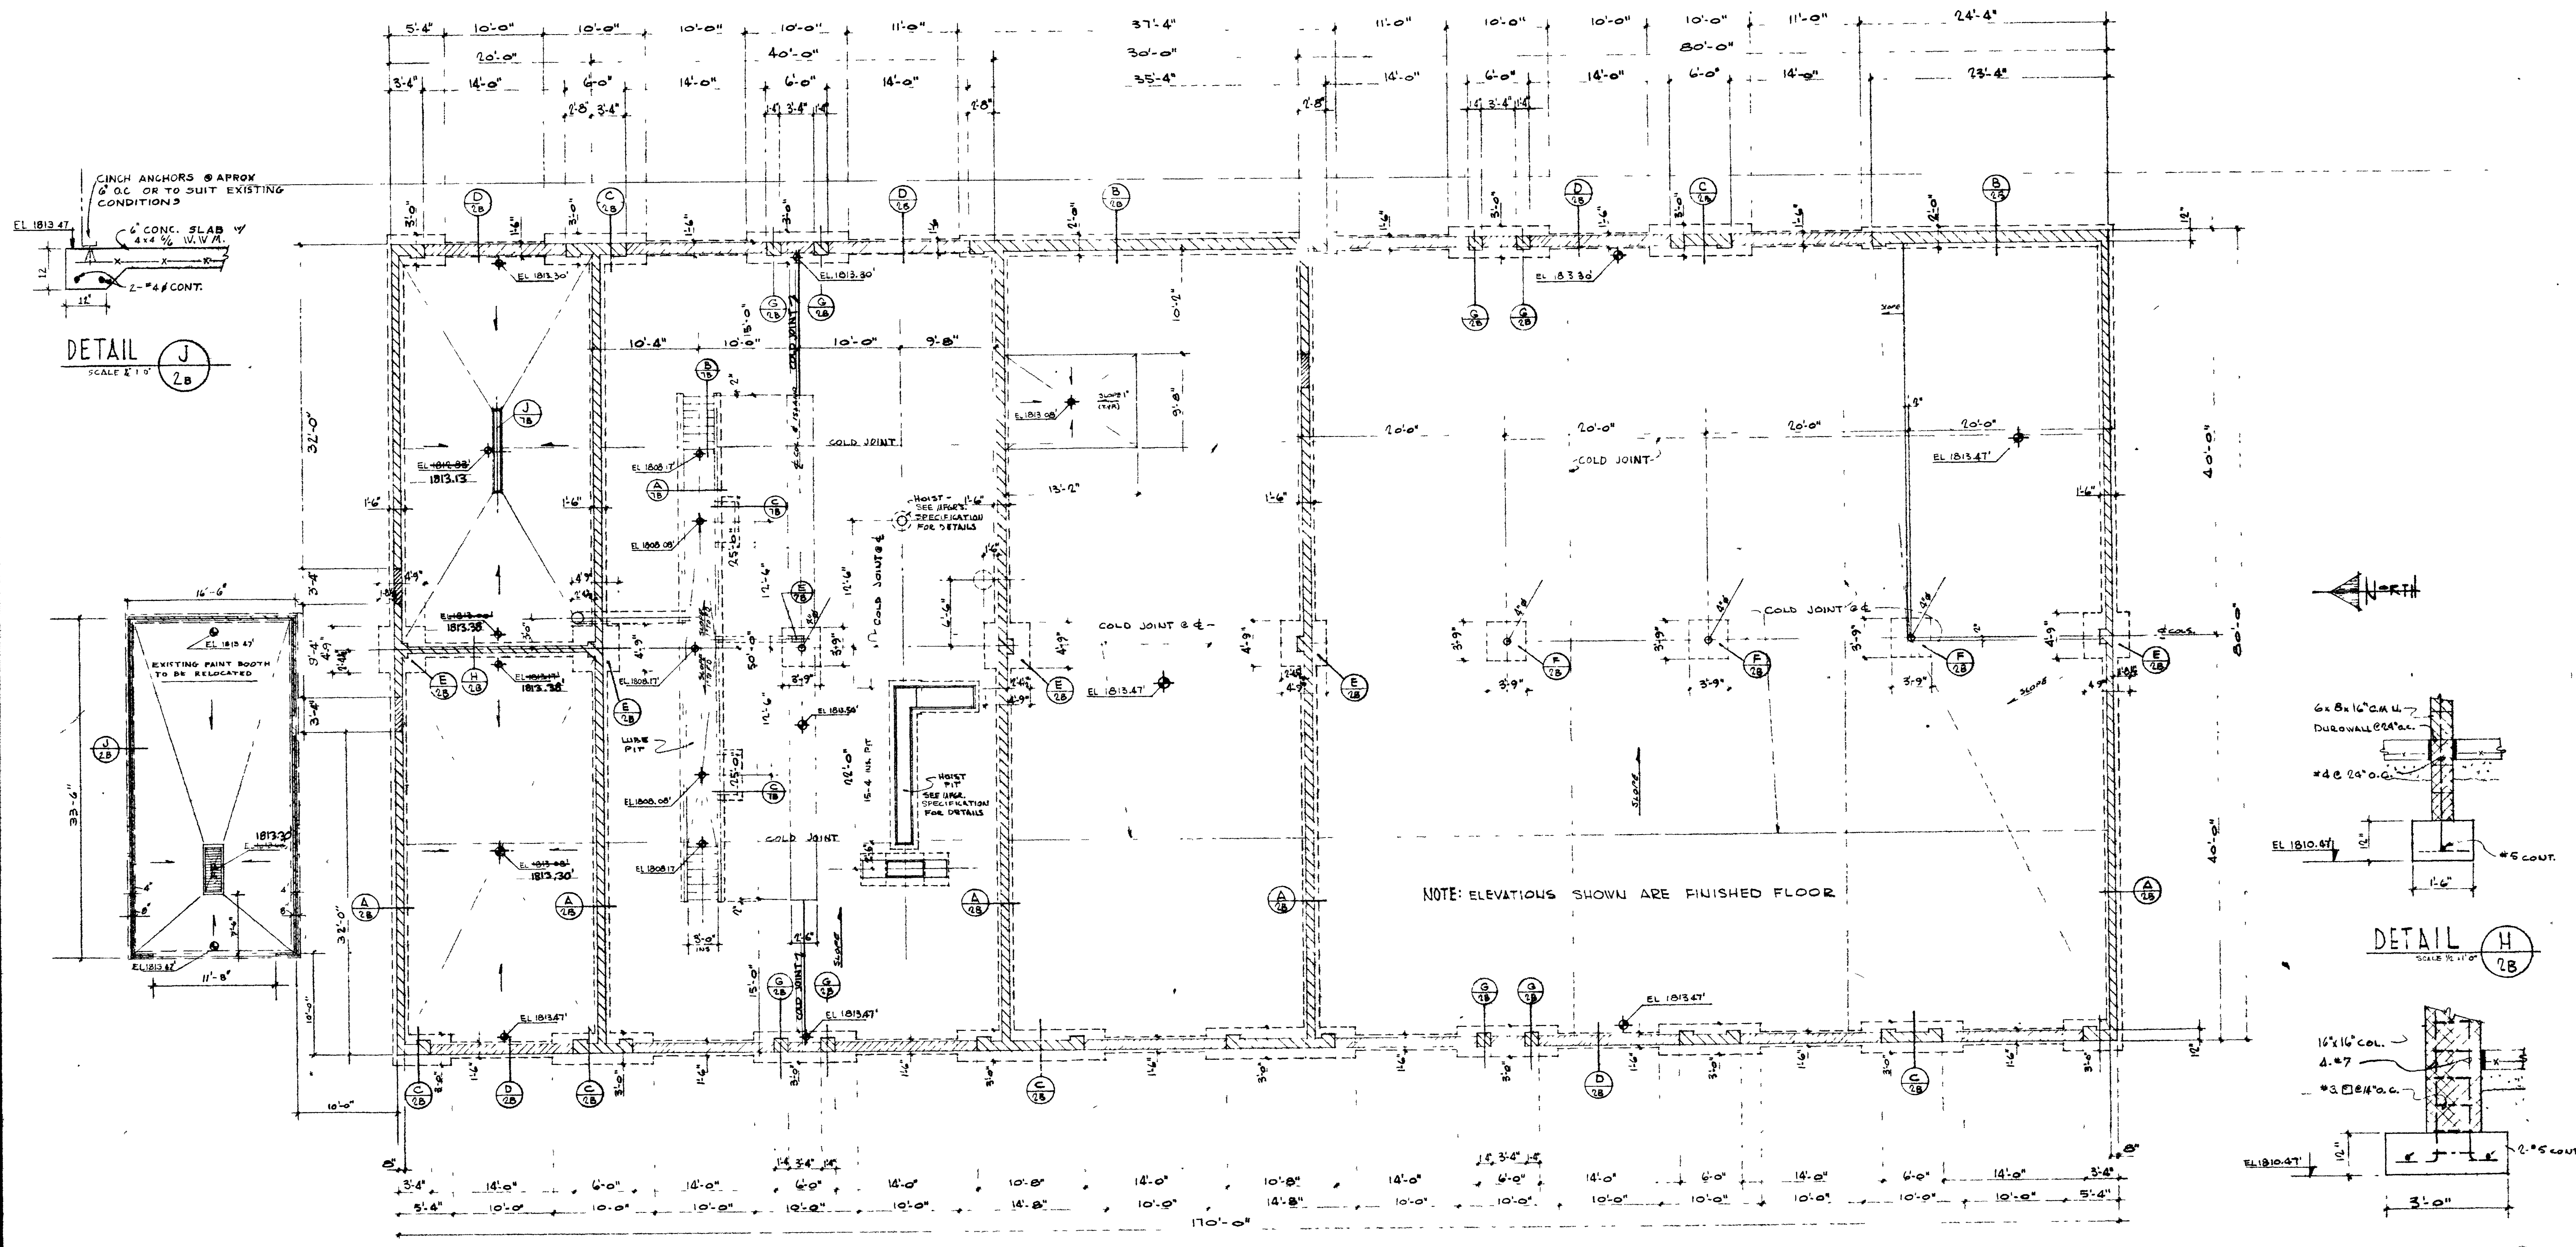

FOUNDATION PLAN SCALE 1/8" = 1'-0"

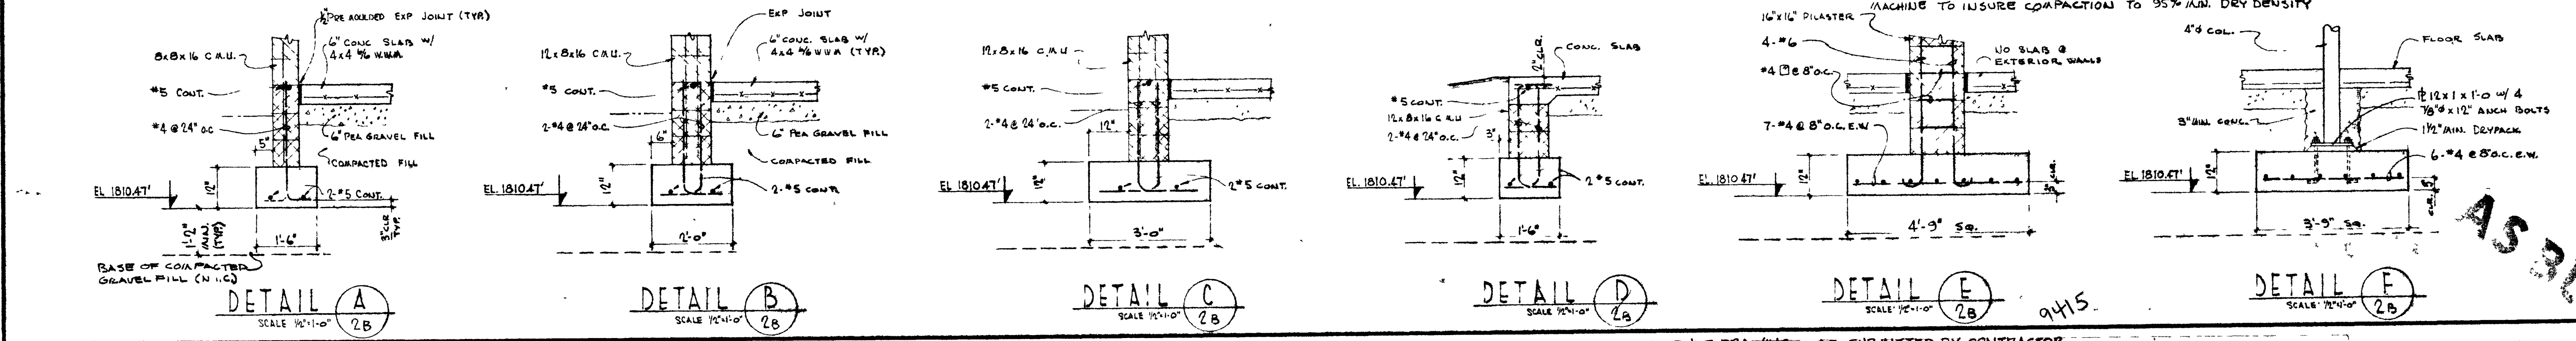

AS BUILT DRAWING AS SUBMITTED BY CONTRACTOR

522-29

